

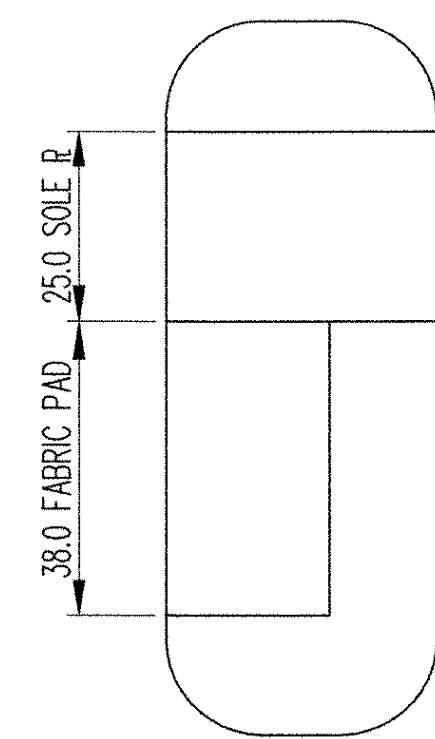


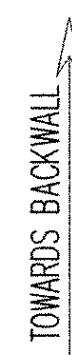


DETAIL 'B'

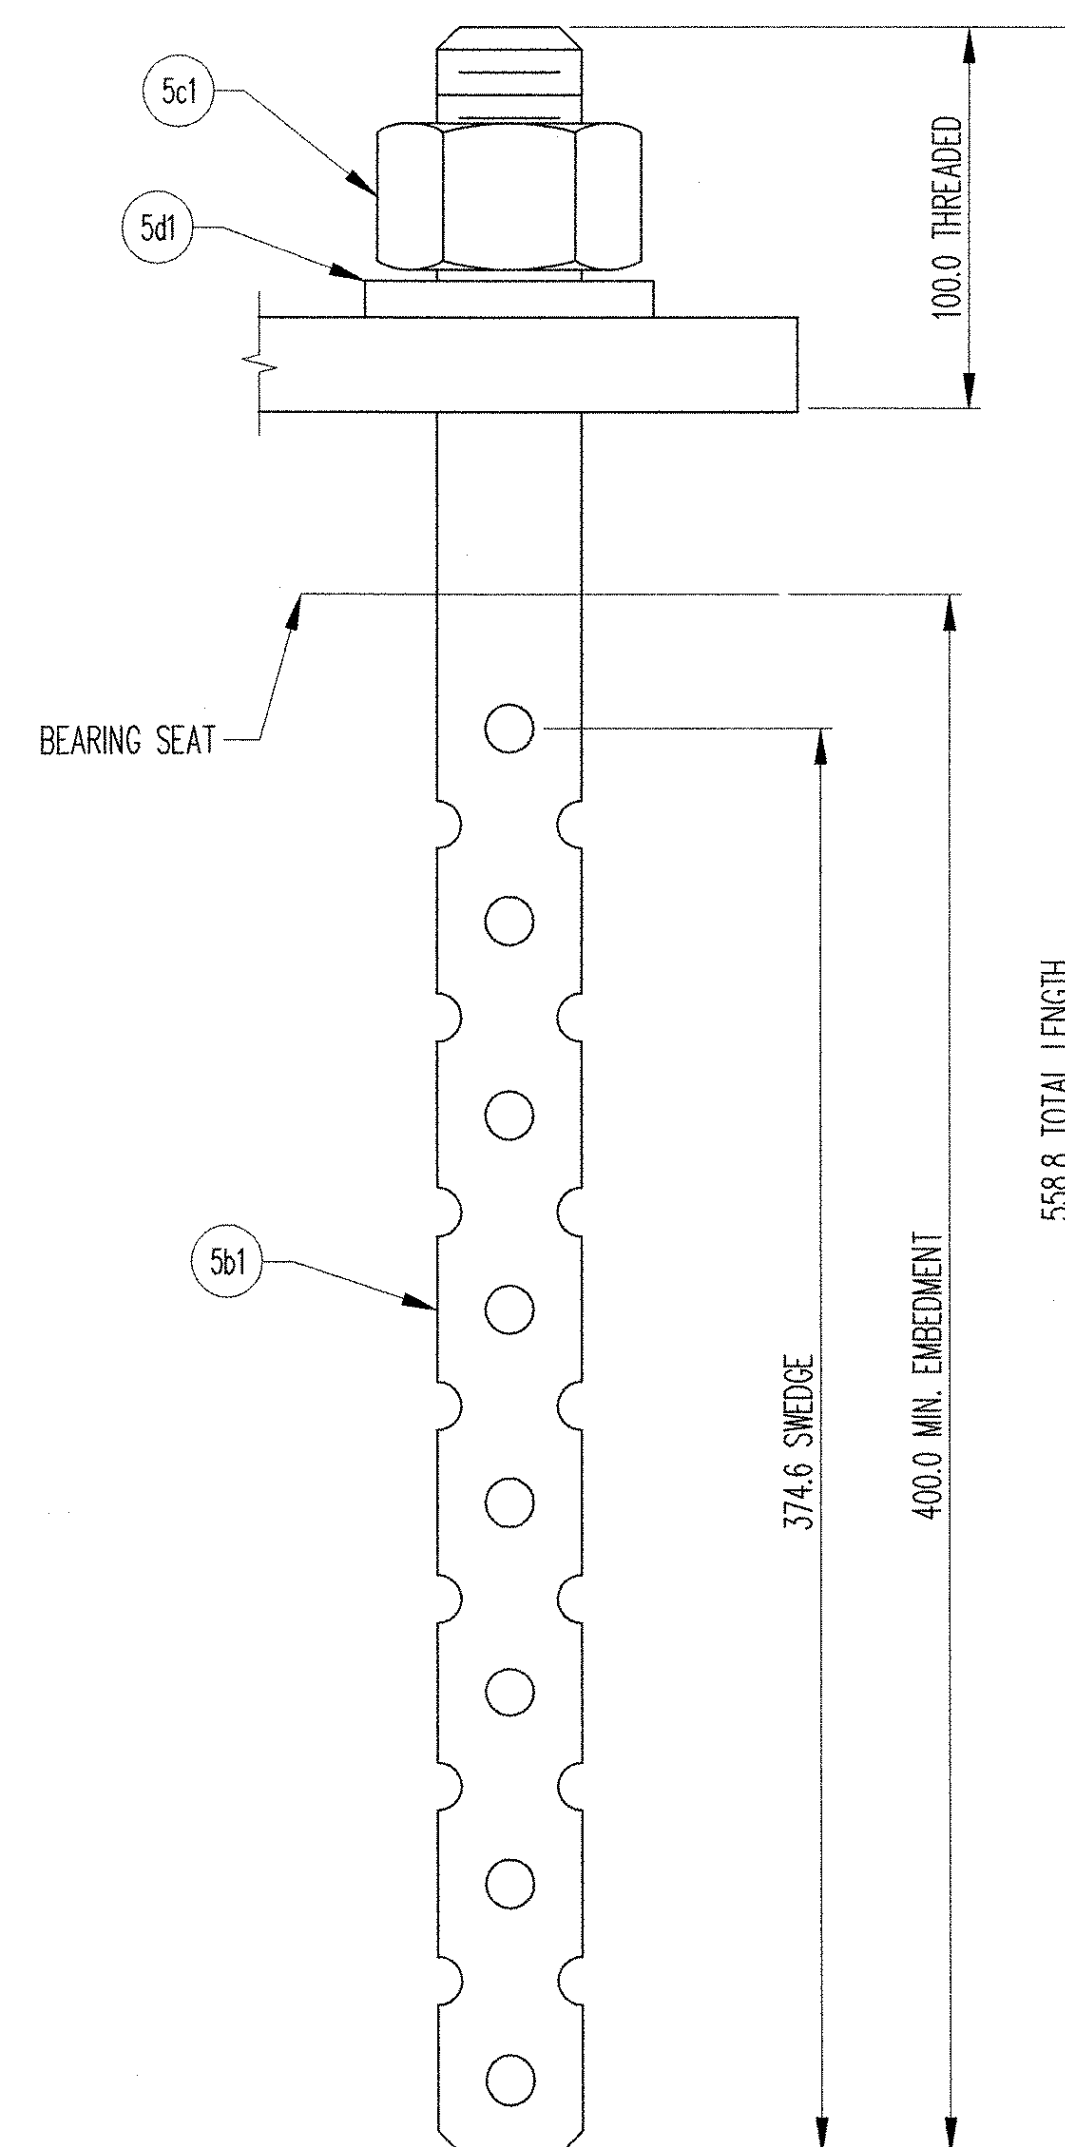


MR	QTY.	DESCRIPTION	MATERIAL	LENGTH	REMARKS	PART NO.
5A	1	PREFORMED FABRIC PAD	VT 707.07 731.01			
5d1	1	38.0 X 286.0	VT 707.07	190.0	(AASHTO M270 GR 345)	
5p11	2	19.0 X 200.0	A709 GR 345	250.0	(AASHTO M270 GR 345), CLIP CORNER; A123-HDG	
5p12	1	19.0 X 89.0	A709 GR 345	110.0	(AASHTO M270 GR 345); A123-HDG	
5sp1	1	25.0 X 535.0	A709 GR 345	340.0	(AASHTO M270 GR 345); A123-HDG	
5B	2	SWEDGE ANCHOR ROD				
5b1	2	38.1Ø X 558.8	A36		(AASHTO M553), 5/16" SWEDGE, 1000 THREADS; A153-HDG	
5C	2	HEAVY HEX NUT				
5c1	2	38.1Ø	A563-DH/A194-2H		(AASHTO M259-DH/A292-2H). SEE NOTE 7; A153-HDG	
5D	2	WASHER PLATE				
5d1	2	9.5 X 76.2	A36	76.2	41.3 DIA. HOLE; A153-HDG	

NOTE: ALL DIMENSIONS IN MILLIMETERS, UNLESS OTHERWISE NOTED.

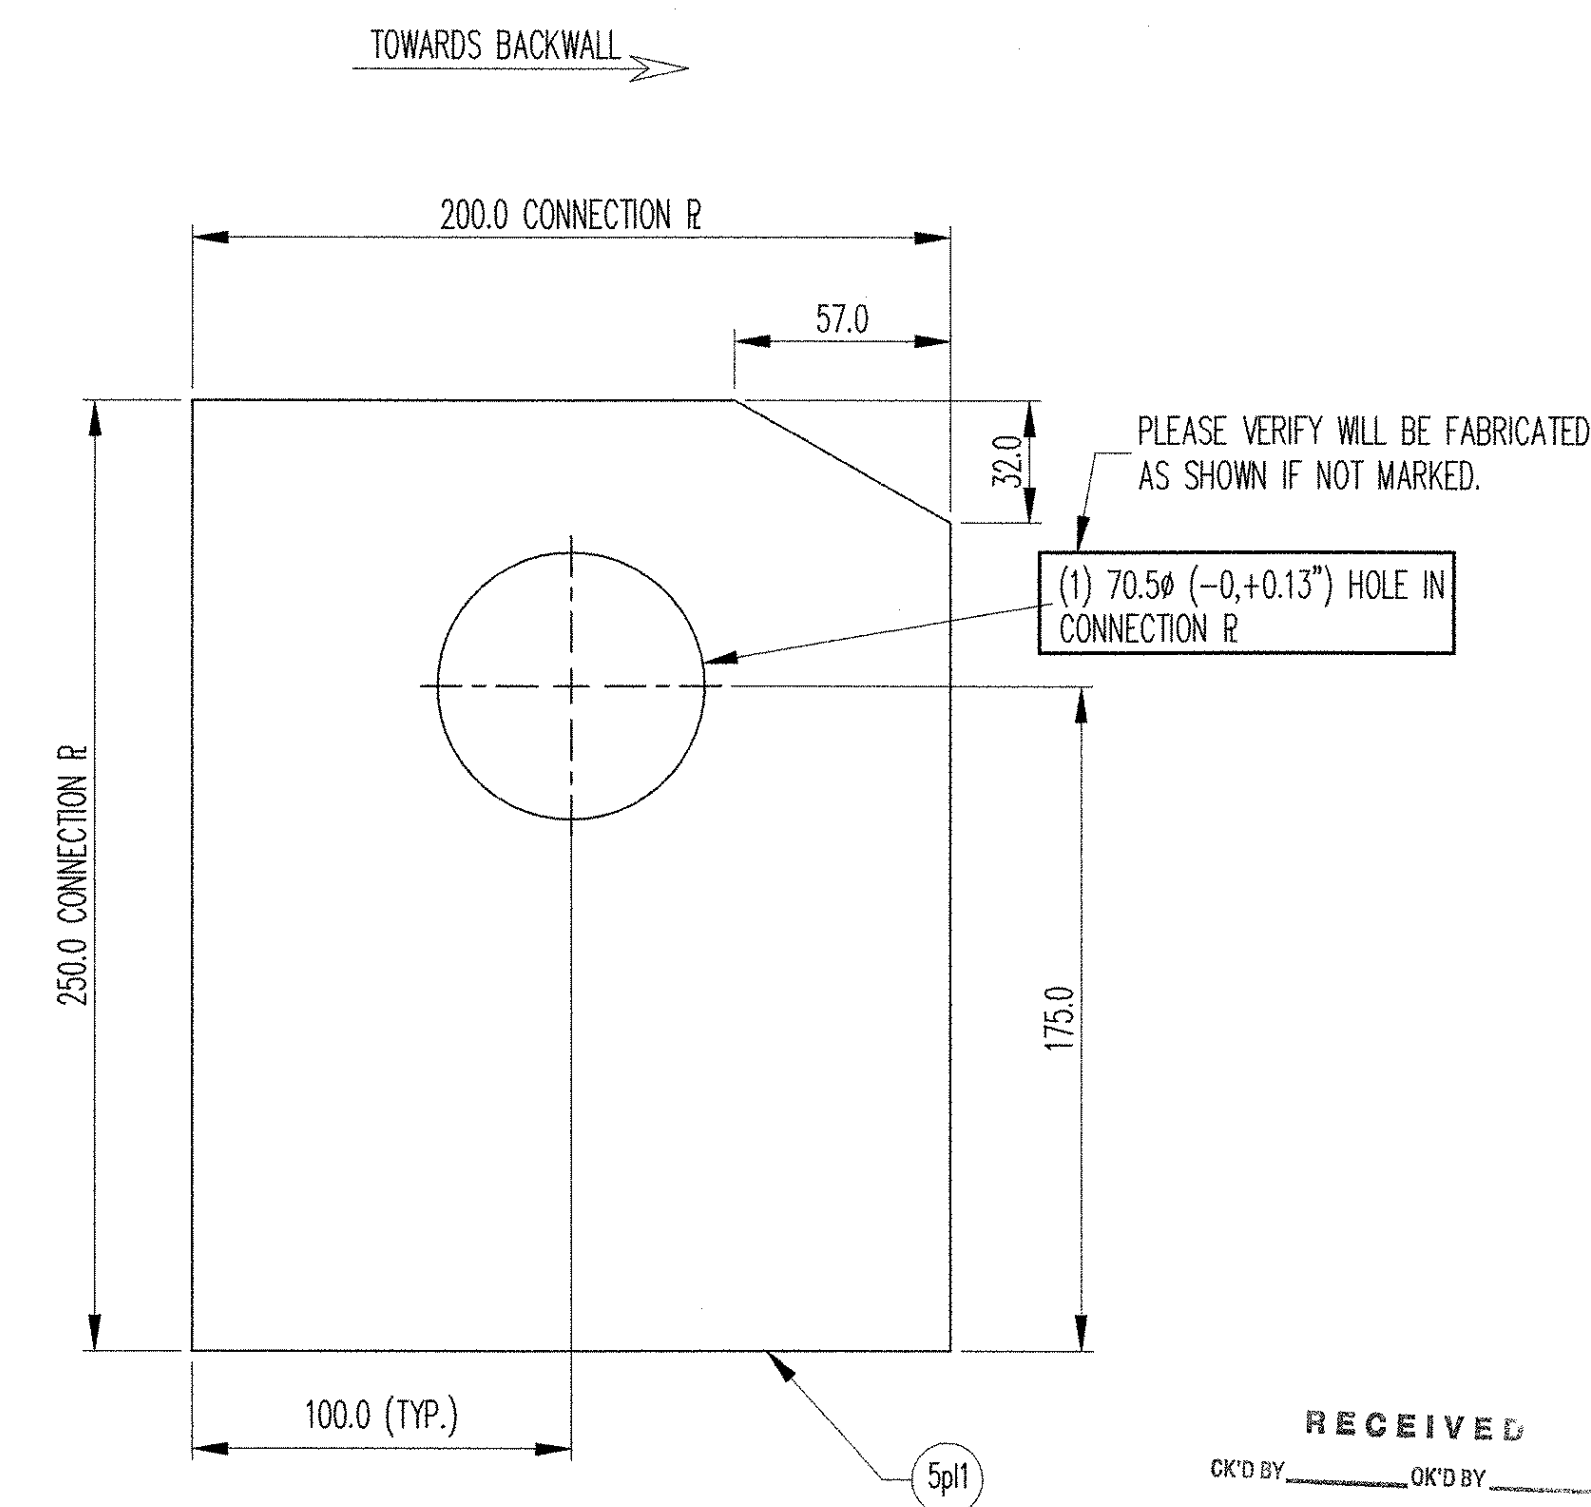

RECEIVED
OK'D BY _____ OK'D BY _____
APR 29 2004
RESUBMIT _____ APPROVED _____
BY *RRW* DATE *5-12-04*

FOR GENERAL NOTES SEE SHEET GN1.

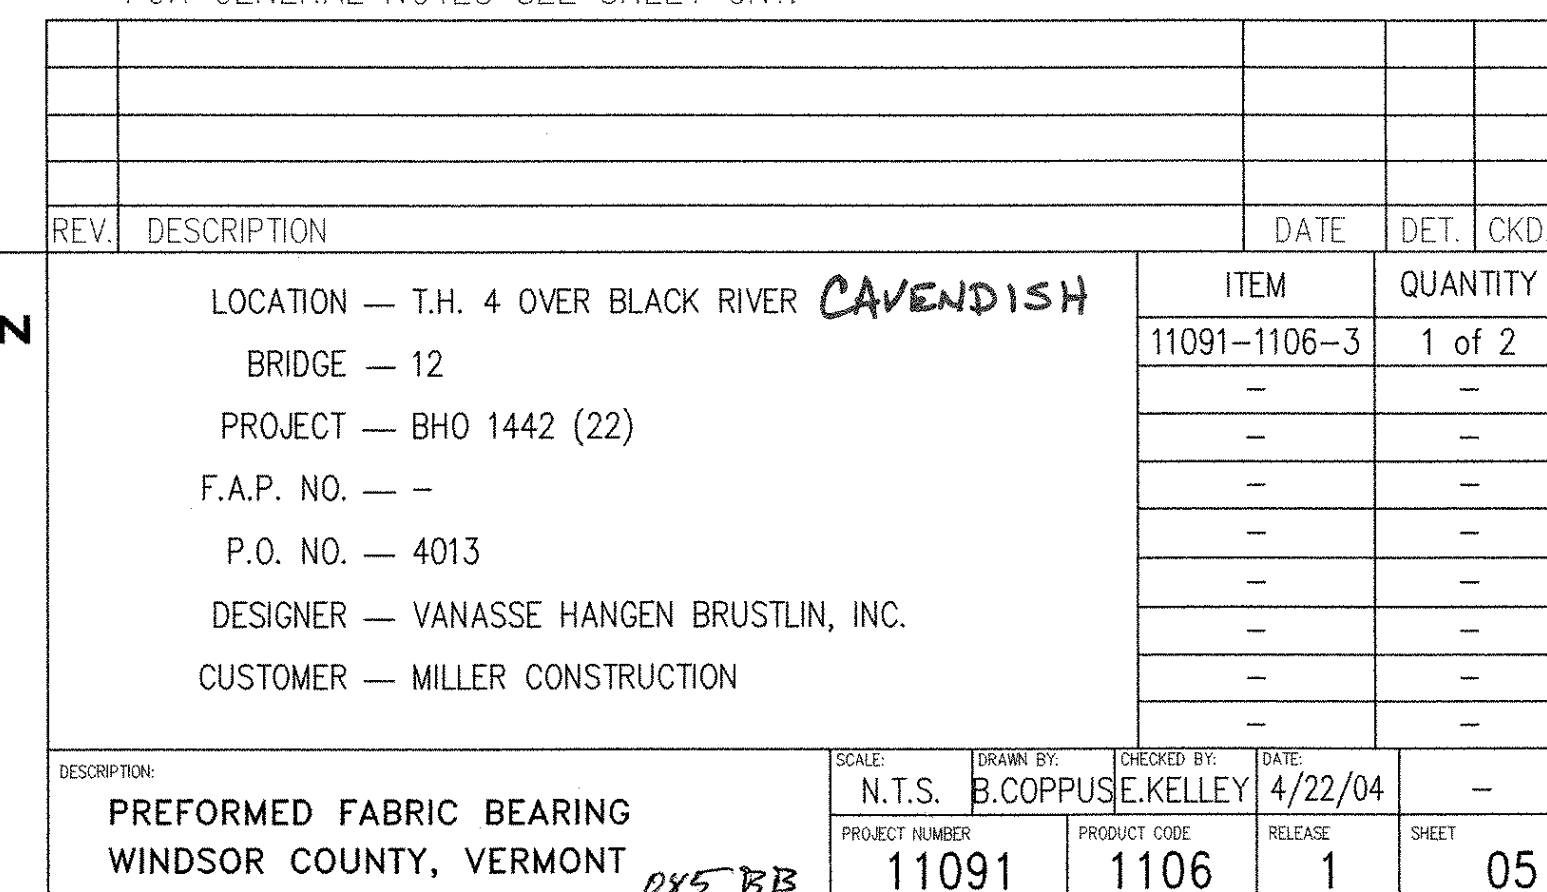

 **D.S. BROWN**


300 E. CHERRY STREET
NORTH BALTIMORE, OHIO 45872
419.257.3561
FAX: 419.257.0332

4201 NOREX DRIVE
CHASKA, MINNESOTA 55318
952.368.3000
FAX: 952.448.7000

DSBROWN.COM



PLAN VIEW
FIXED PREFORMED FABRIC BEARING
(1) REQ'D @ ABUT. 1, TRUSS UPSTREAM

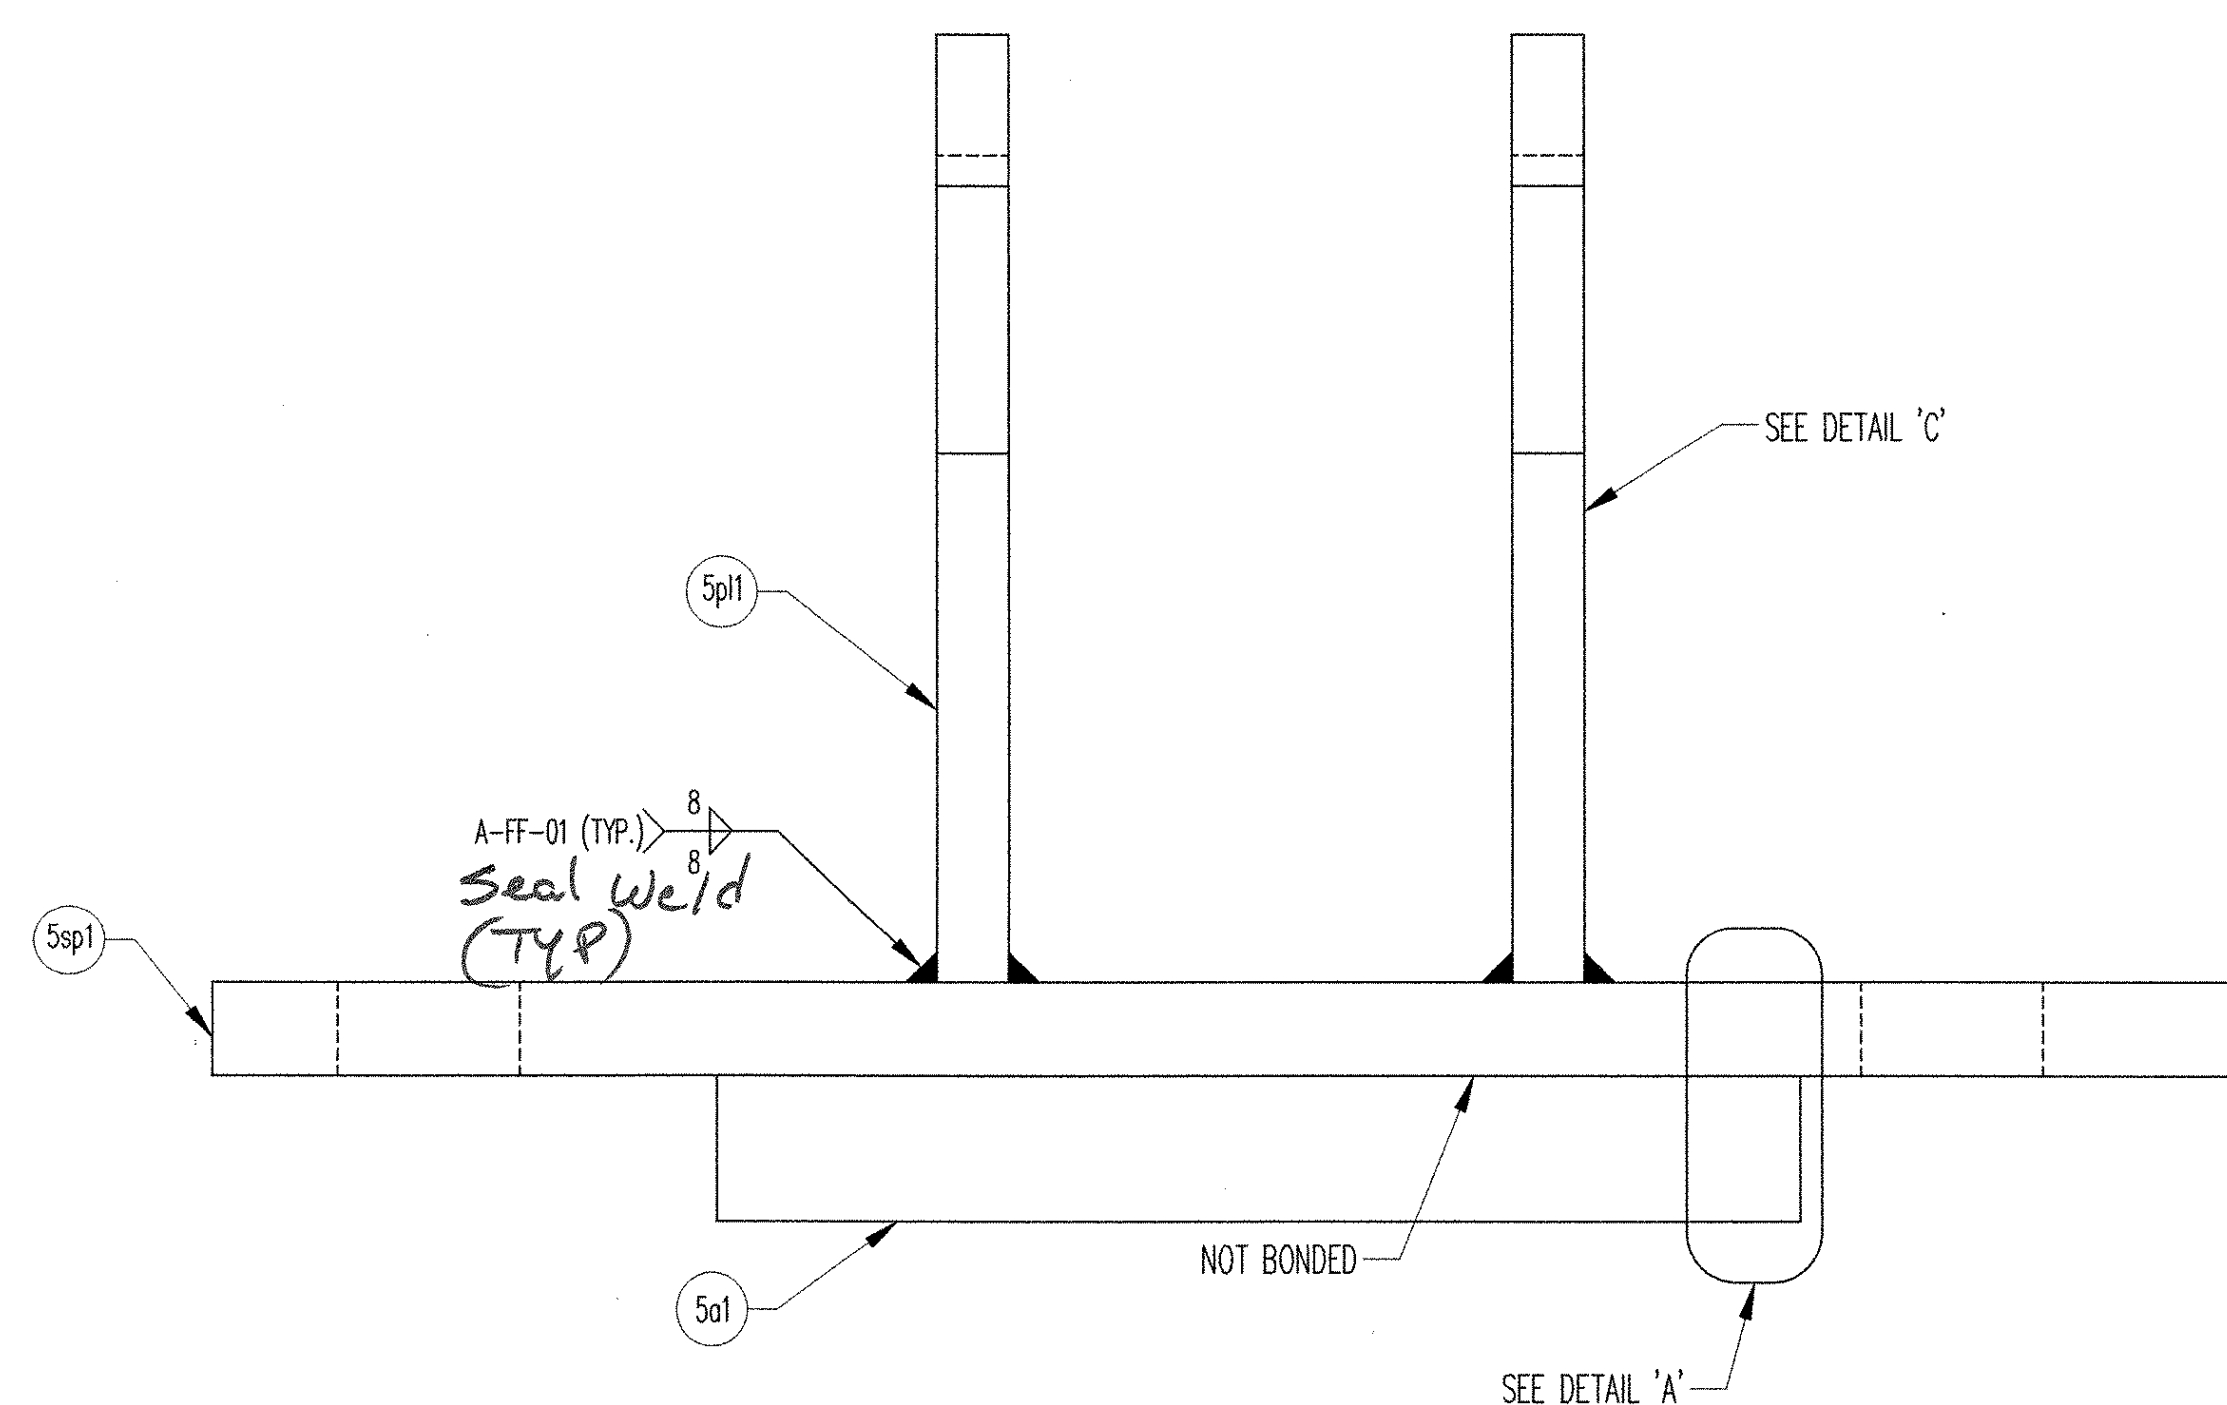

SECTION 'A-A'

TRUSS PINS & CLEVIS PINS
SUPPLIED BY OTHERS.