
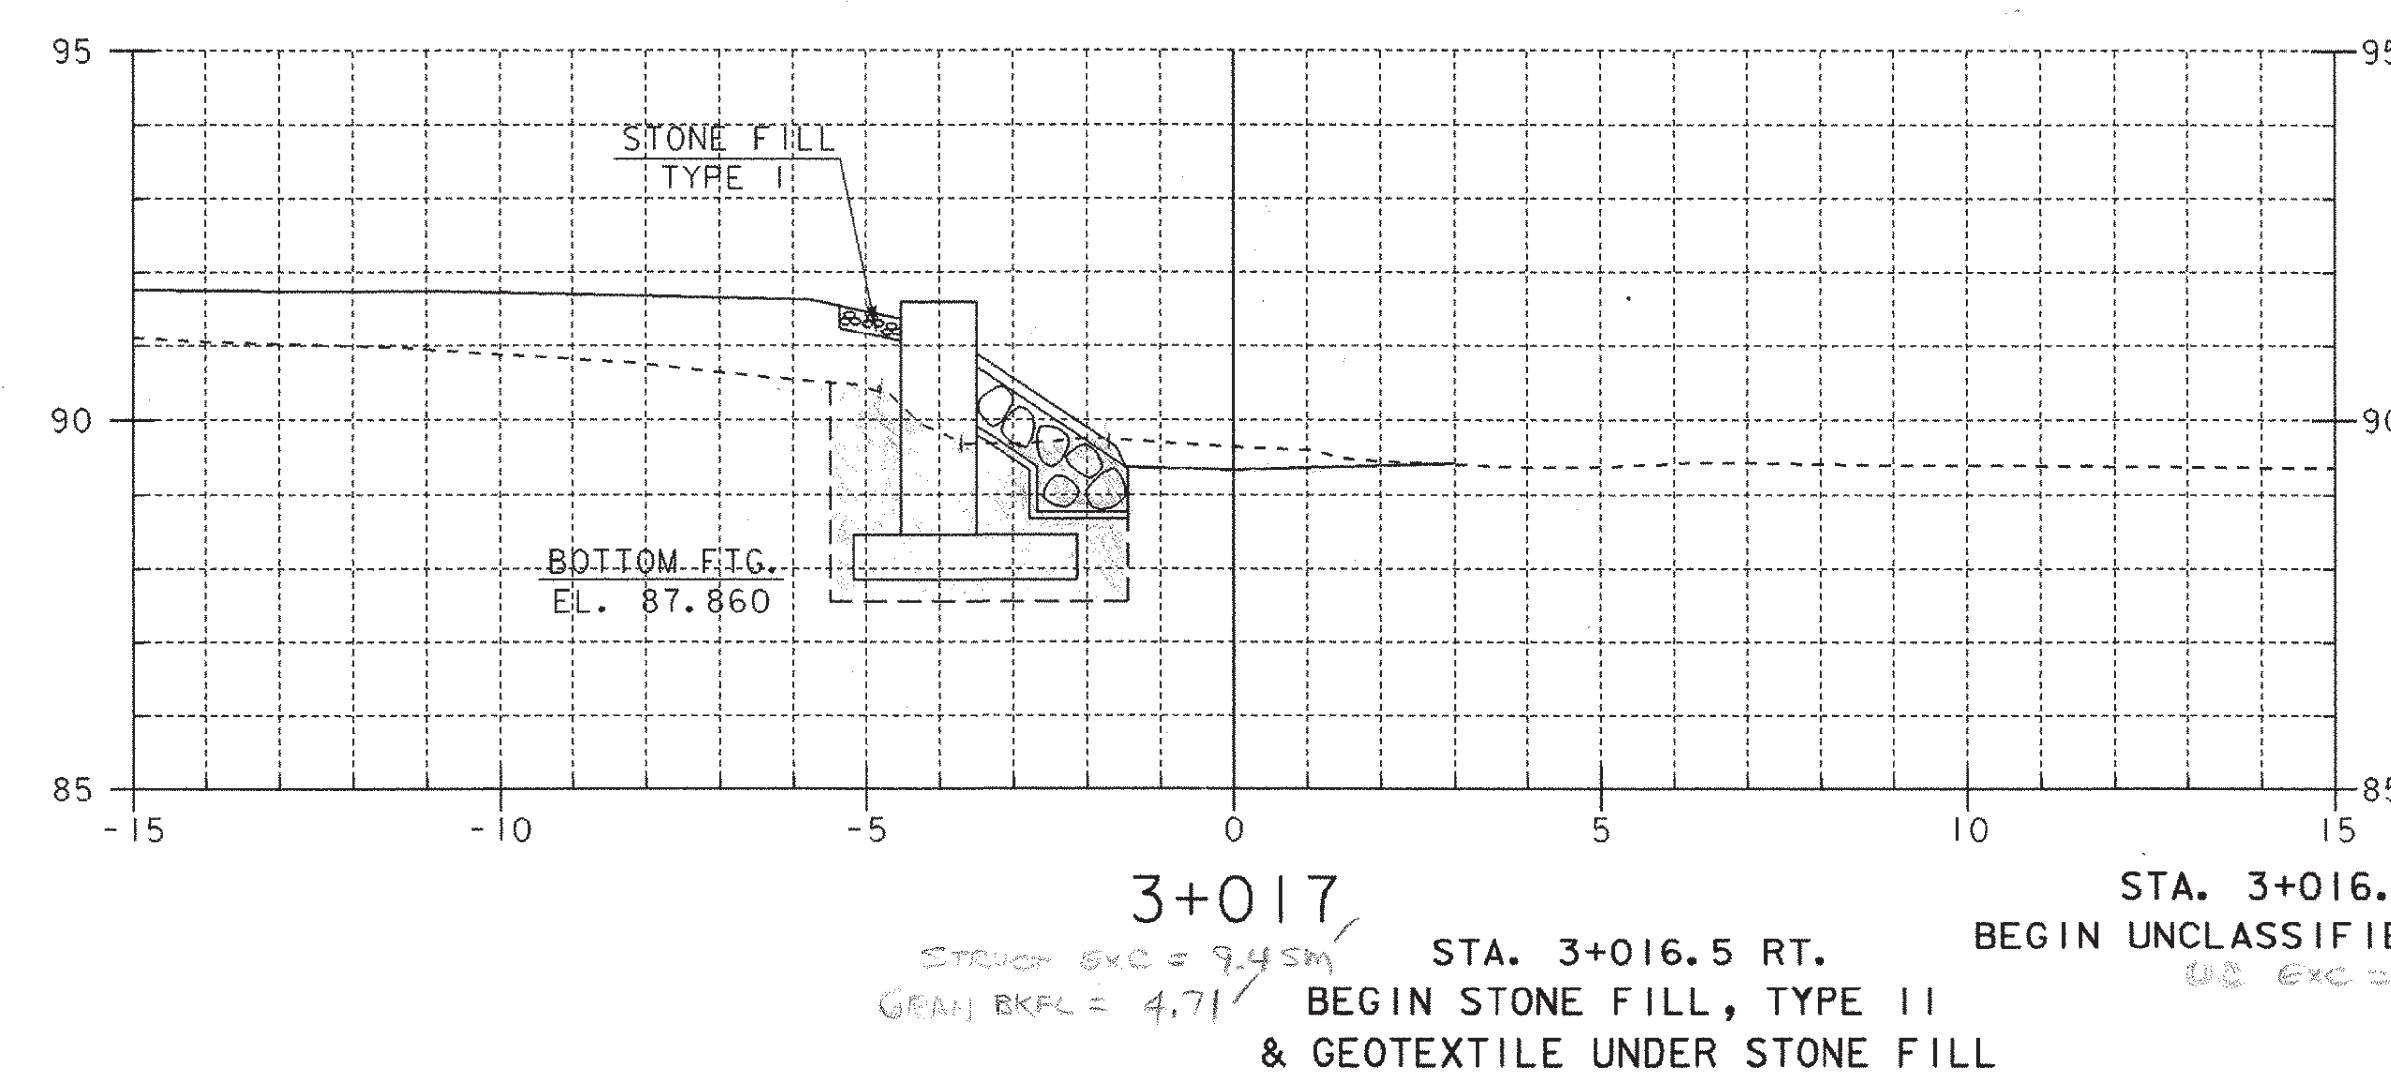
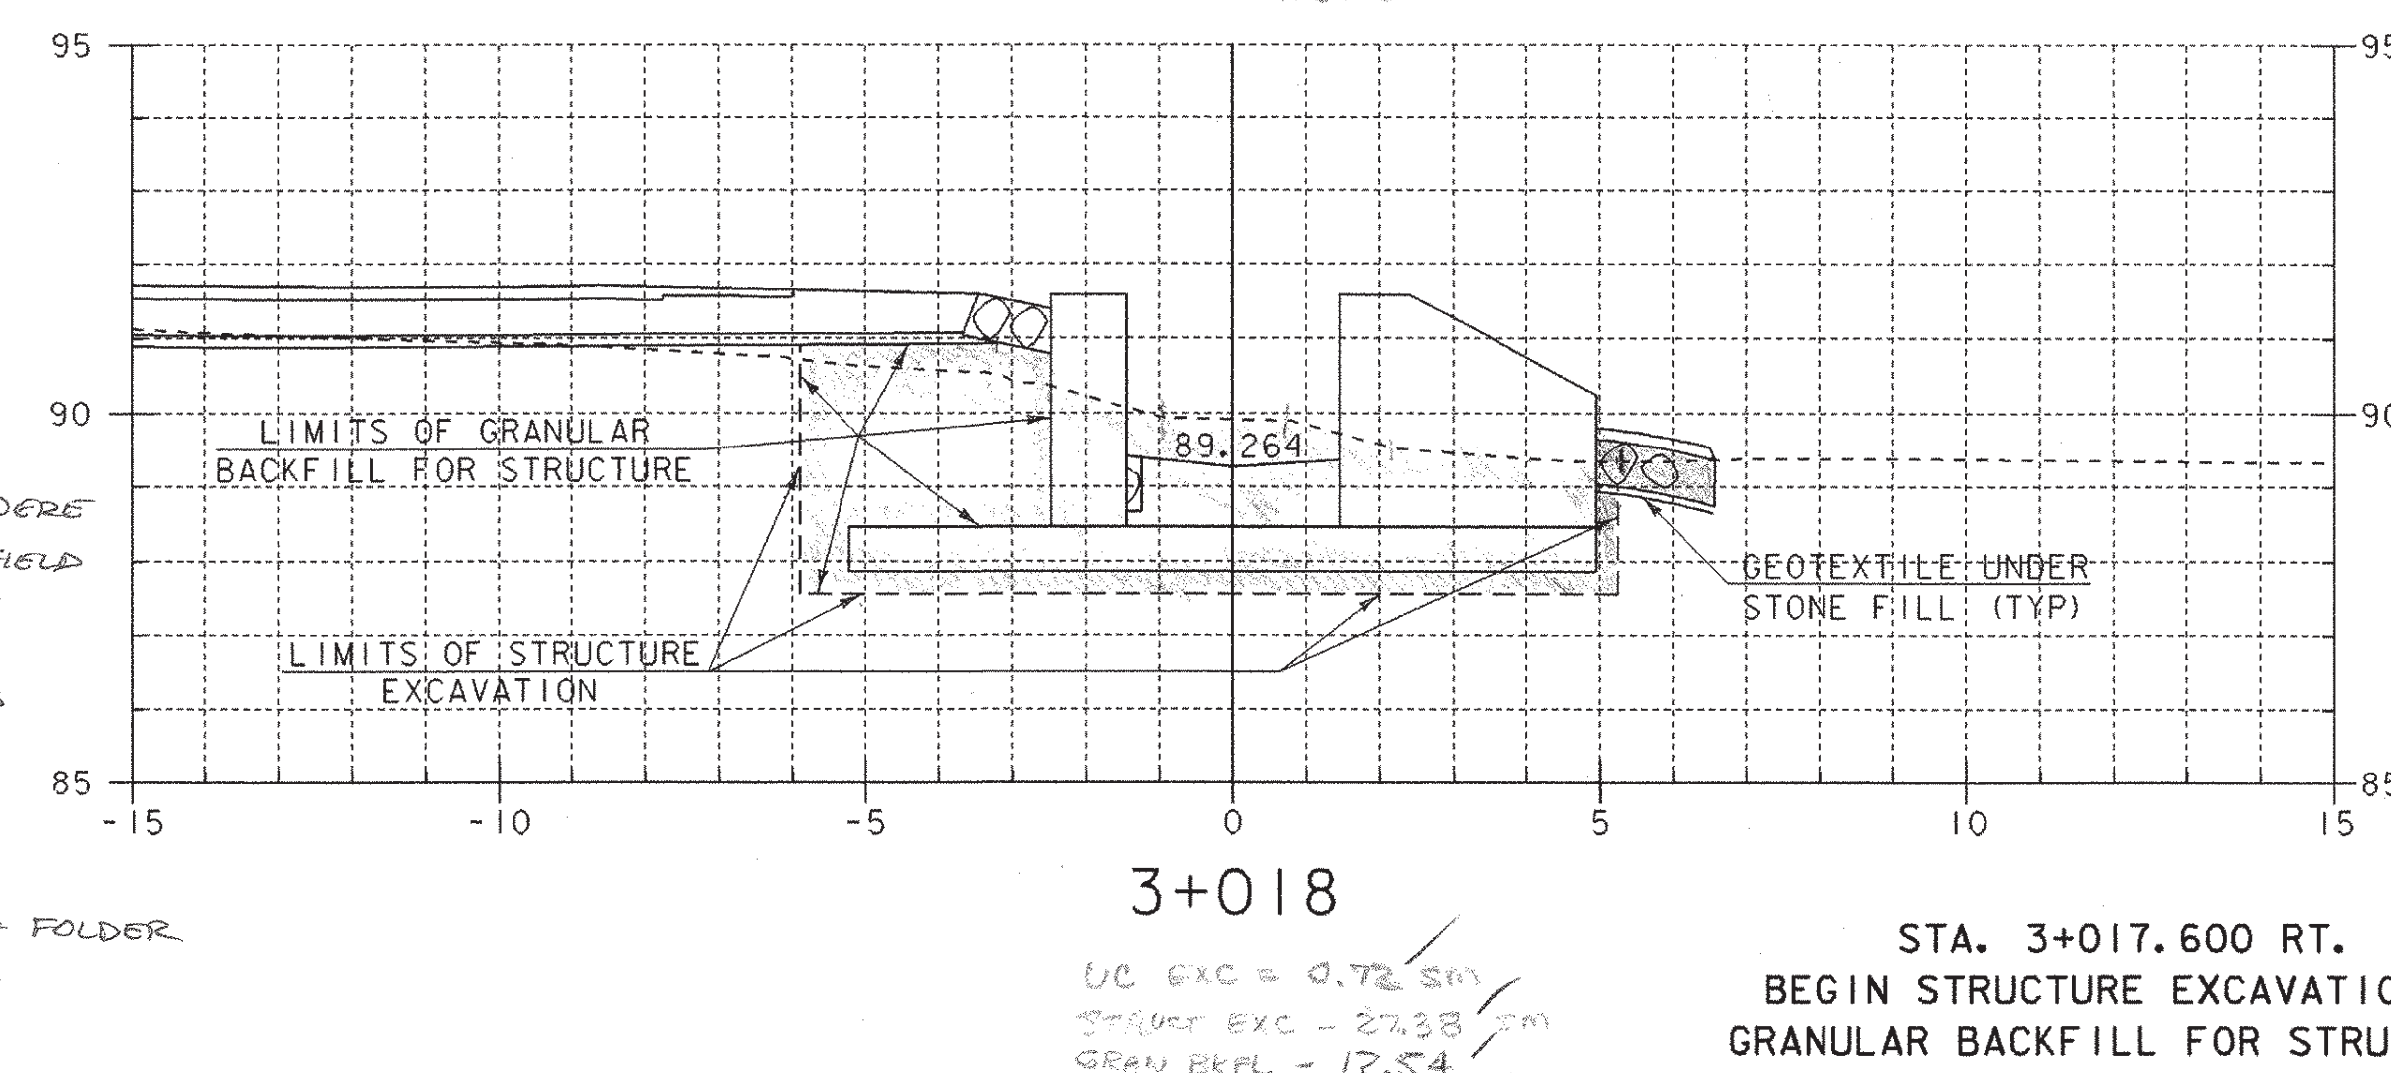
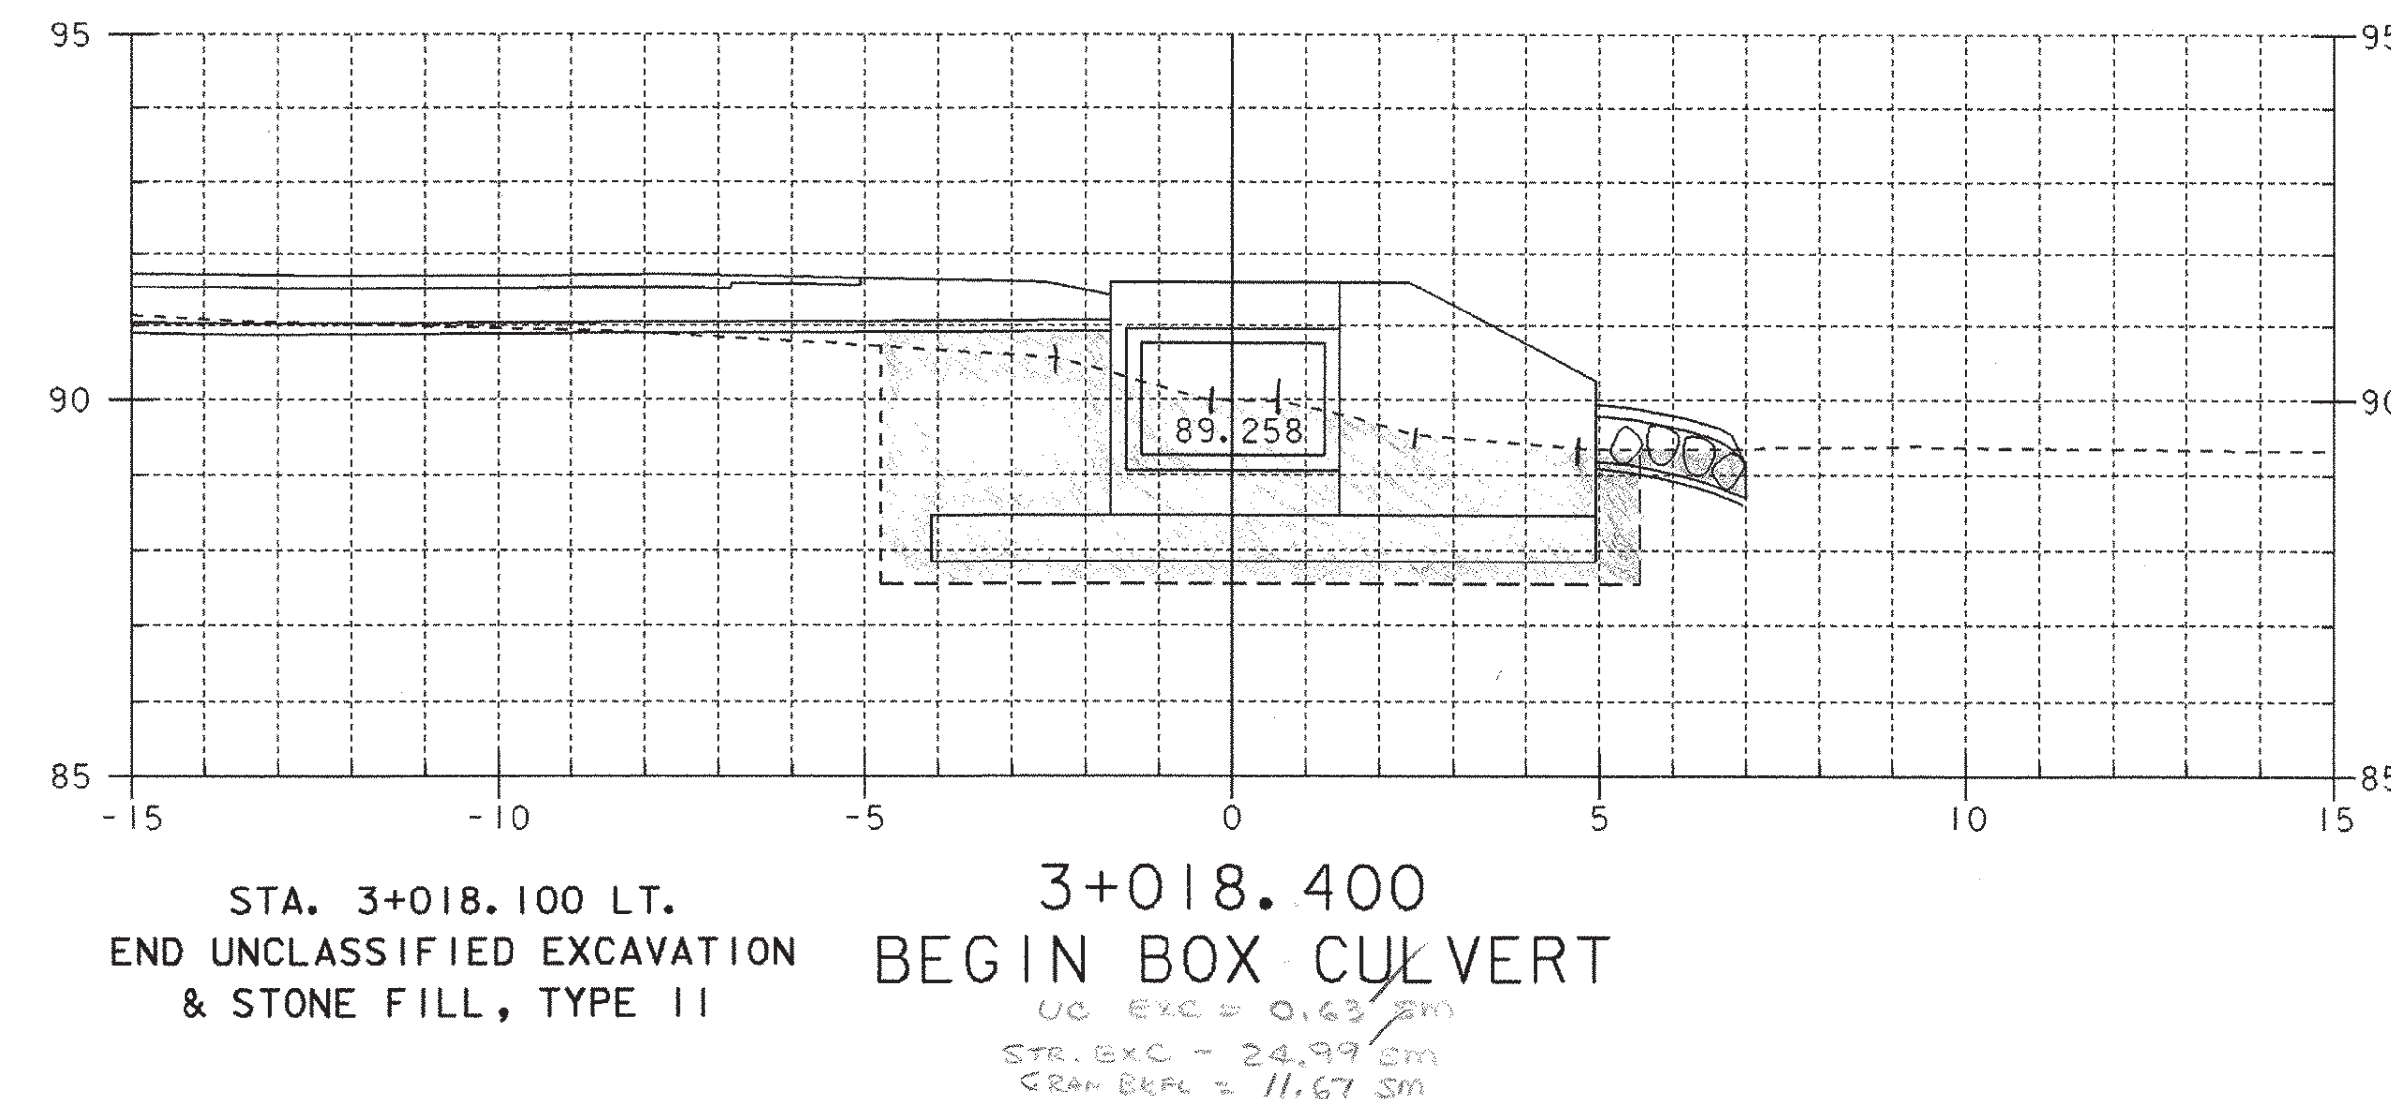
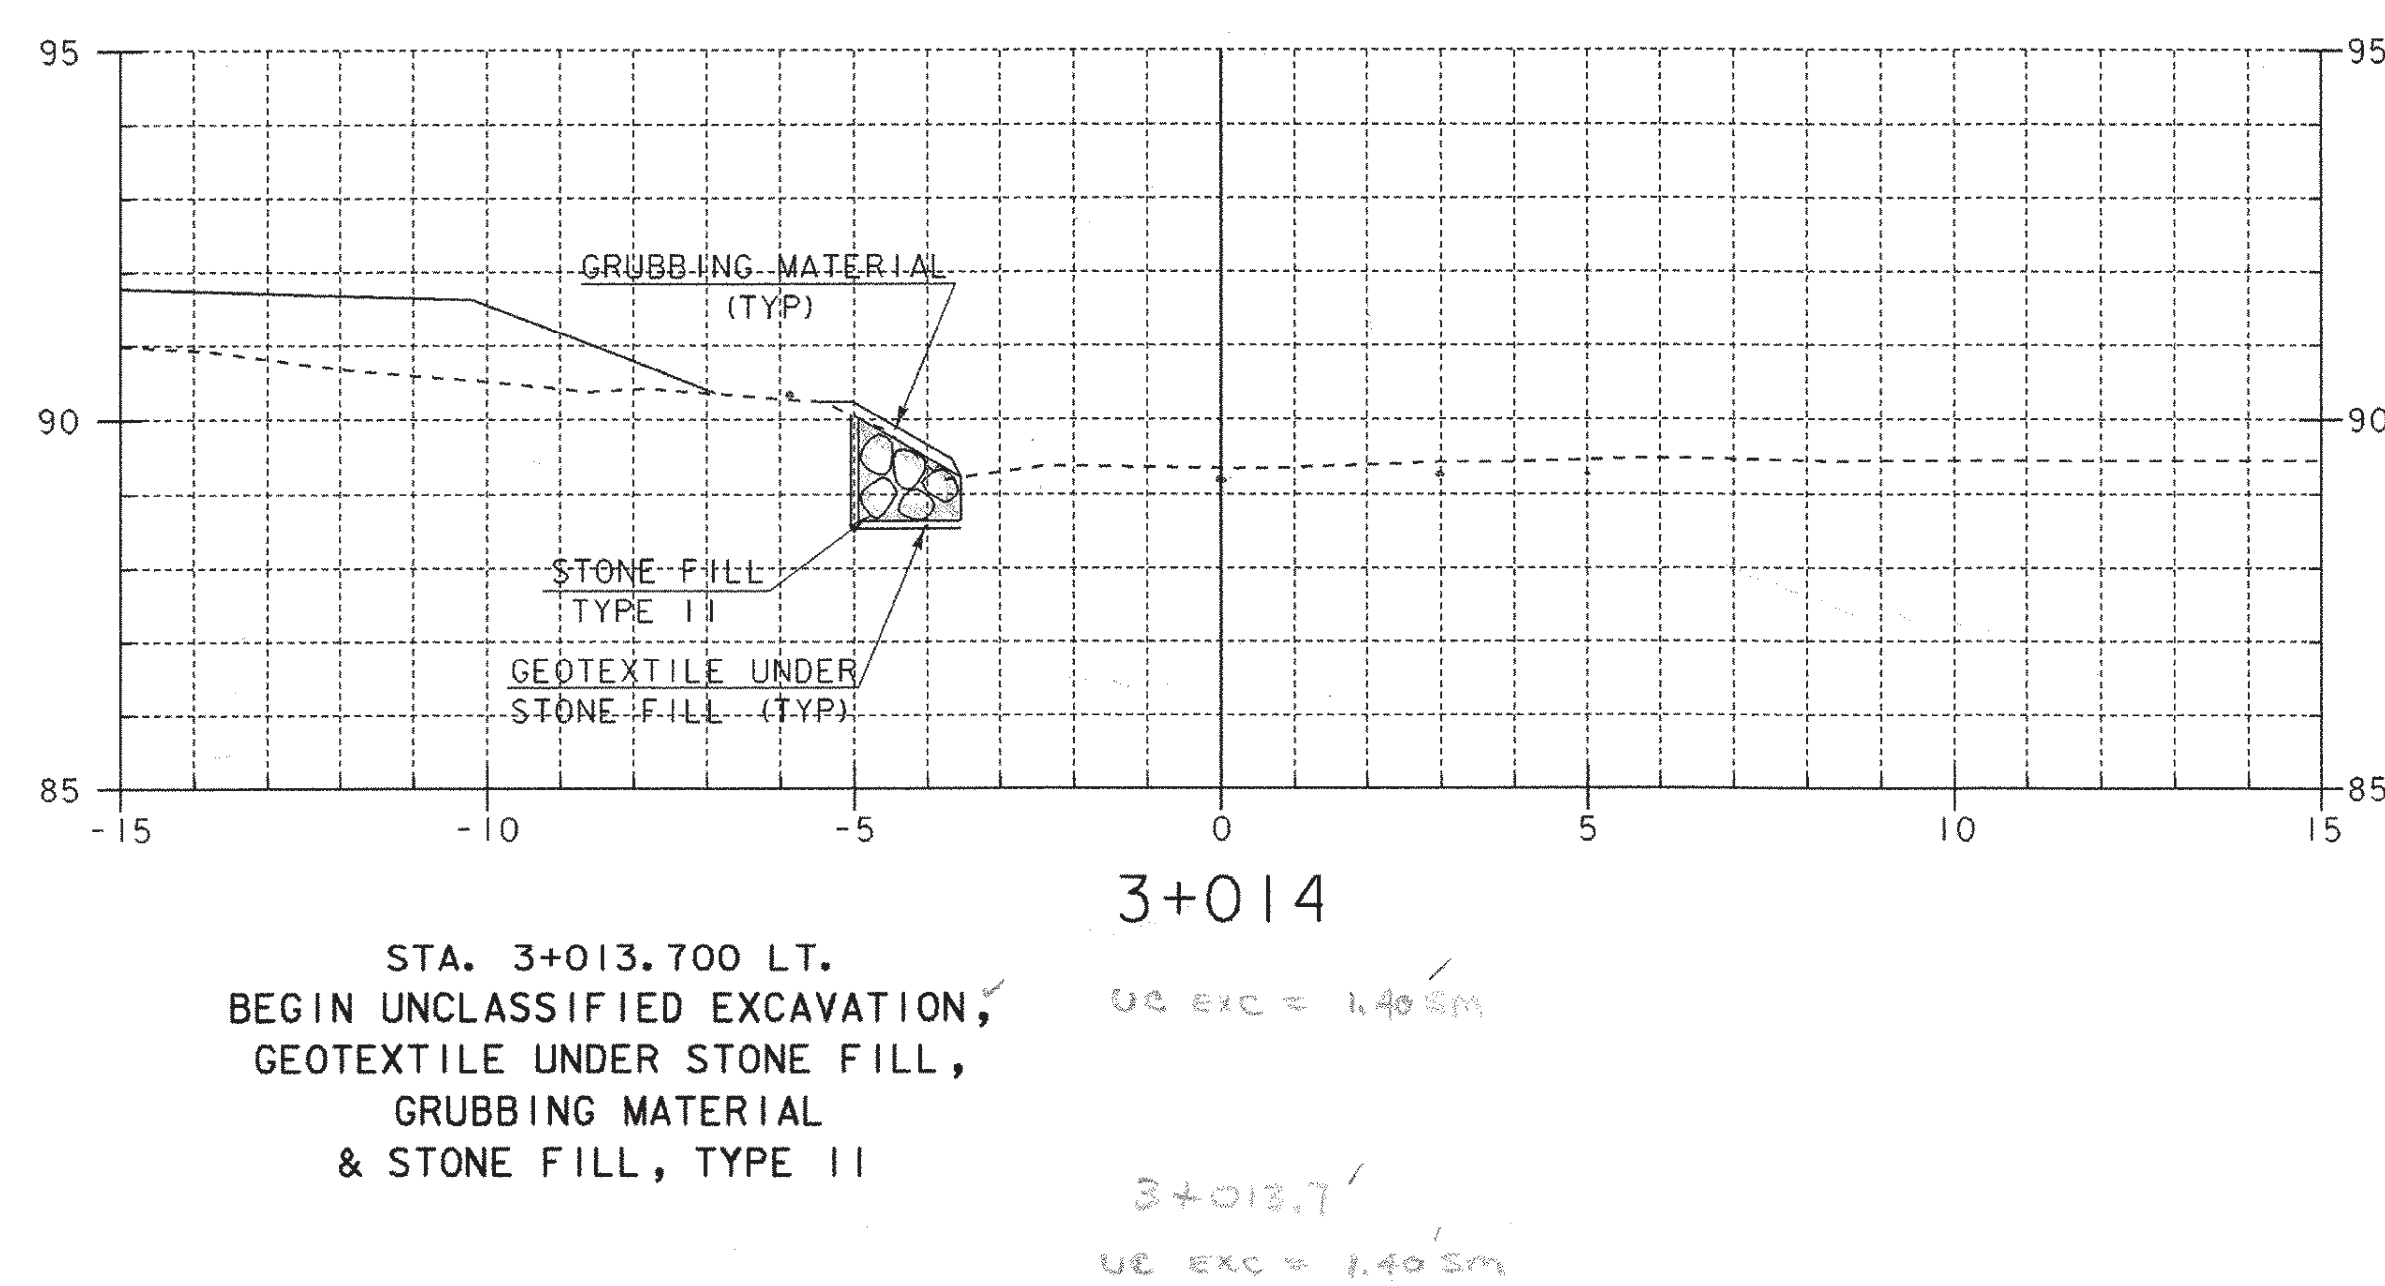
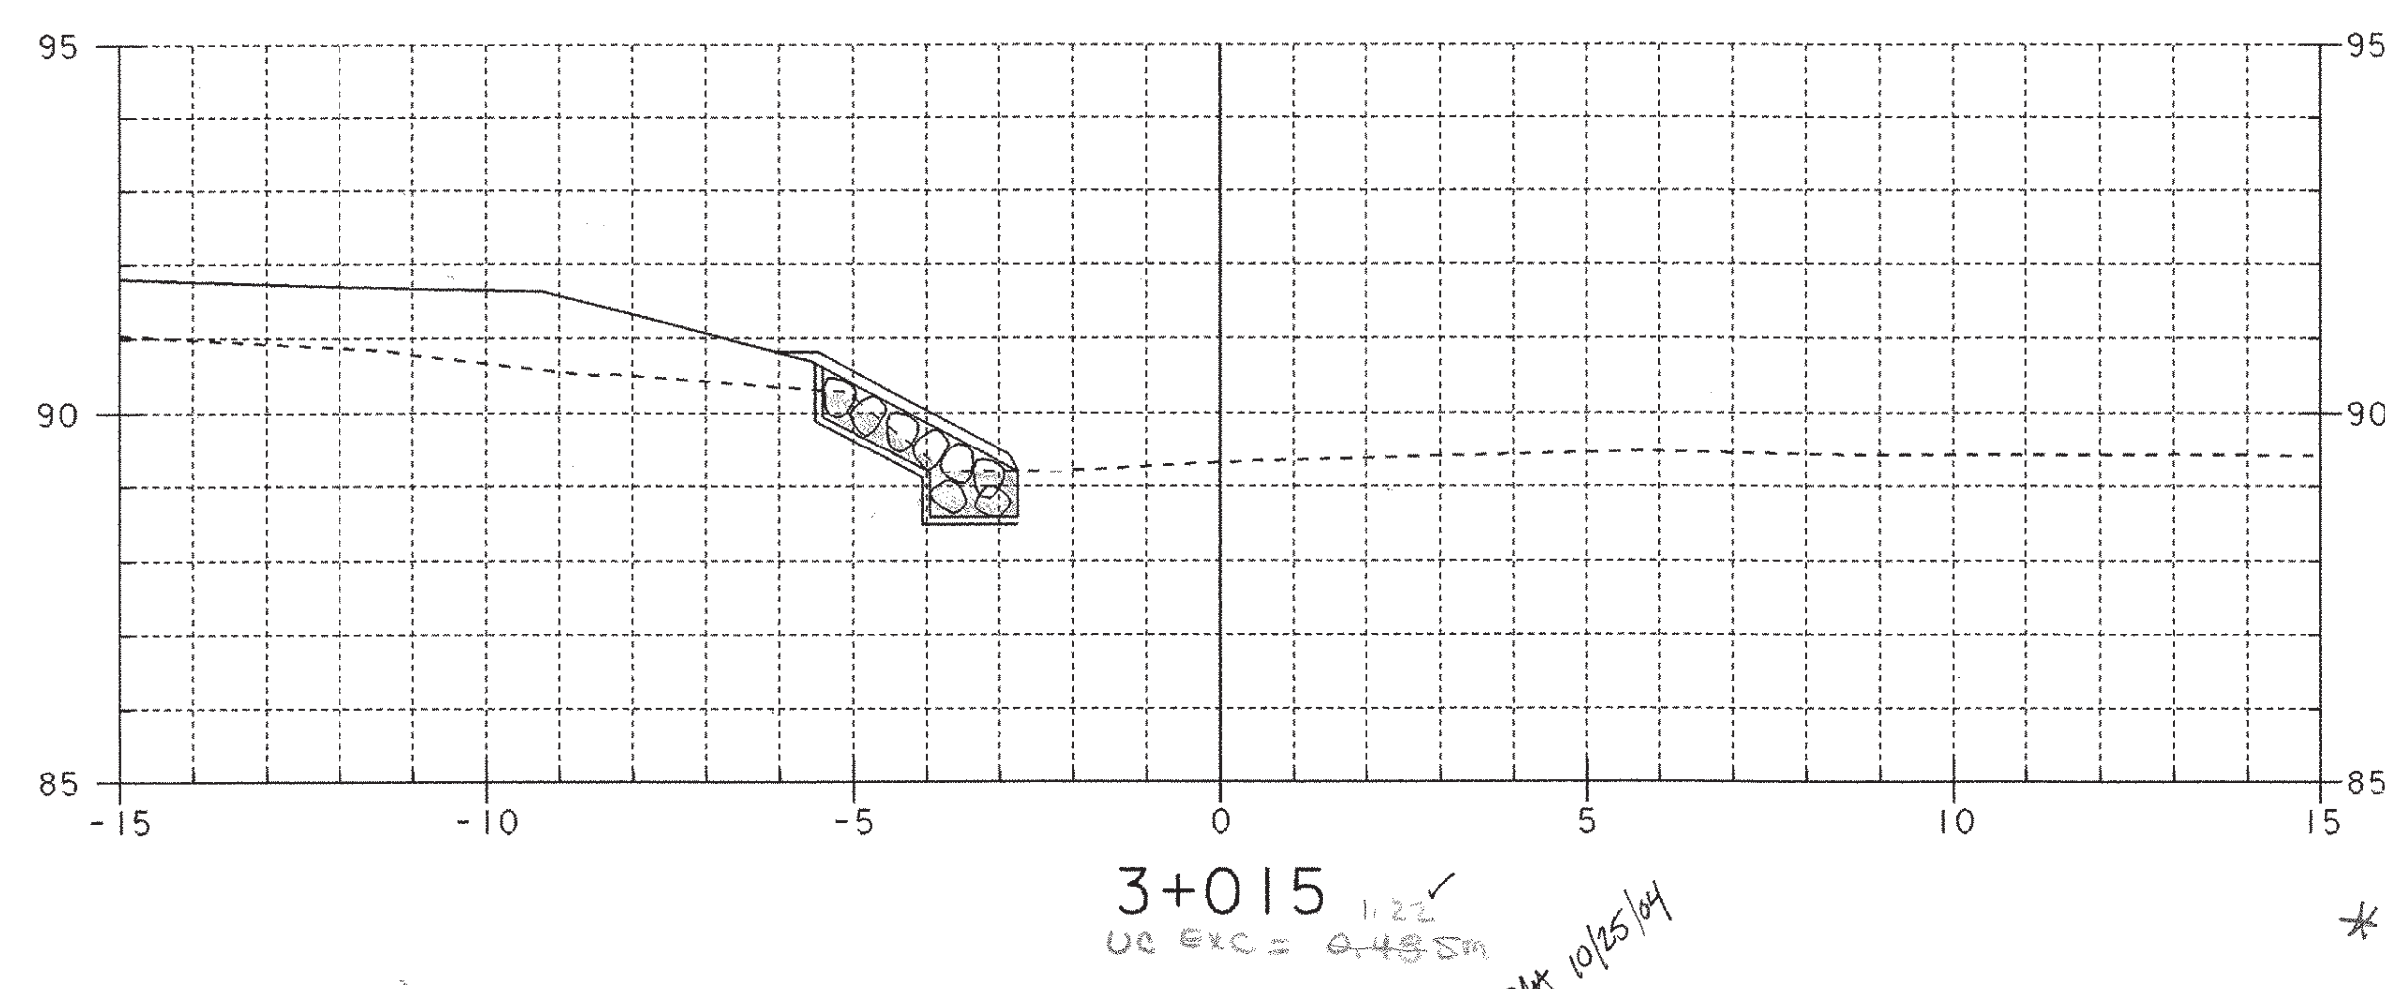


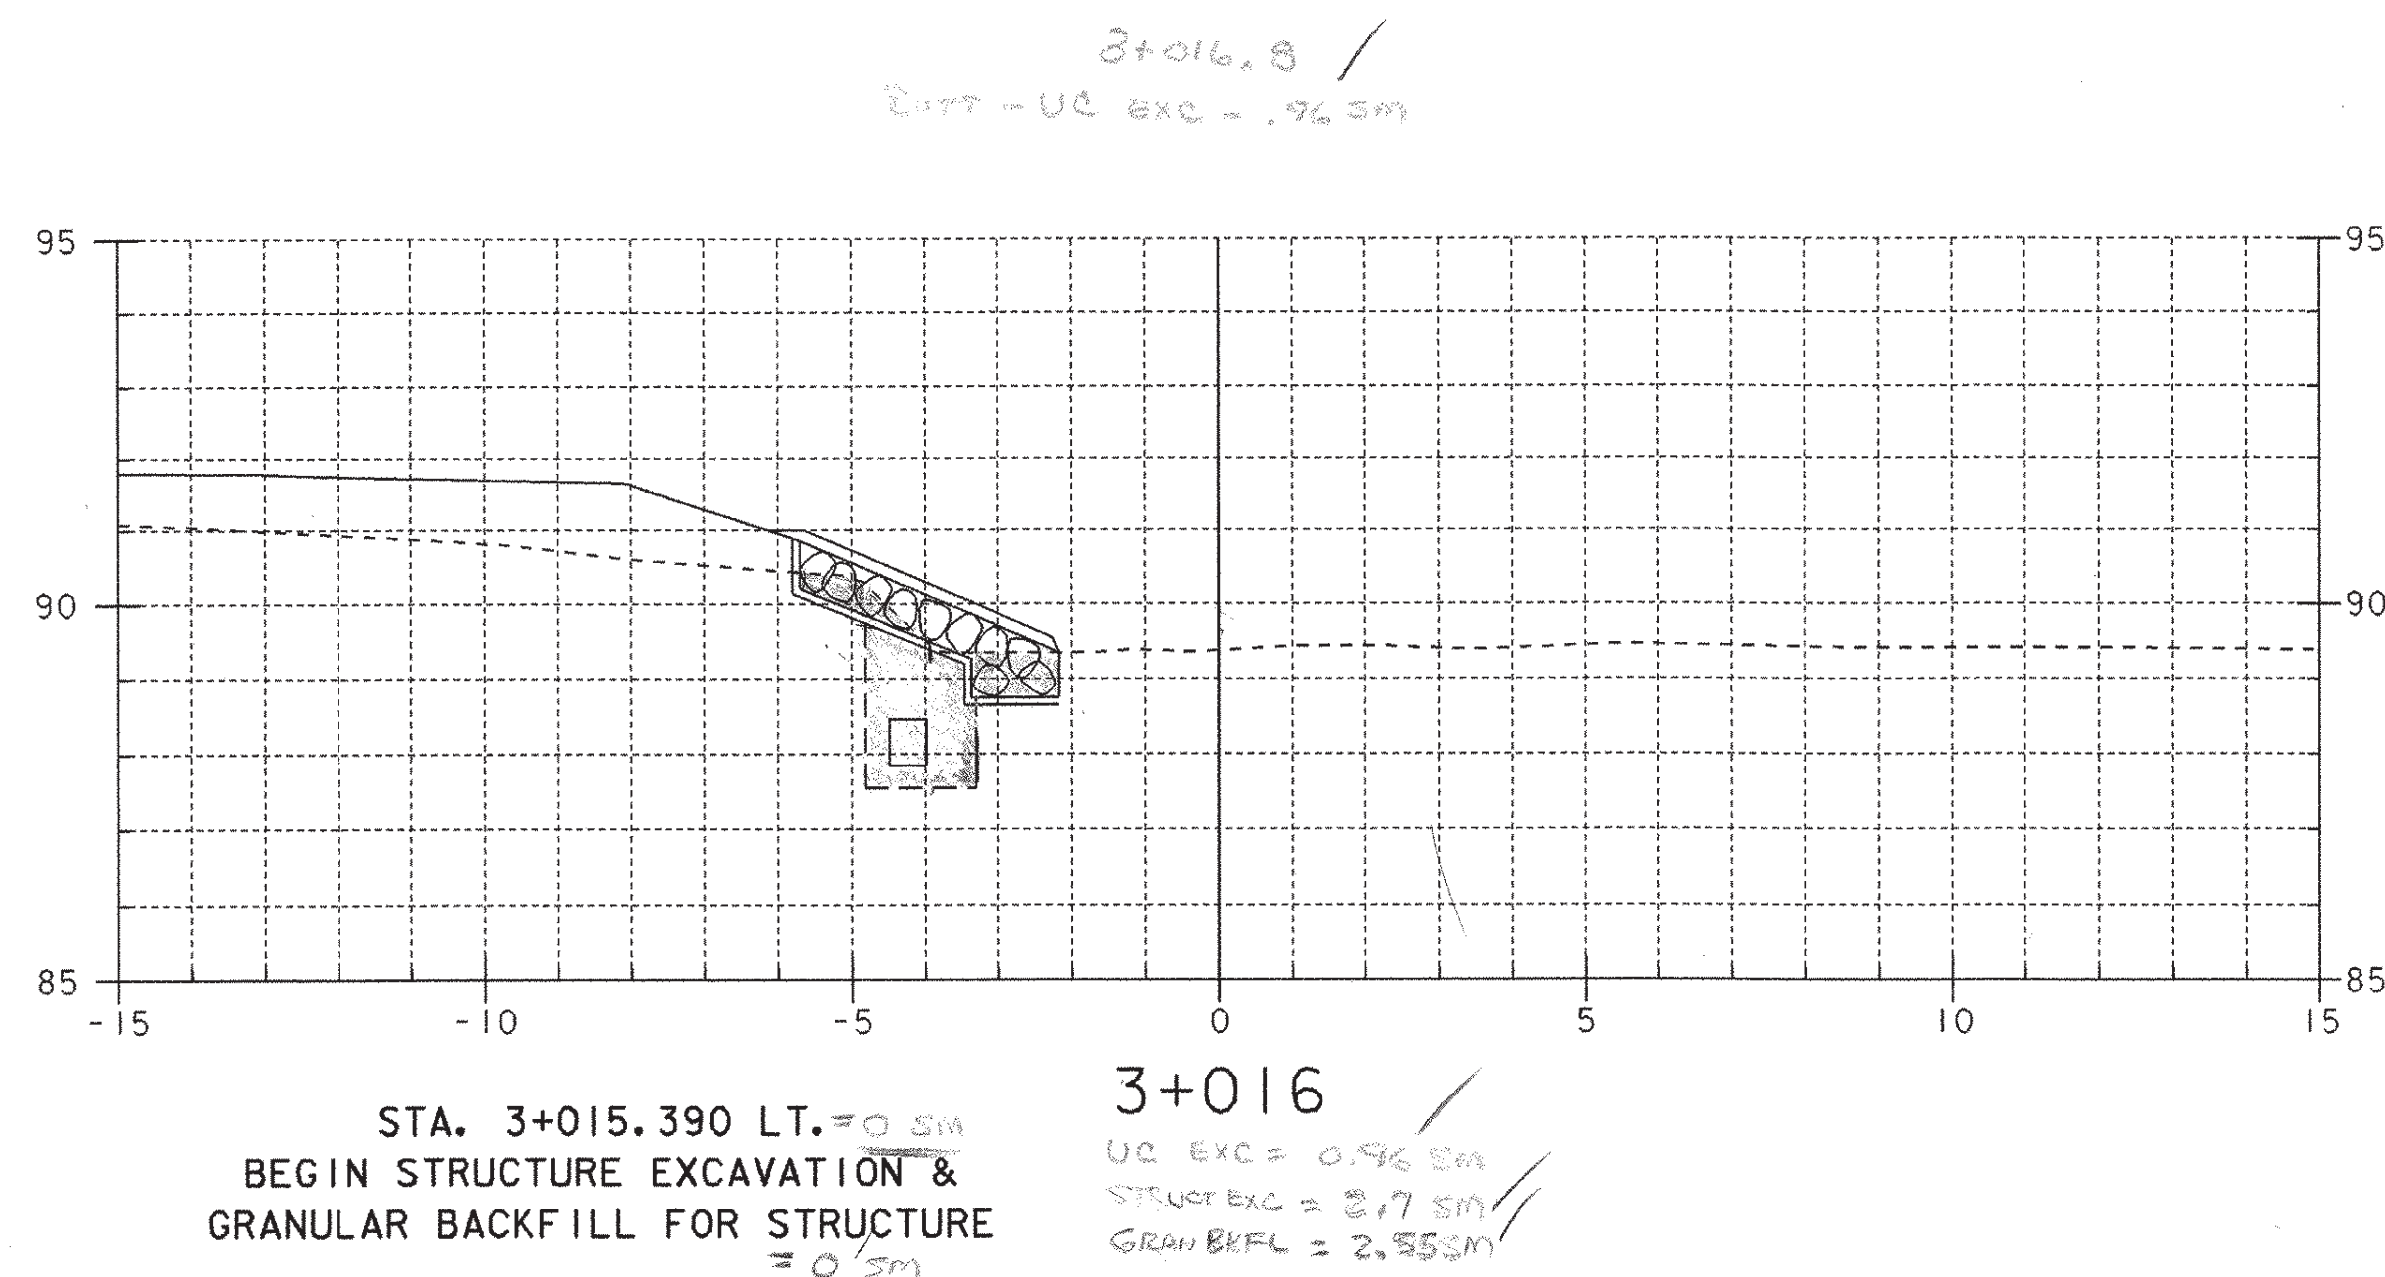

1/2 10-05-04  
10/25/04

|                                        |                        |
|----------------------------------------|------------------------|
| SHEET NAME: BOX CULVERT CROSS SECTIONS |                        |
| PROJECT NAME: FAIR HAVEN-HAMPTON       | HIGHWAY NO.: TH 6      |
| PROJECT NUMBER: BRO 1443(32)           | BRIDGE NO.: 6          |
|                                        | OVER: POULTNEY RIVER   |
| FILE NAME: /str1/93j021/sj021xs.dgn    | PLOT DATE: 28-JAN-2003 |
| PROJECT MANAGER: G.S. ROGERS           | DRAWN BY: STRI         |
| DESIGNED BY: C. MEUNIER                | IPARM NAME: sj021bx1.i |
| BRIDGE SHEET NUMBER:                   | SHEET 49 OF 53         |