

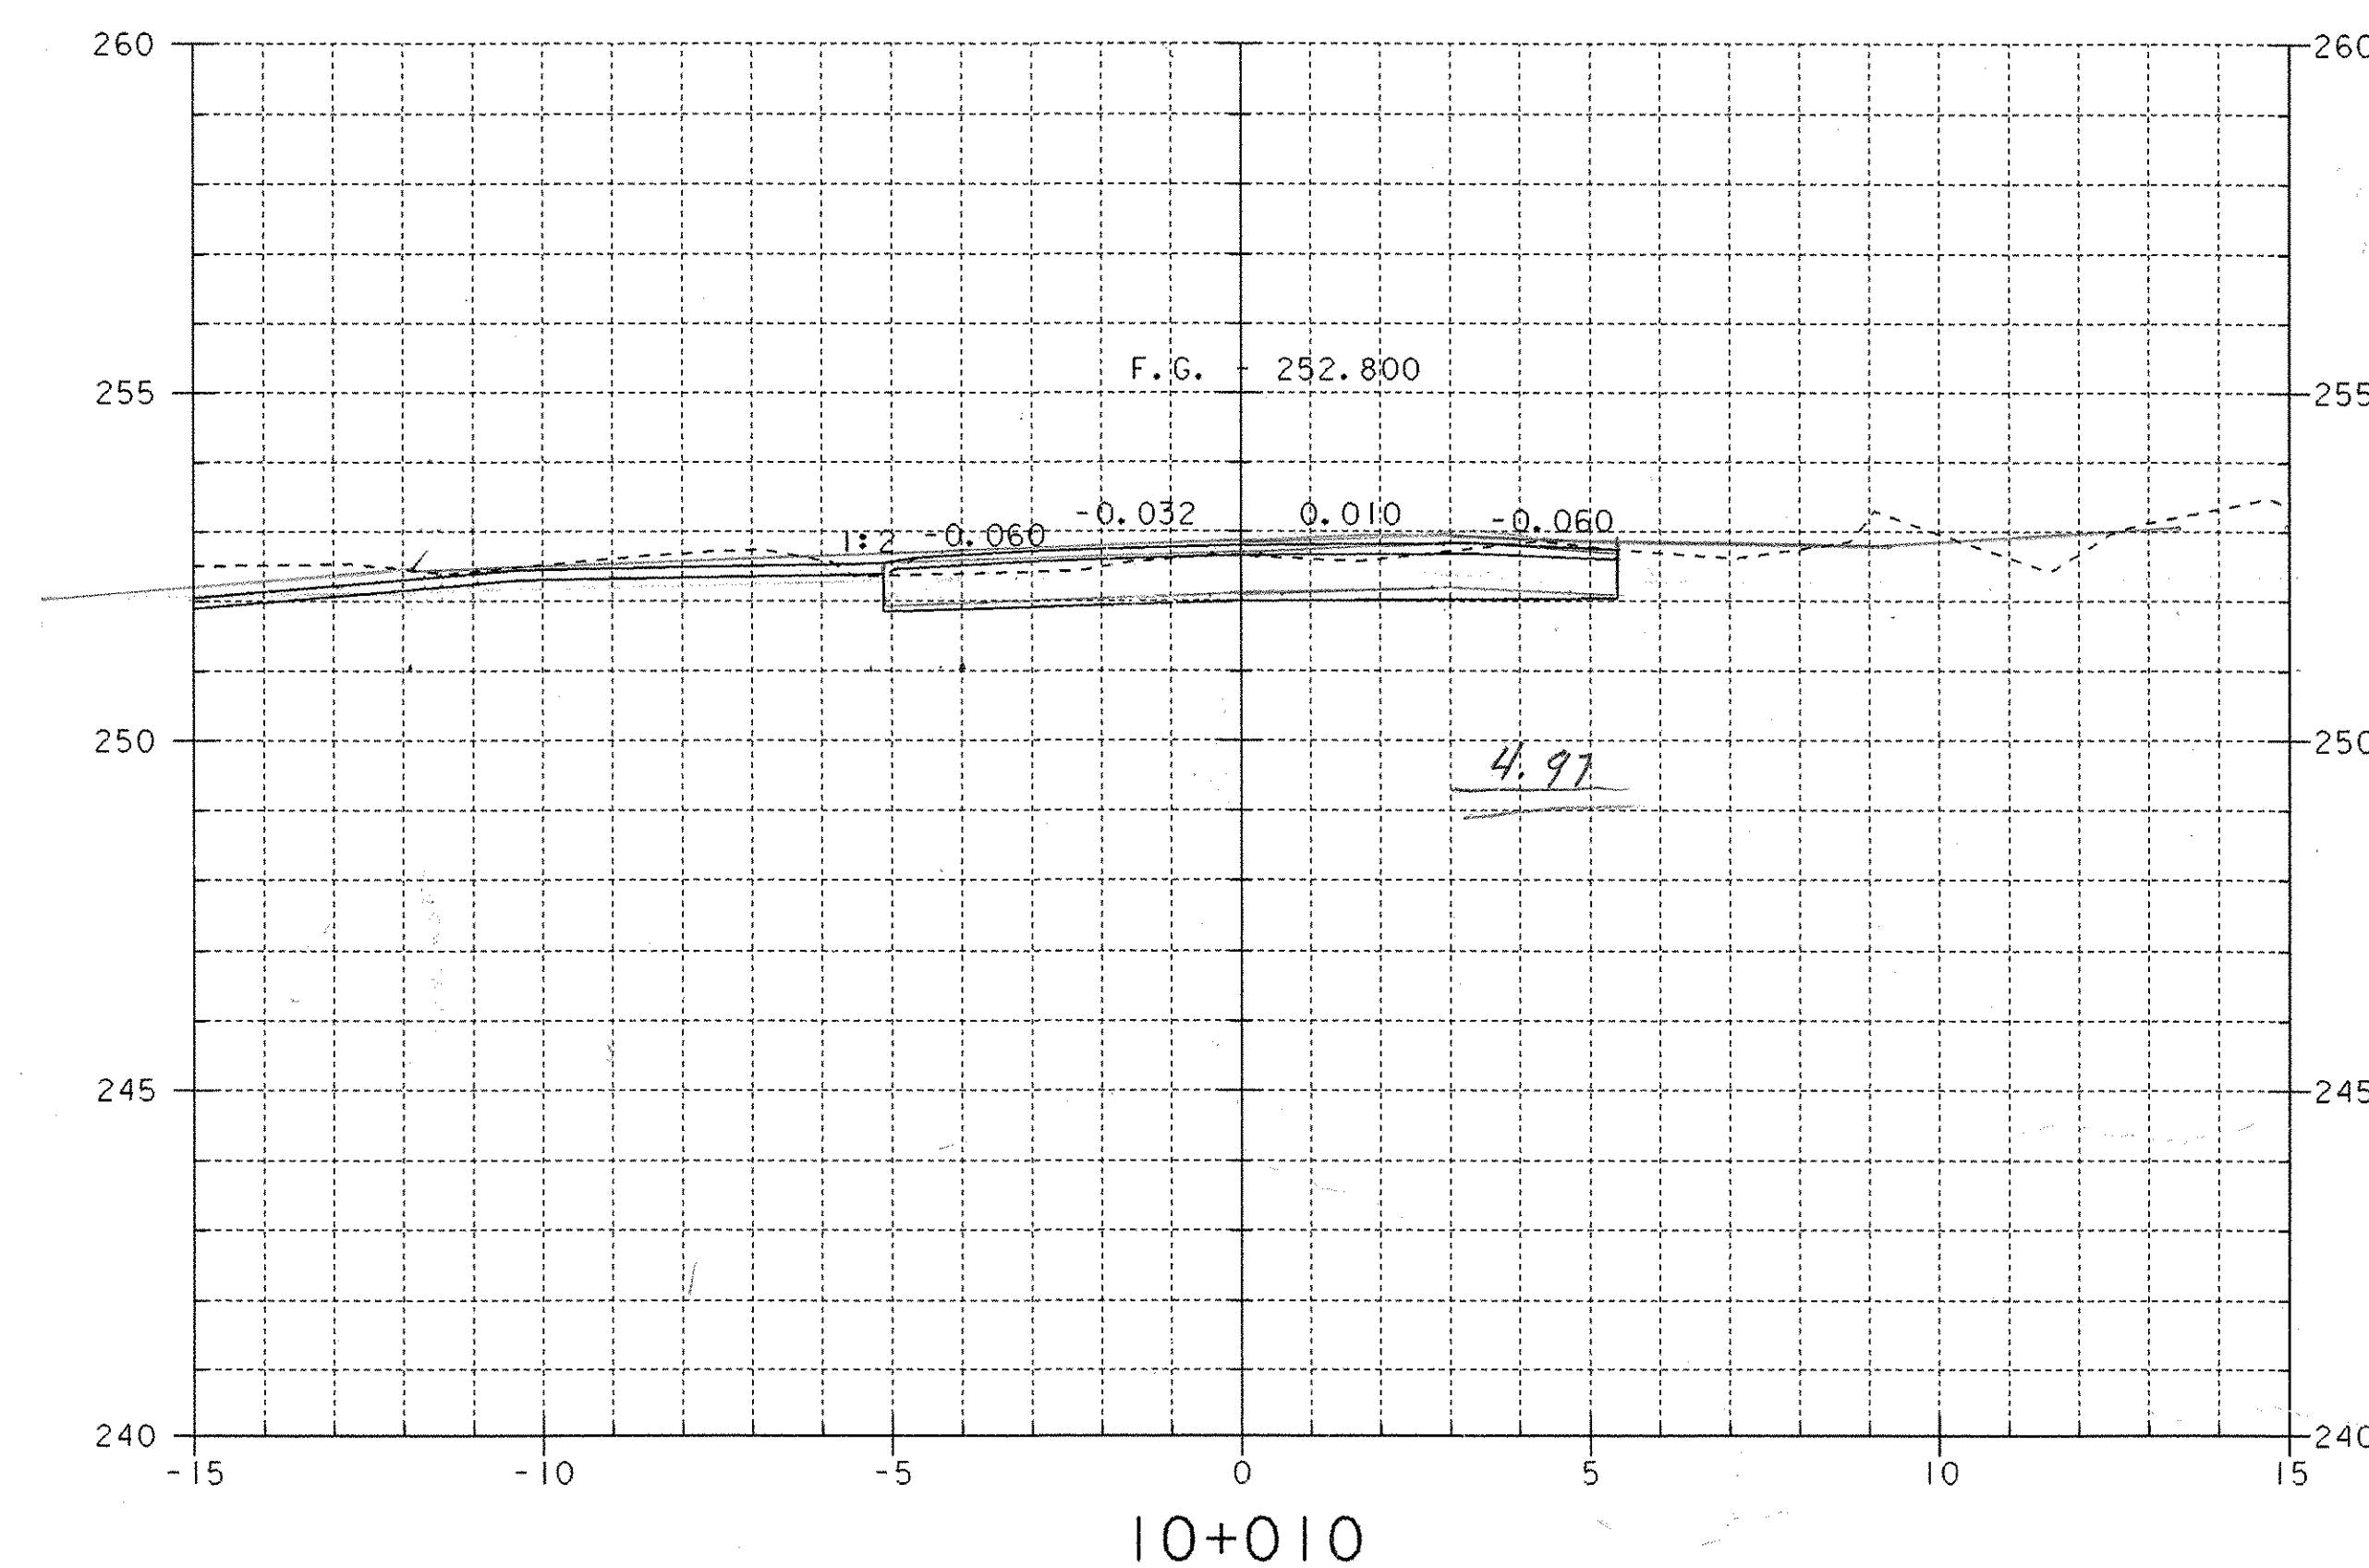
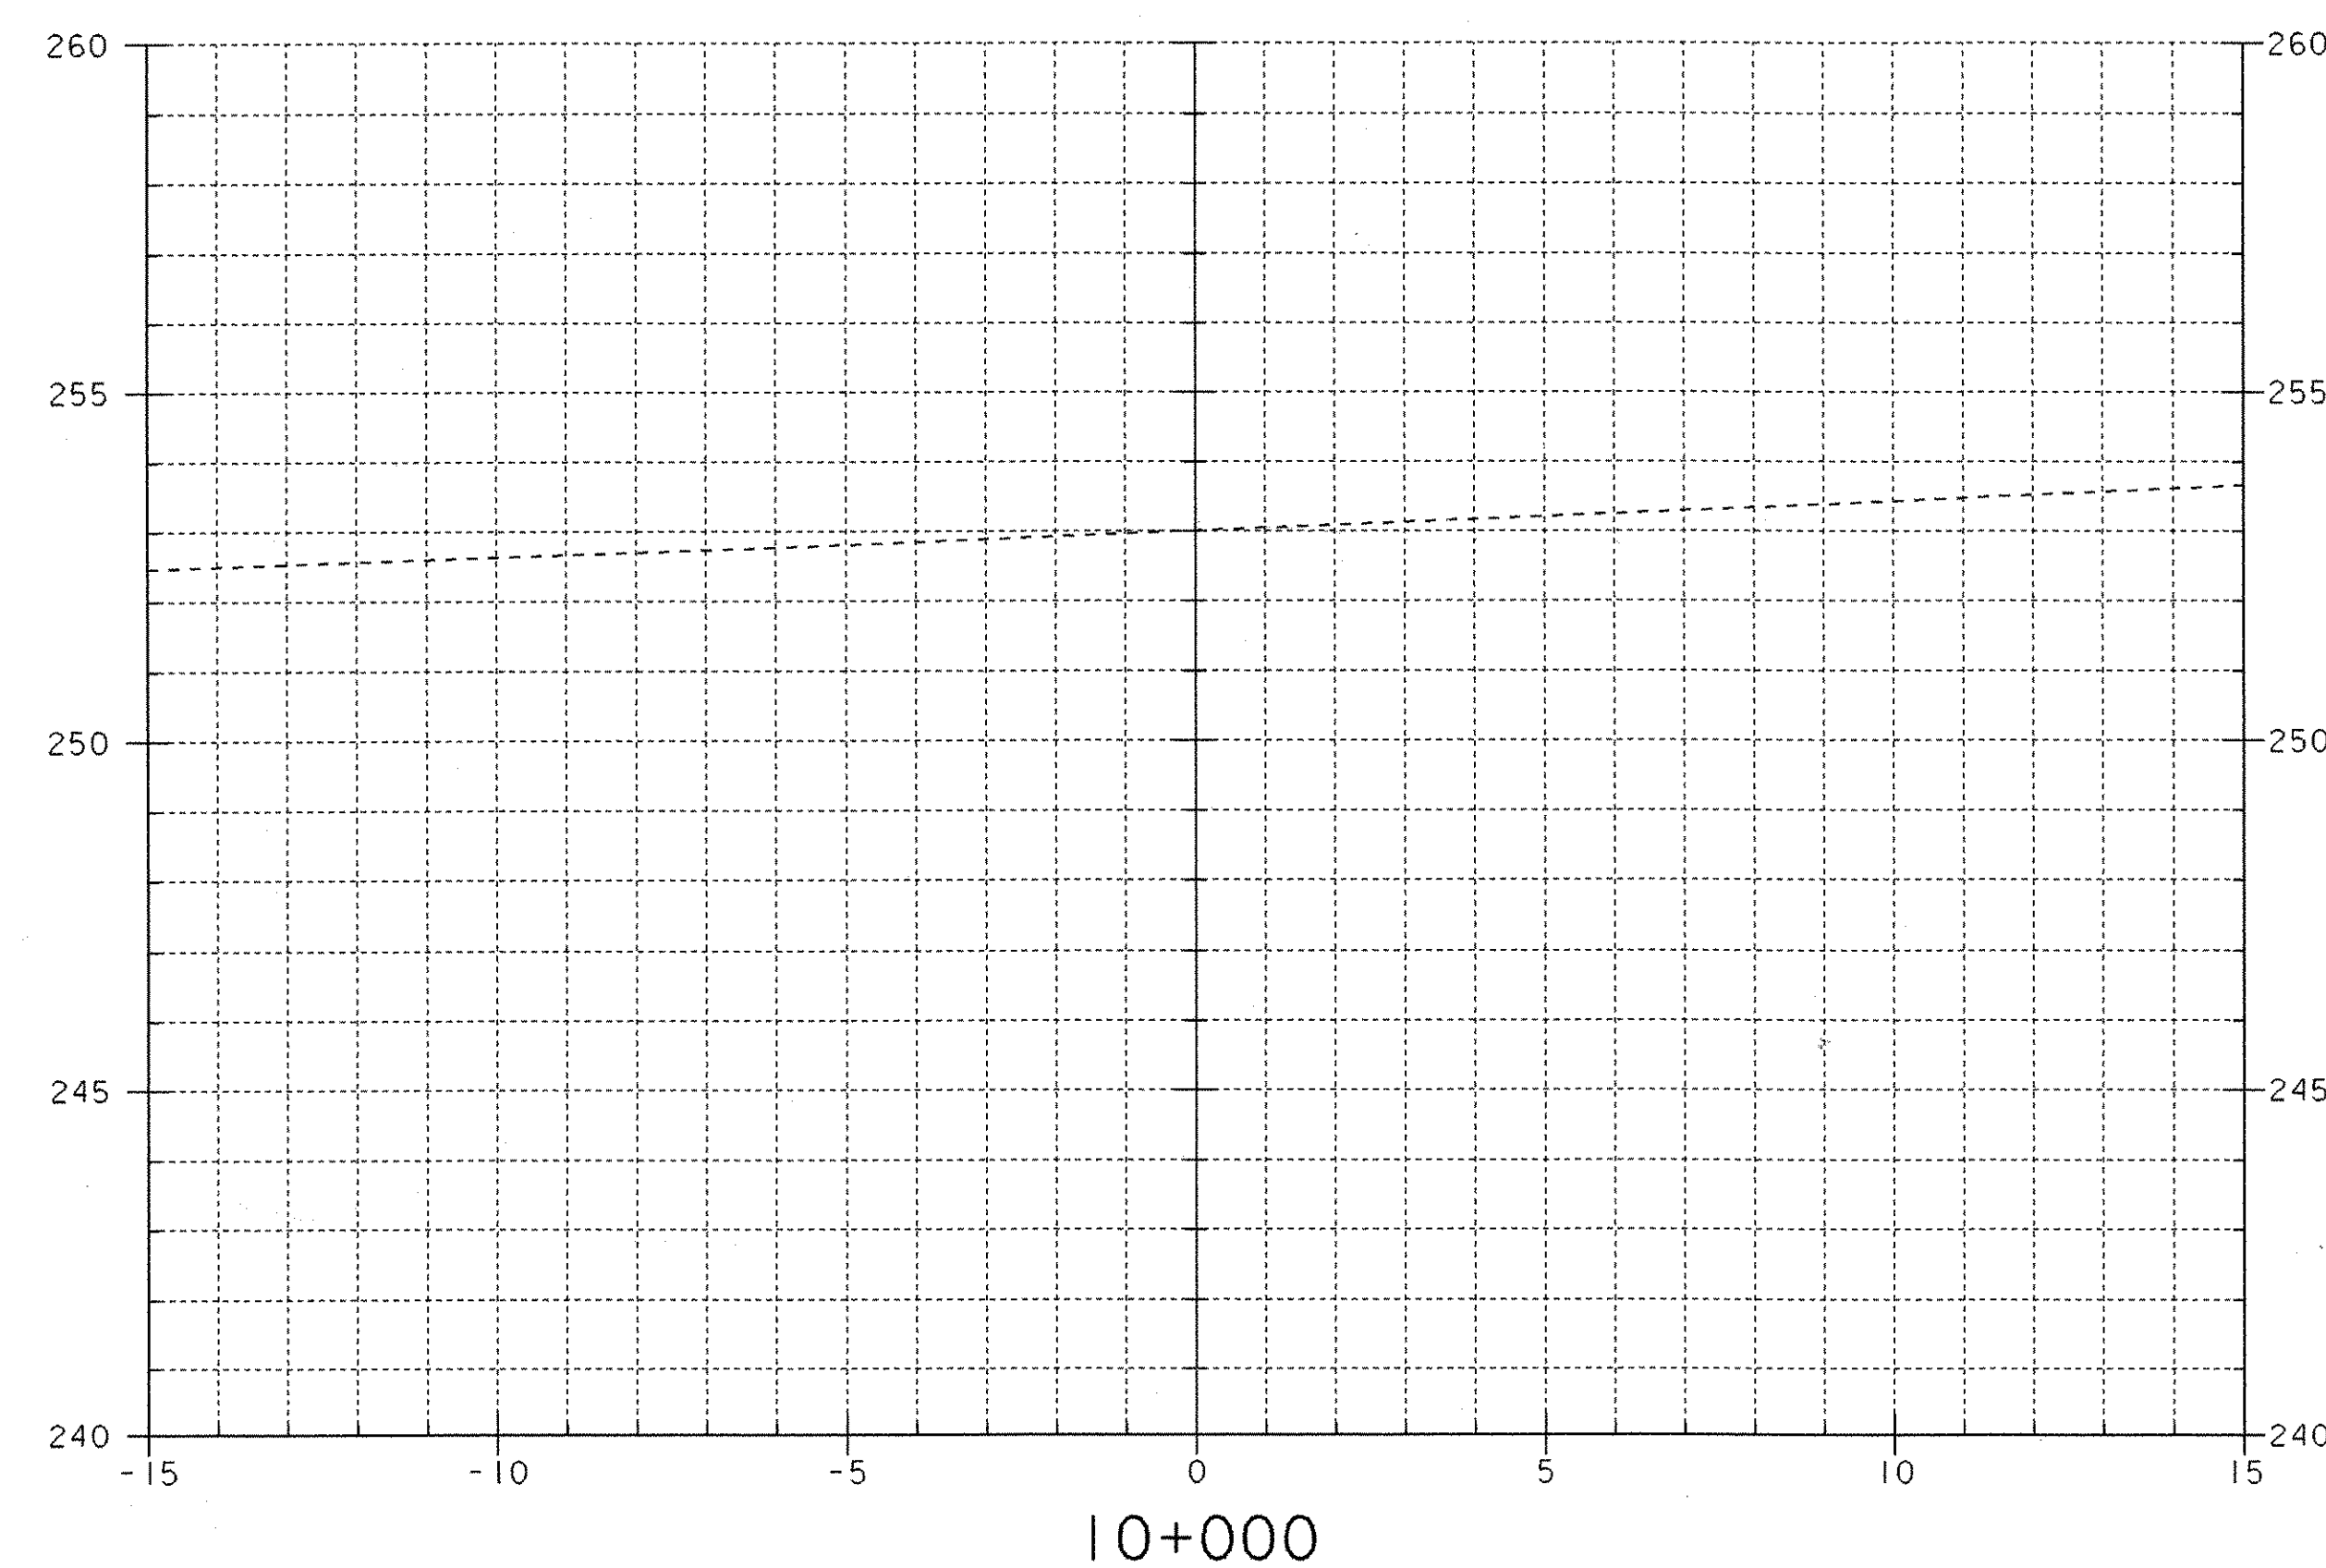


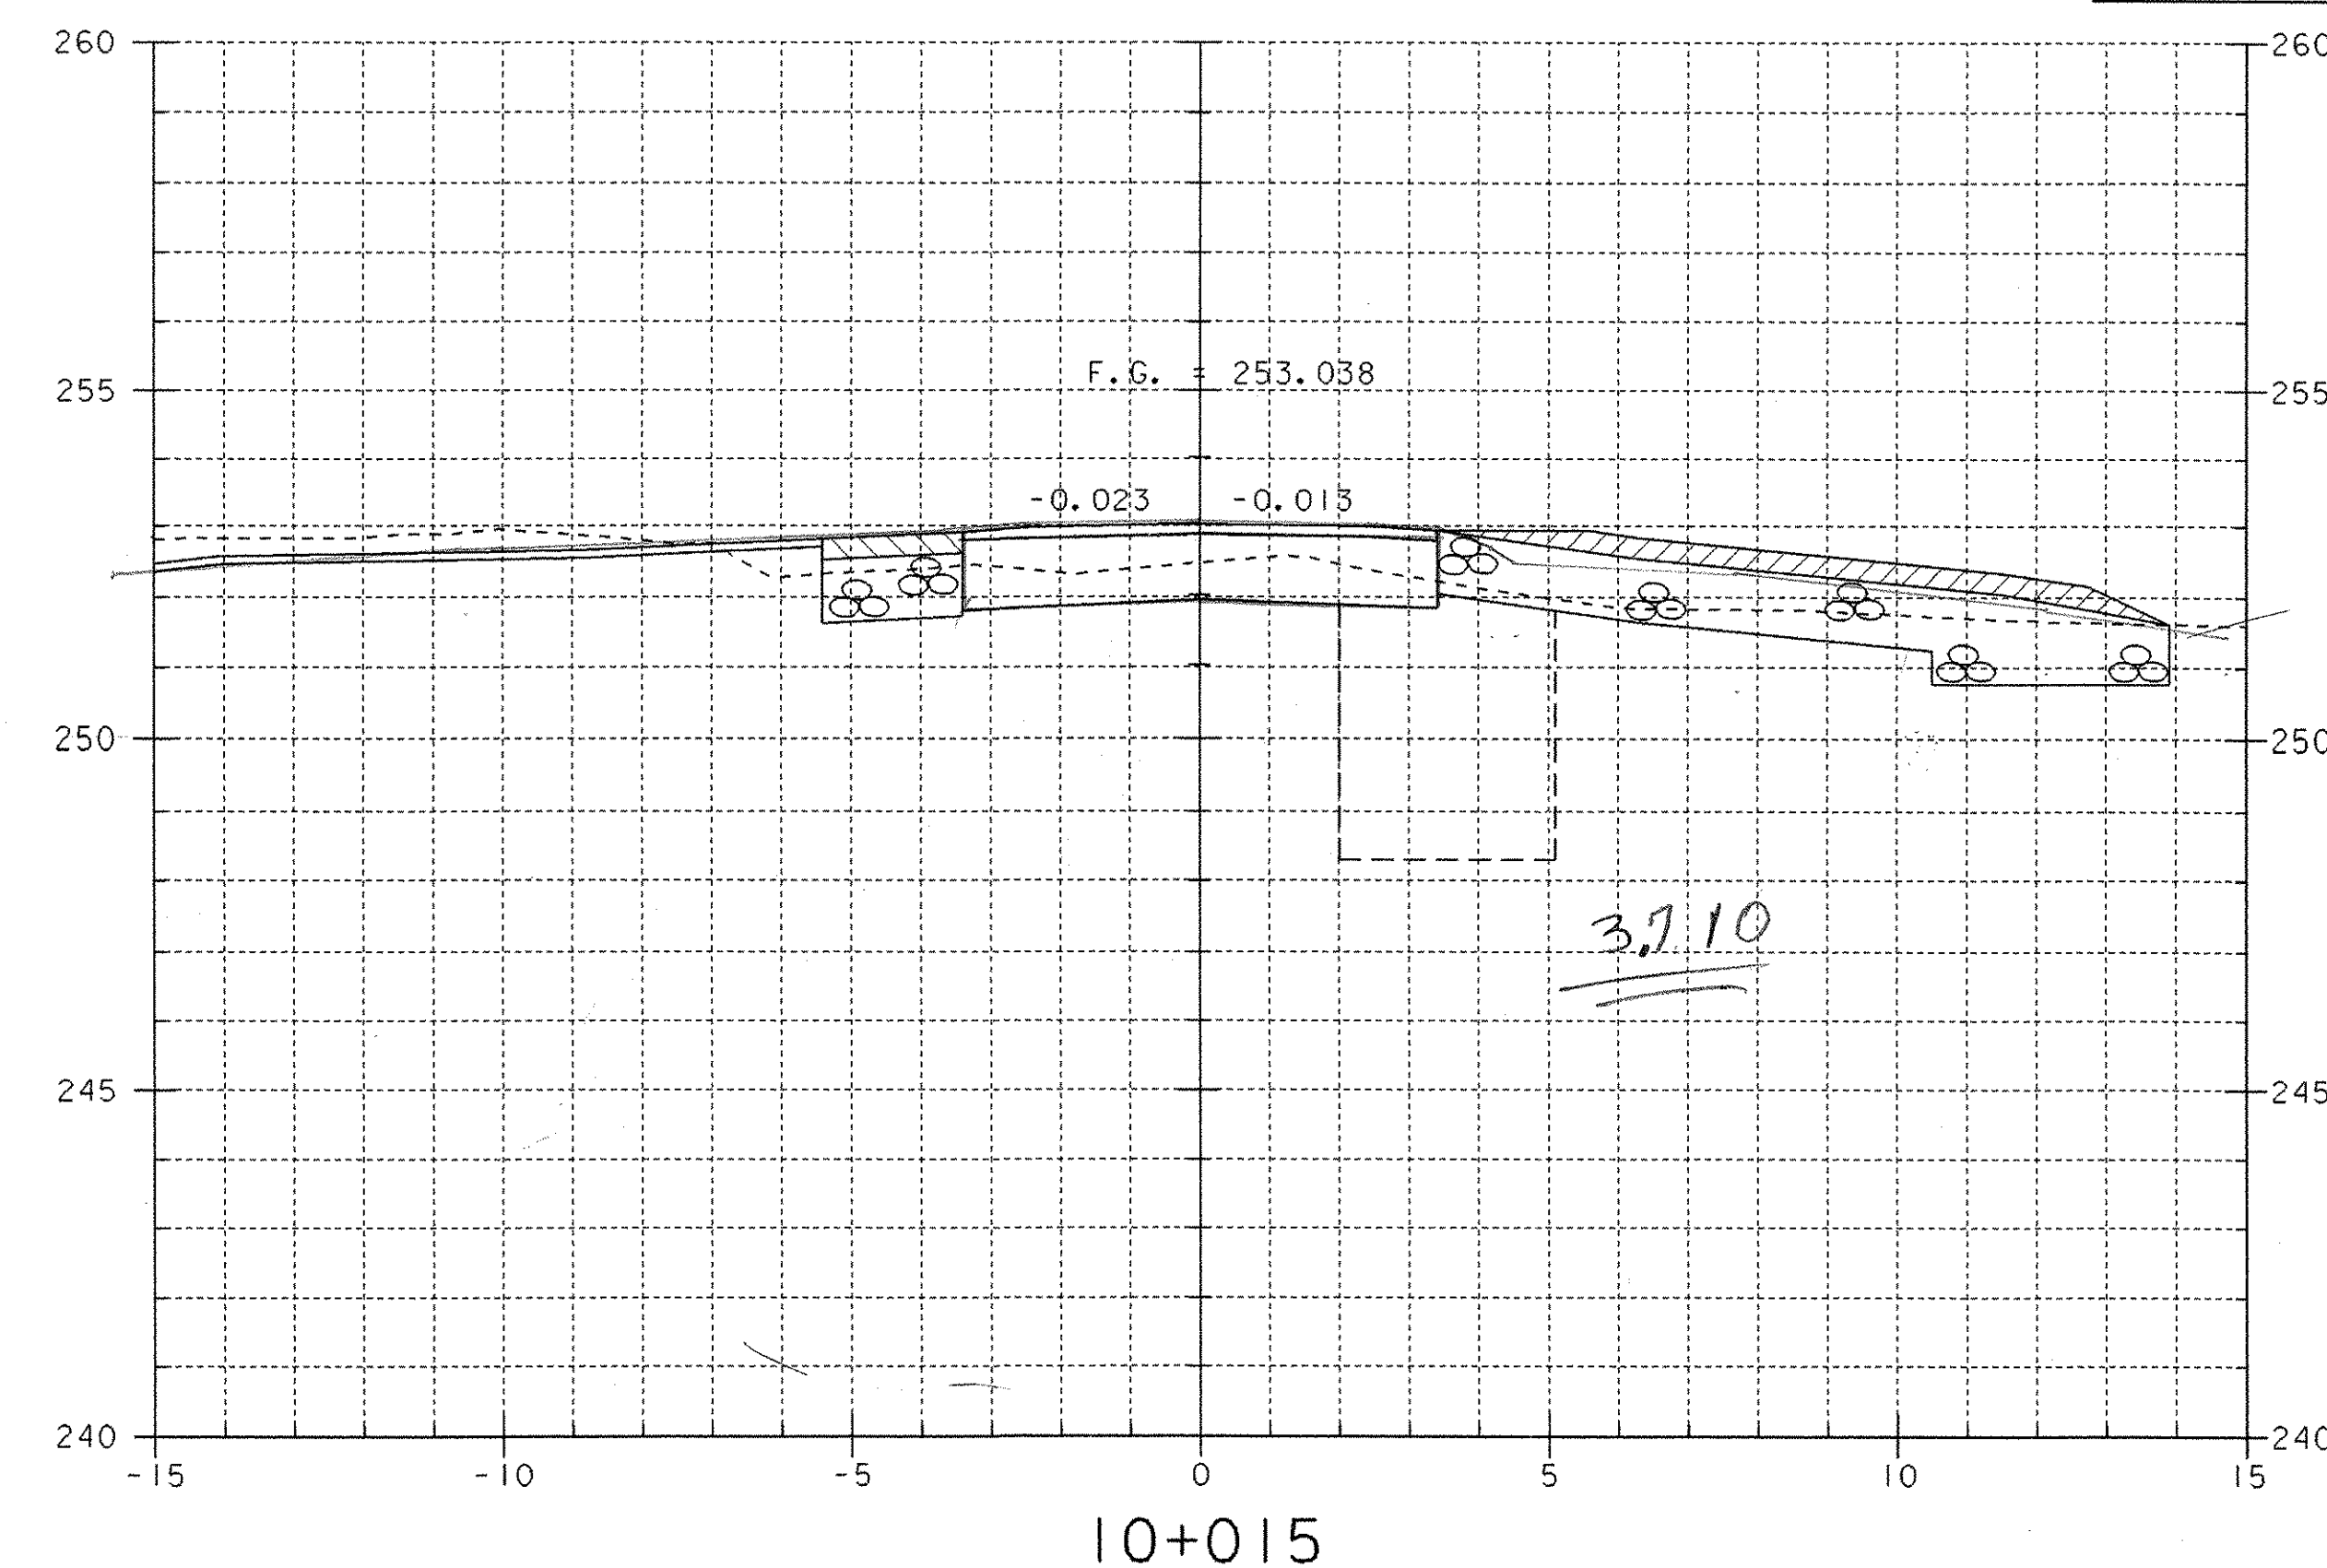

MAINLINE CROSS SECTIONS (1)

PROJECT NAME: HUNTINGTON
PROJECT NUMBER: BRO 1445 (21)

FILE NAME: 93J029\Structures\sj029m01.i PLOT DATE: 09-JAN-2004
PROJECT MANAGER: R.R. WHITCOMB DRAWN BY: J. ARMSTRONG
DESIGNED BY: J. ARMSTRONG CHECKED BY: M. LOZIER
SHEET 24 OF 34

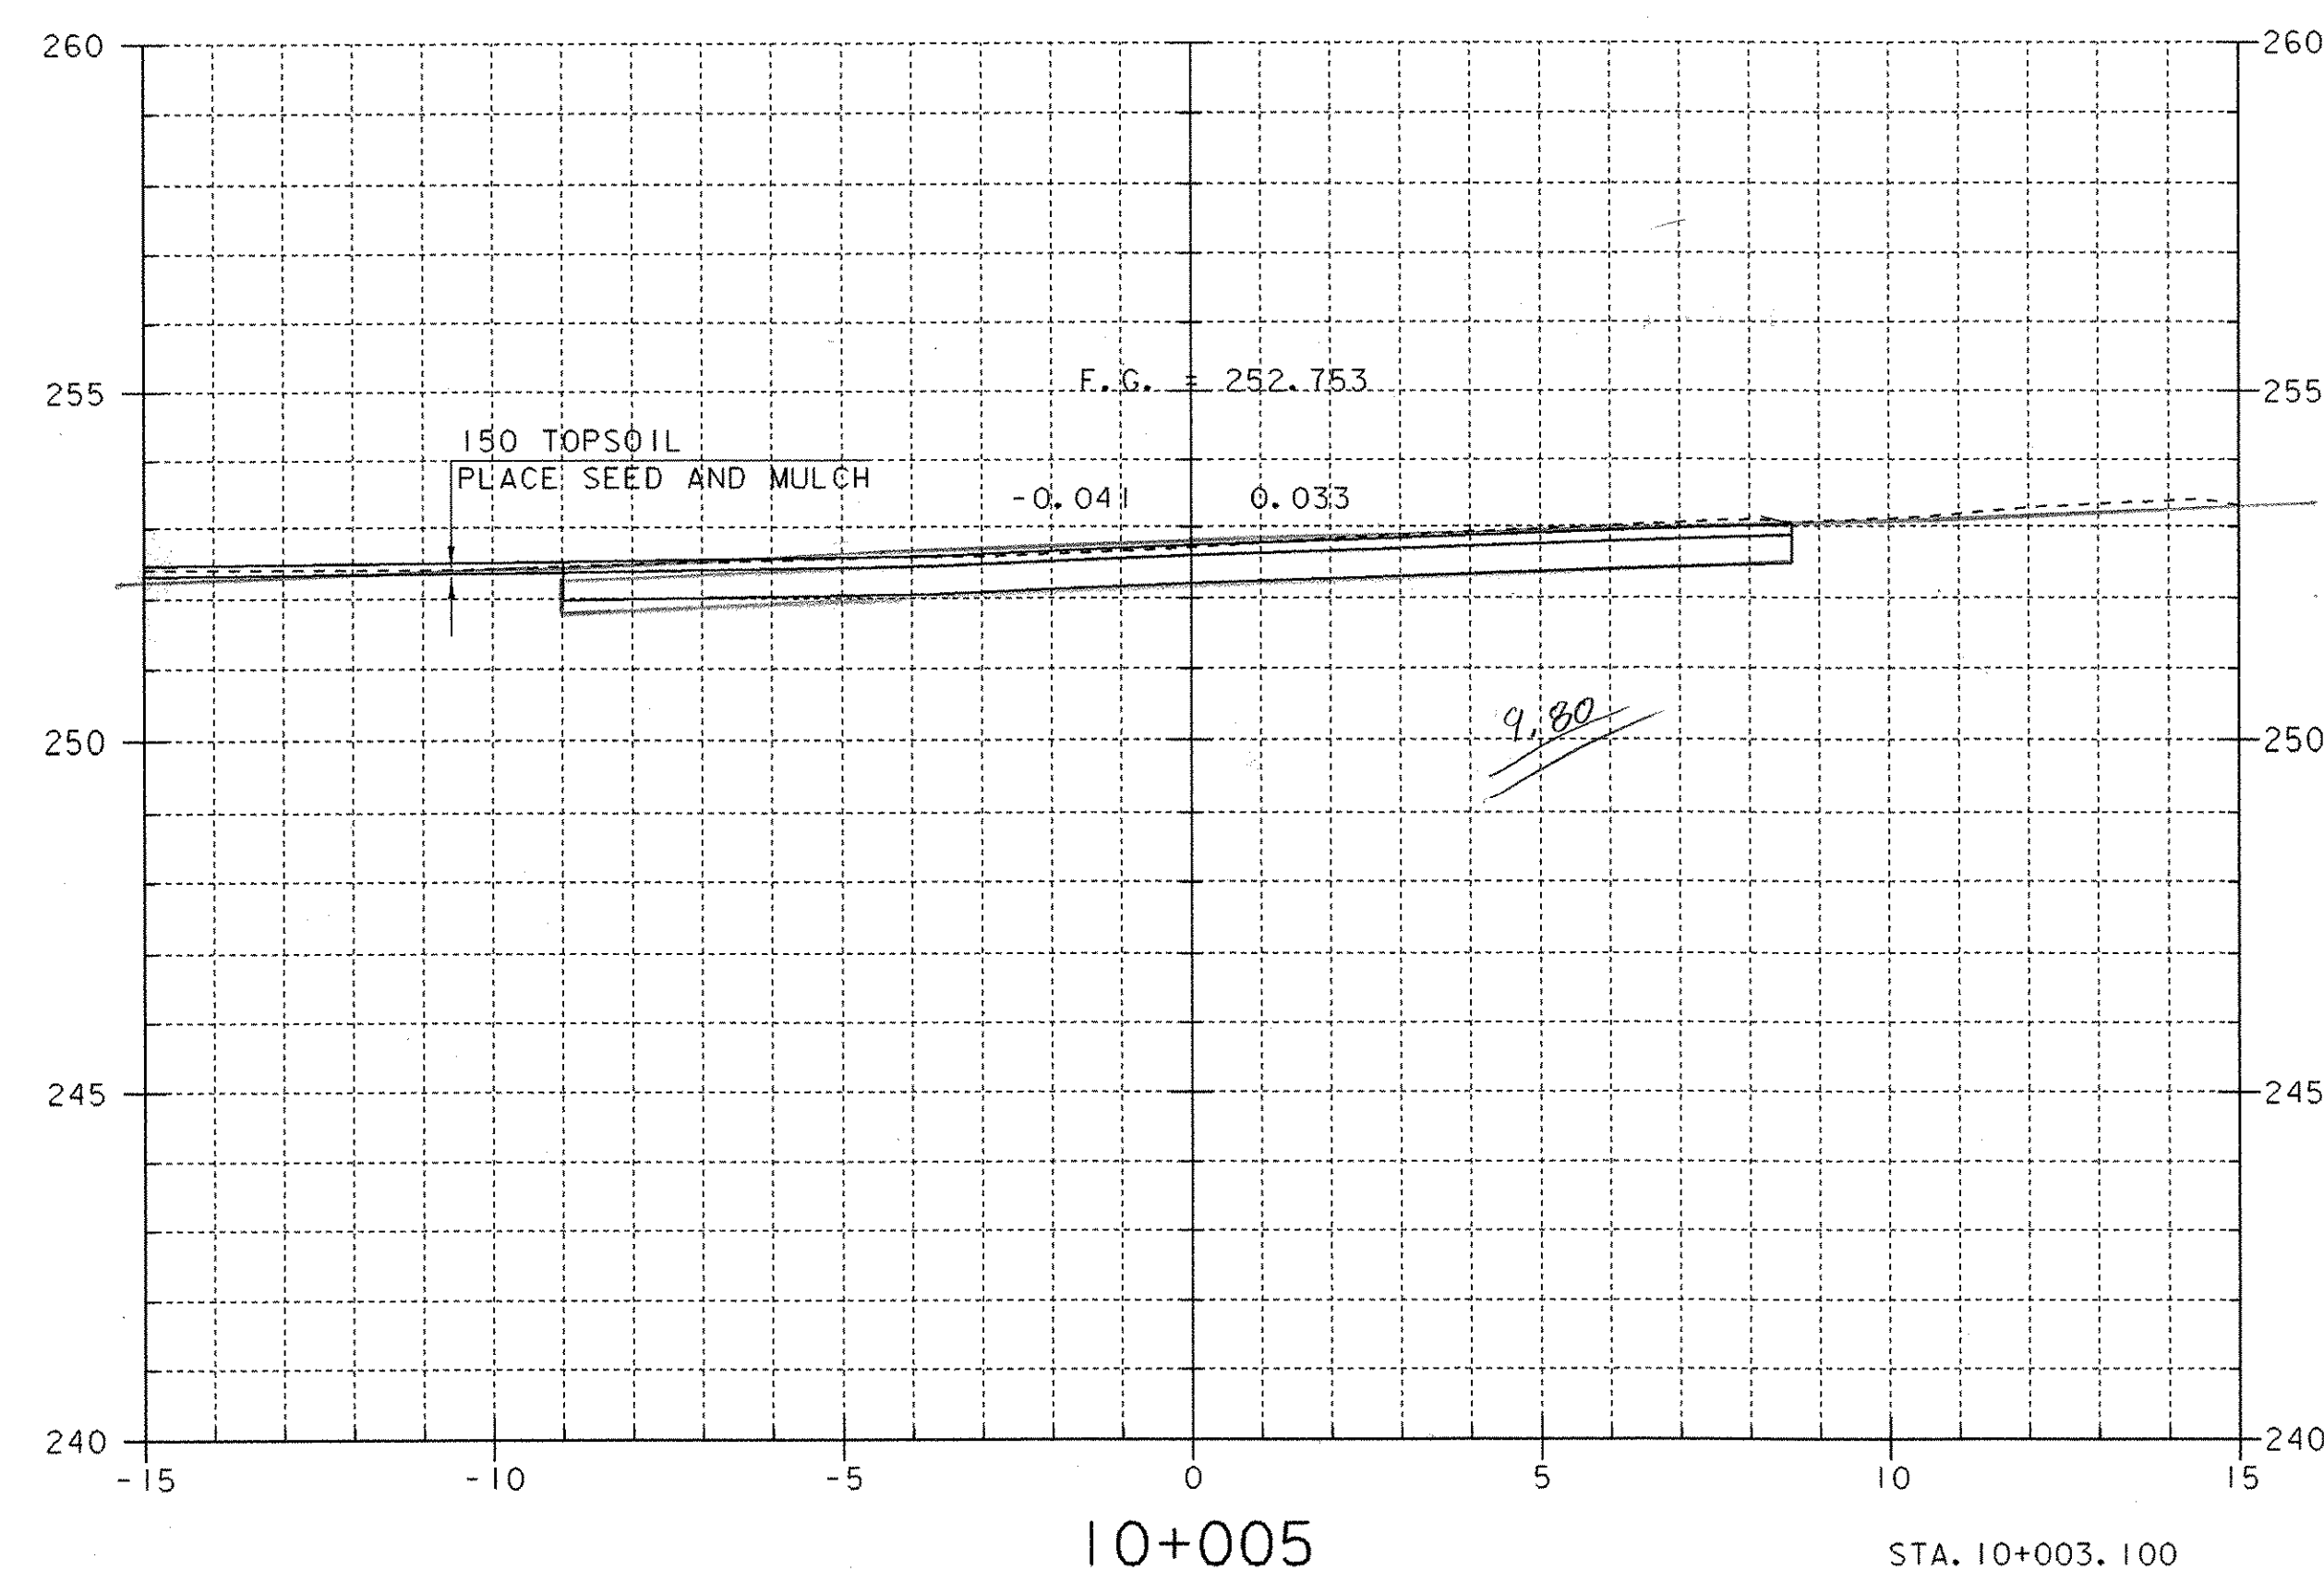