
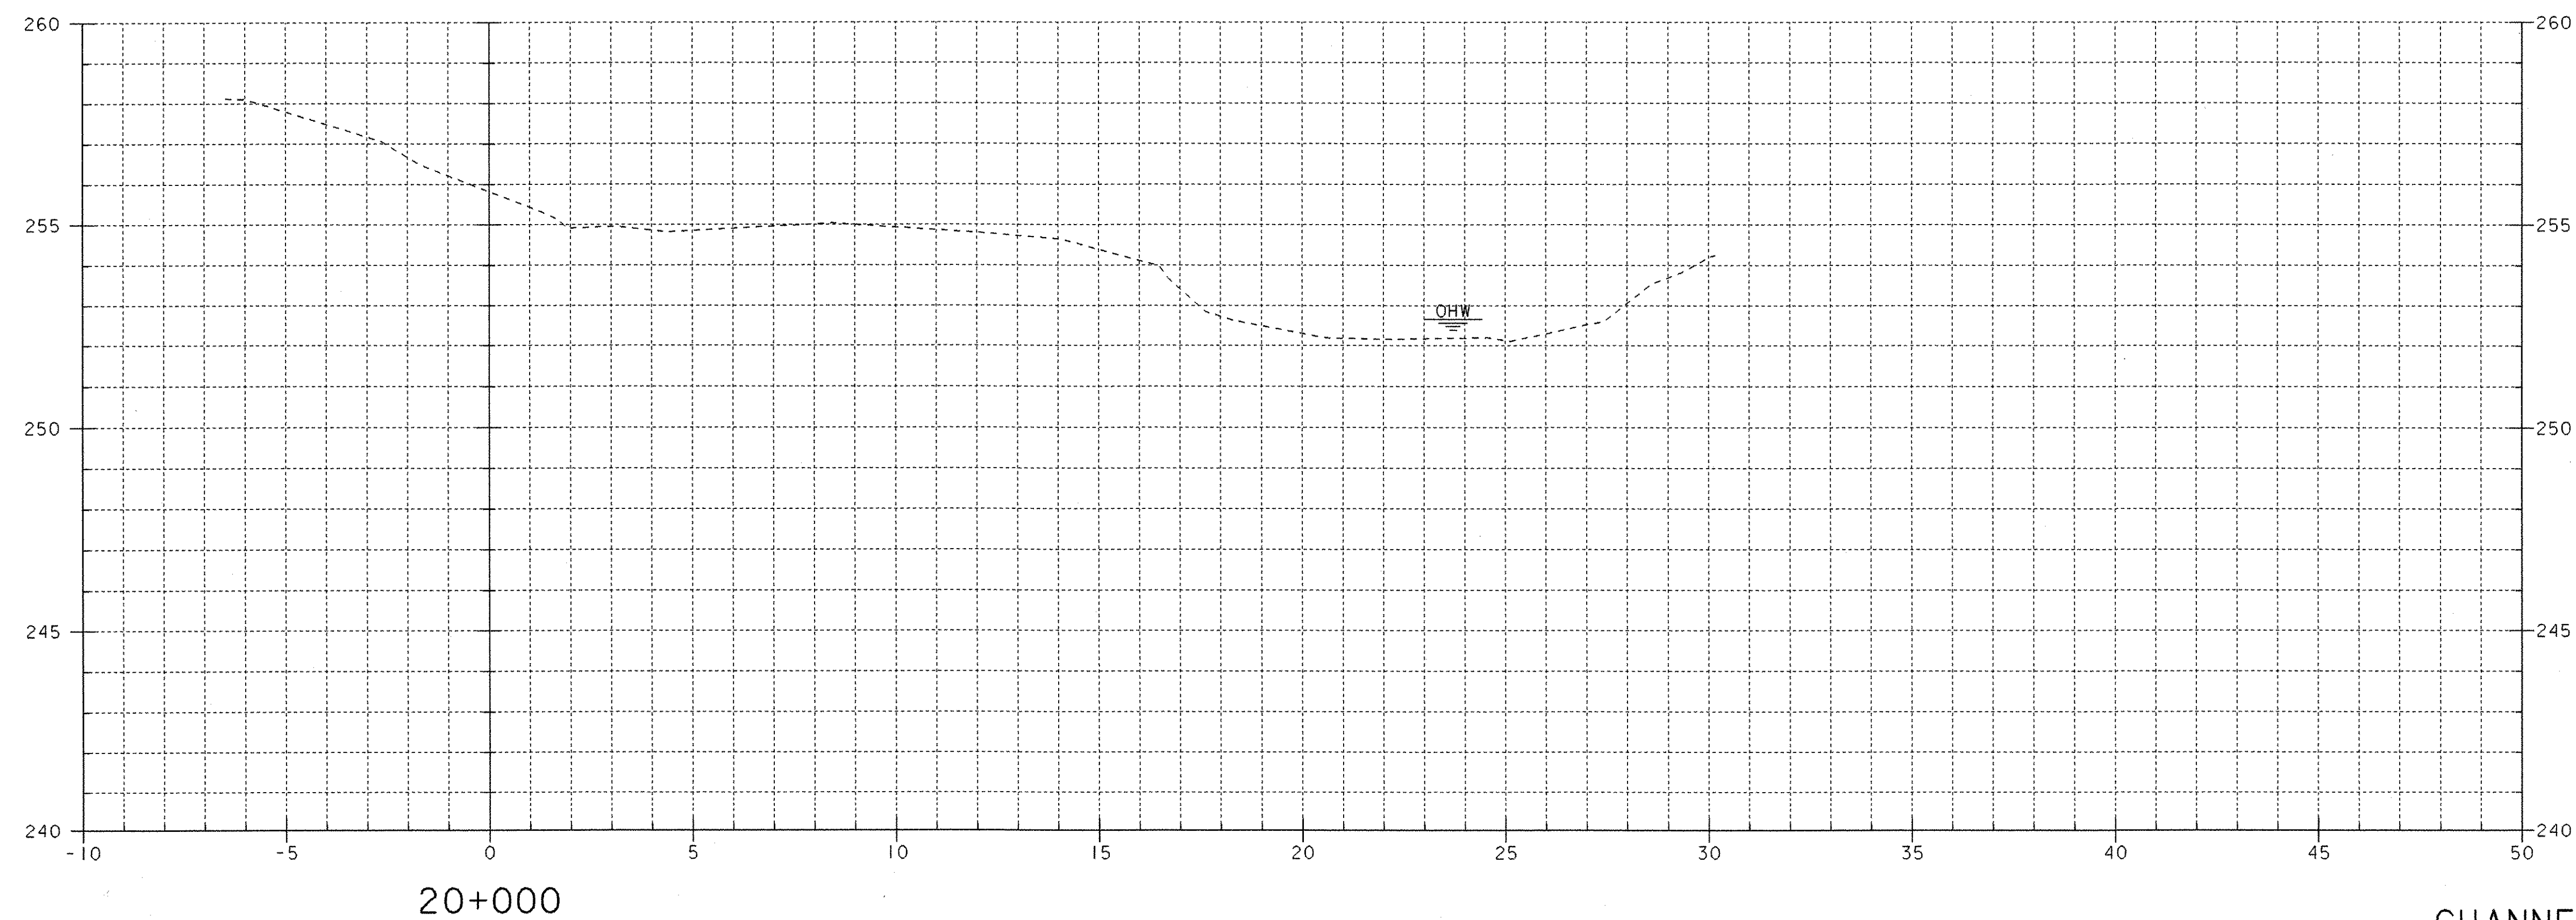


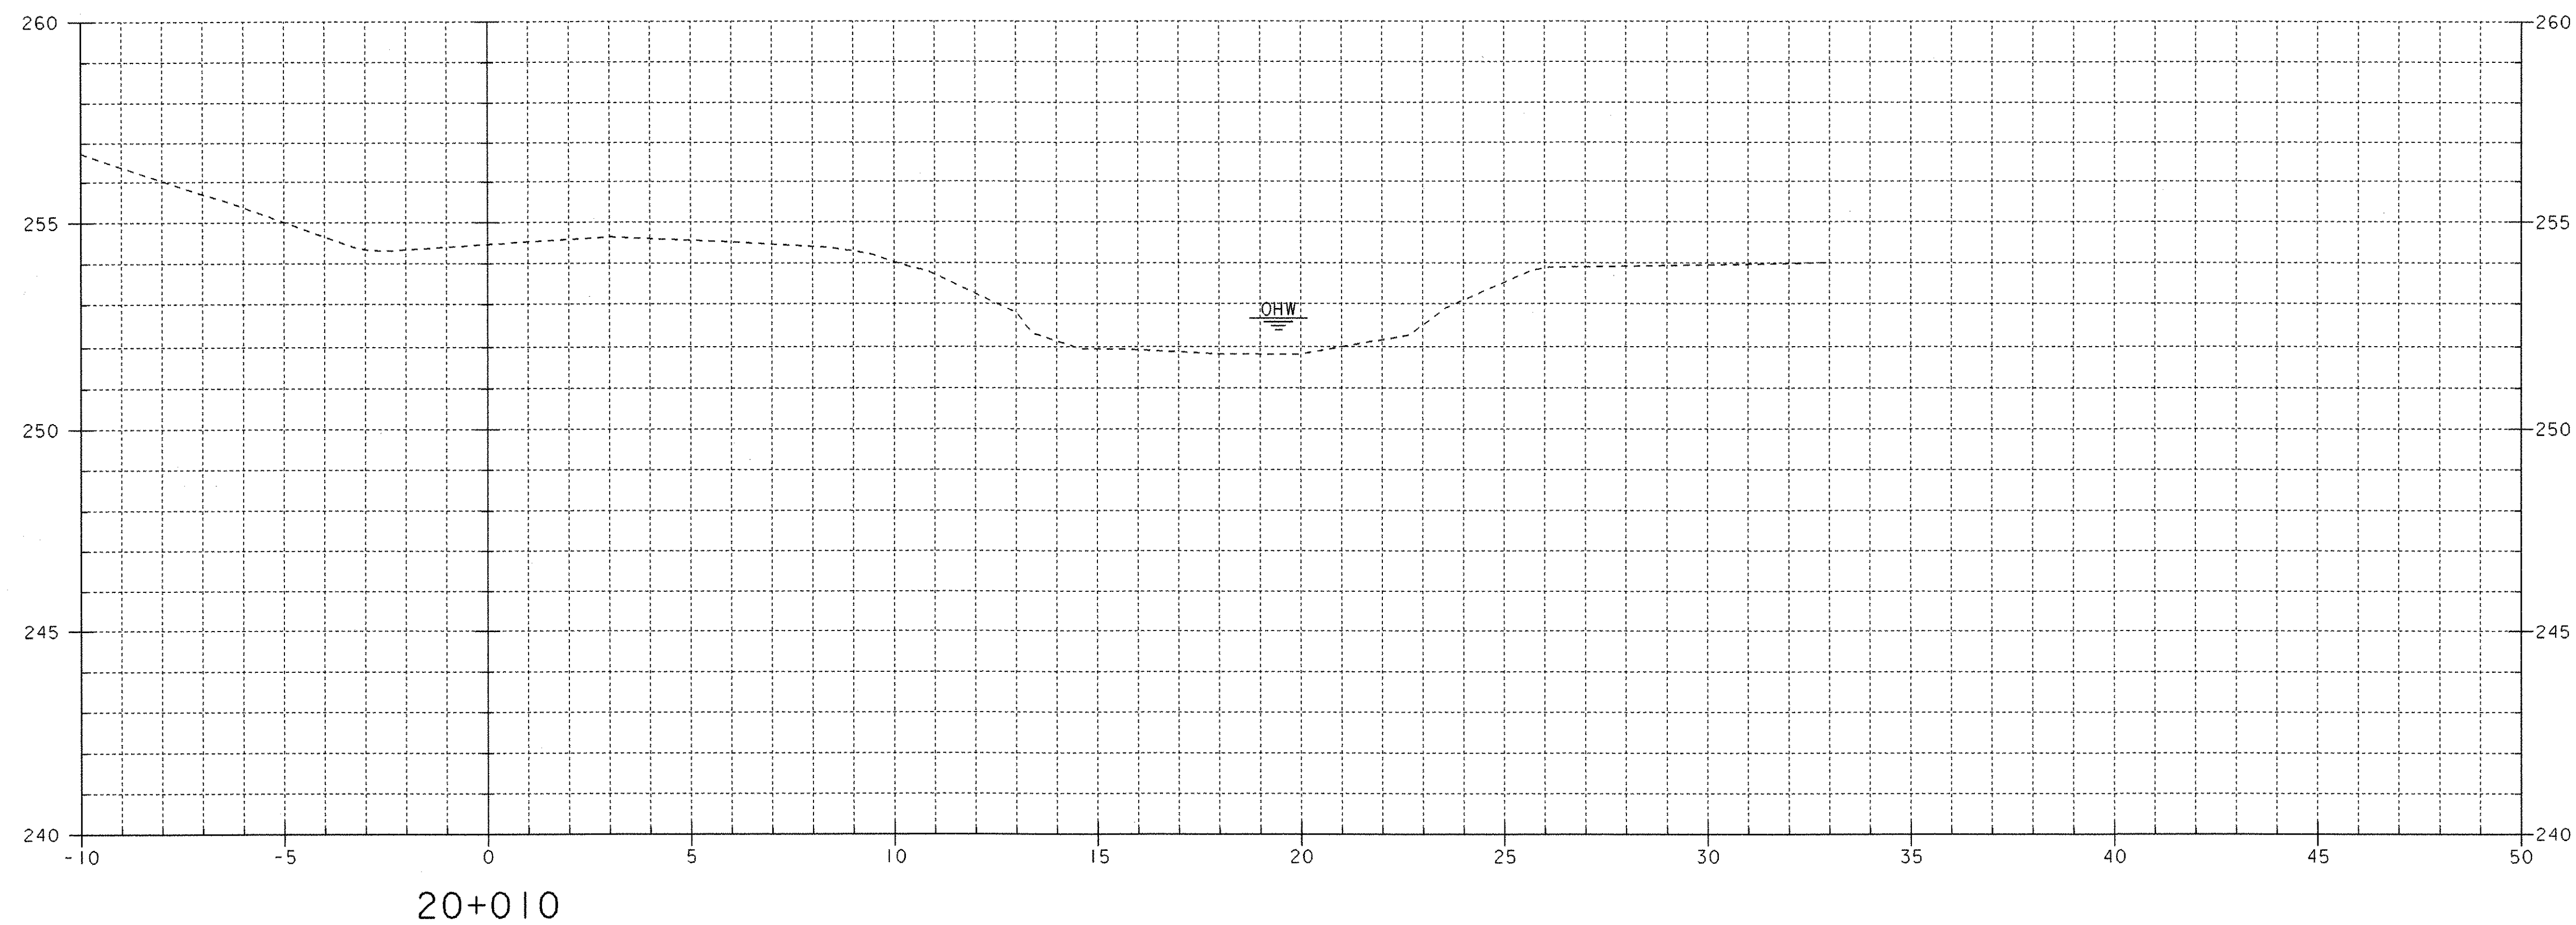

0 1 2 4 6 8 10

 SCALE = 1:100

CHANNEL CROSS SECTIONS (1)

PROJECT NAME:	HUNTINGTON
PROJECT NUMBER:	BRO 1445 (21)
FILE NAME:	93J029\Structures\sj029c01.d
PROJECT MANAGER:	R.R. WHITCOMB
DESIGNED BY:	J. ARMSTRONG
PLOT DATE:	09-JAN-2004
DRAWN BY:	J. ARMSTRONG
CHECKED BY:	M. LOZIER
SHEET	28 OF 34