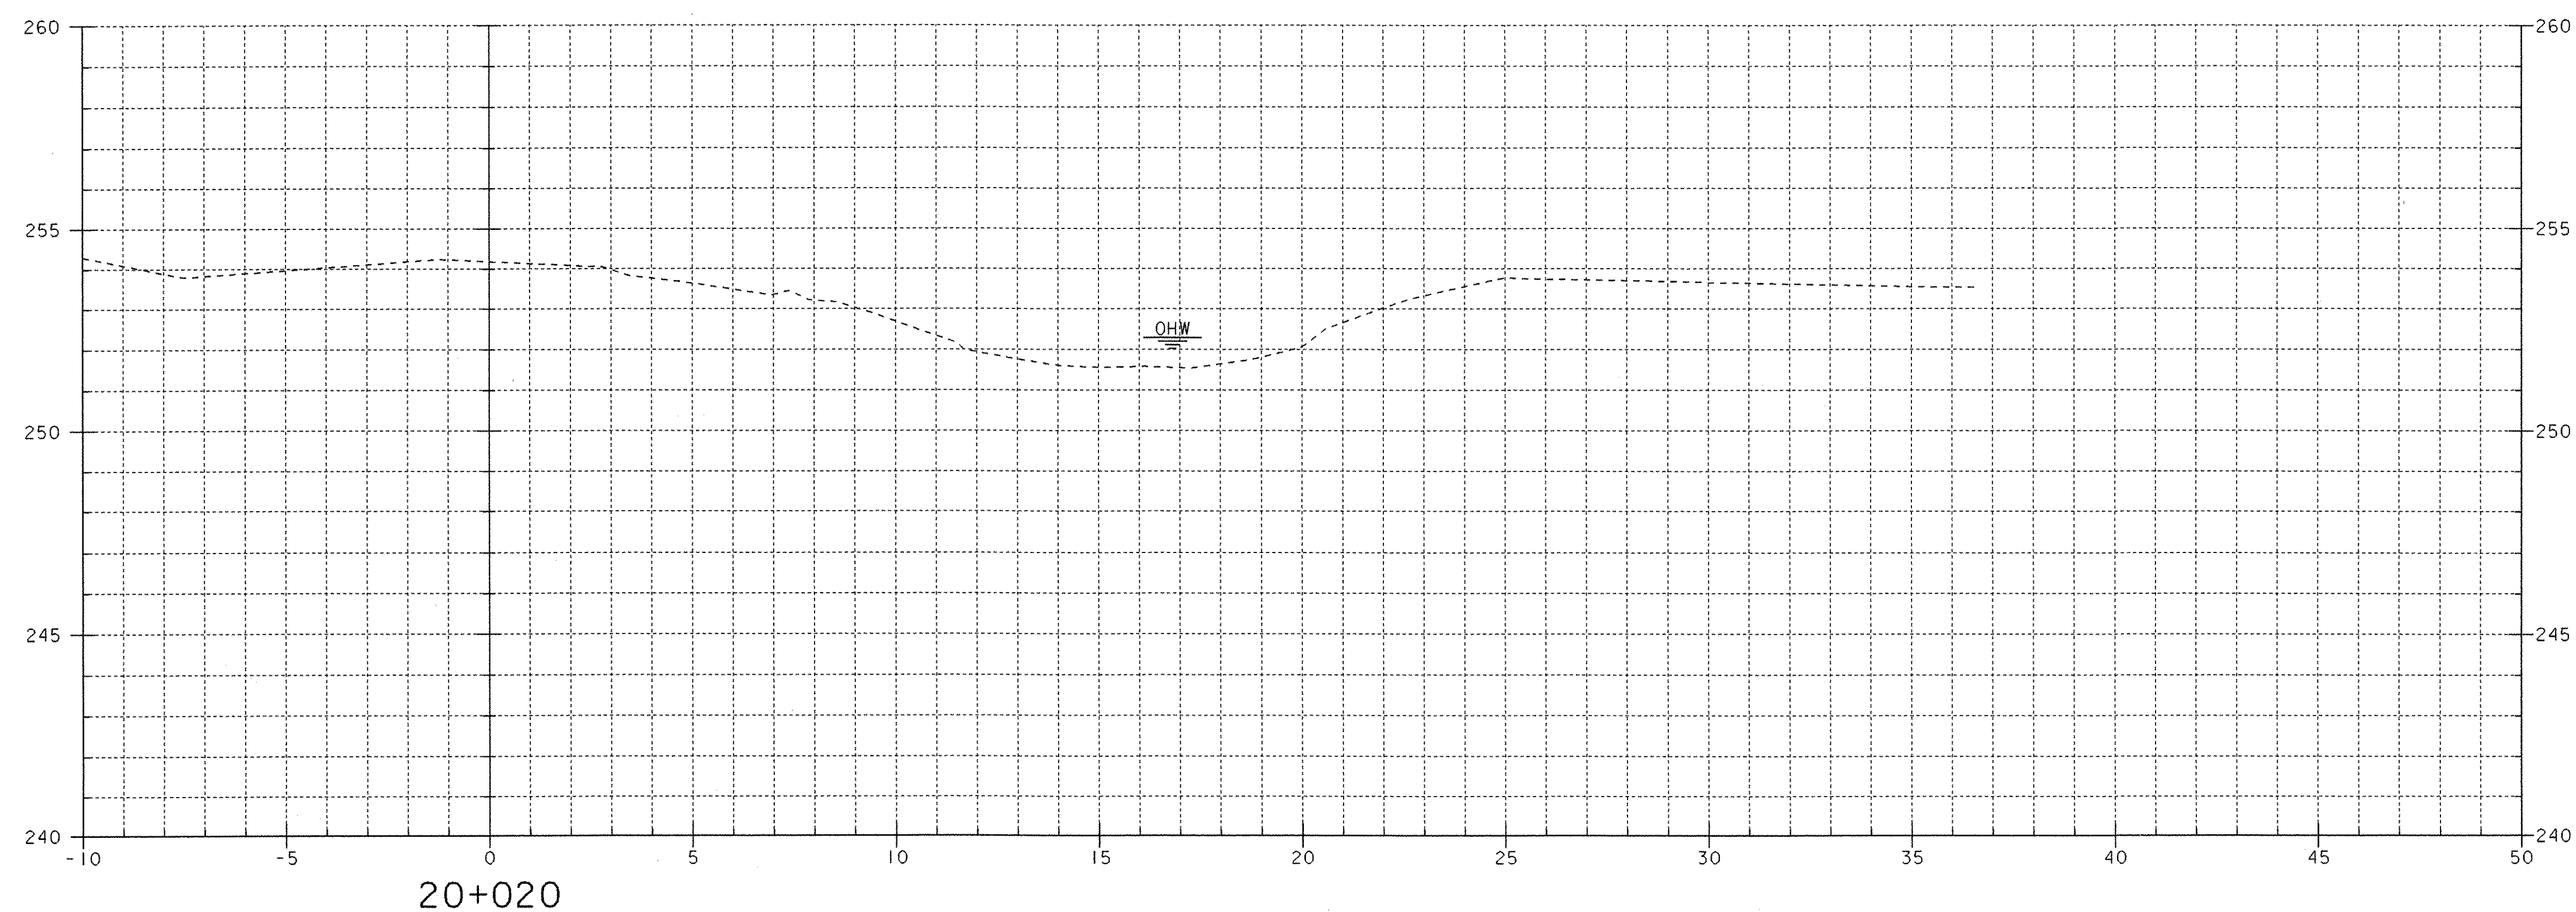
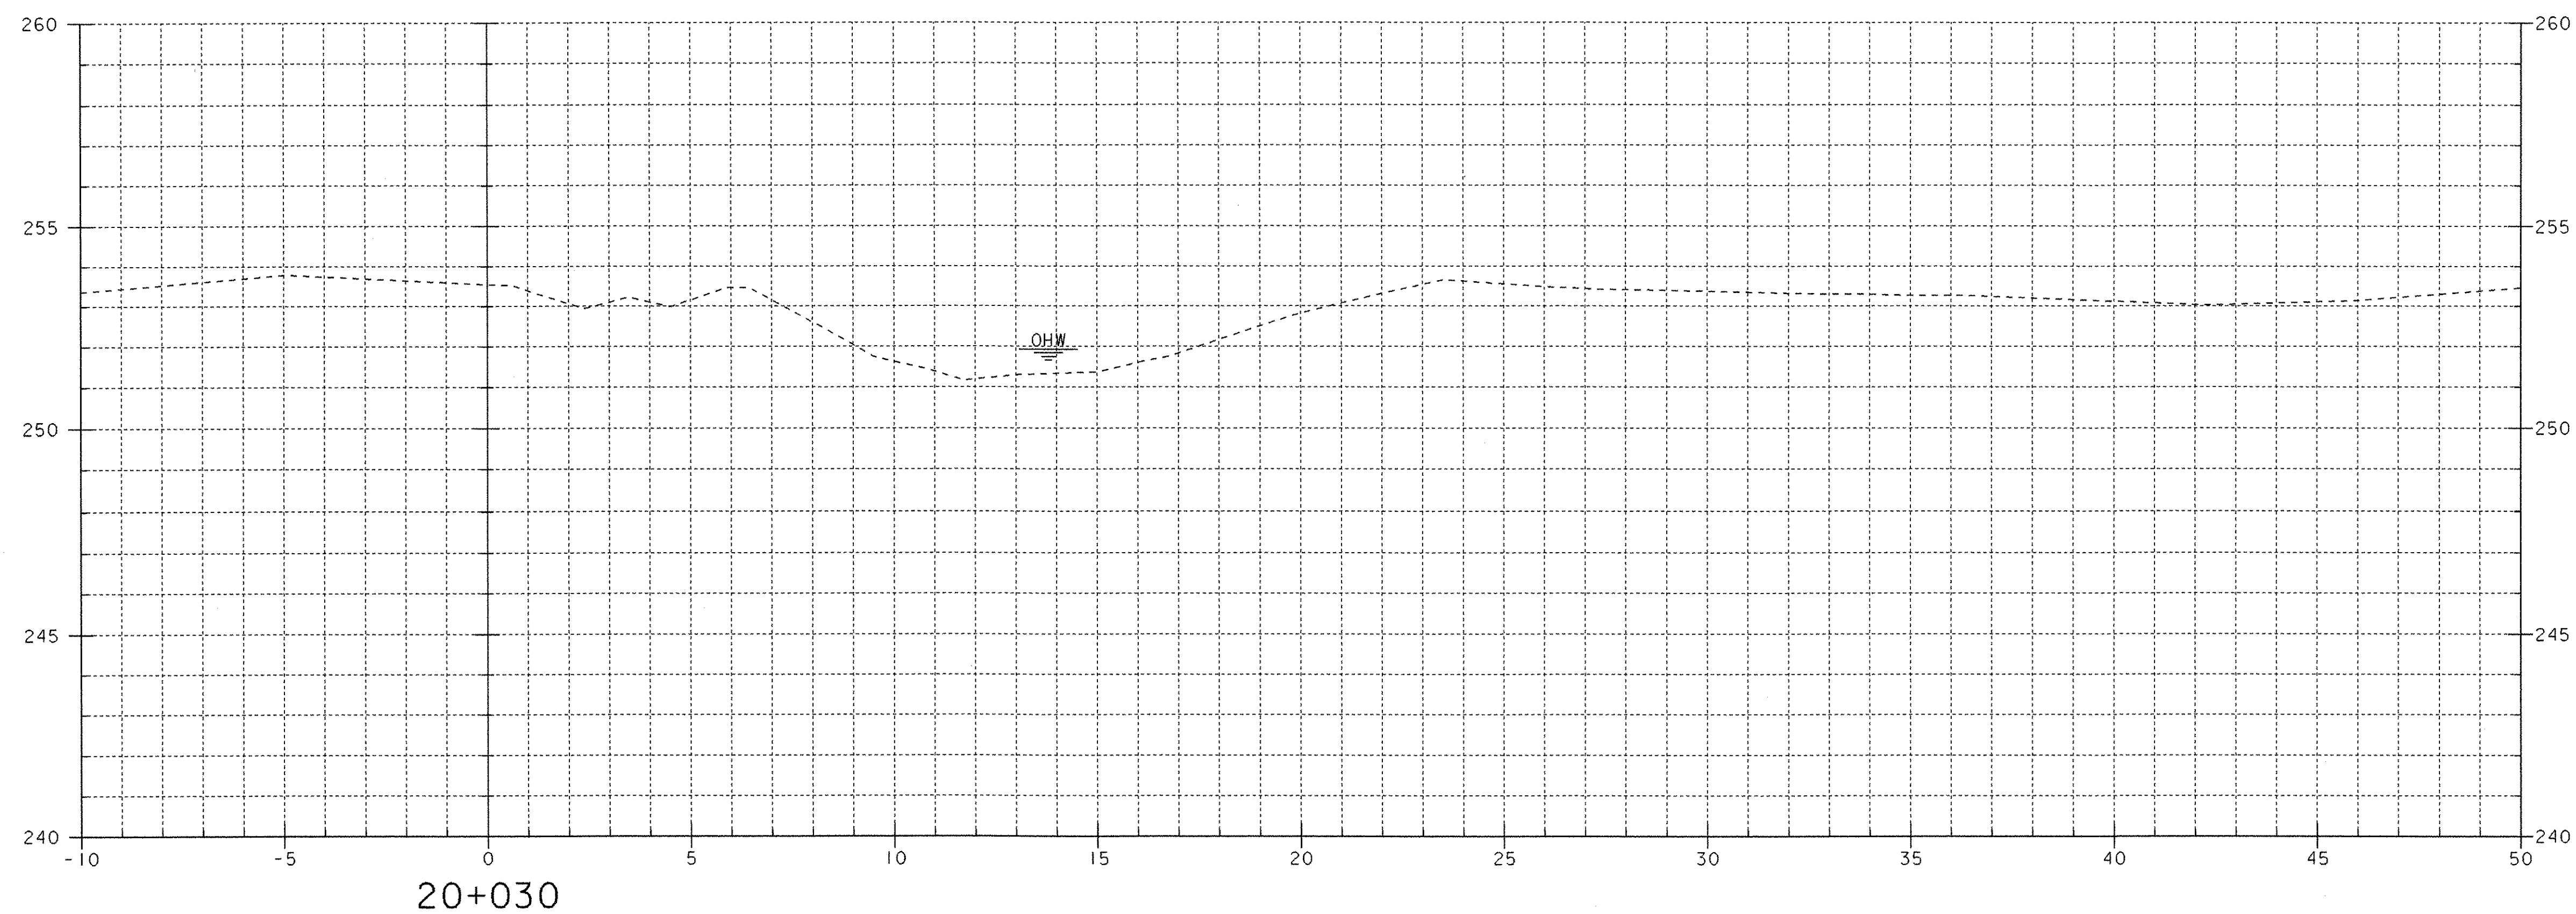


CHANNEL CROSS SECTIONS (2)

PROJECT NAME:	HUNTINGTON
PROJECT NUMBER:	BRO 1445 (21)
FILE NAME:	93J029\Structures\sj029c02.1
PROJECT MANAGER:	R.R. WHITCOMB
DESIGNED BY:	J. ARMSTRONG
PLOT DATE:	09-JAN-2004
DRAWN BY:	J. ARMSTRONG
CHECKED BY:	M. LOZIER
SHEET	29 OF 34