




FILE NAME: 93J029\Structures\s\j029c05.l	PLOT DATE: 09-JAN-2004
PROJECT MANAGER: R.R. WHITCOMB	DRAWN BY: J. ARMSTRONG
DESIGNED BY: J. ARMSTRONG	CHECKED BY: M. LOZIER
	SHEET 32 OF 34

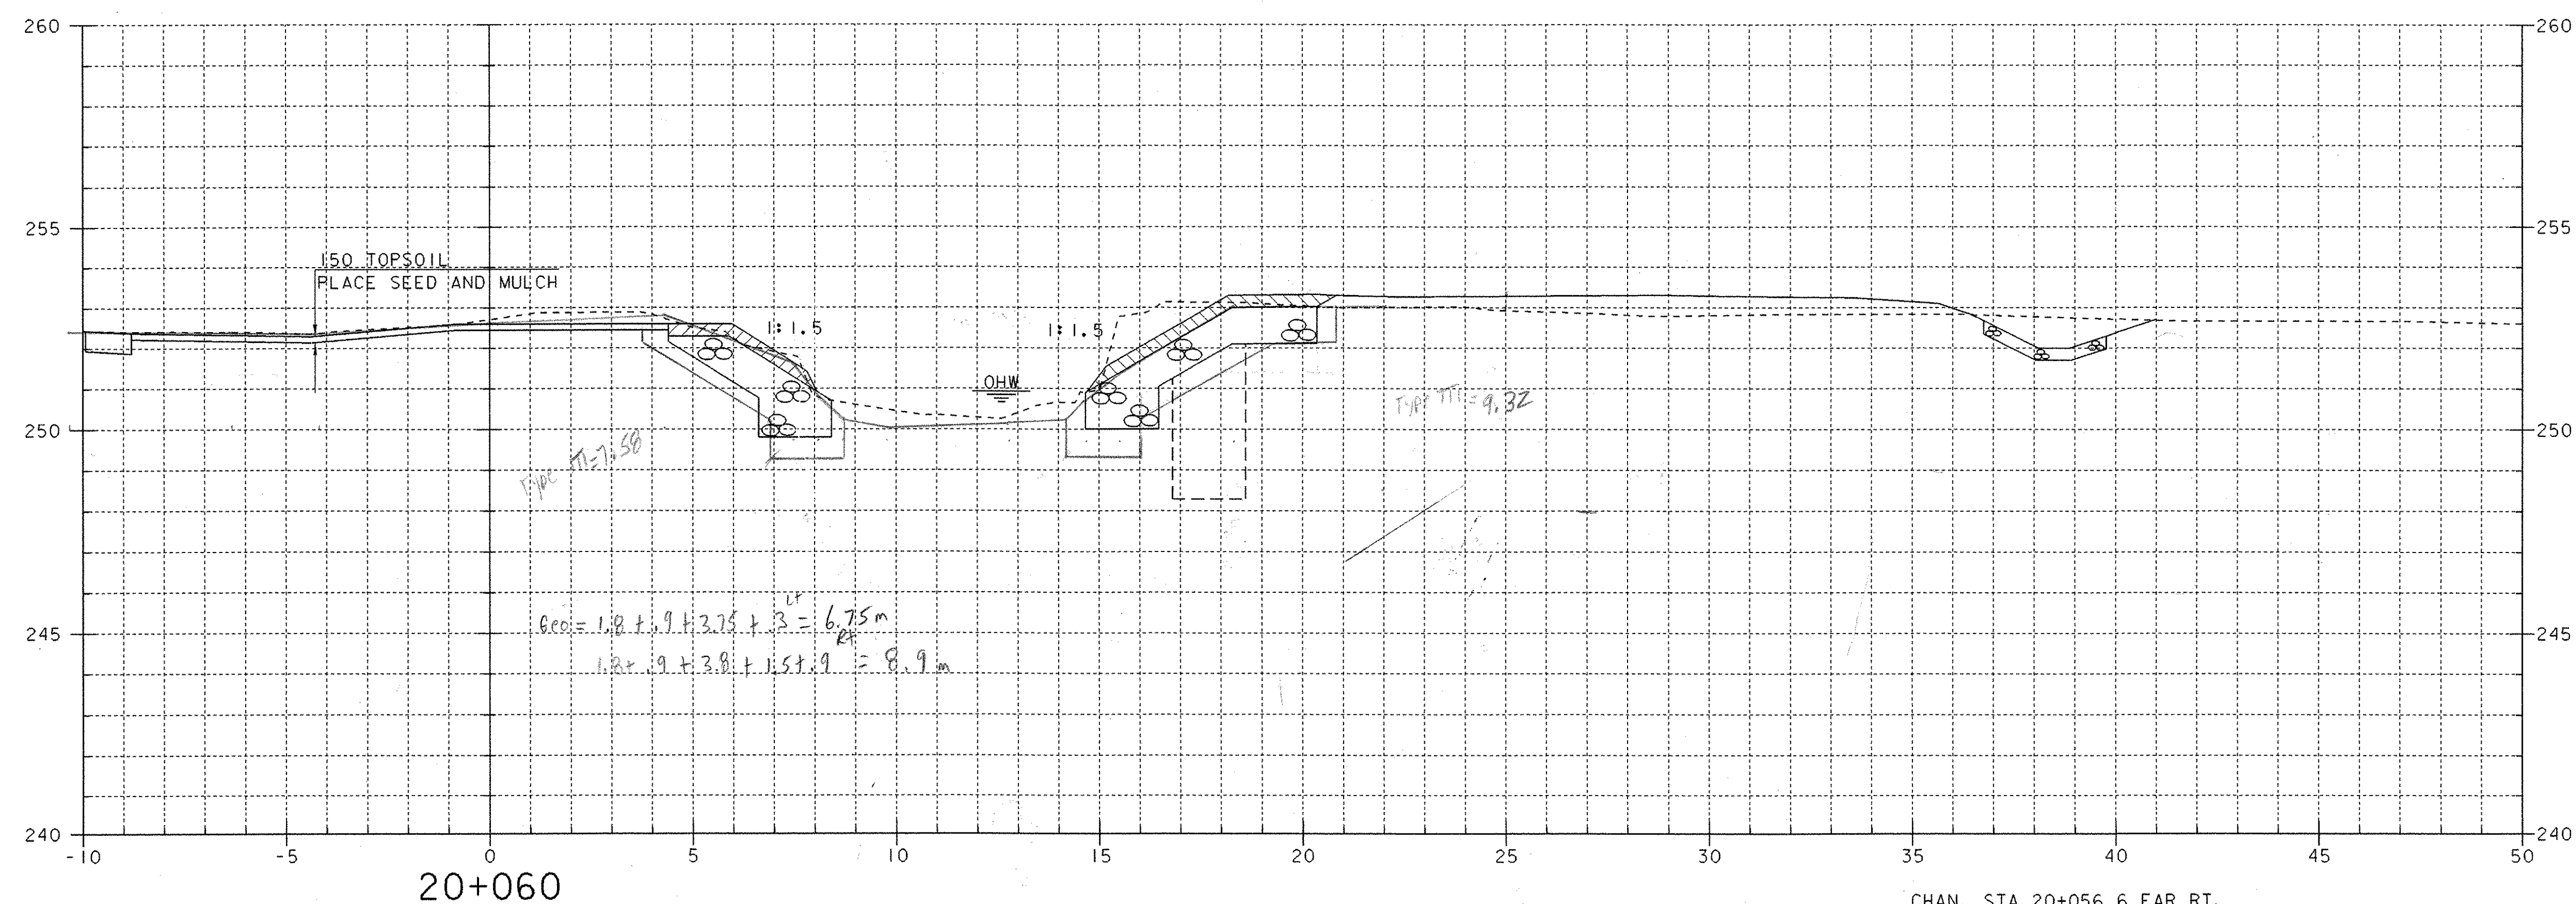