

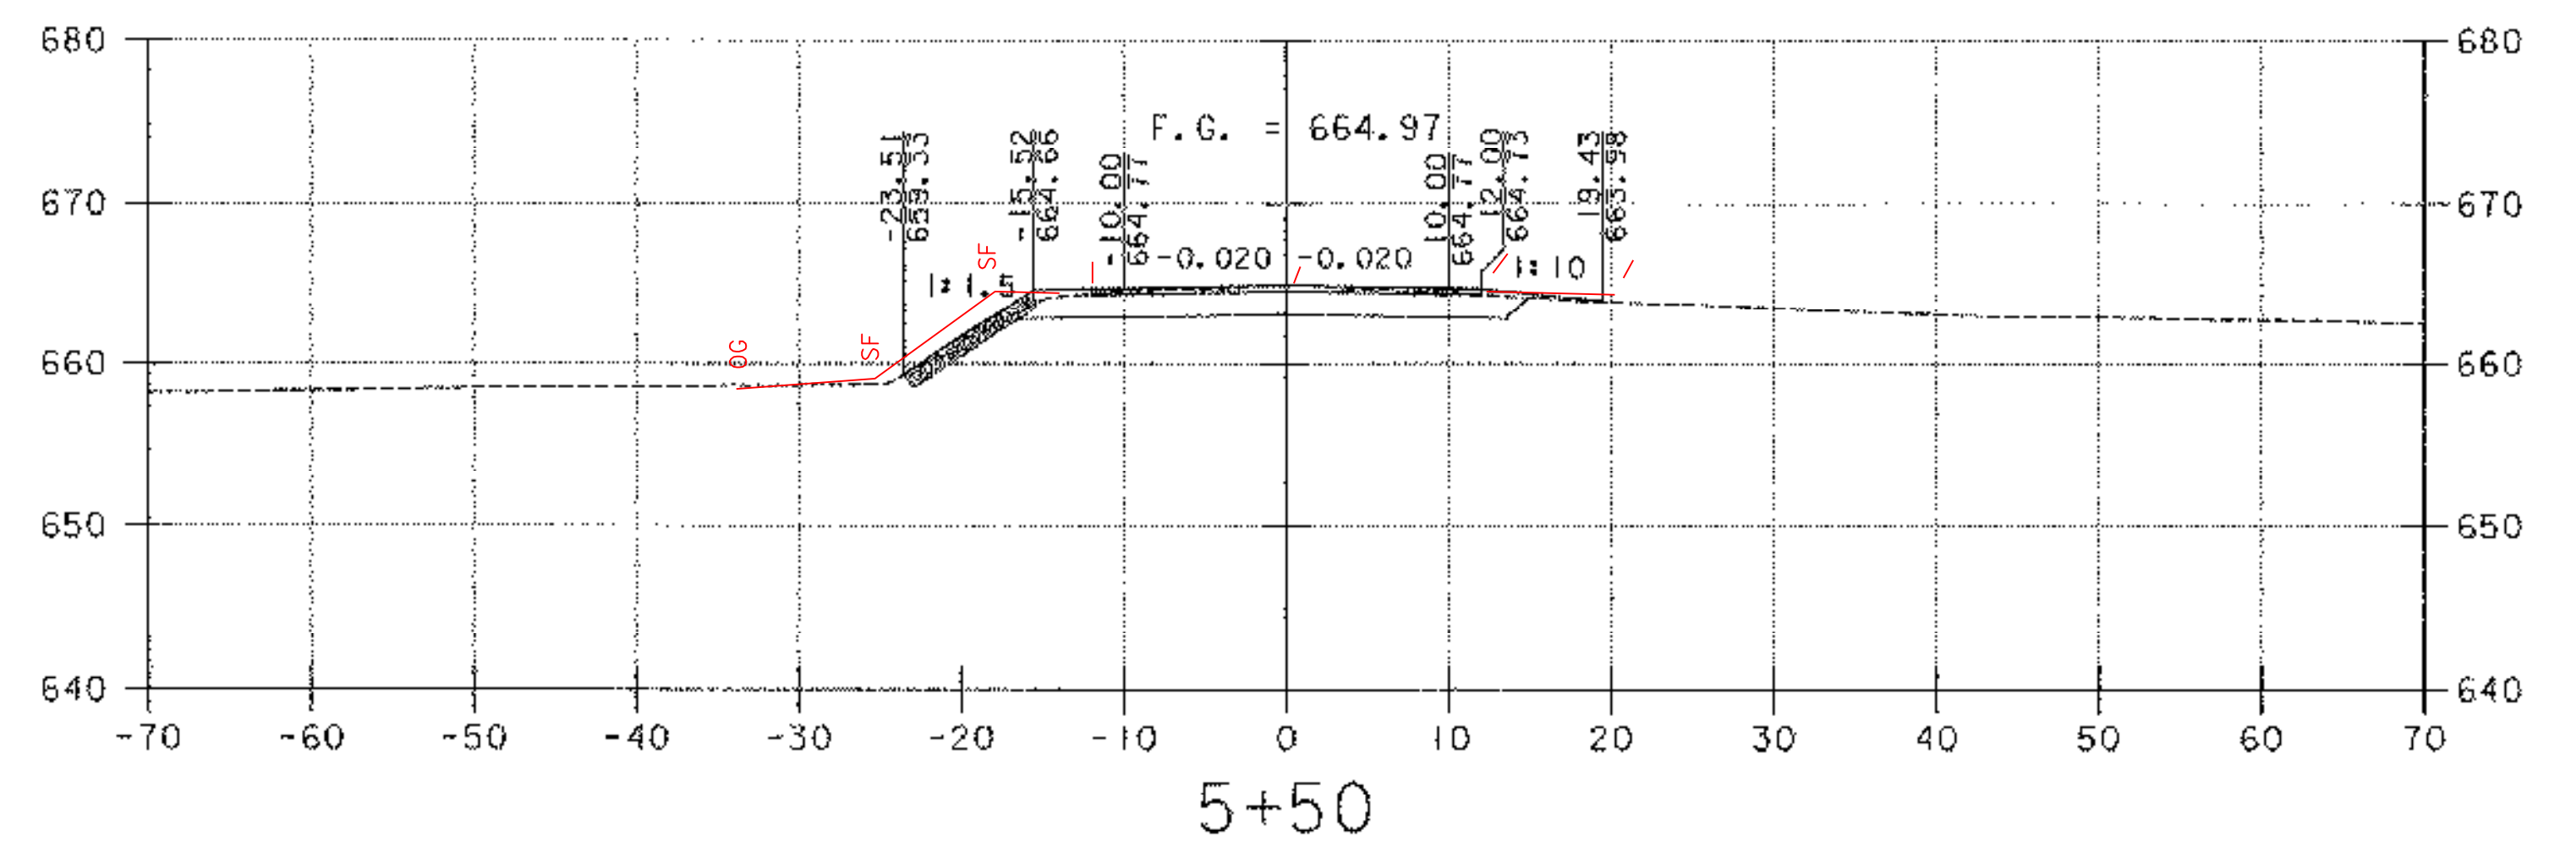
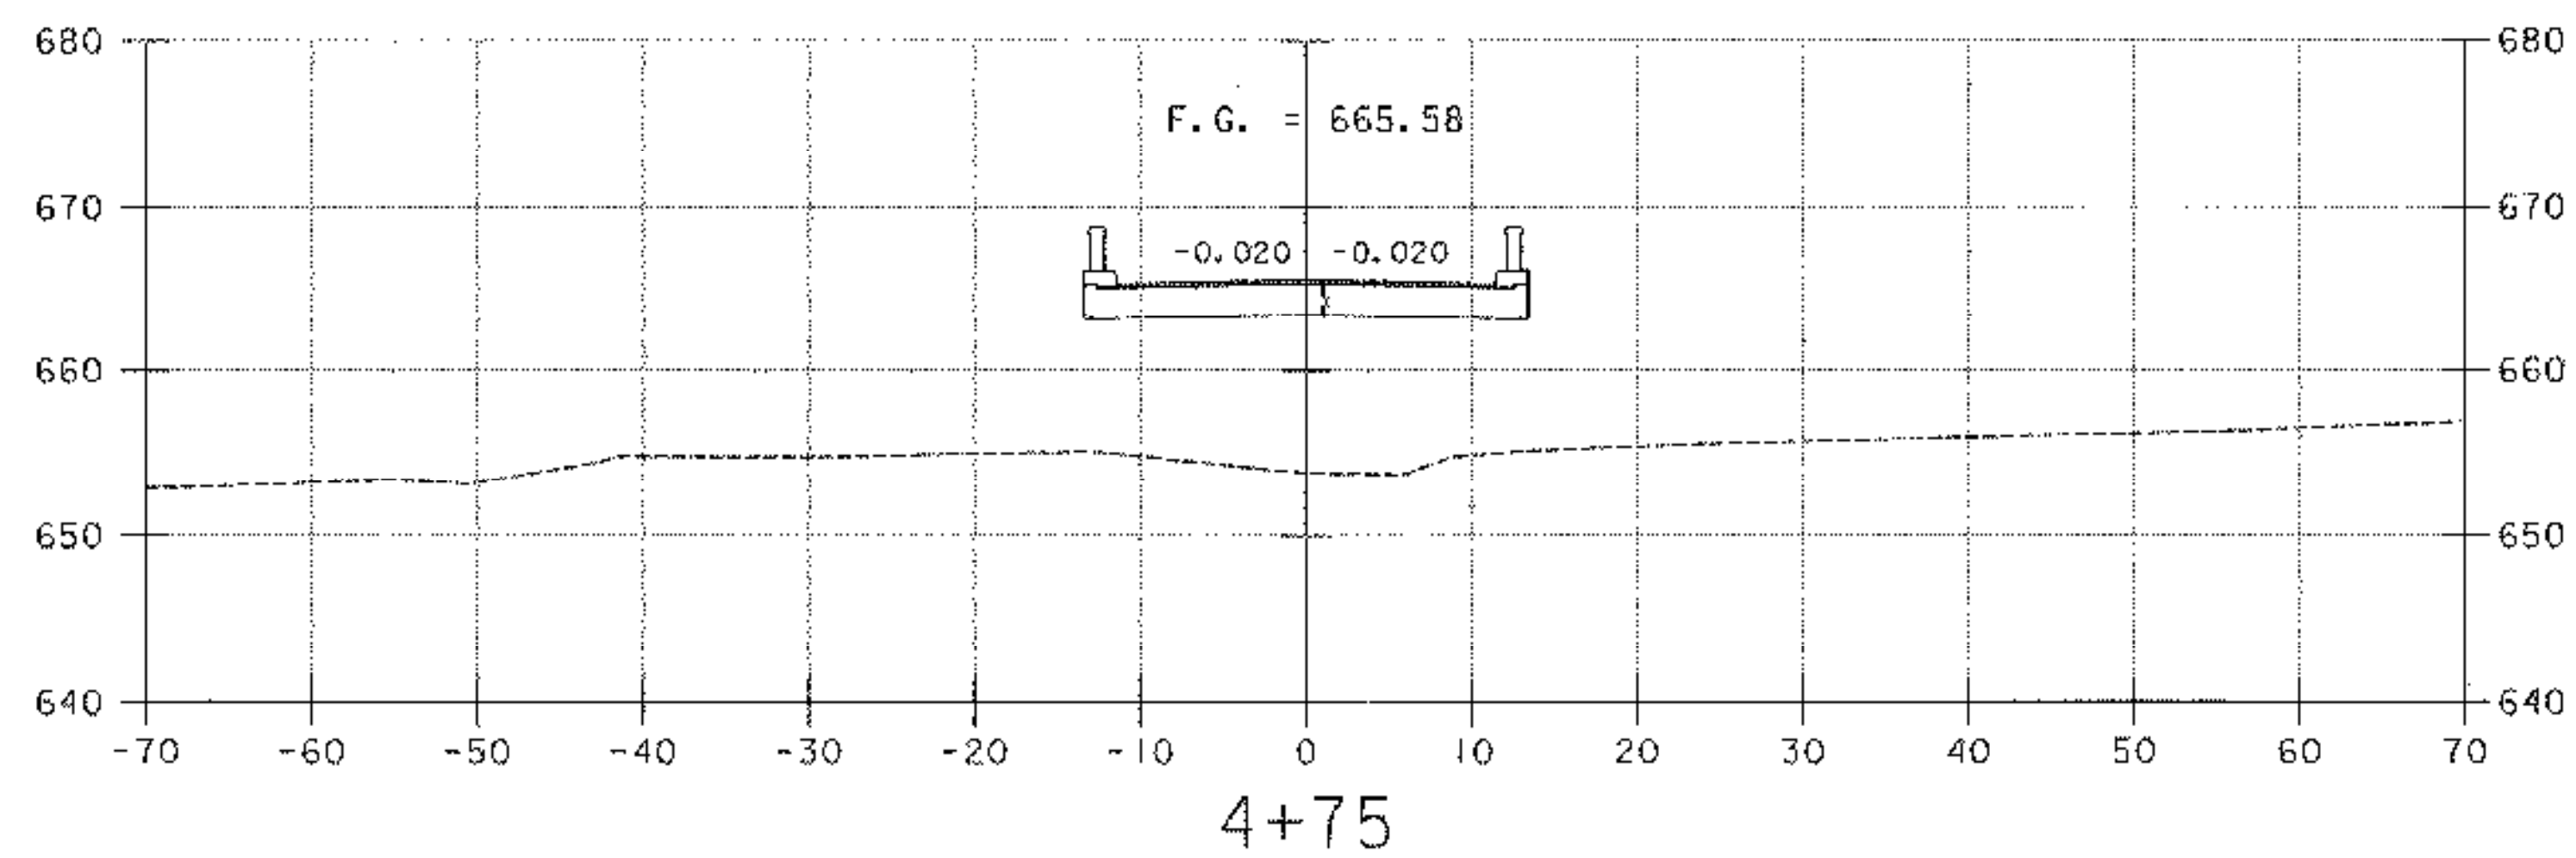
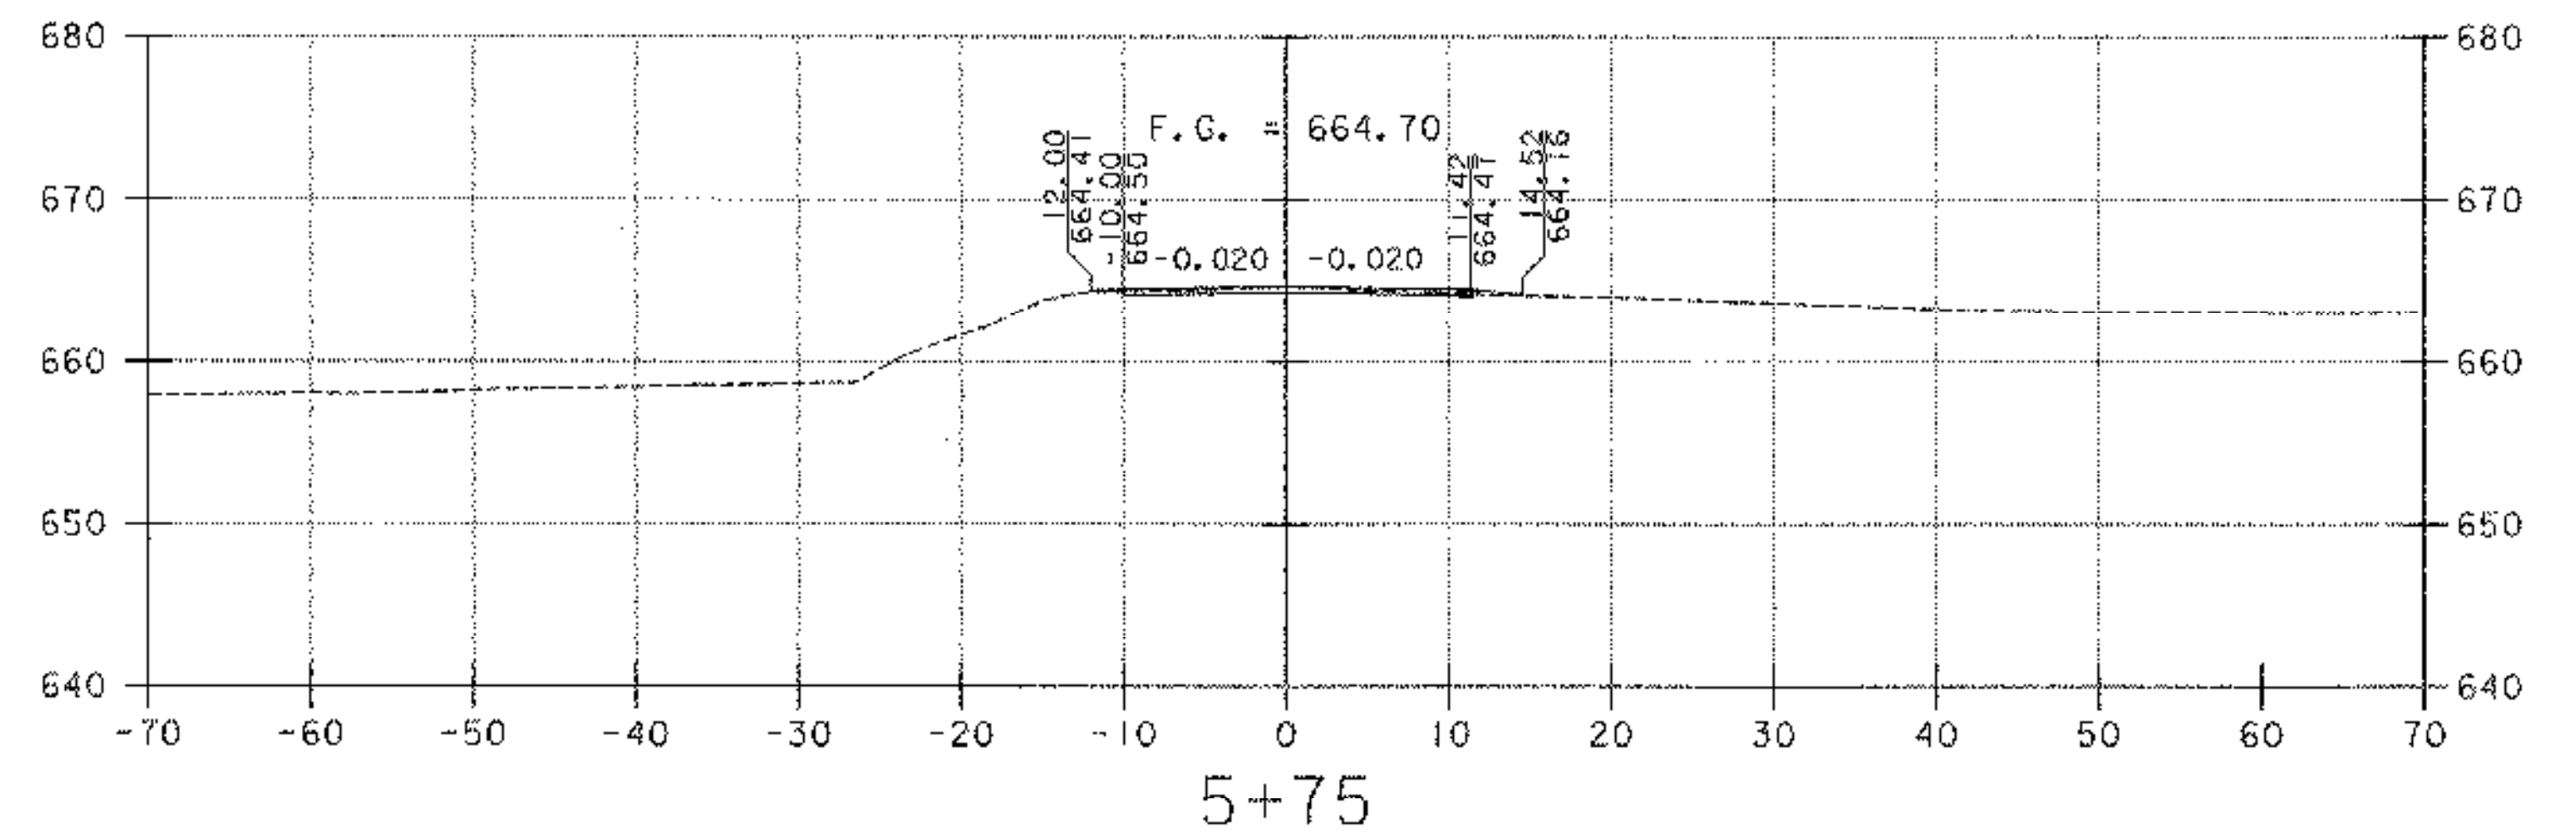
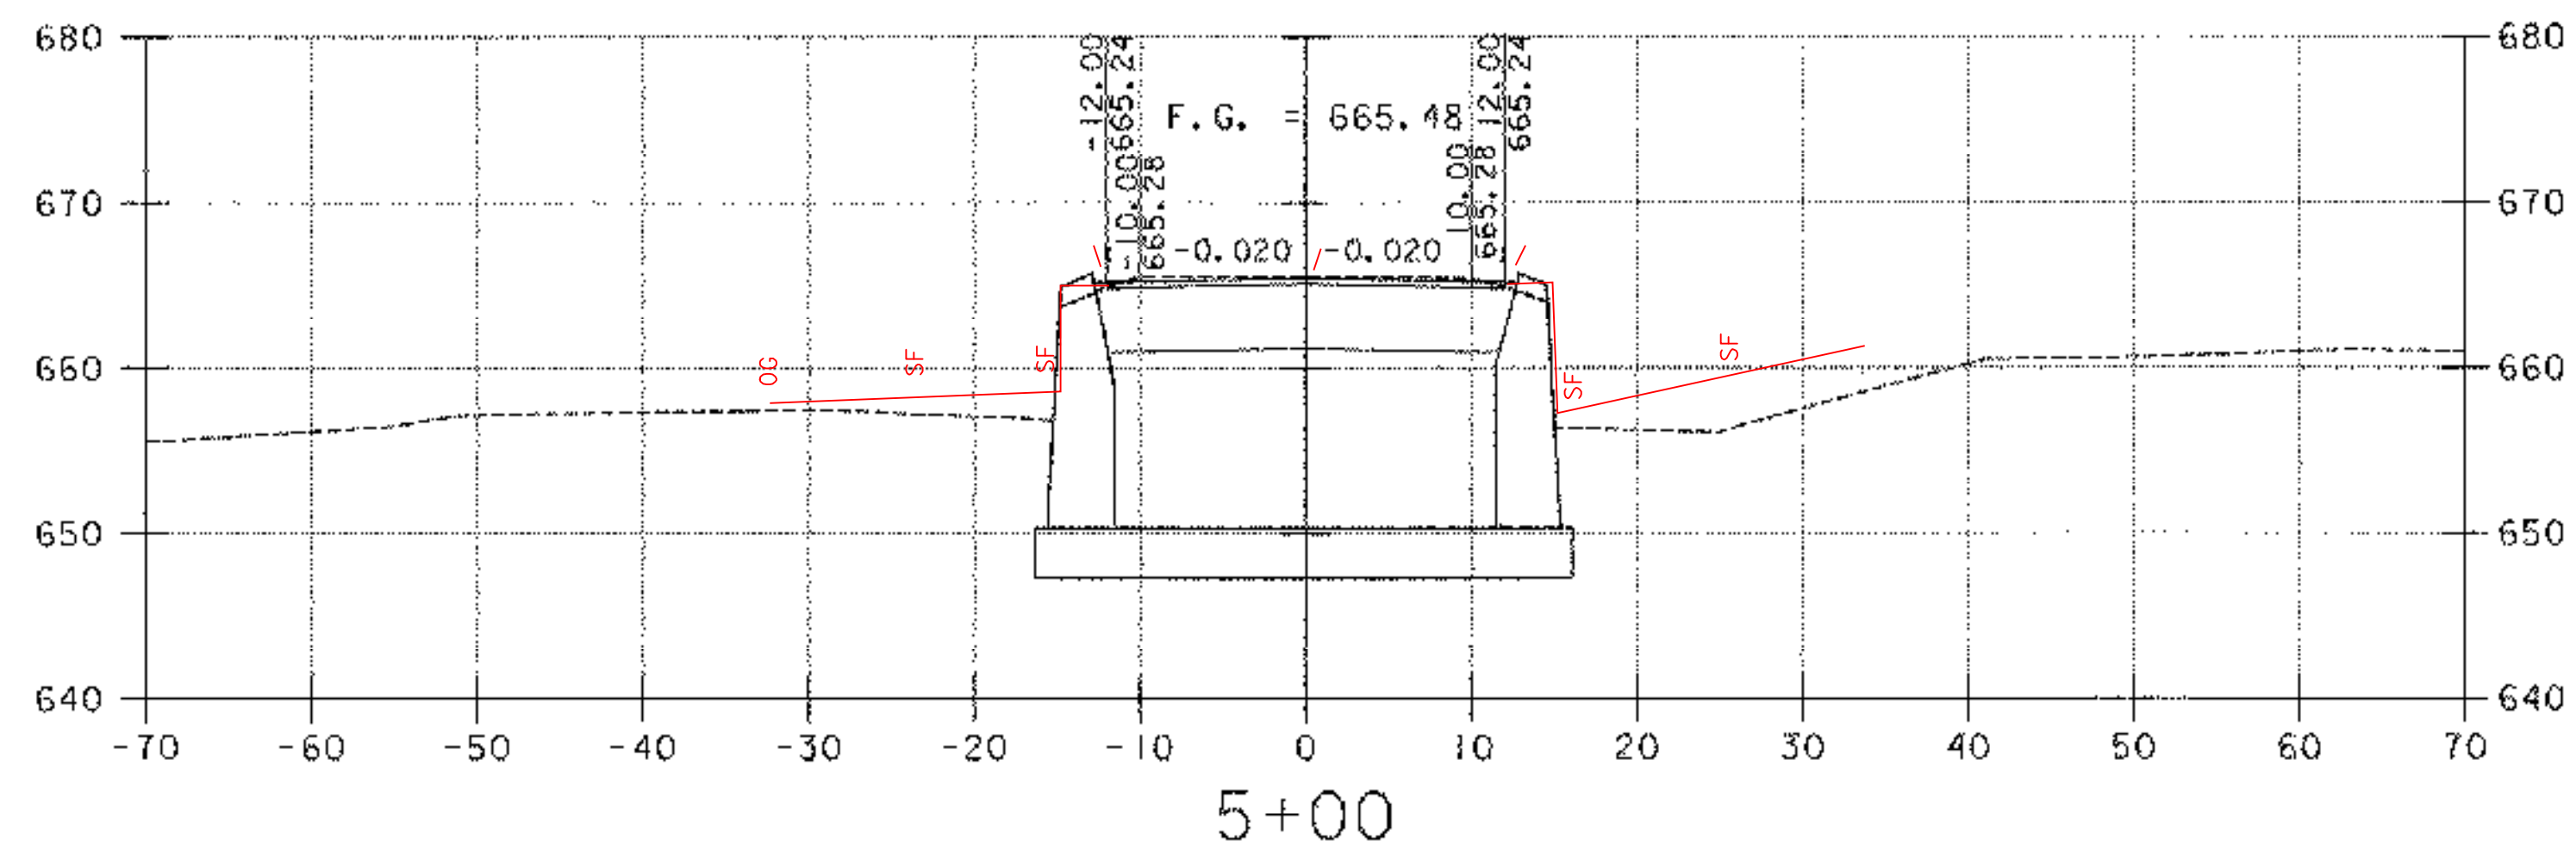


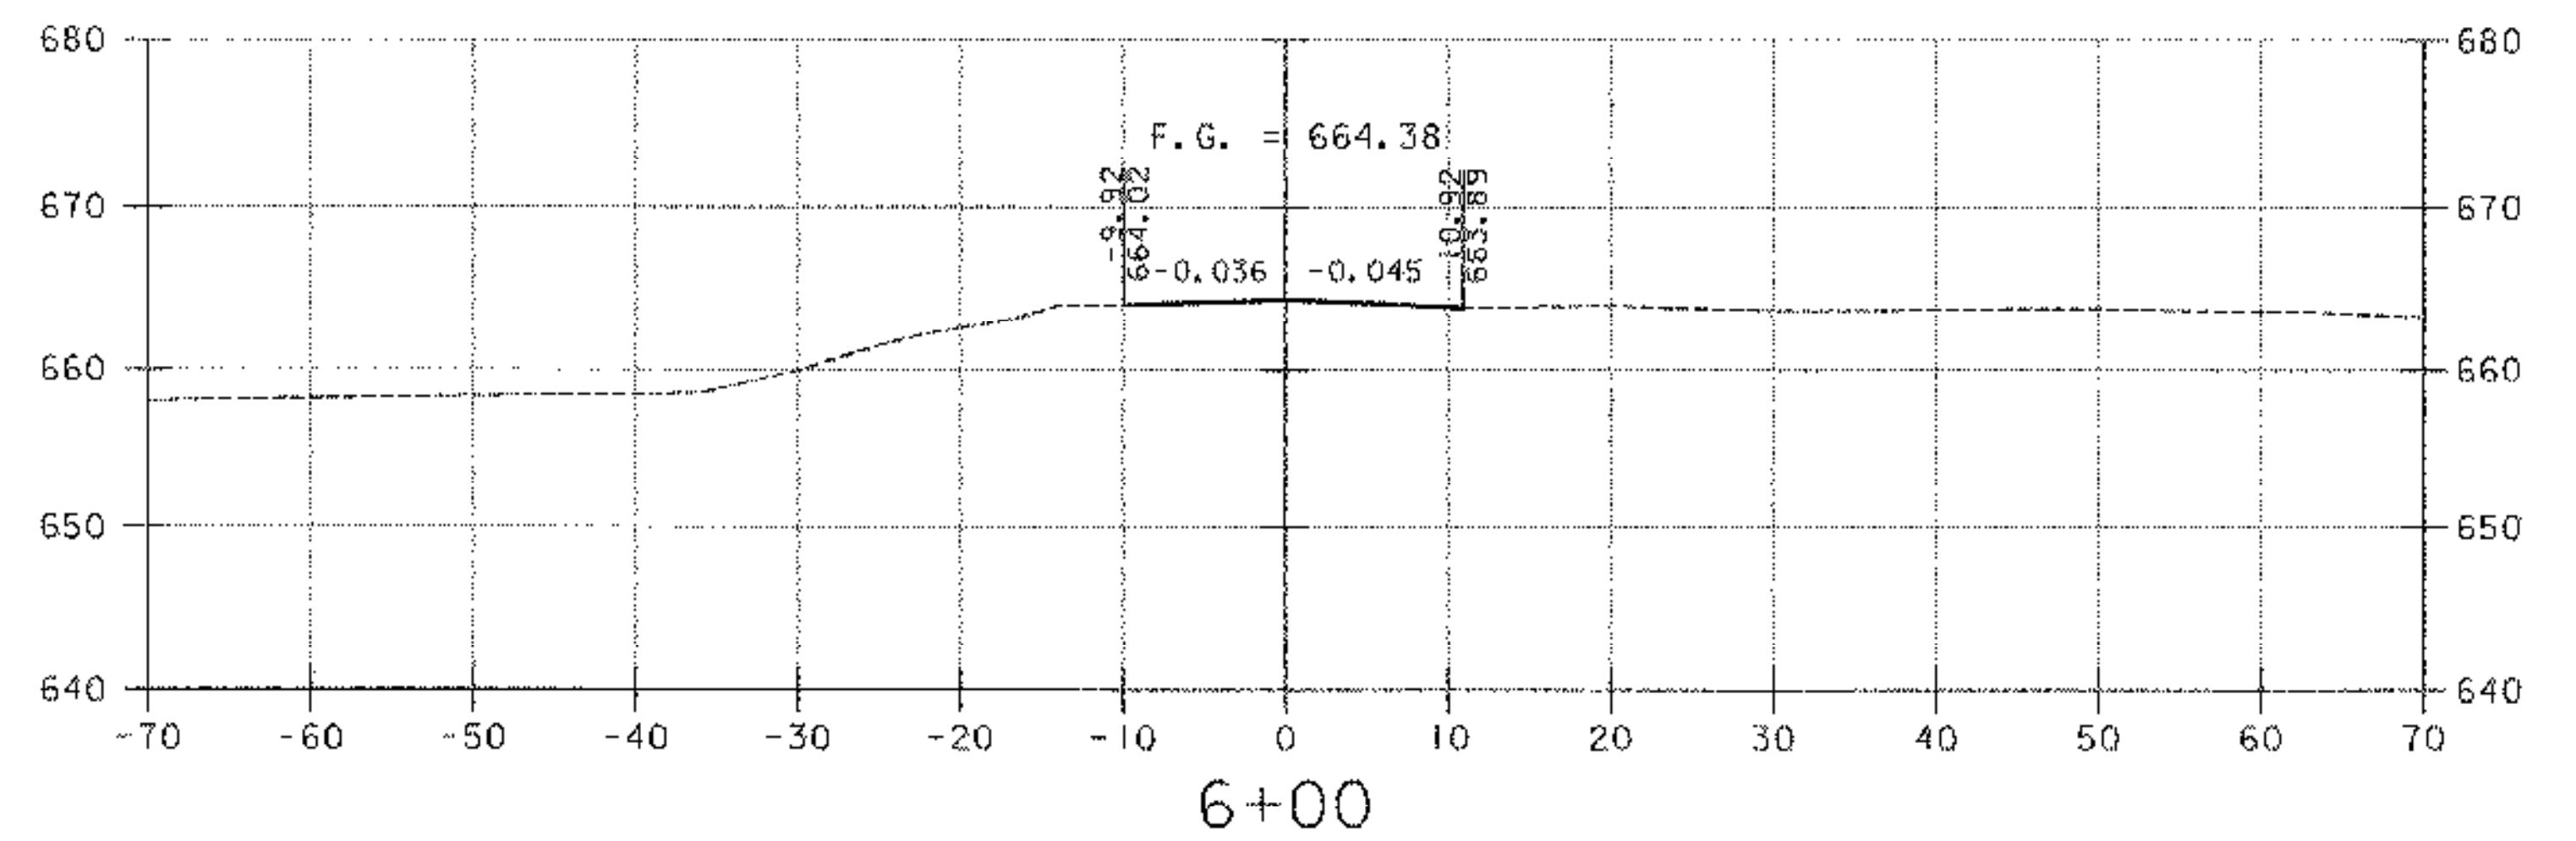

SCALE 1" = 10'-0"

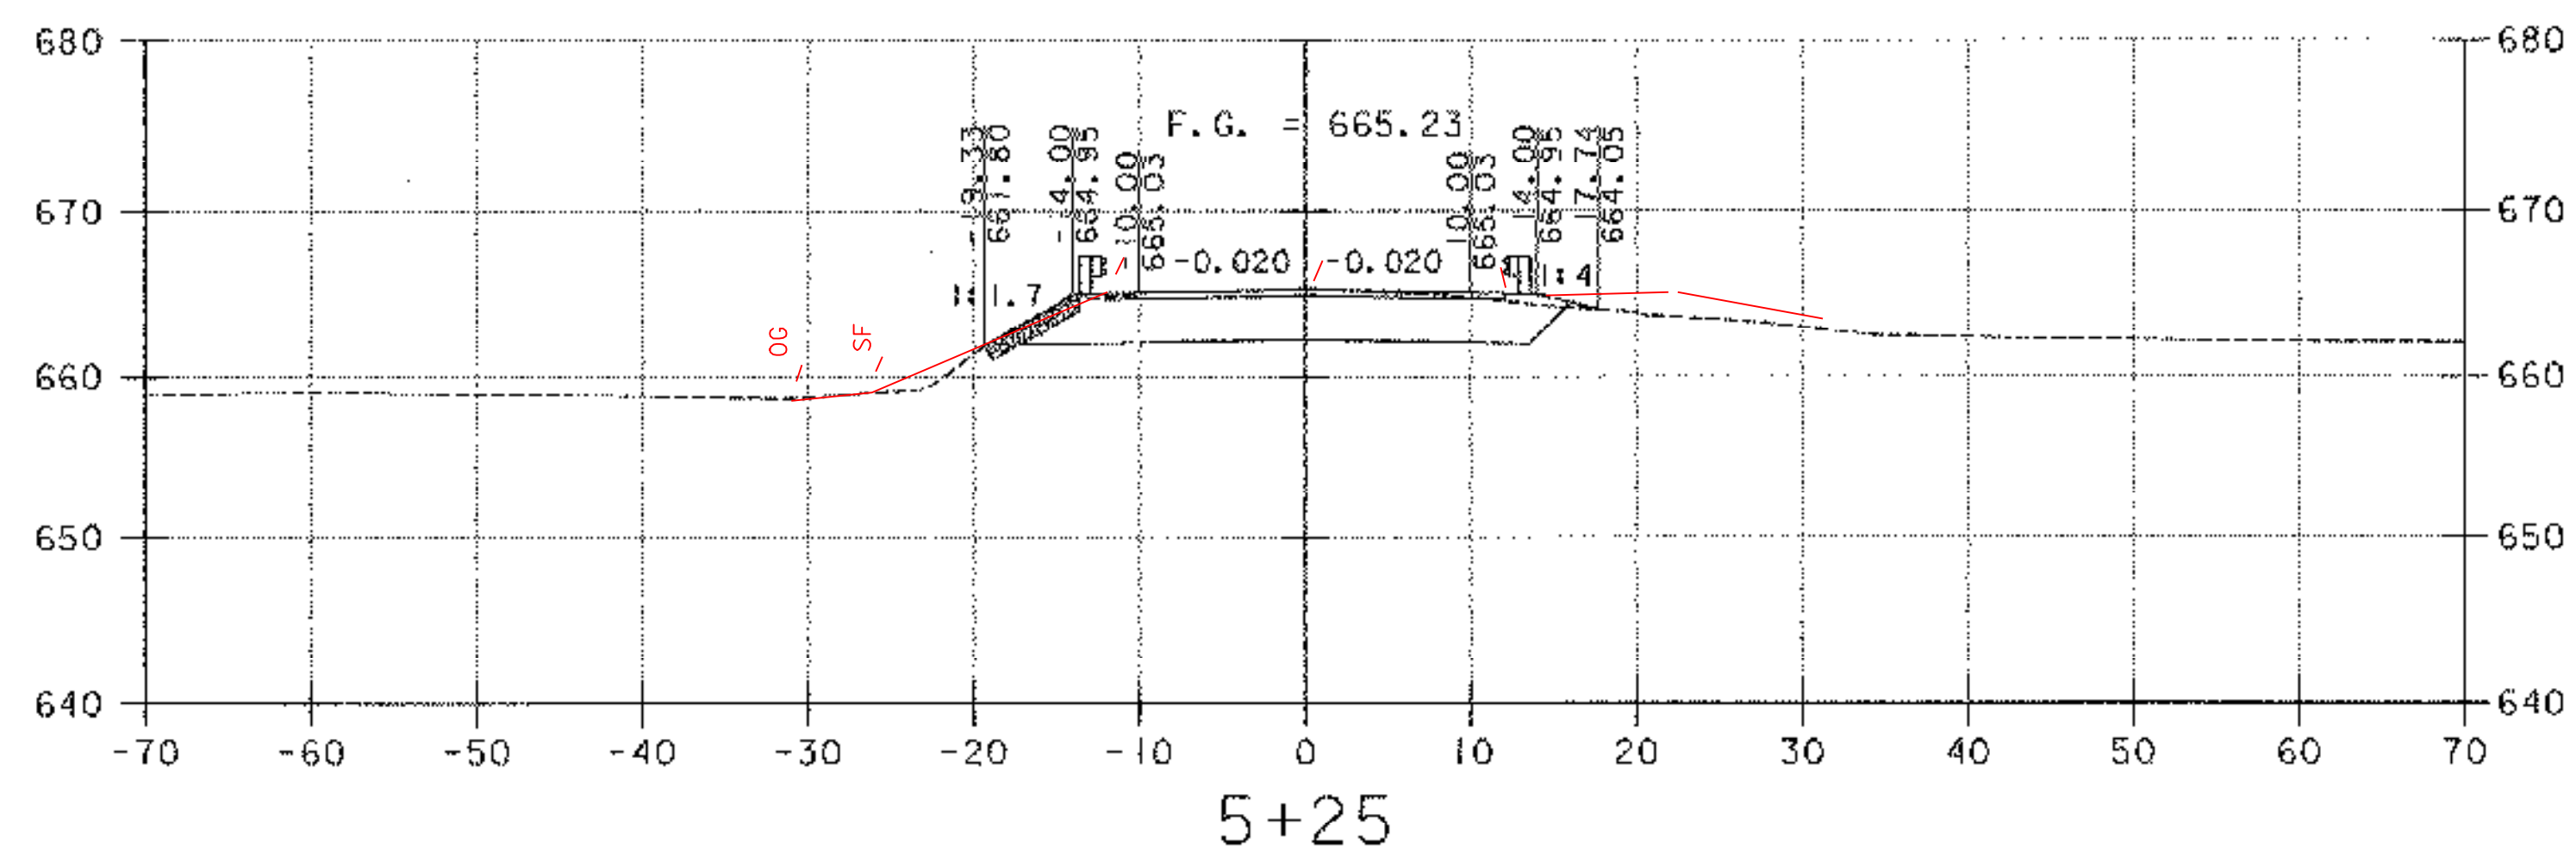

PROJECT NAME:	CORINTH
PROJECT NUMBER:	TH2-9352

FILE NAME: ... \Corr~xs.dgn

PROJECT LEADER: MJC
DESIGNED BY: SEB

PLOT DATE: 05/07/2003

DRAWN BY: SEB
CHECKED BY: MJC