

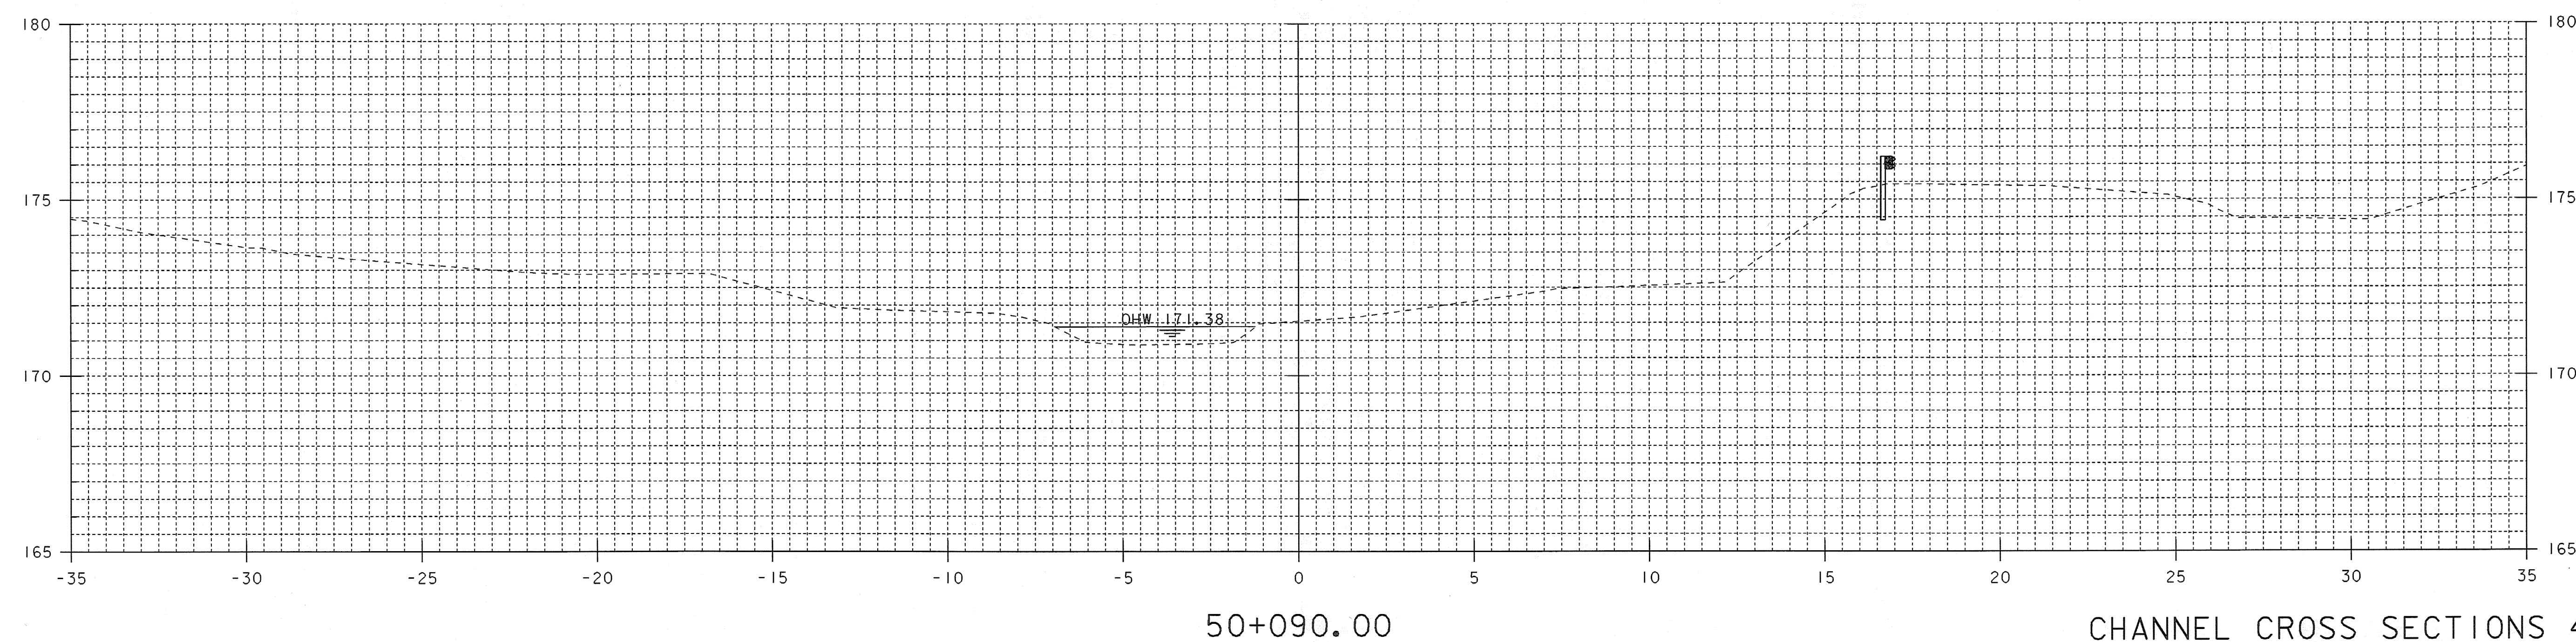


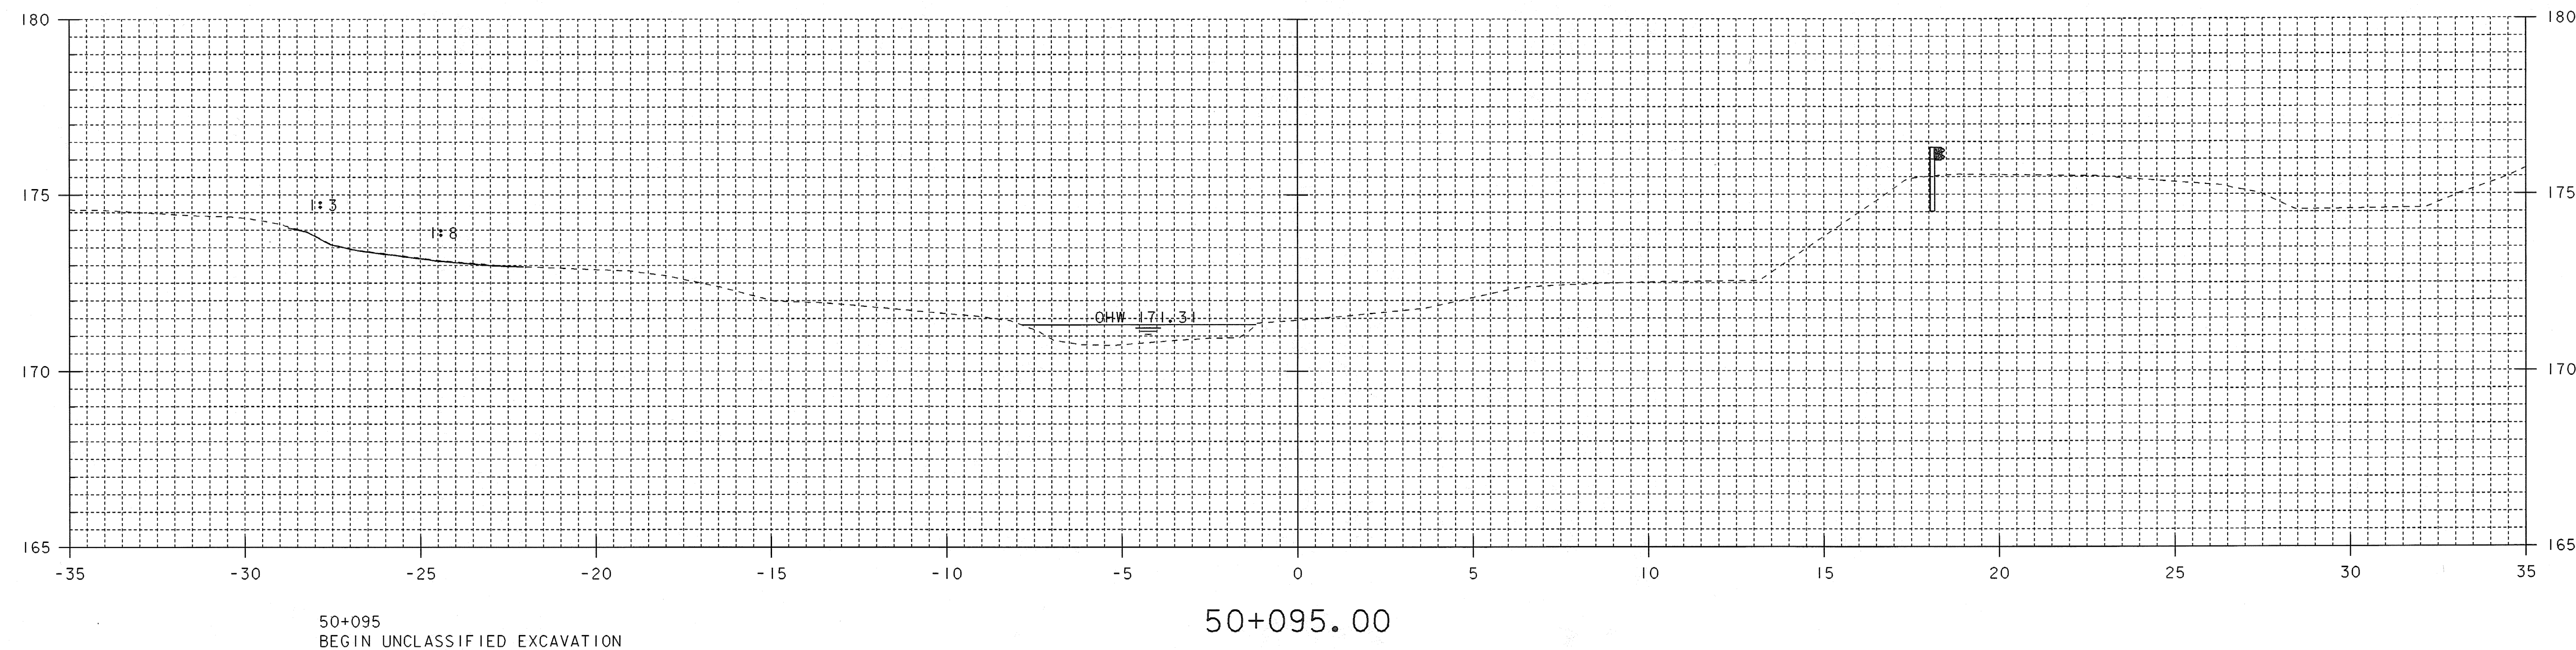

CHANNEL CROSS SECTIONS 4

PROJECT NAME:	GUILFORD	FILE NAME:	sj076c04.i	PLOT DATE:	15-APR-2008
PROJECT NUMBER:	BRO 1442(24)	PROJECT LEADER:	R. WHITCOMB	DRAWN BY:	T. LACKEY
		DESIGNED BY:	J. PERRIGO	CHECKED BY:	T. LACKEY
			94J076\Structures\sj076xs3.dgn	SHEET	55 OF 59

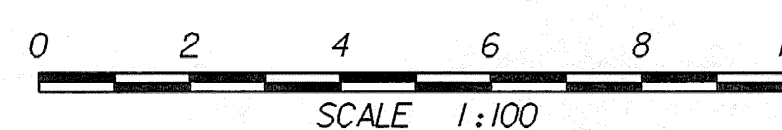

STA. 50+090 TO STA. 50+095