


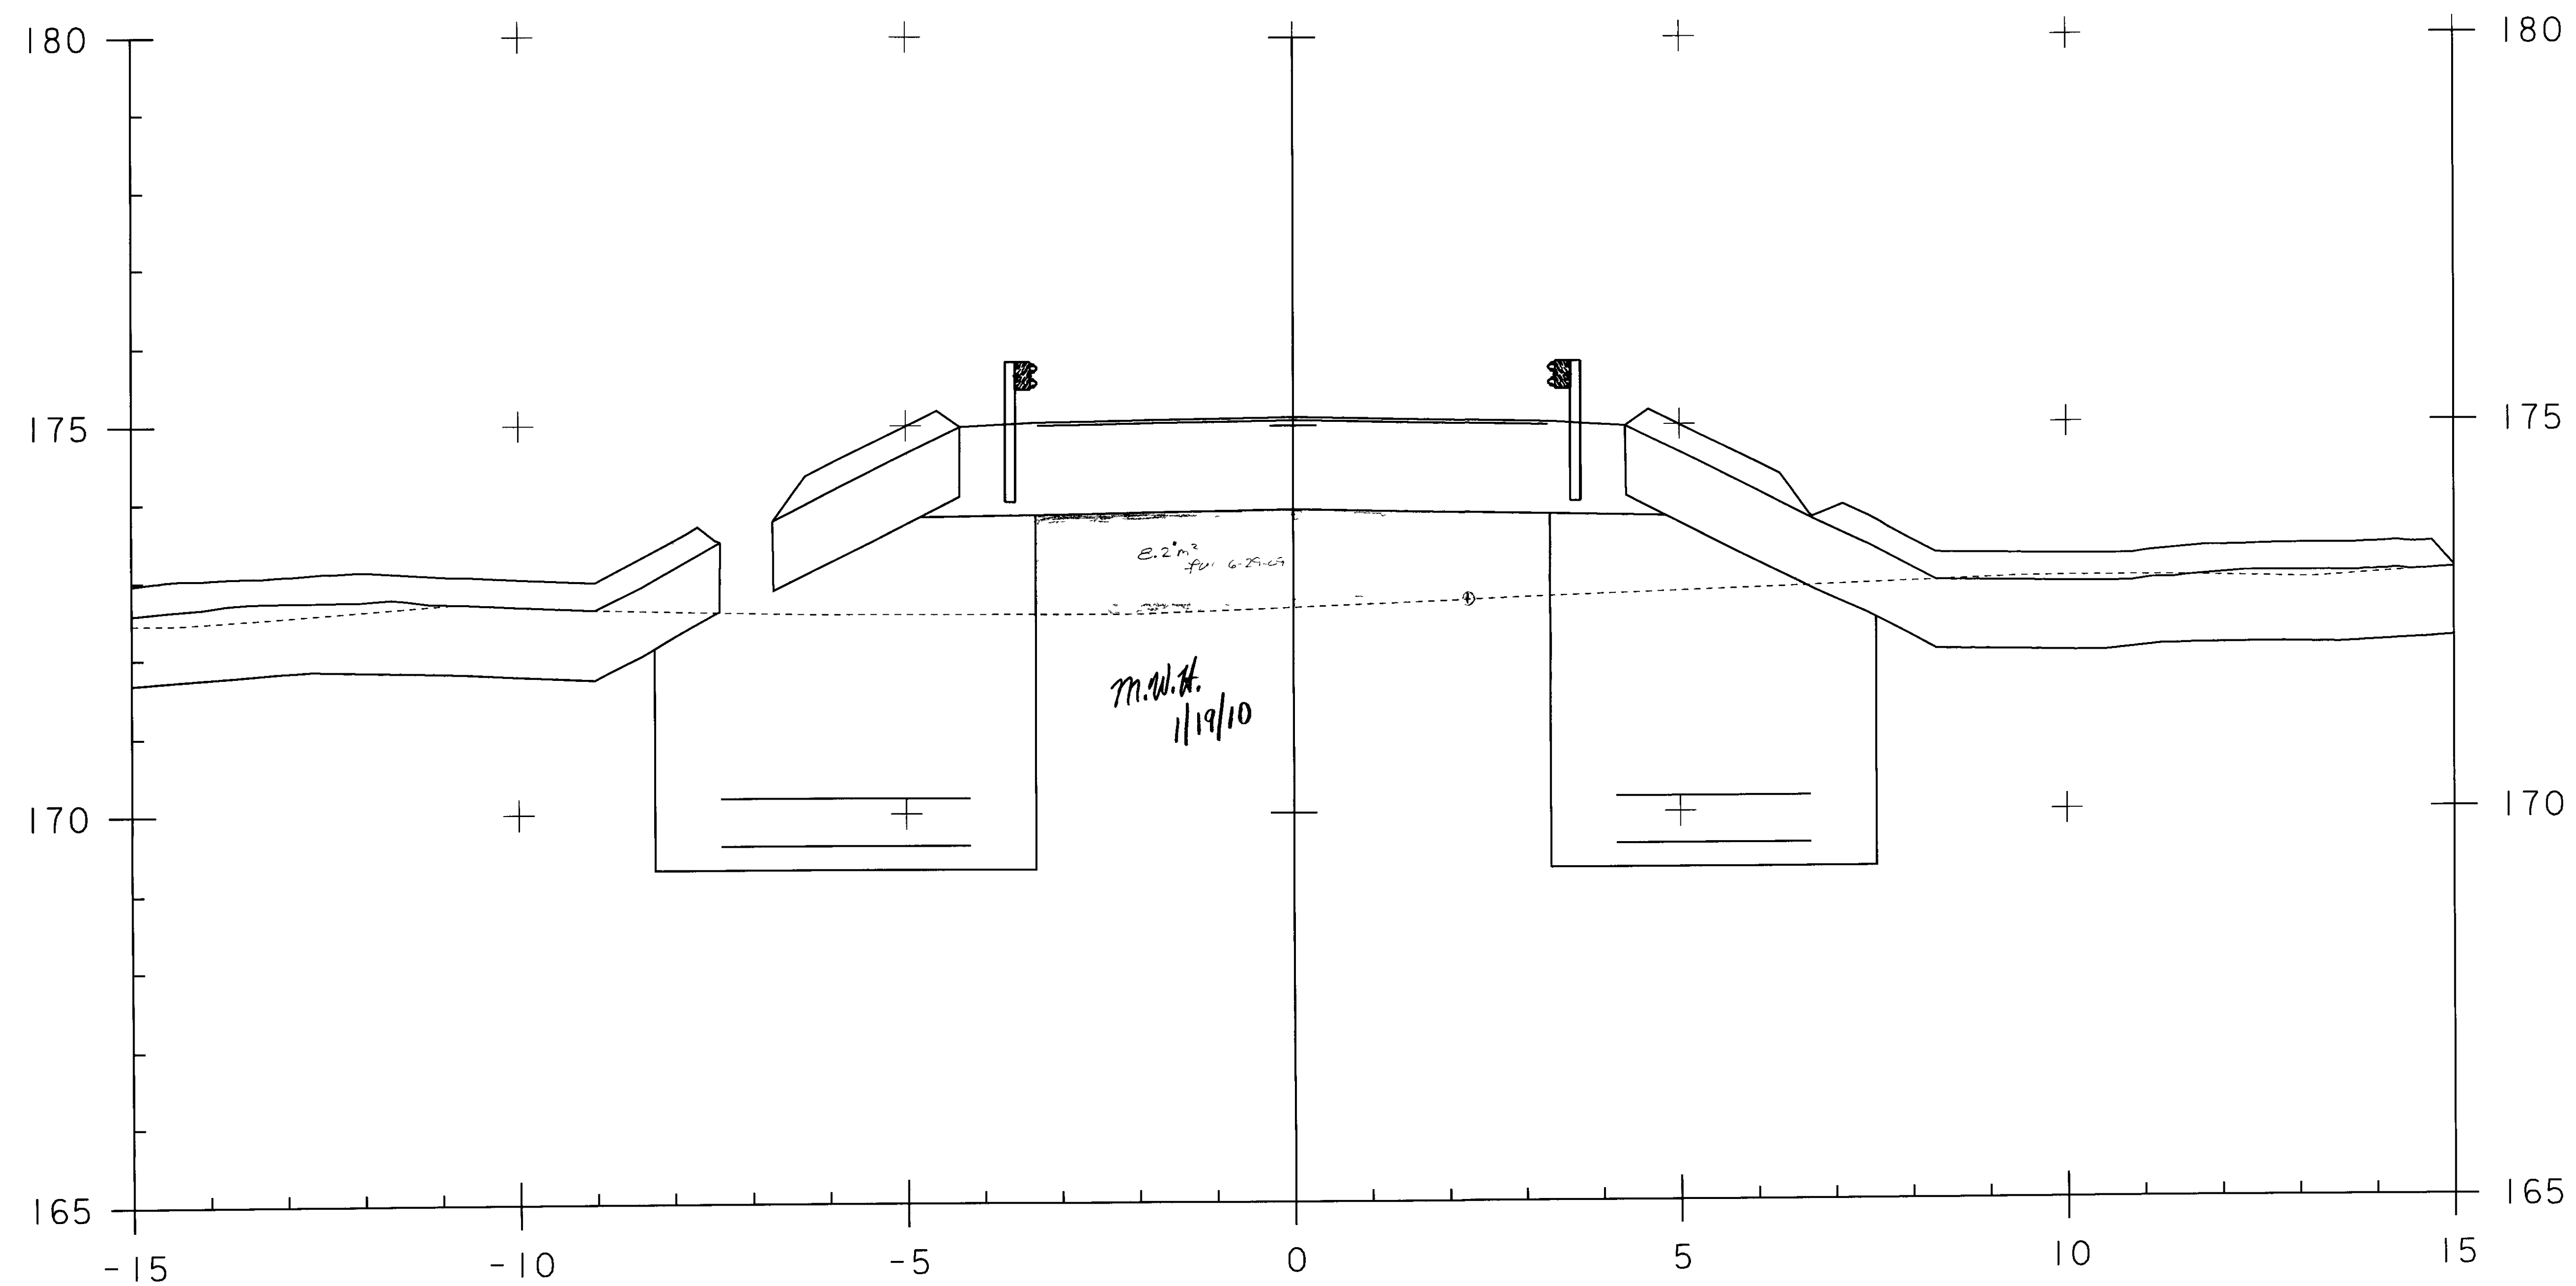

PROJECT NAME: GUILFORD	
PROJECT NUMBER: BRO 1442(24)	
FILE NAME: sj076c31.i	PLOT DATE: 16-JUN-2009
PROJECT LEADER: R. WHITCOMB	DRAWN BY: T. LACKEY
DESIGNED BY:	CHECKED BY:
94J076\Structures\sj076xs3.dgn	SHEET 20 OF 23

STA. 40+116 TO STA. 40+116