




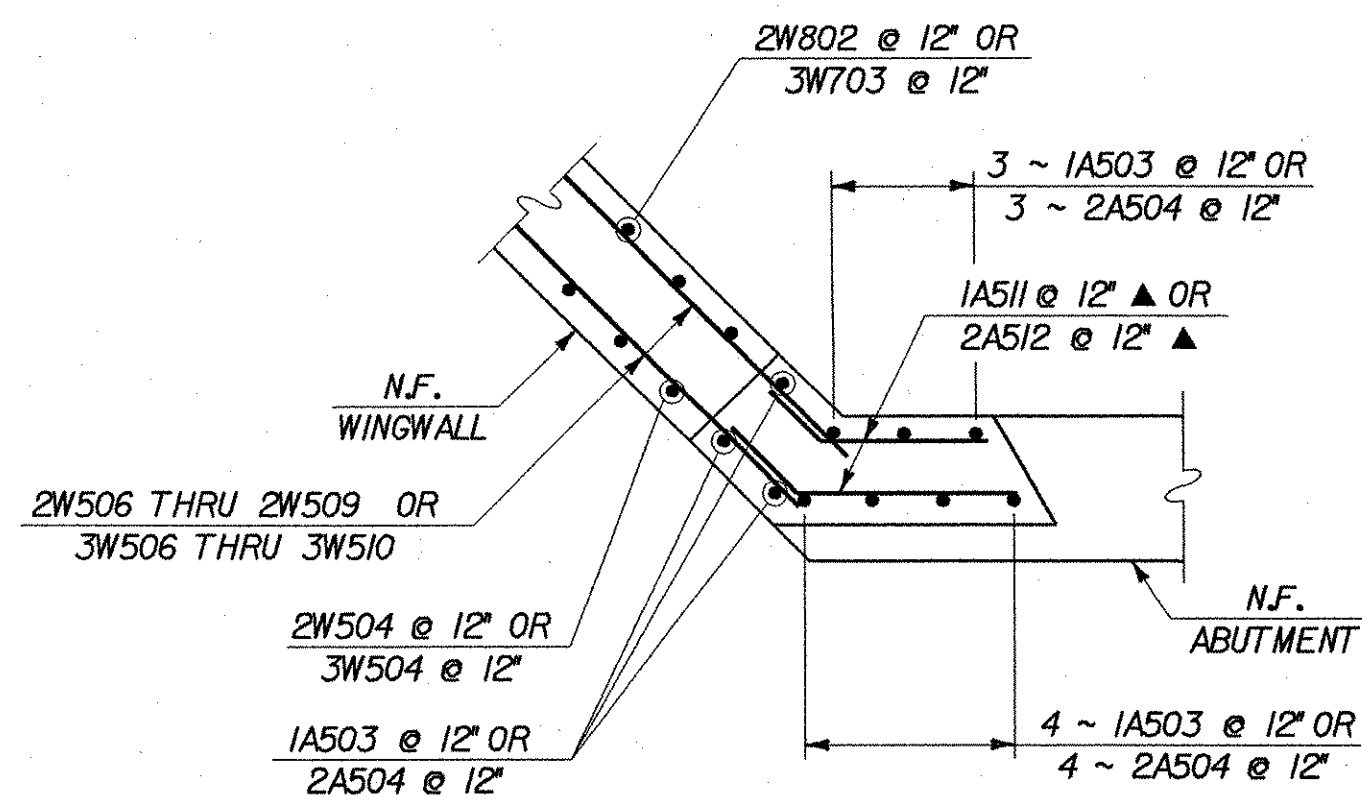


ABOVE BRIDGE SEAT

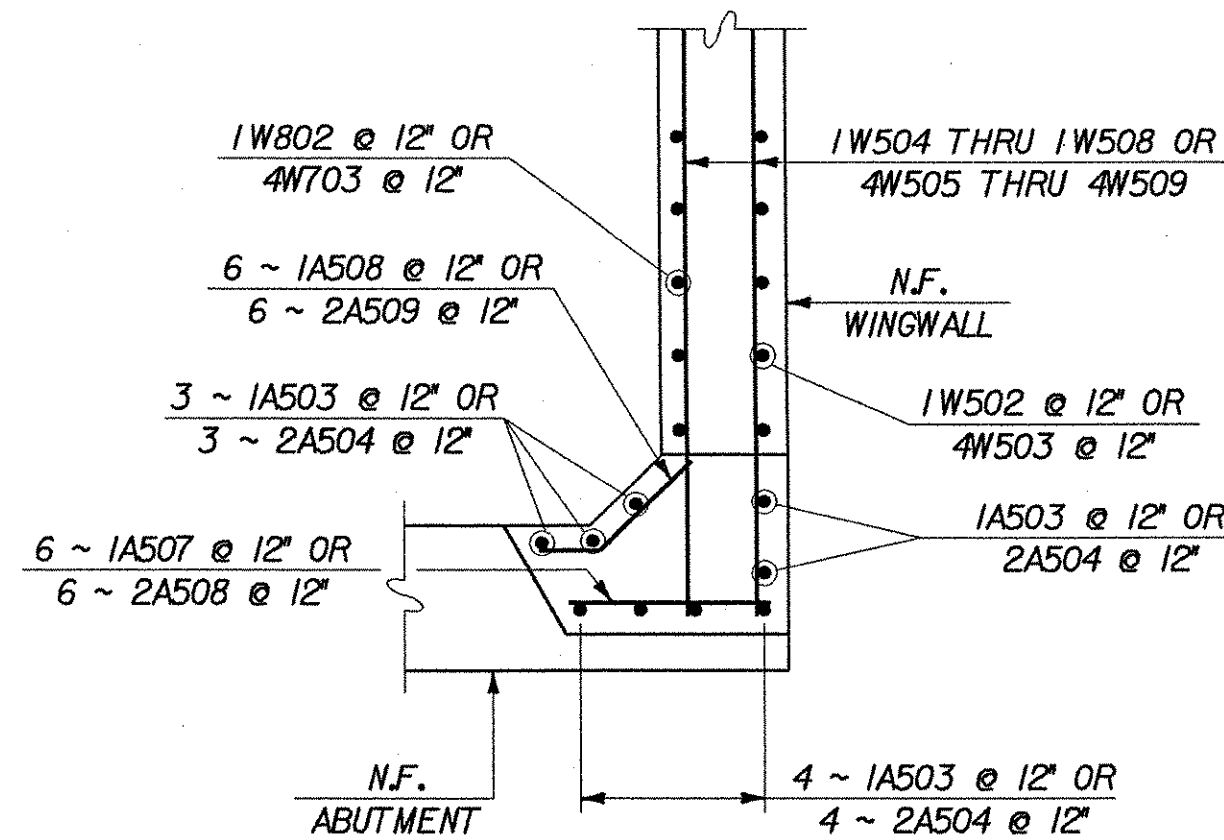

ABOVE BRIDGE SEAT

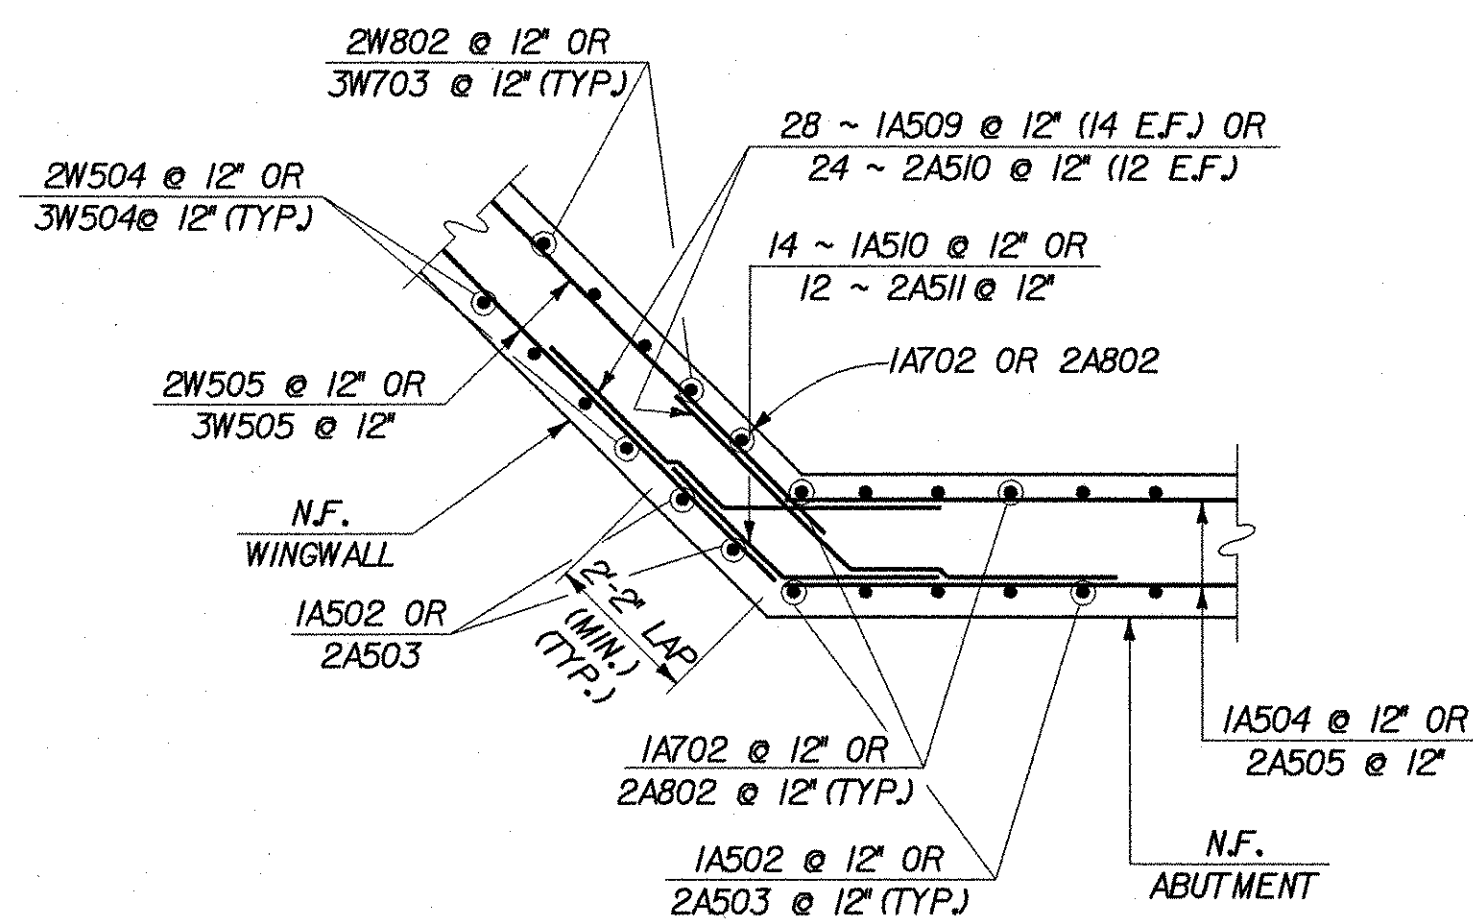

AT ABUTMENT STEM

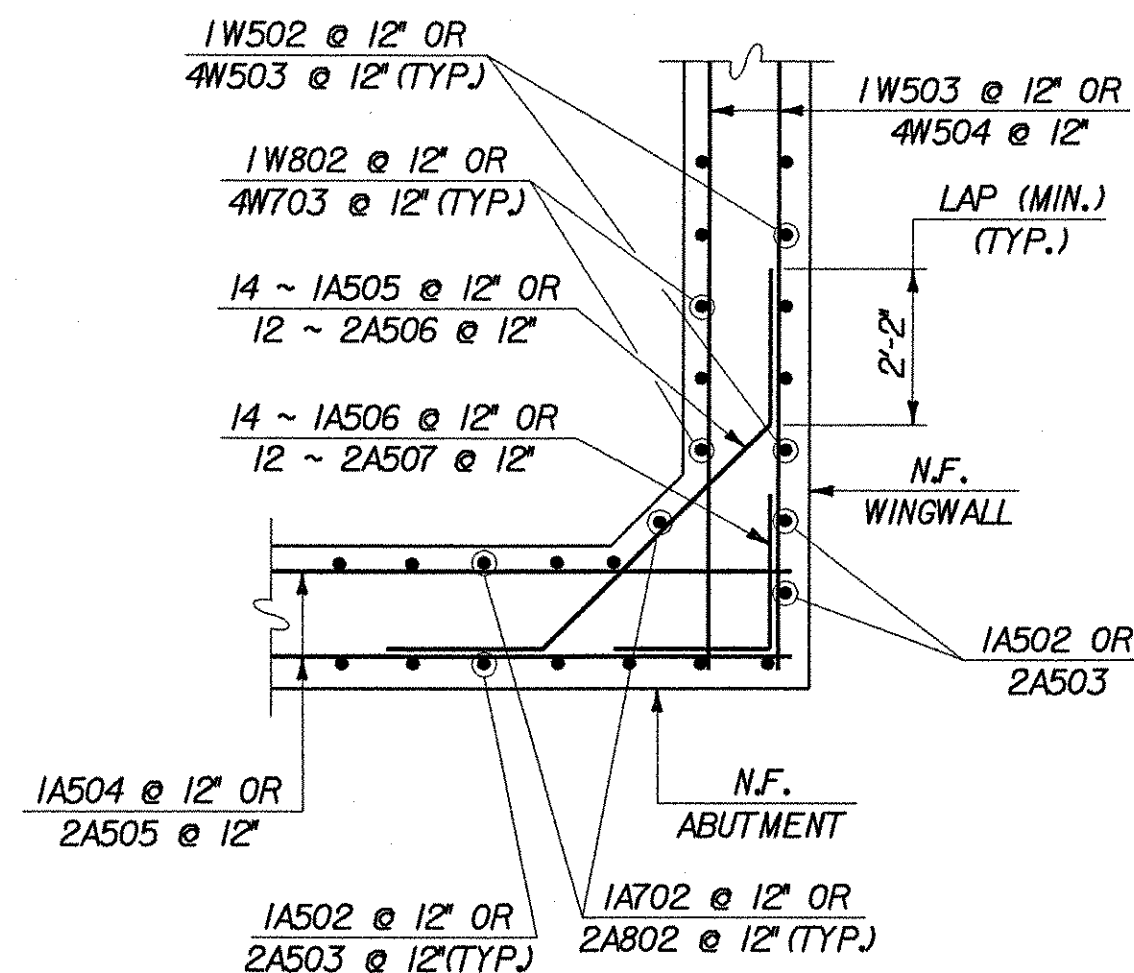


AT ABUTMENT STEM

WINGWALL NO. 2 & NO. 3 CORNER DETAILS

SCALE: 3/8" = 1'-0"


WINGWALL NO. 1 & NO. 4 CORNER DETAILS

SCALE: 3/8" = 1'-0"

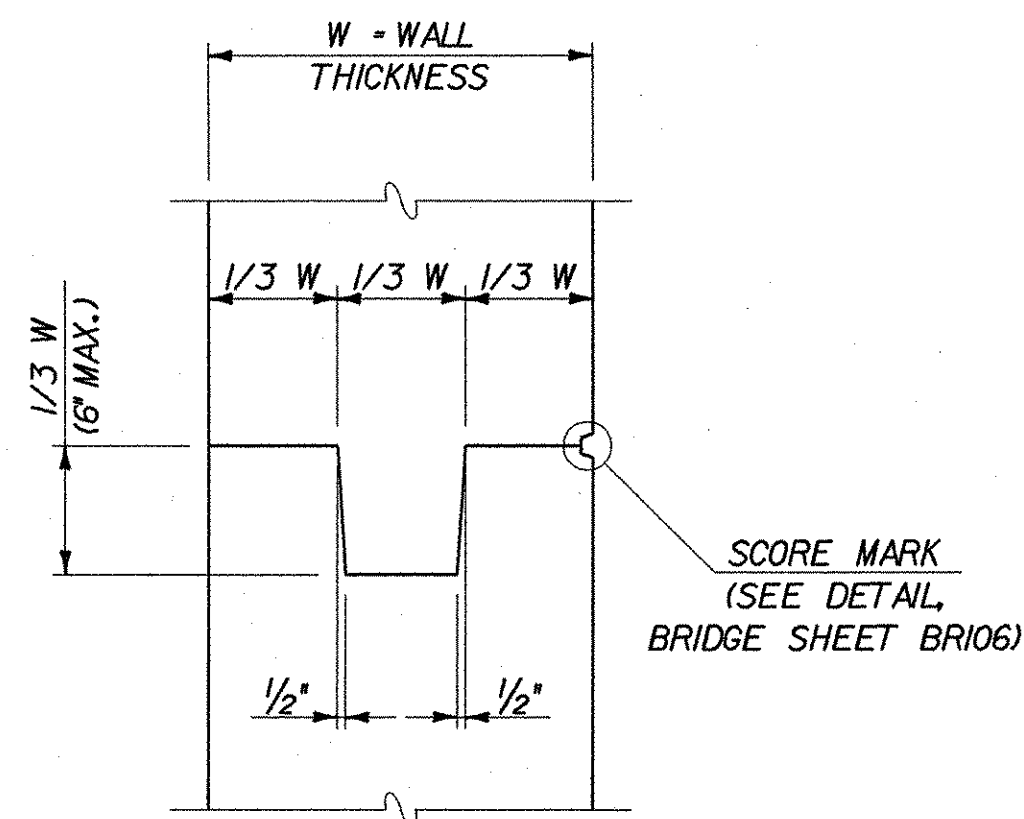


TYPICAL CONCRETE CONSTRUCTION JOINT

SCALE: 1" = 1'-0"

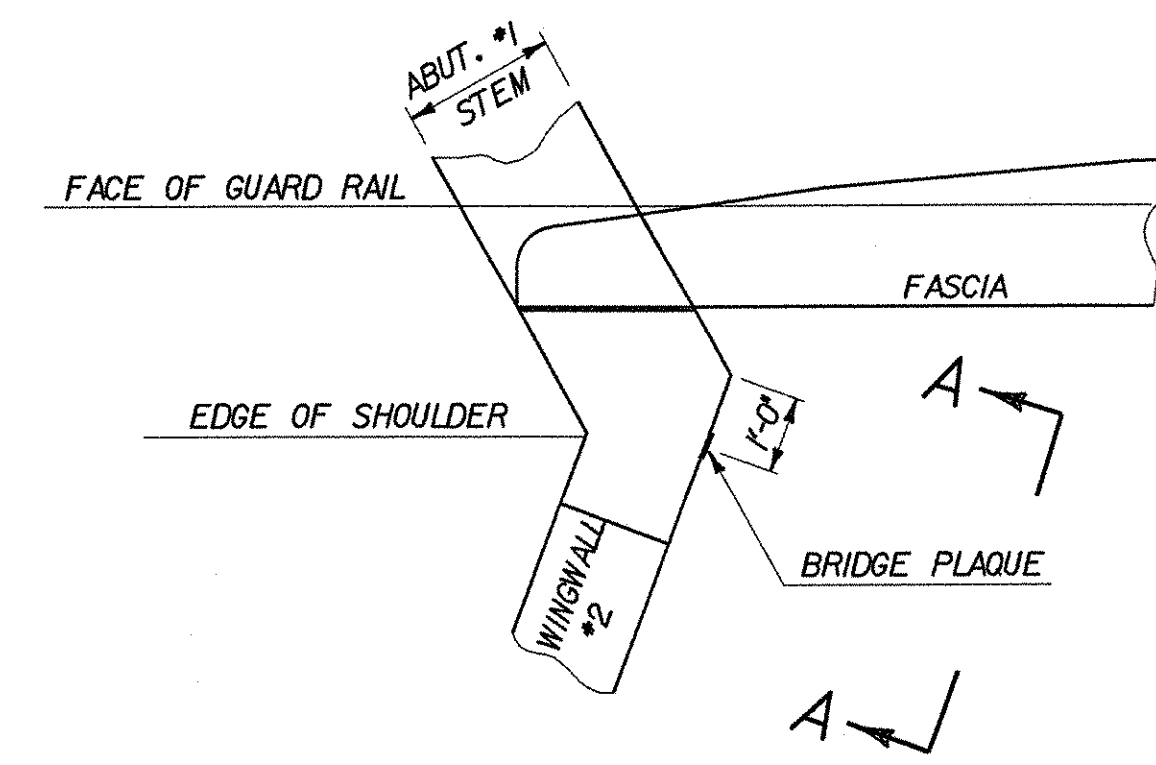

PLAN

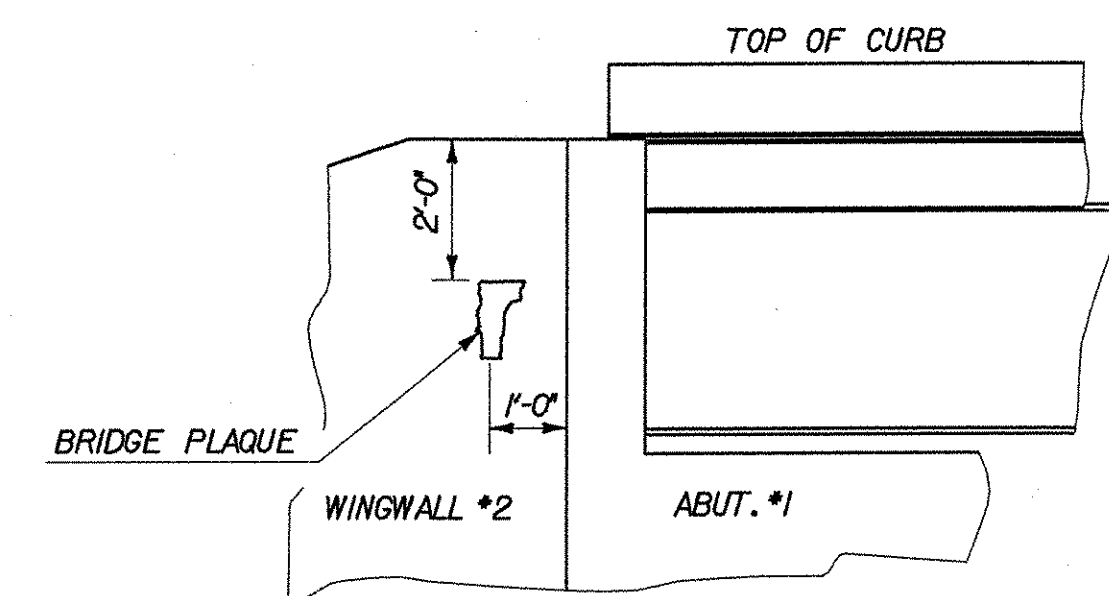

VIEW "A - A"

LOCATE BRIDGE PLAQUE

THE BRIDGE PLAQUE WILL BE SUPPLIED BY THE AGENCY OF TRANSPORTATION AND SHALL BE INSTALLED BY THE CONTRACTOR AT ABUTMENT #1 ON THE RIGHT SIDE AS SHOWN OR AS DIRECTED BY THE ENGINEER.

## NOTES

1. FOR FOOTINGS DETAILS, SEE BRIDGE SHEETS BR113 AND BR115.
2. FOR WINGWALL DETAILS, SEE BRIDGE SHEET BR117.

## LEGEND

- N.F. = NEAR FACE  
F.F. = FAR FACE  
E.F. = EACH FACE  
▲ = CUT TO FIT IN FIELD



McFarland-Johnson, Inc.

## STATE OF VERMONT AGENCY OF TRANSPORTATION

|                                                           |           |                          |              |
|-----------------------------------------------------------|-----------|--------------------------|--------------|
| Town Of                                                   | SHELBURNE | Bridge No.               | 15           |
| Highway No.                                               | TH 3      | Log Sta.                 |              |
|                                                           |           | Surv. Sta.               |              |
| BOSTWICK ROAD OVER VERMONT RAILWAY                        |           |                          |              |
| ABUTMENT DETAILS                                          |           |                          |              |
| Designed By                                               | L. WIXSON | Drawn By                 | S. MERKMAN   |
| Checked By                                                | R. JOY    | Date                     | 05/03        |
|                                                           |           | Bridge Design Supervisor | M. ZYDEL     |
| PROJECT                                                   | SHELBURNE | PROJECT NO.              | BRO 1445(30) |
| I.G.C. Info. MN595402 Bostwick\BRIDGE\gmlar\z\J196abd.dgn |           |                          |              |
| Bridge Sheet No. BR116                                    |           | Sheet 56 of 73           |              |