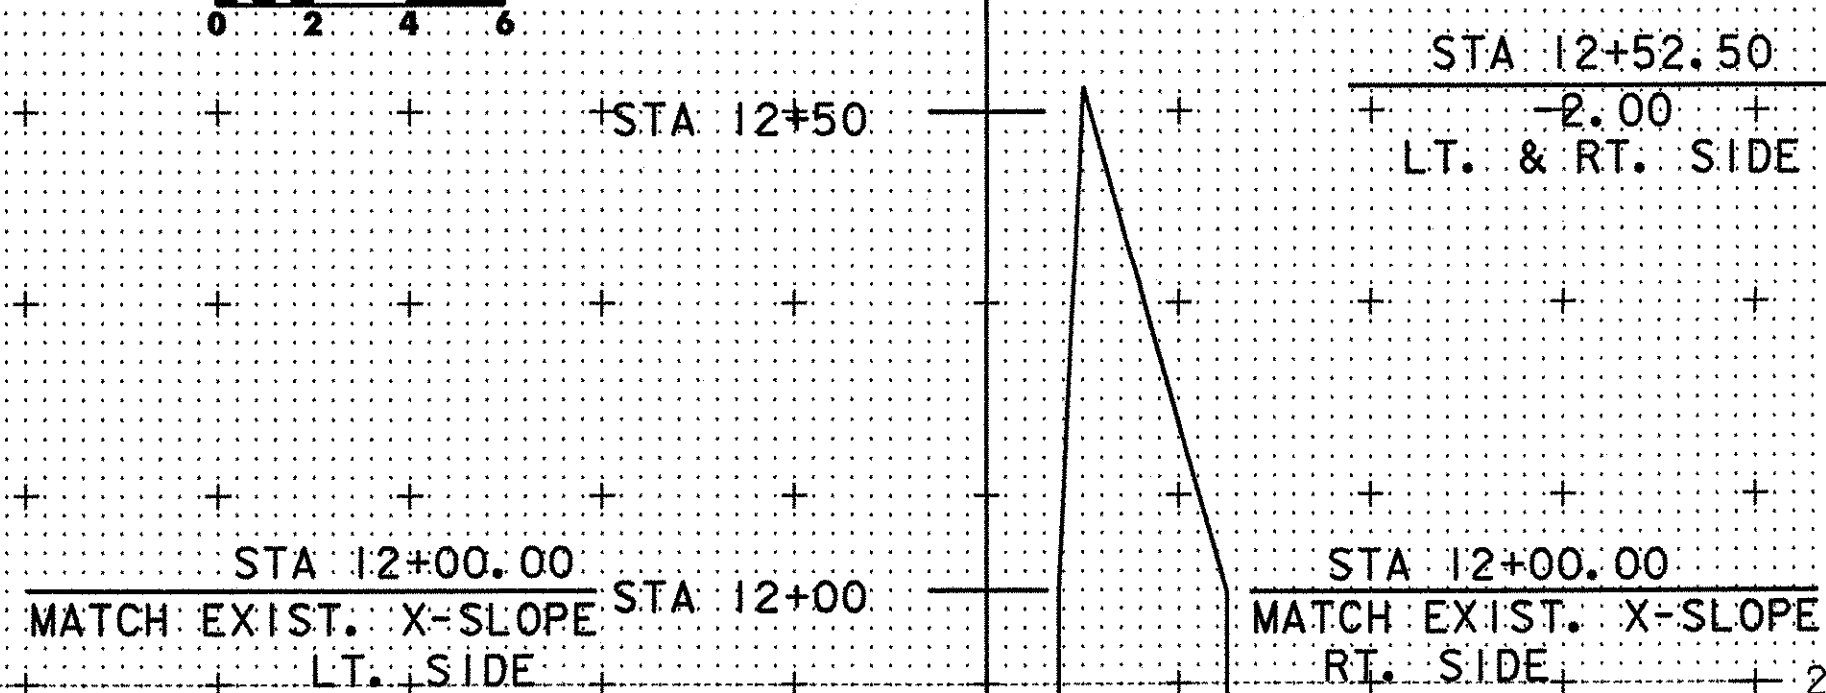
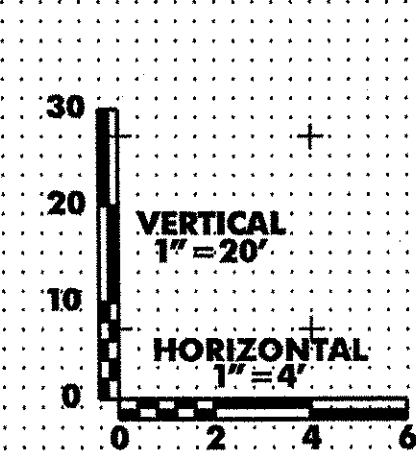
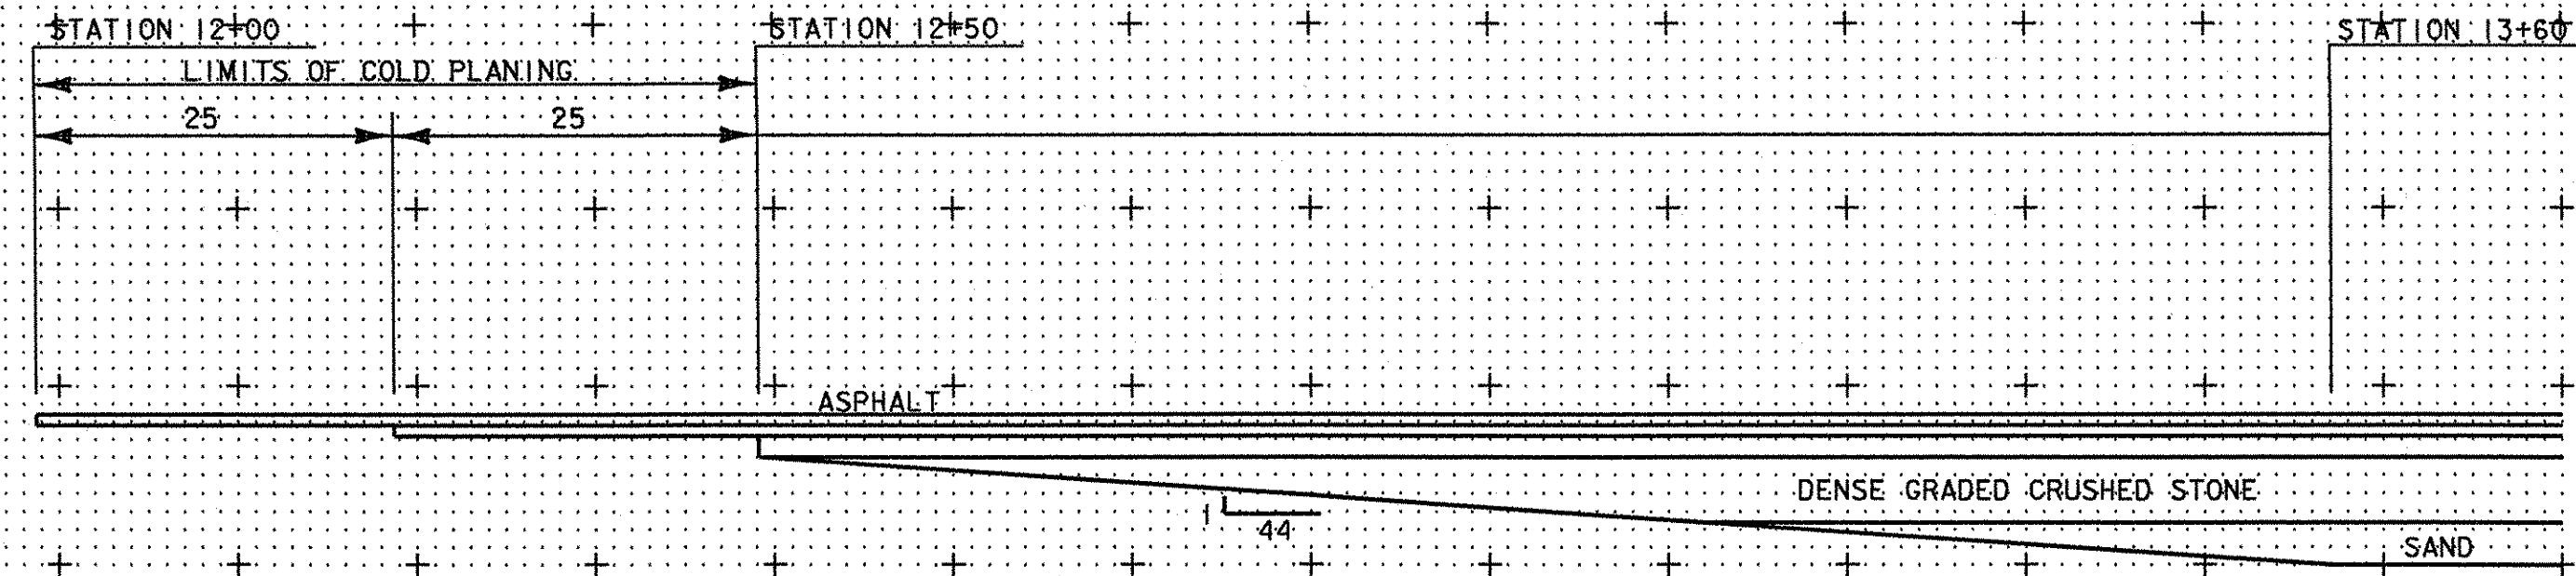


BOSTWICK ROAD	PROJECT NAME: SHELBURNE	
	PROJECT NUMBER: BRO 1445(30)	
	FILE NAME: M:\595402 Bostwick\HWY\DRAW\J196wrk.dgn	PLOT DATE: 01-AUG-2003
	PROJECT LEADER: MBZ	DRAWN BY: DMB
	DESIGNED BY: DMB	CHECKED BY: MDL
		SHEET 59 OF 73