


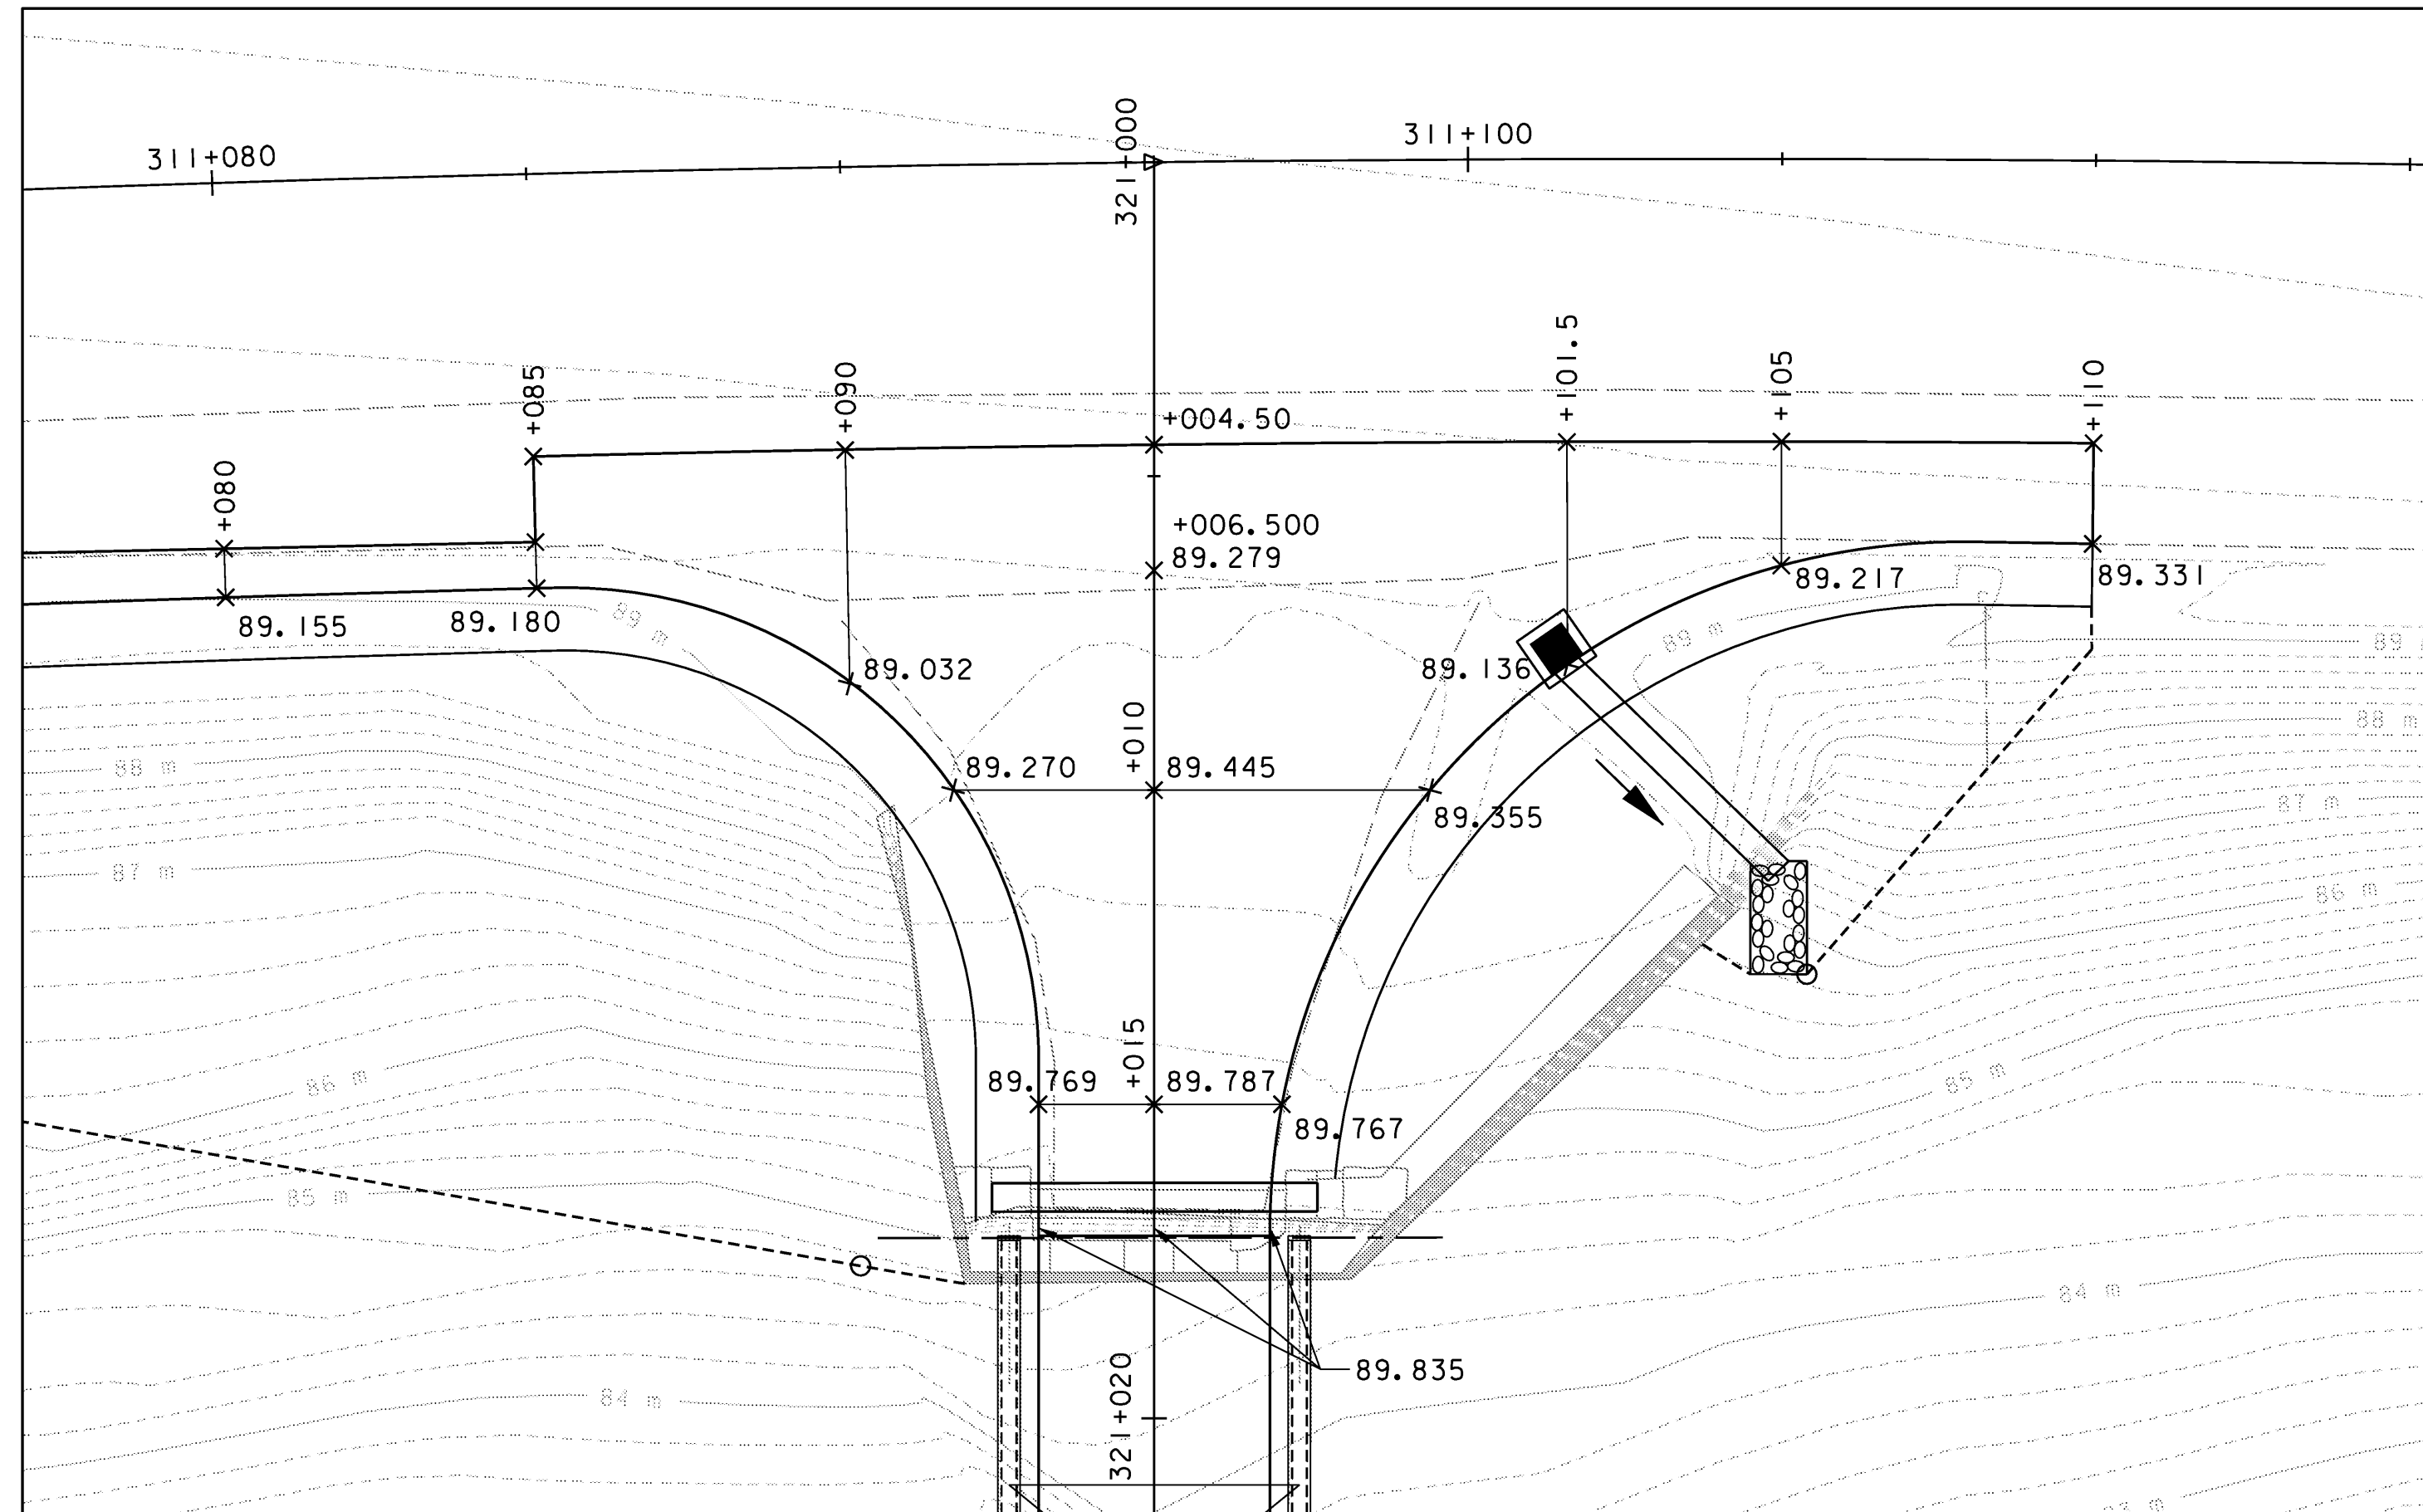


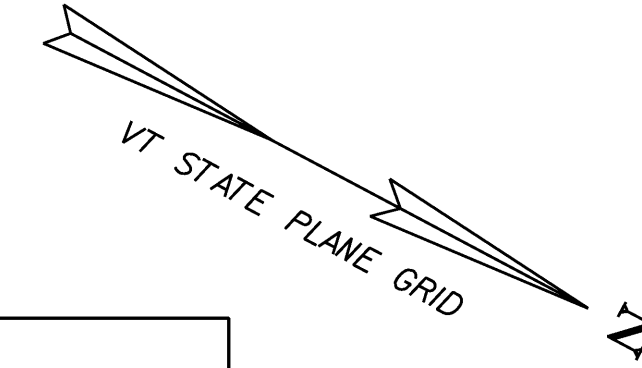

VT 30/TH 62 INTERSECTION GRADING PLAN
SCALE: 1" = 100'

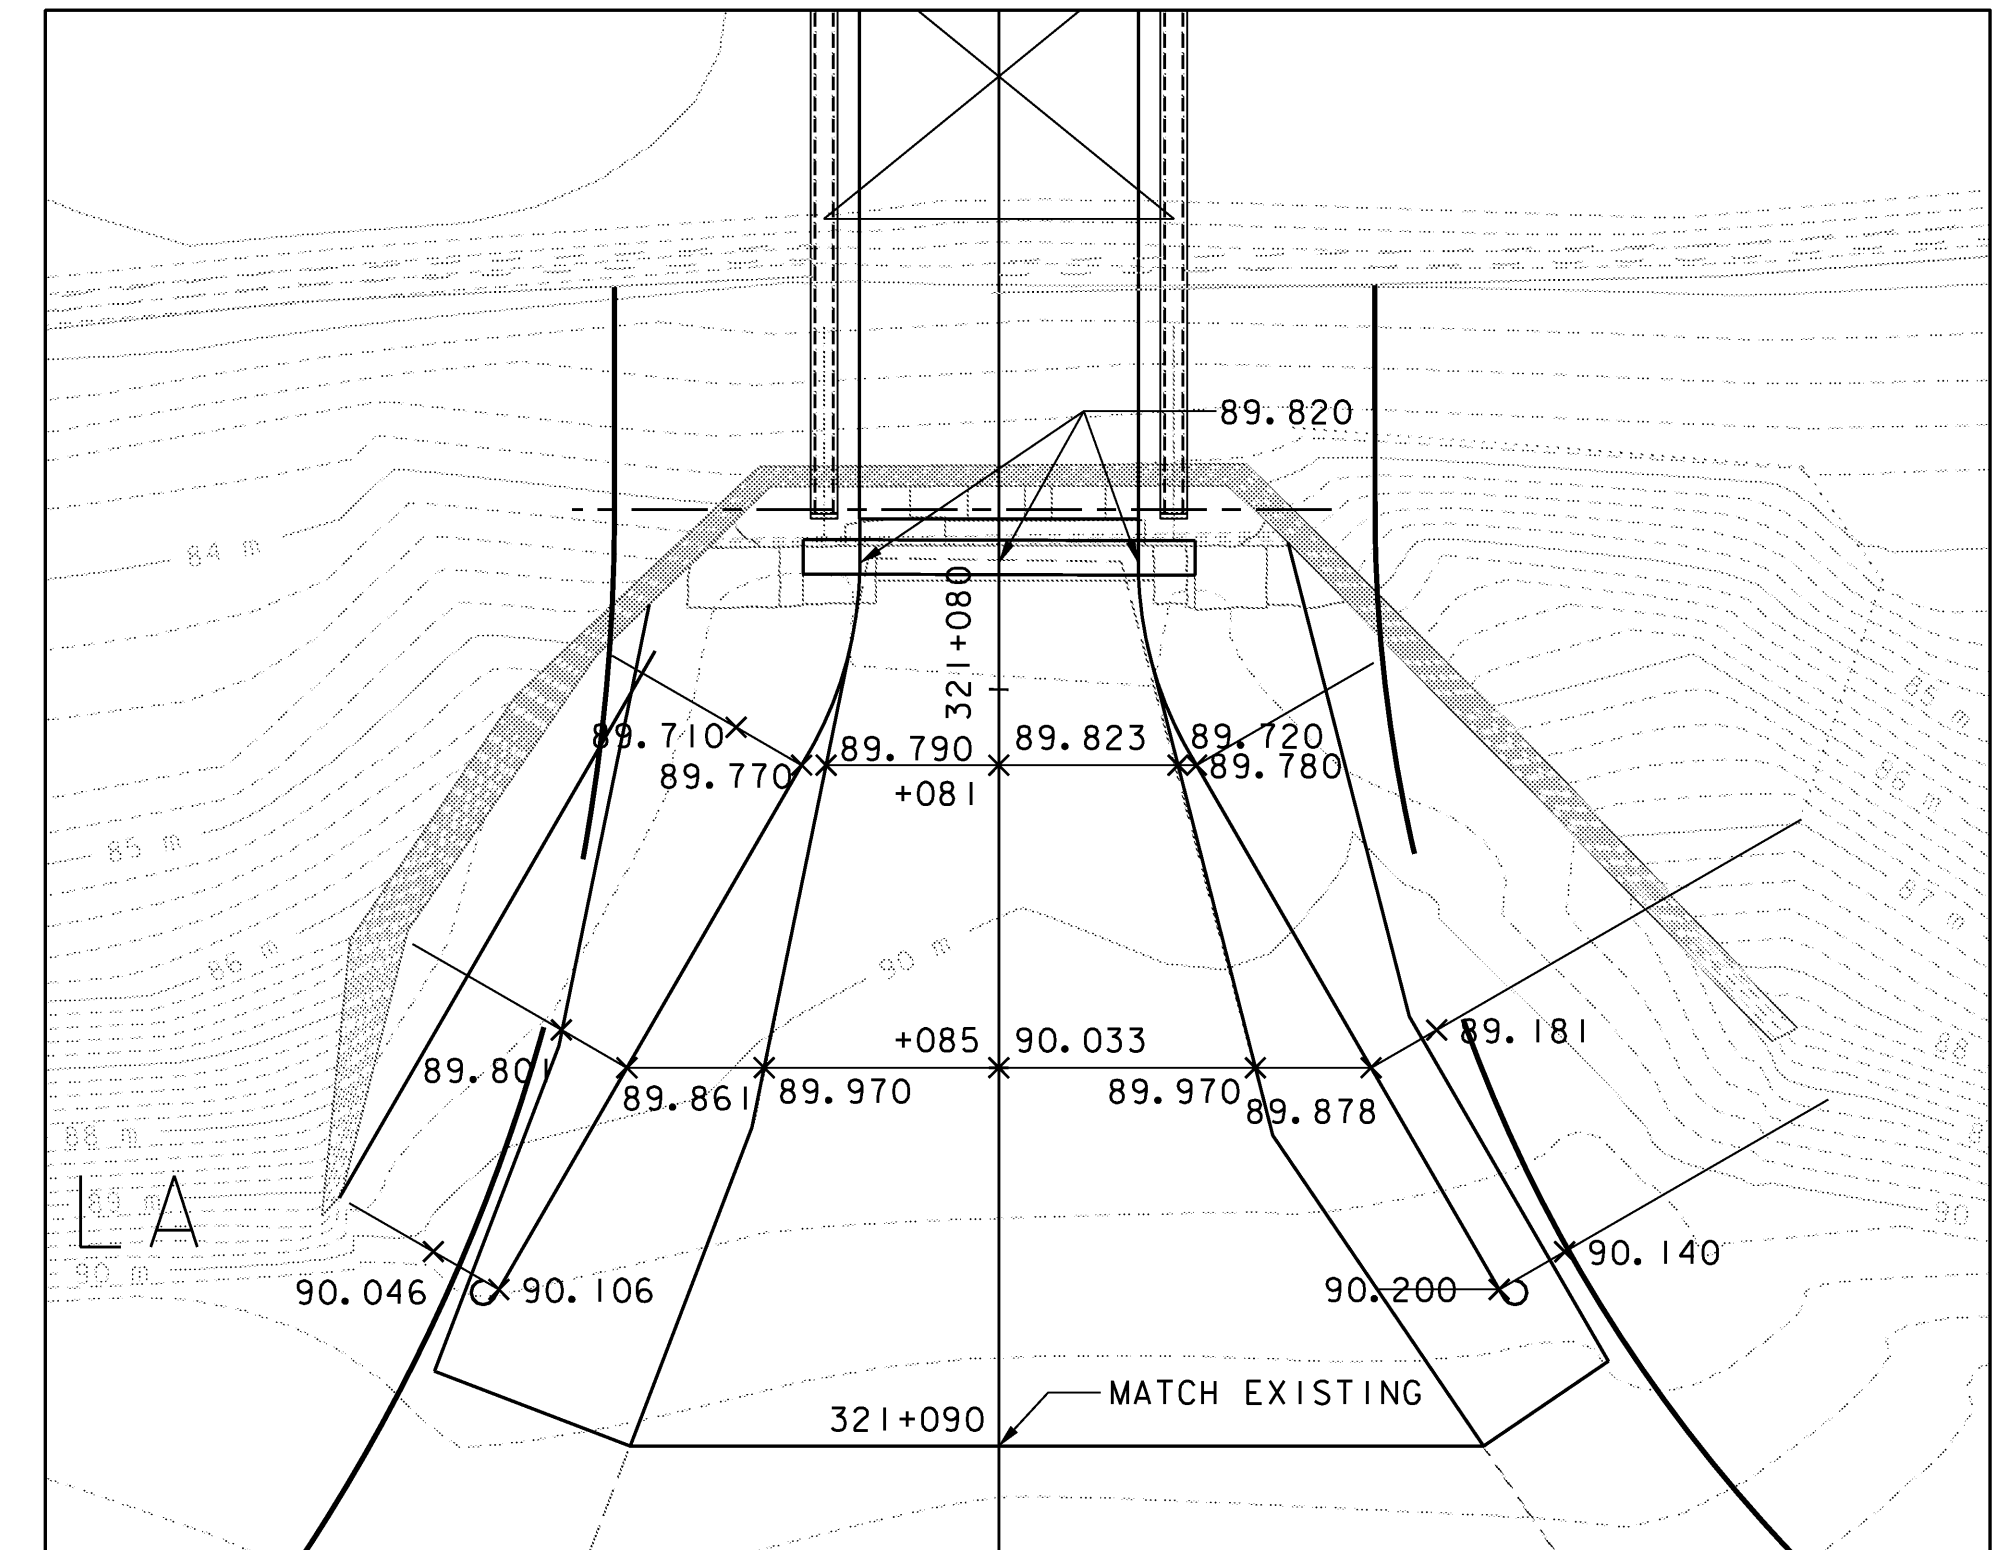

END BRIDGE/TH 62 GRADING PLAN
SCALE: 1" = 100'

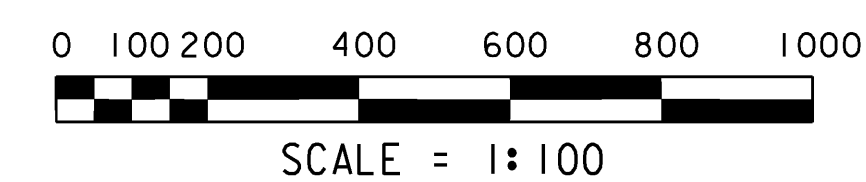

VANASSE HANGEN BRUSTLIN, INC.

STATE OF VERMONT			
AGENCY OF TRANSPORTATION			
Town Of		Bridge No.	
DUMMERSTON		37	
Highway No.		Log Sta.	
TH 62		Surv. Sta.	
TH 62 OVER WEST RIVER			
ROADWAY GRADING PLAN			
Designed By		Drawn By	
C.L. CILLEY		C.L. CILLEY	
Checked By		Bridge Design Supervisor	
Date		Date	
S. M. HODGDON		S. M. HODGDON	
4/09		4/09	
PROJECT		PROJECT NO.	
DUMMERSTON		BHO 1442 (28)	
I.G.C. Info.			
Bridge Sheet No.		Sheet	
ZJ080GR1		33 of 49	