




Nov 06 2009 10:54:09 AM

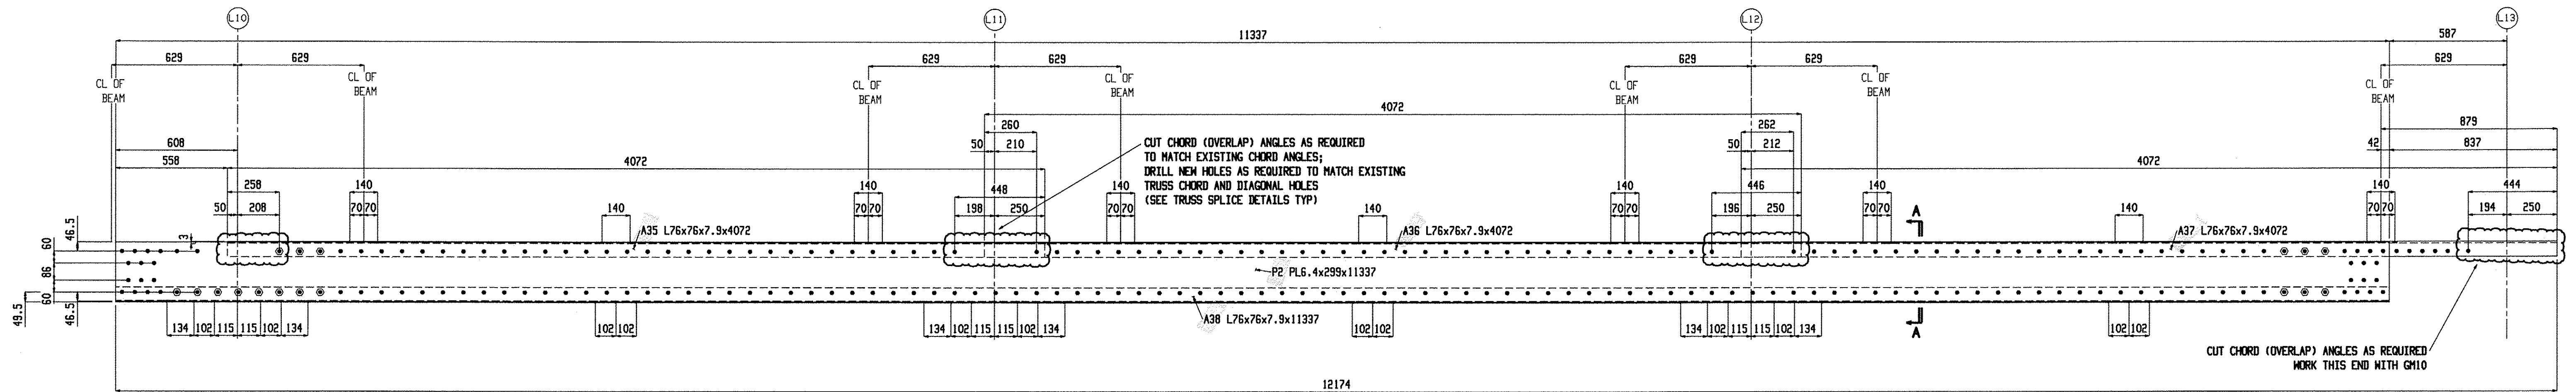


2 GROUP MEMBERS GM9

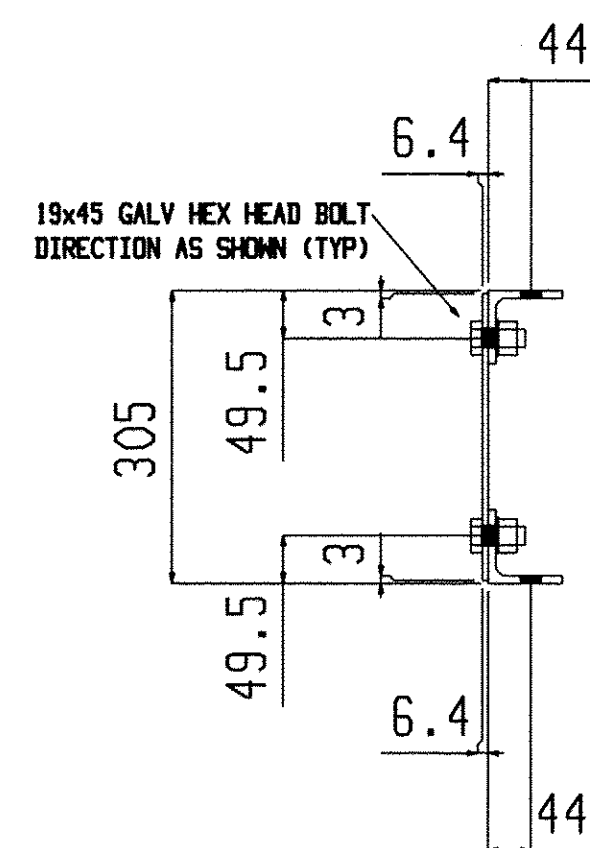

Section A-A
GM10

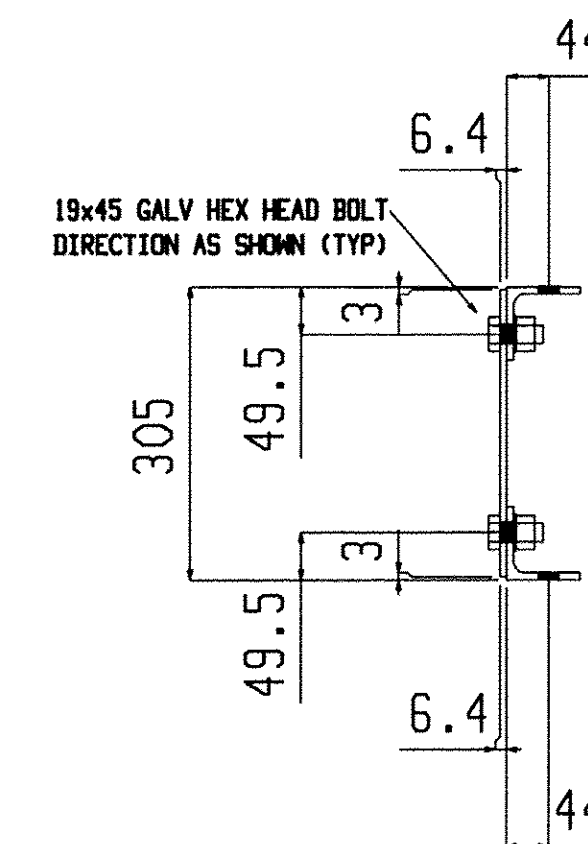

Section A-A
GM9

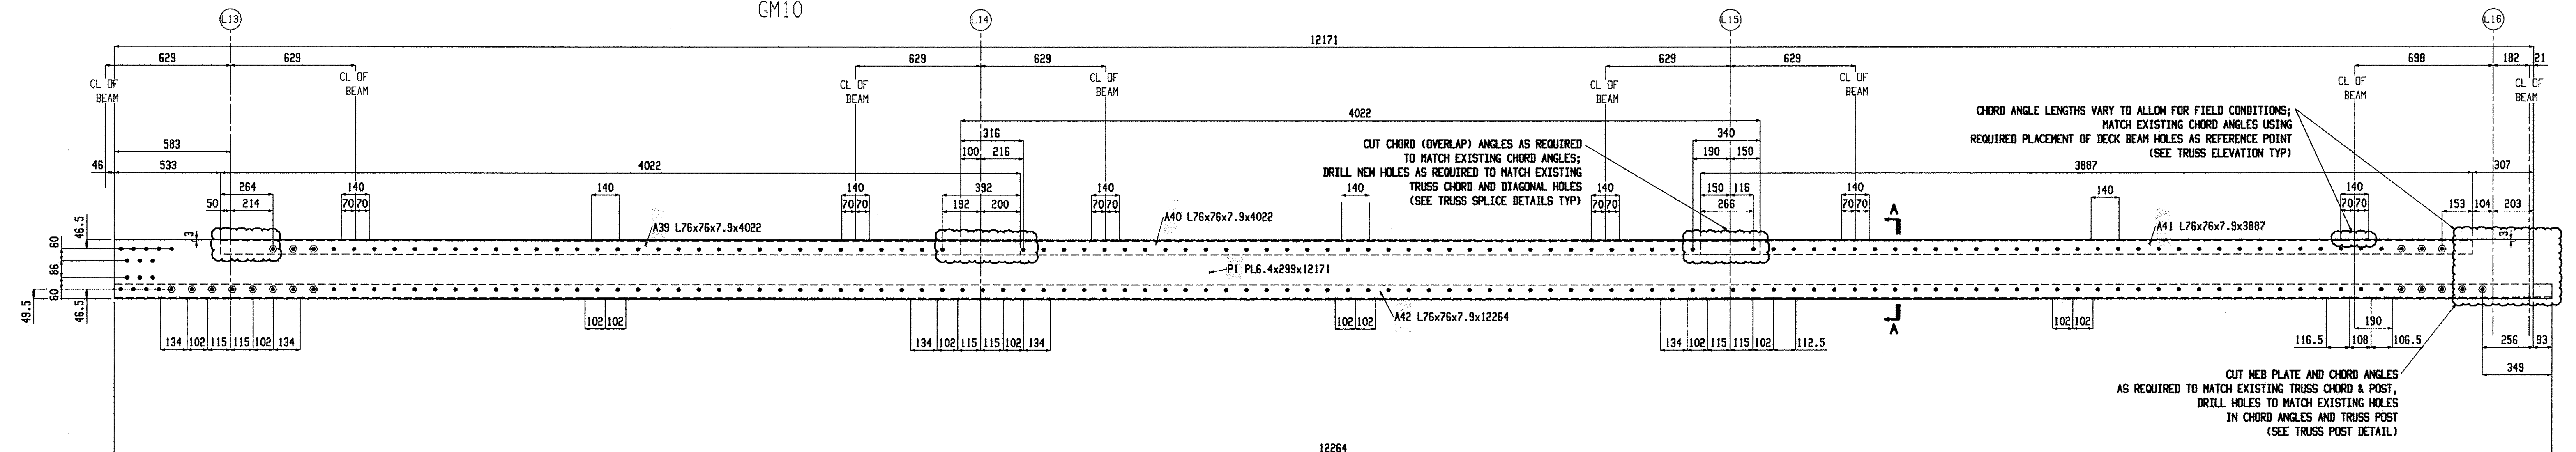

2 GROUP MEMBERS GM10

BILL OF MATERIAL									BILL OF MATERIAL									BILL OF MATERIAL								
Qty	Piece			Seq	Seq	Adv	Steel		Qty	Piece			Seq	Seq	Adv	Steel		Qty	Piece			Seq	Seq	Adv	Steel	
Tot.	Mark	Description	Length	NO.	Qty	ABM #	Grade	Remarks	Tot.	Mark	Description	Length	NO.	Qty	ABM #	Grade	Remarks	Tot.	Mark	Description	Length	NO.	Qty	ABM #	Grade	Remarks
2	GM9	GROUP MEMBER							2	GM10	GROUP MEMBER															
2	P2	PL5.4x299	11337				M270M-345		2	P1	PL6.4x299	12171				M270M-345										
2	A38	L76x76x7.9	11337				M270M-345		2	A42	L76x76x7.9	12264				M270M-345										
2	A37	L76x76x7.9	4072				M270M-345		2	A39	L76x76x7.9	4022				M270M-345										
2	A36	L76x76x7.9	4072				M270M-345		2	A40	L76x76x7.9	4022				M270M-345										
2	A35	L76x76x7.9	4072				M270M-345		2	A41	L76x76x7.9	3887				M270M-345										

Total weight : 1565

RECEIVED
NOV 17 2009
RESUBMIT APPROVED
BY DATE

Renaud Bros. Inc. 283 Fort Bridgeman Rd. #2 Vernon, VT. 05354 Phone 1-802 257-7383		Holes:	21mm UNO
		BOLTS:	19mm DIA. M164M-I GALV UNO
		Steel GR:	M270M-GR345 UNO
		Paint:	PER SPECS (GREEN) UNO
Rev.No:	Date:	Surface Prep:	PER SPECS
Project: DUMMERSTON BRIDGE DUMMERSTON, VT		Date: 9-9-09	Job No. 8401442(28)
DMN. BY: EG	Checked: MRS	Sheet No. GM9, GM10	Product?