


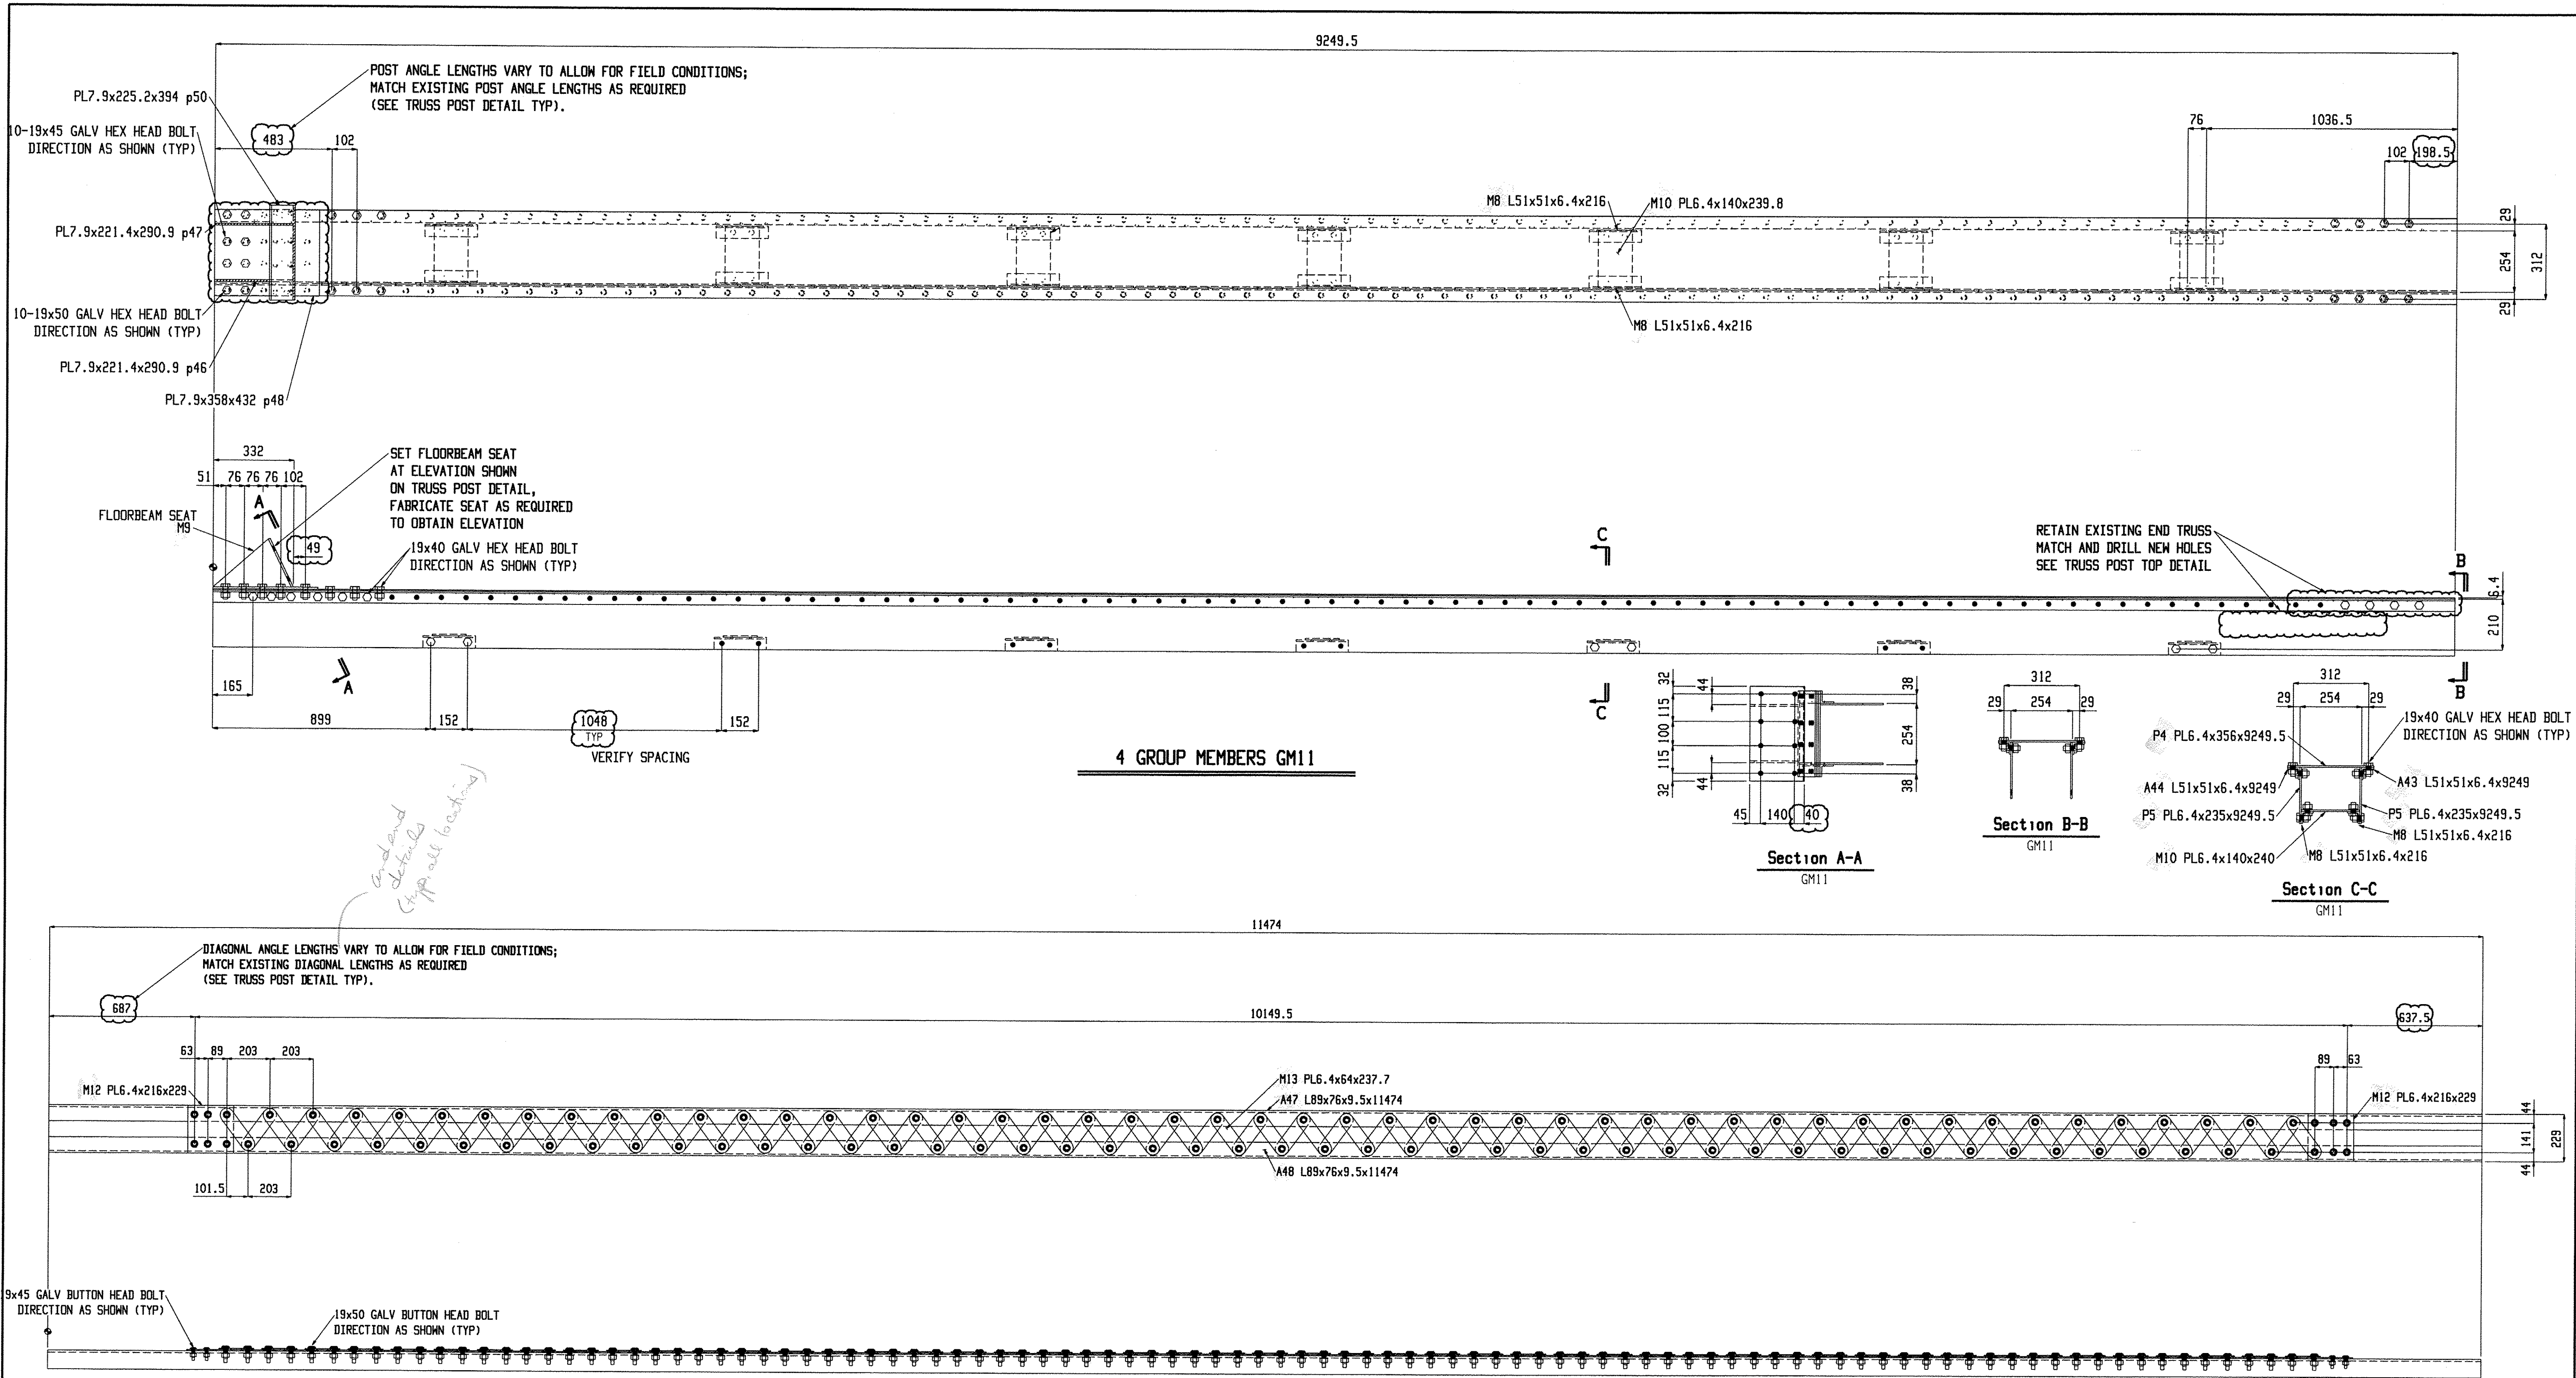

BILL OF MATERIAL									BILL OF MATERIAL									BILL OF MATERIAL								
Qty	Piece			Seq	Seq	Adv	Steel		Qty	Piece			Seq	Seq	Adv	Steel		Qty	Piece			Seq	Seq	Adv	Steel	
Tot.	Mark	Description	Length	NO.	Qty	ABM #	Grade	Remarks	Tot.	Mark	Description	Length	NO.	Qty	ABM #	Grade	Remarks	Tot.	Mark	Description	Length	NO.	Qty	ABM #	Grade	Remarks
4	GM11	GROUP MEMBER							4	p46	PL7.9x221.4	291				M270M-345		388	M13	PL6.4x64	237.5				M270M-345	
56	M8	L51x51x6.4	216				M270M-345		4	p47	PL7.9x221.4	291				M270M-345		4	A48	L89x76x9.5	11474				M270M-345	
28	M10	PL6.4x140	240				M270M-345											4	A47	L89x76x9.5	11474				M270M-345	
4	p48	PL7.9x358	432				M270M-345																			
8	P5	PL6.4x235	9249.5				M270M-345																			
4	P4	PL6.4x356	9249.5				M270M-345																			
4	A43	L51x51x6.4	9249				M270M-345																			
4	A44	L51x51x6.4	9249				M270M-345		4	GM12	GROUP MEMBER															
4	p50	PL7.9x225.2	394				M270M-345		8	M12	PL6.4x216	229				M270M-345										

Total weight : 3450

RECEIVED

OK'D BY _____

NOV 17 2009

BY _____ DATE _____

Rev.No:

Date:

DWN. BY: EG

Checked: MRS

Holes: 21mm UNO

BOLTS: 19mm DIA. M164M-I GALV UNO

Steel GR: M270M-GR345 UNO

Paint: PER SPECS (GREEN) UNO

Surface Prep: PER SPECS

Project: DUMMERSTON BRIDGE

DUMMERSTON, VT

Job No. BHO 1442 (23)

Sheet No. GM11, GM12

Nov 06 2009 10:54:14 AM