




Nov 06 2009 10:54:40 AM

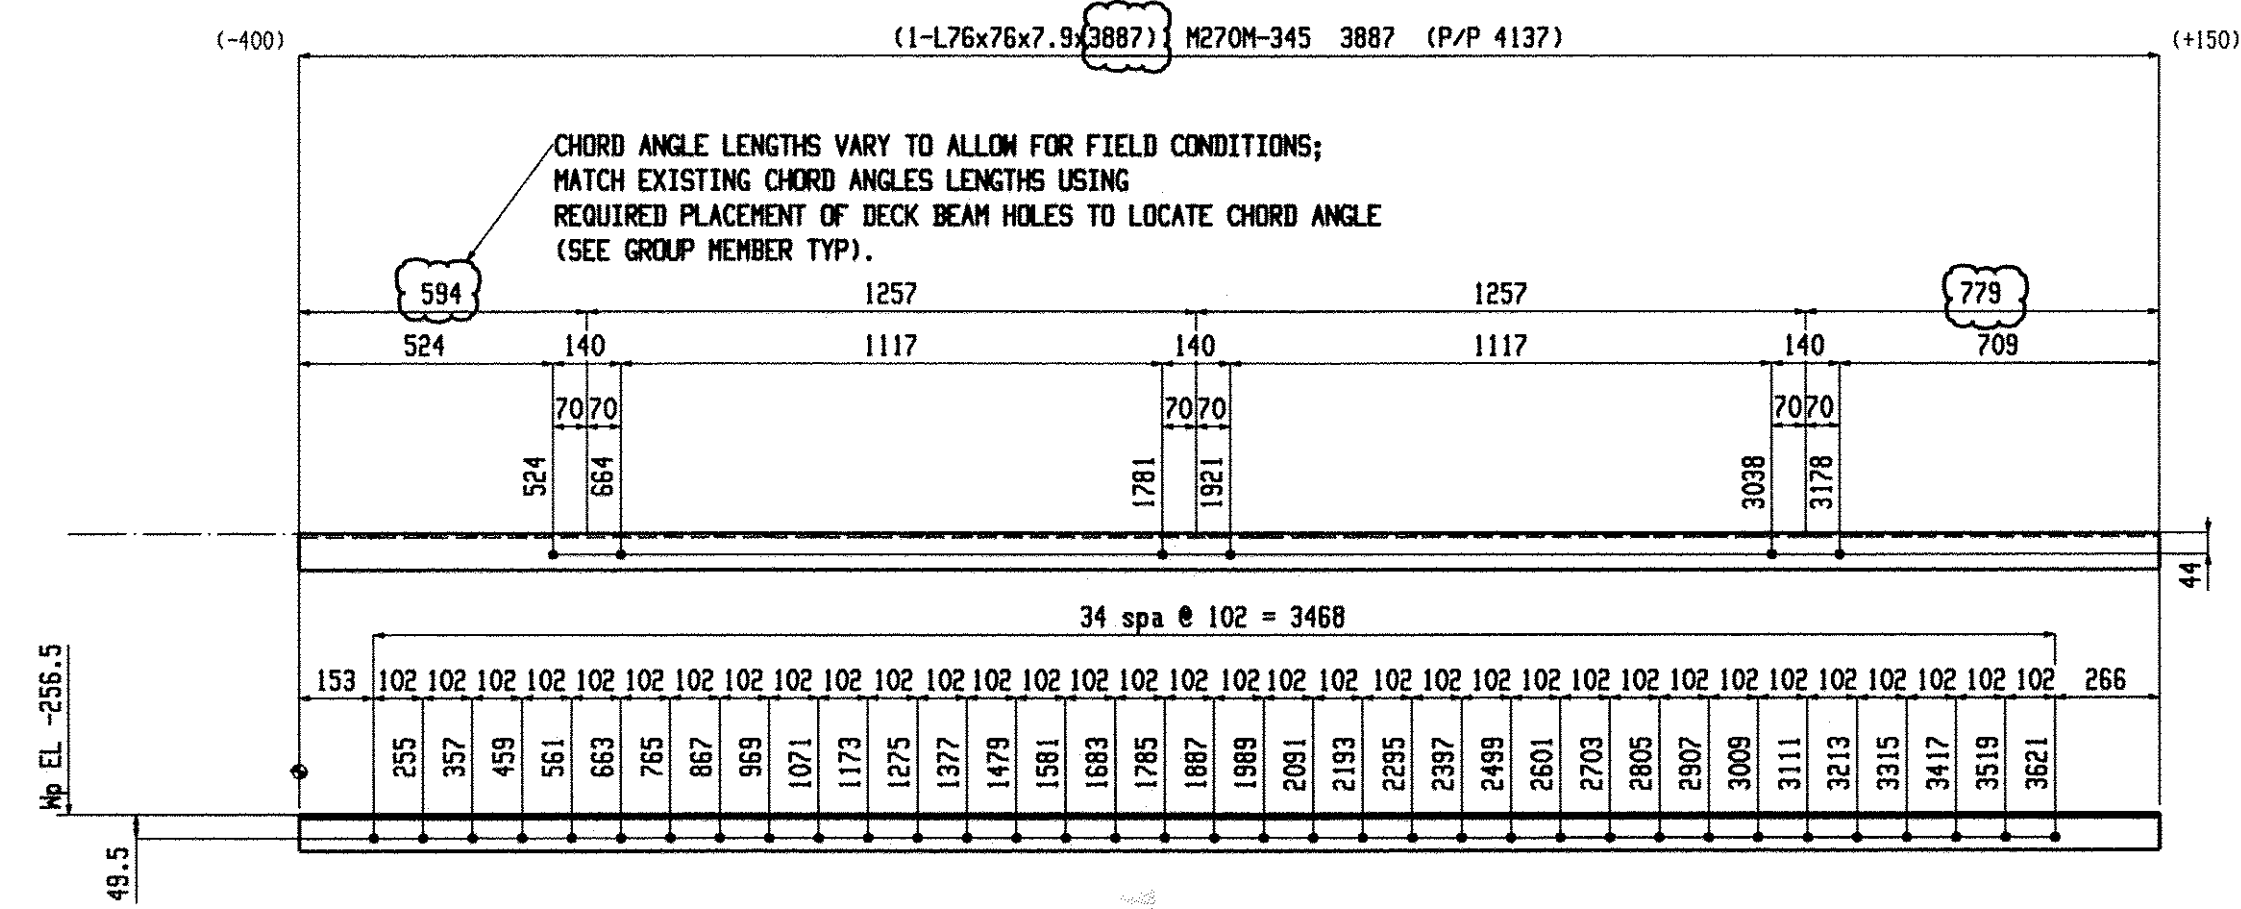

2 ANGLES A1
SHOP NOTE:
TOE DIRECTION NEAR SIDE

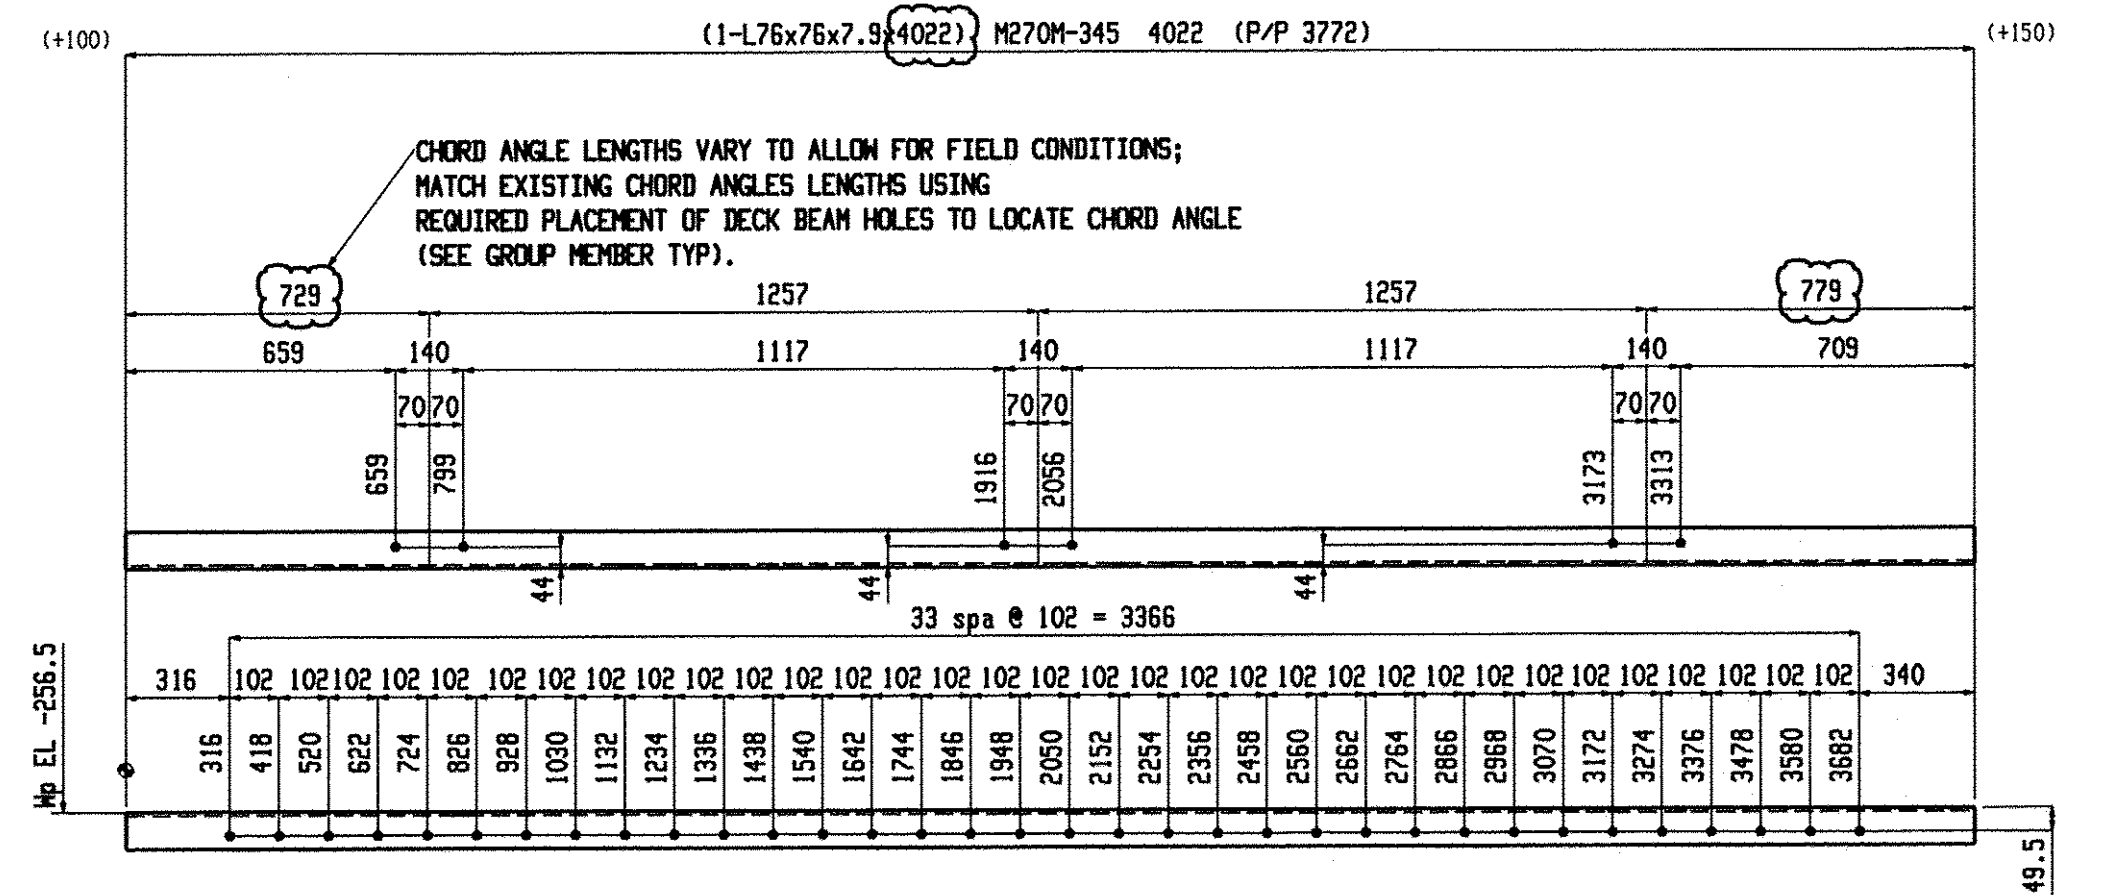

2 ANGLES A2
SHOP NOTE:
TOE DIRECTION FAR SIDE

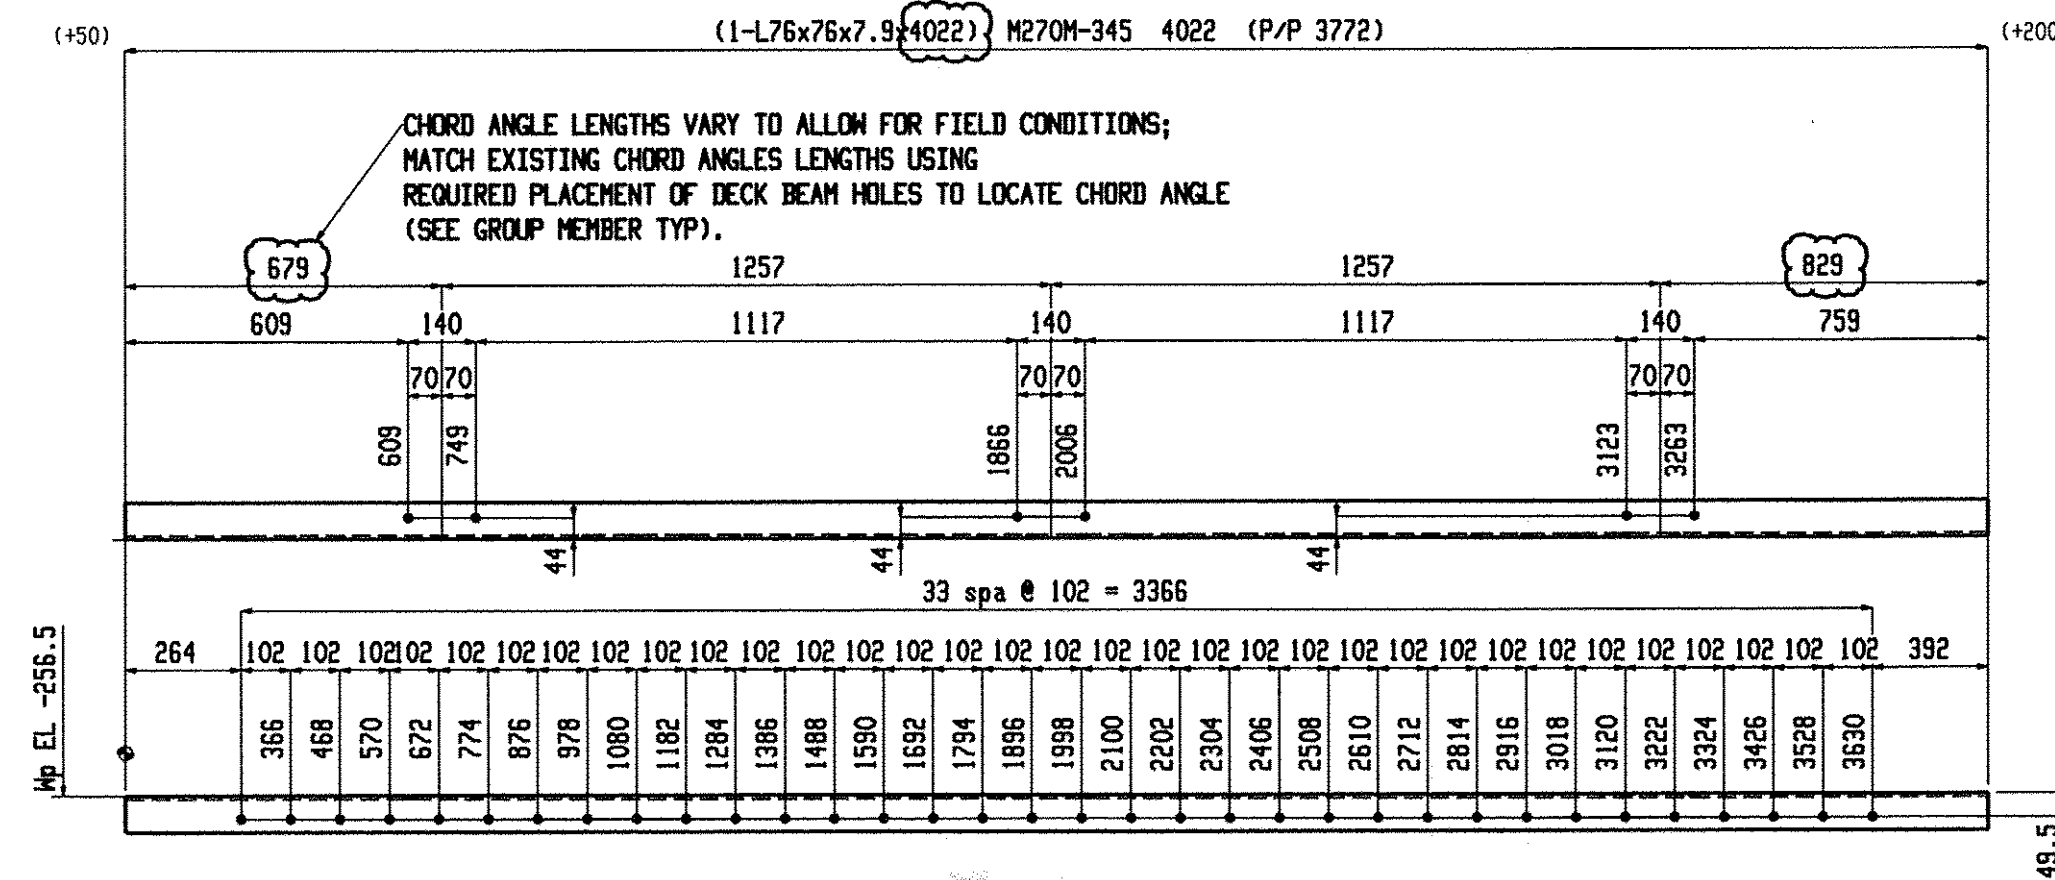

2 ANGLES A3
SHOP NOTE:
TOE DIRECTION FAR SIDE

