

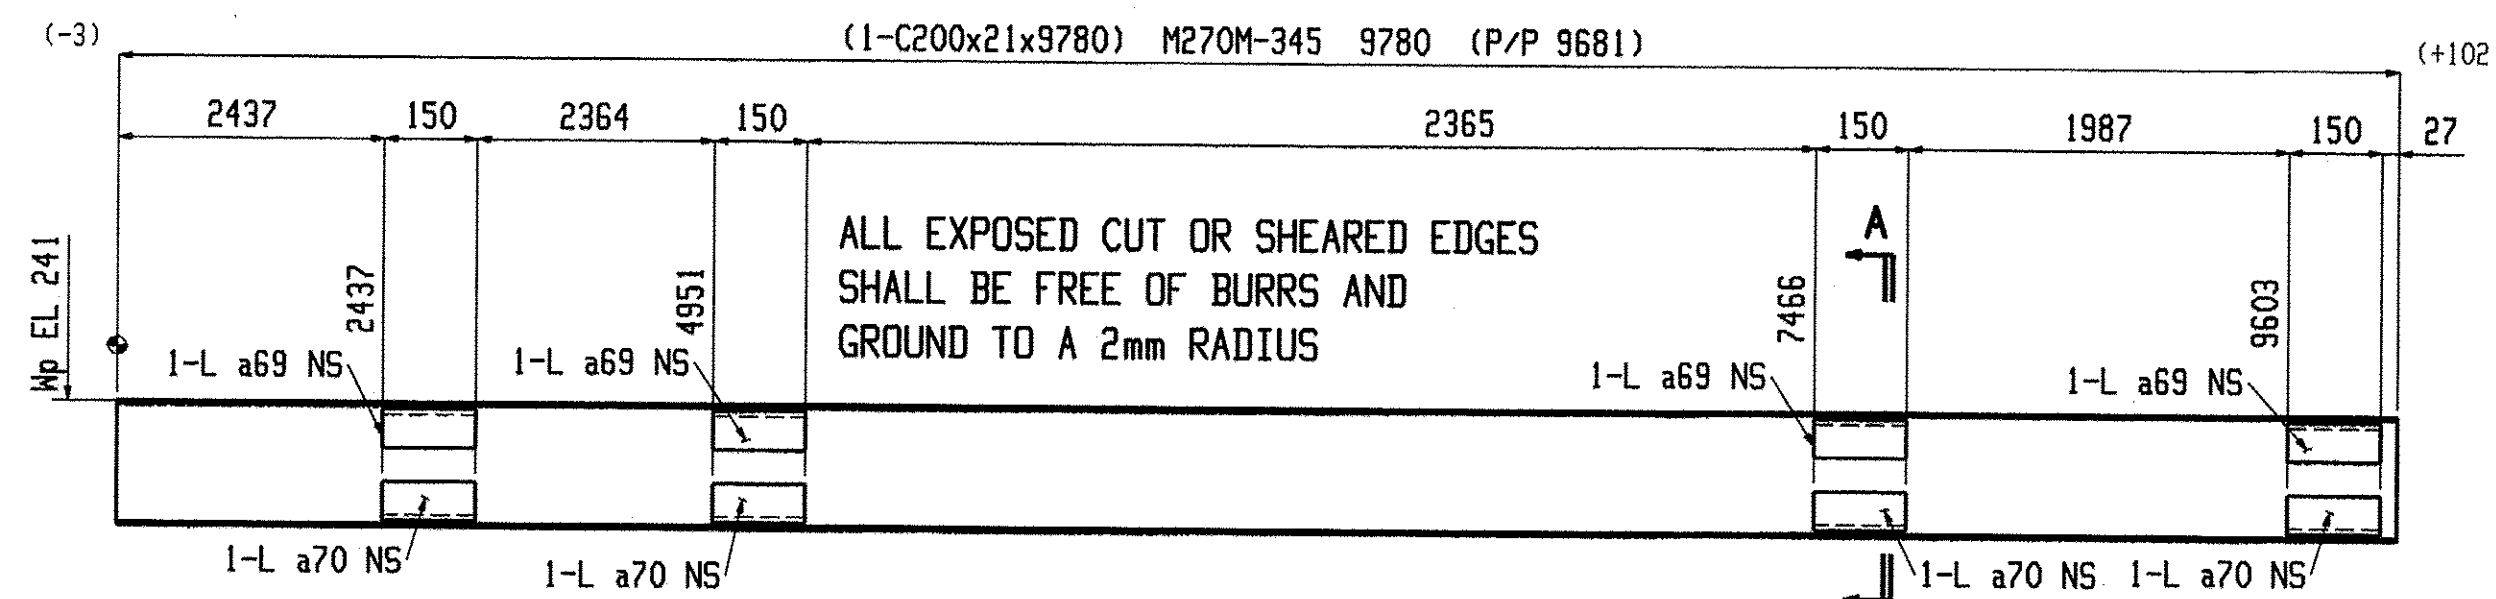


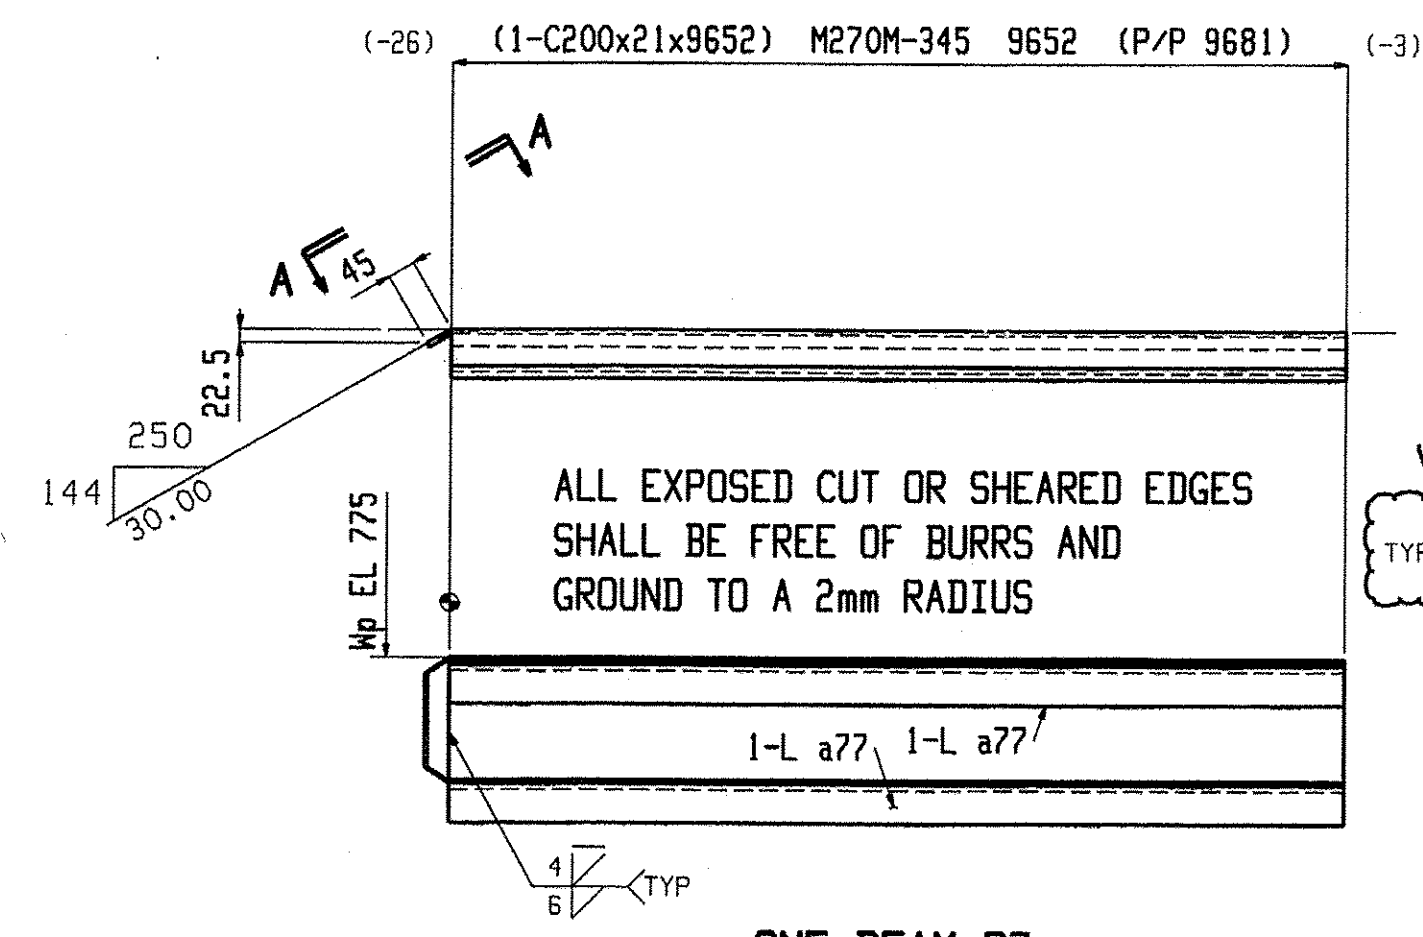

ONE BEAM R6

W 203x7.5
F 59.5x10
K 24x18

SHOP NOTE:
TOE DIRECTION NEAR SIDE

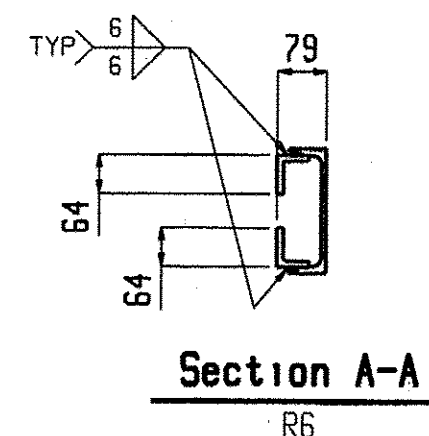



ONE BEAM R7

W 203x7.5
F 59.5x10
K 24x18

SHOP NOTE:
TOE DIRECTION NEAR SIDE

VERIFY!

TYP 6 758300 758300

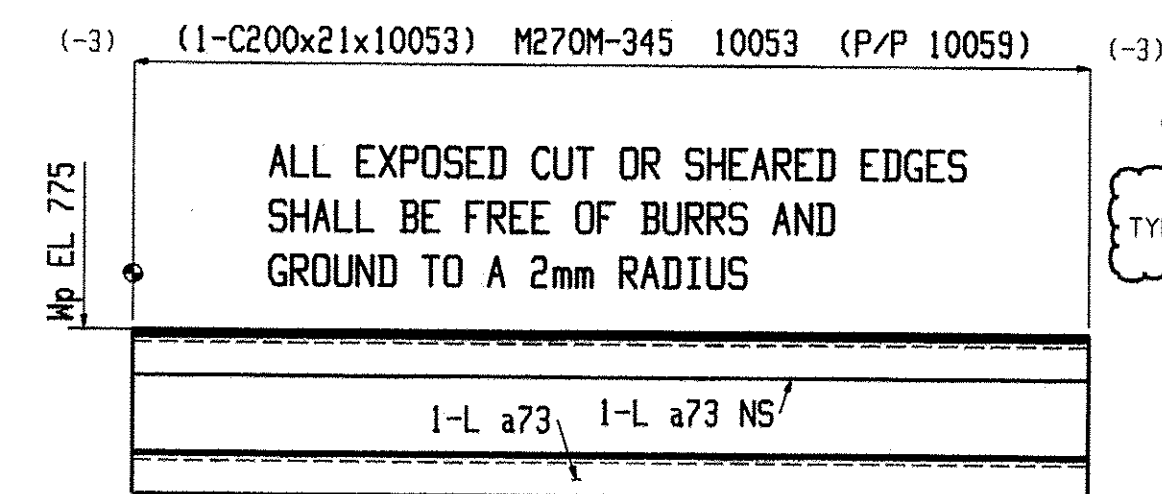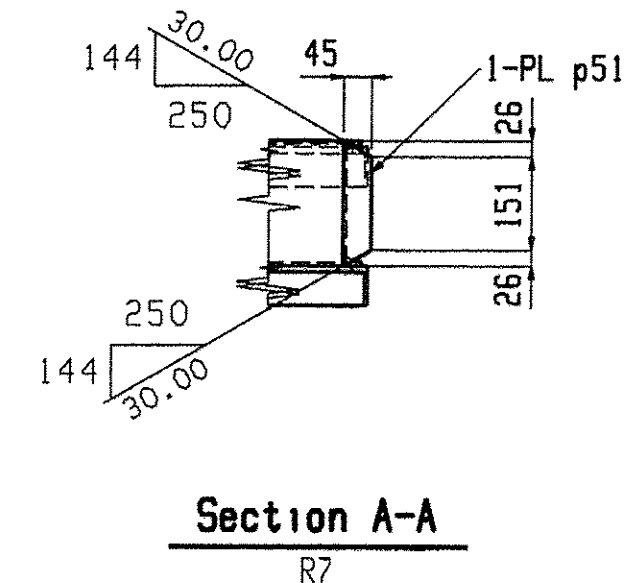



2 BEAMS R8

W 203x7.5
F 59.5x10
K 24x18

SHOP NOTE:
TOE DIRECTION NEAR SIDE

VERIFY!

TYP 6 758300 758300

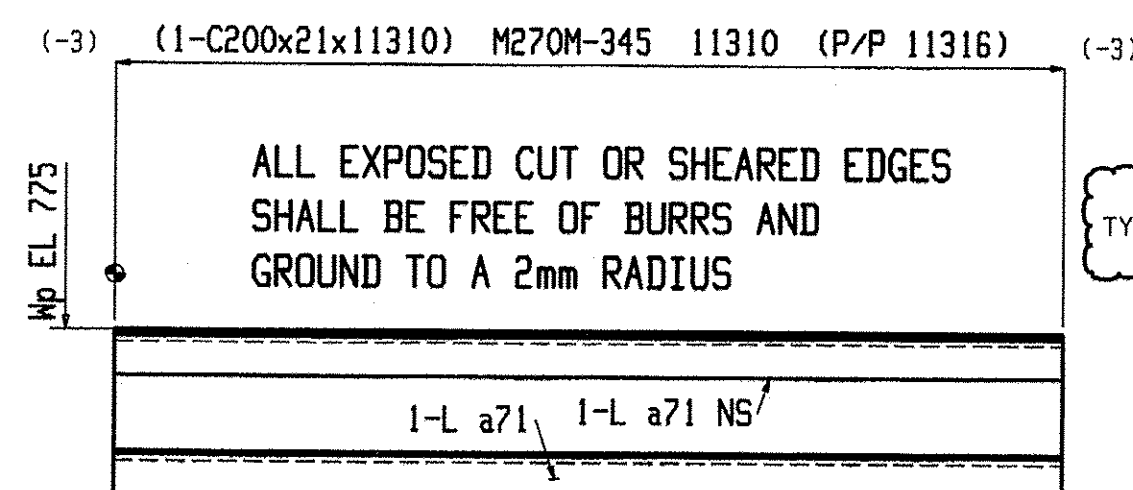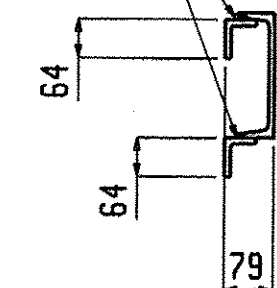



ONE BEAM R9

W 203x7.5
F 59.5x10
K 24x18

SHOP NOTE:
TOE DIRECTION NEAR SIDE

VERIFY!

TYP 6 758300 758300

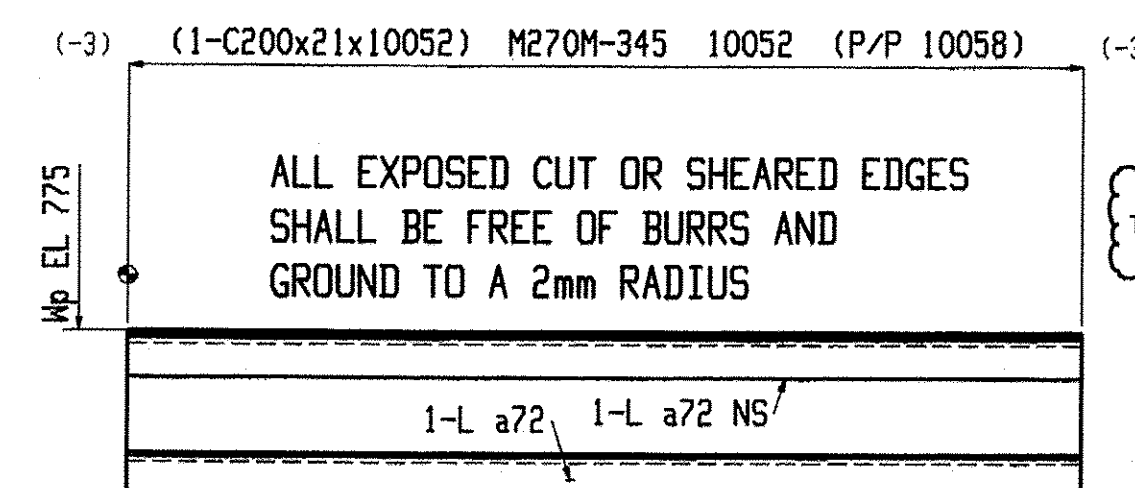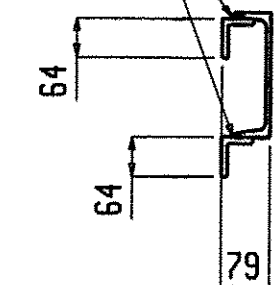



ONE BEAM R10

W 203x7.5
F 59.5x10
K 24x18

SHOP NOTE:
TOE DIRECTION NEAR SIDE

VERIFY!


TYP 6 758300 758300

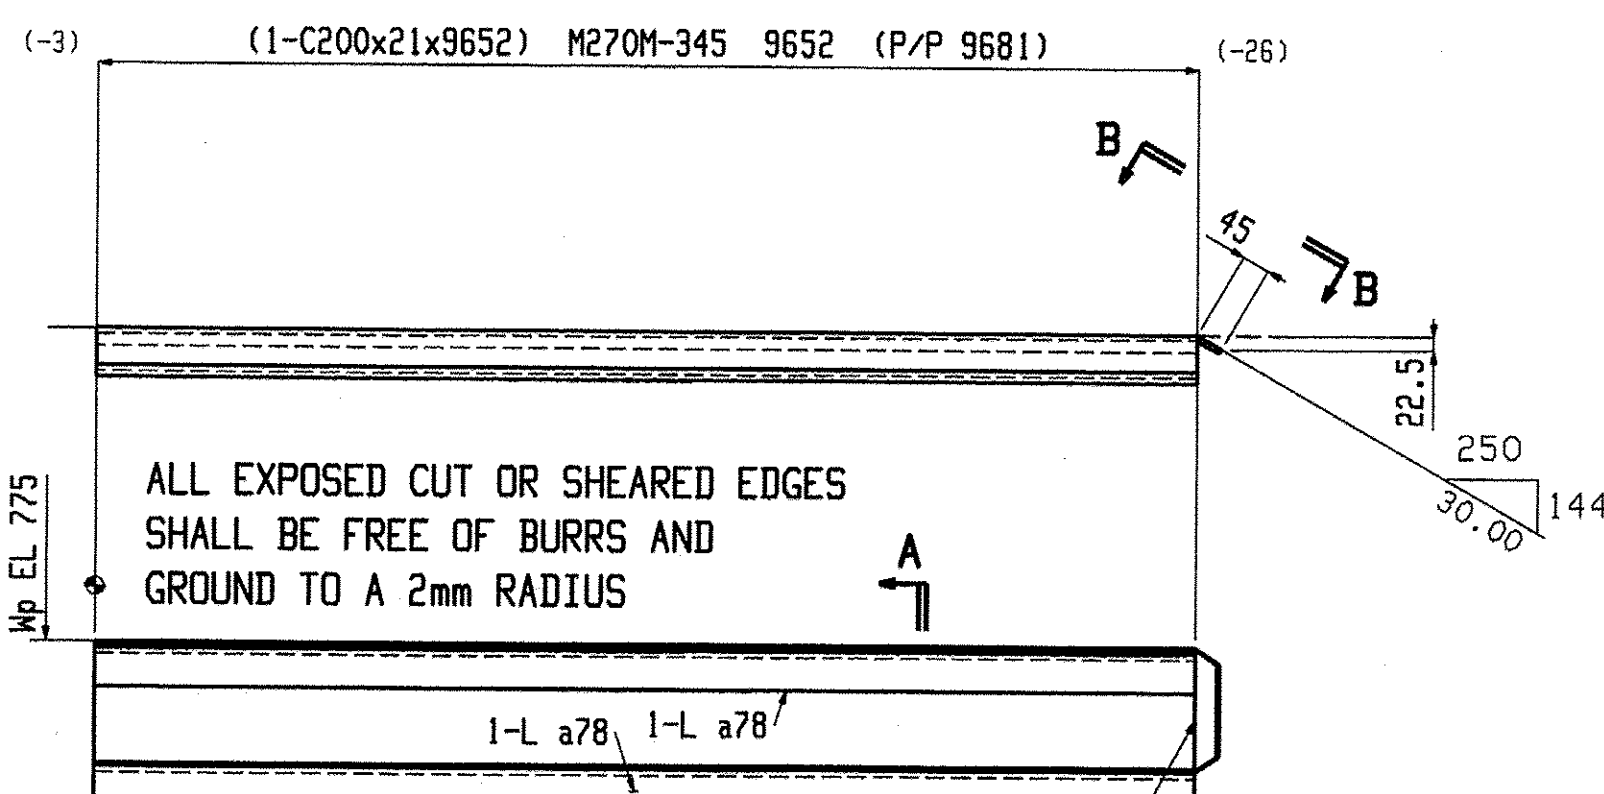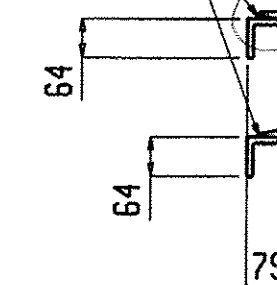

ONE BEAM R11


W 203x7.5
F 59.5x10
K 24x18

SHOP NOTE:
TOE DIRECTION NEAR SIDE

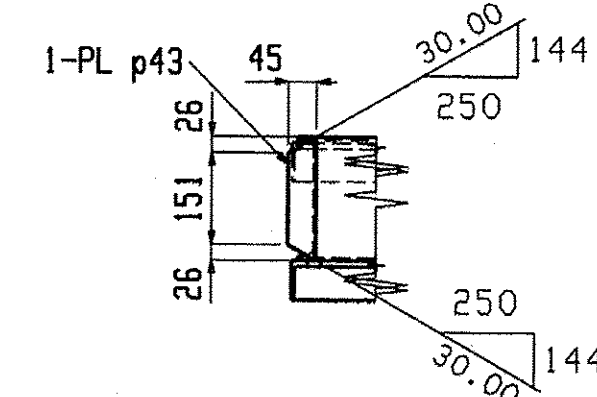

VERIFY!

TYP 6 758300 758300

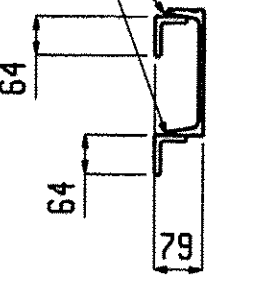

BILL OF MATERIAL

Qty	Piece		Seq	Seq	Adv	Steel	
Tot.	Mark	Description	Length	NO.	Qty	ABM #	Grade
ONE R6	BEAM		2	1			
1 R6	C200x21						M270M-345
4 a69	L64x51x9.5						M270M-345
4 a70	L64x51x9.5						M270M-345
ONE R7	BEAM		2	1			
1 R7	C200x21						M270M-345
2 a77	L64x51x9.5						M270M-345
1 p51	PL8x45						M270M-345

BILL OF MATERIAL

Qty	Piece		Seq	Seq	Adv	Steel	
Tot.	Mark	Description	Length	NO.	Qty	ABM #	Grade
2 R8	BEAM		2	2			
2 R8	C200x21						M270M-345
4 a73	L64x51x9.5						M270M-345
ONE R9	BEAM		2	1			
1 R9	C200x21						M270M-345
2 a71	L64x51x9.5						M270M-345

BILL OF MATERIAL

Qty	Piece		Seq	Seq	Adv	Steel	
Tot.	Mark	Description	Length	NO.	Qty	ABM #	Grade
ONE R10	BEAM		2	1			
1 R10	C200x21						M270M-345
2 a72	L64x51x9.5						M270M-345
ONE R11	BEAM		2	1			
1 R11	C200x21						M270M-345
2 a78	L64x51x9.5						M270M-345
1 p43	PL8x45						M270M-345

Total weight : 2407

Fabrication is not to be done by Renaud Bros. Have fabricator resubmit with name of fabricator on drawings

Renaud Bros. Inc.
283 Fort Bridgeman Rd. #2
Vernon, VT, 05354
Phone 1-802 257-7383

Project: **DUMMERSTON BRIDGE**
DUMMERSTON, VT

Rev. No:	Date:	Surface Prep:	PER SPECS
Date:	9-9-09	Job No.:	BHO1442(28)
DWN. BY:	EG	Checked:	MRS
Sheet No.:			21

Holes: 21mm UNO
BOLTS: 19mm DIA. M164M-I GALV UNO
Steel GR: M270M-GR345 UNO
Paint: PER SPECS (GREEN) UNO