



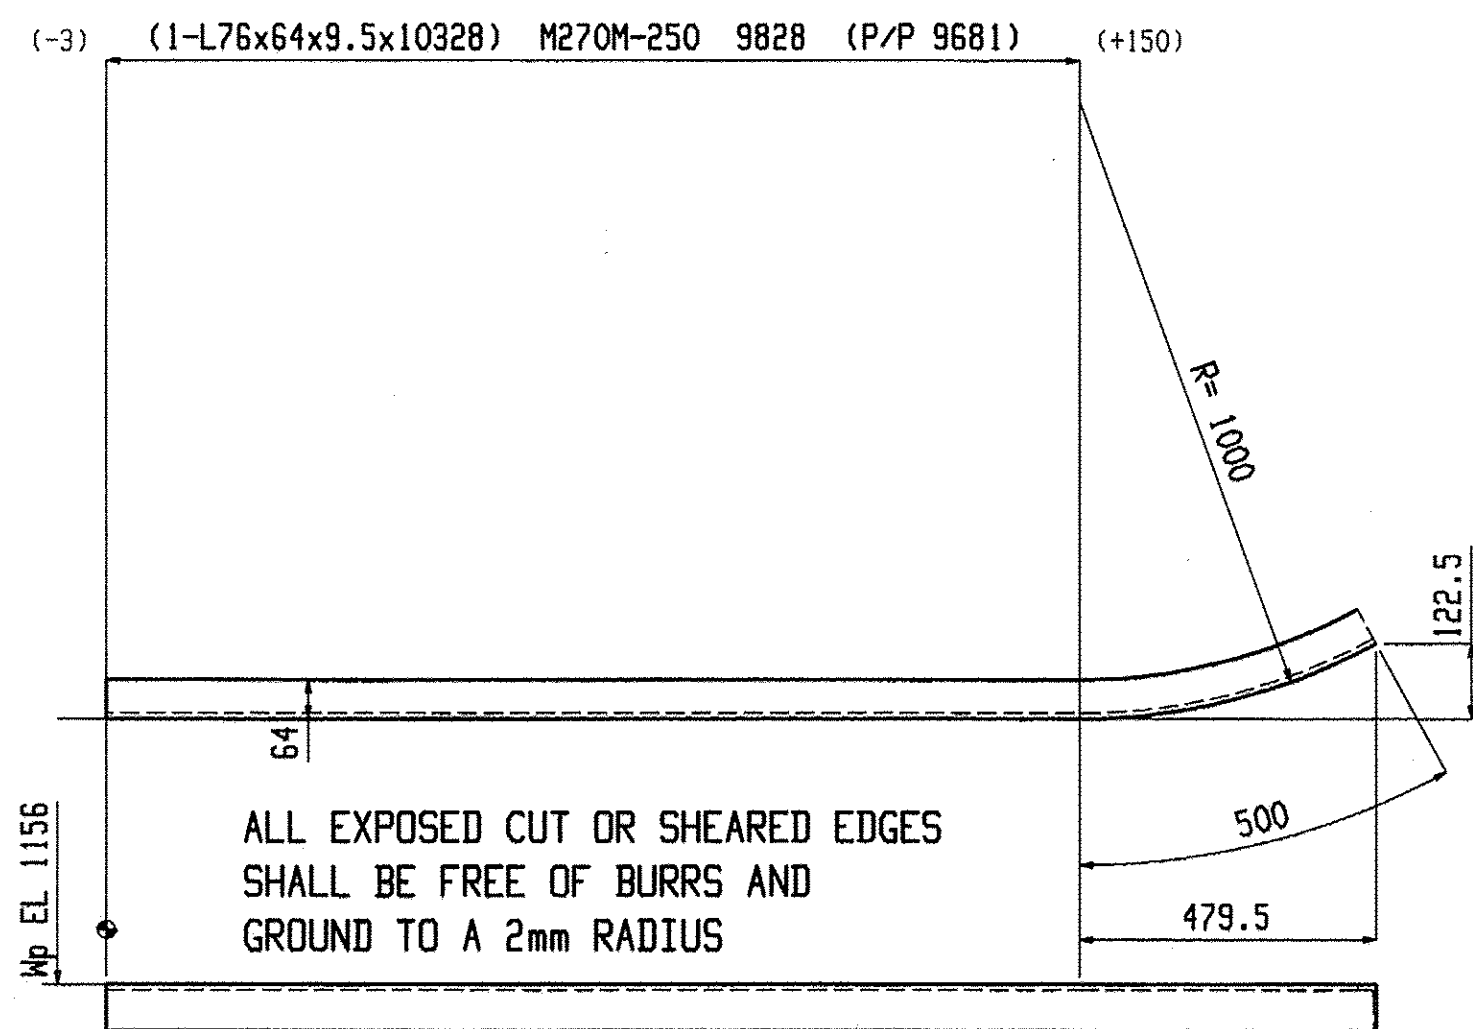


ONE BEAM R32

SHOP NOTE:
TOE DIRECTION FAR SIDE

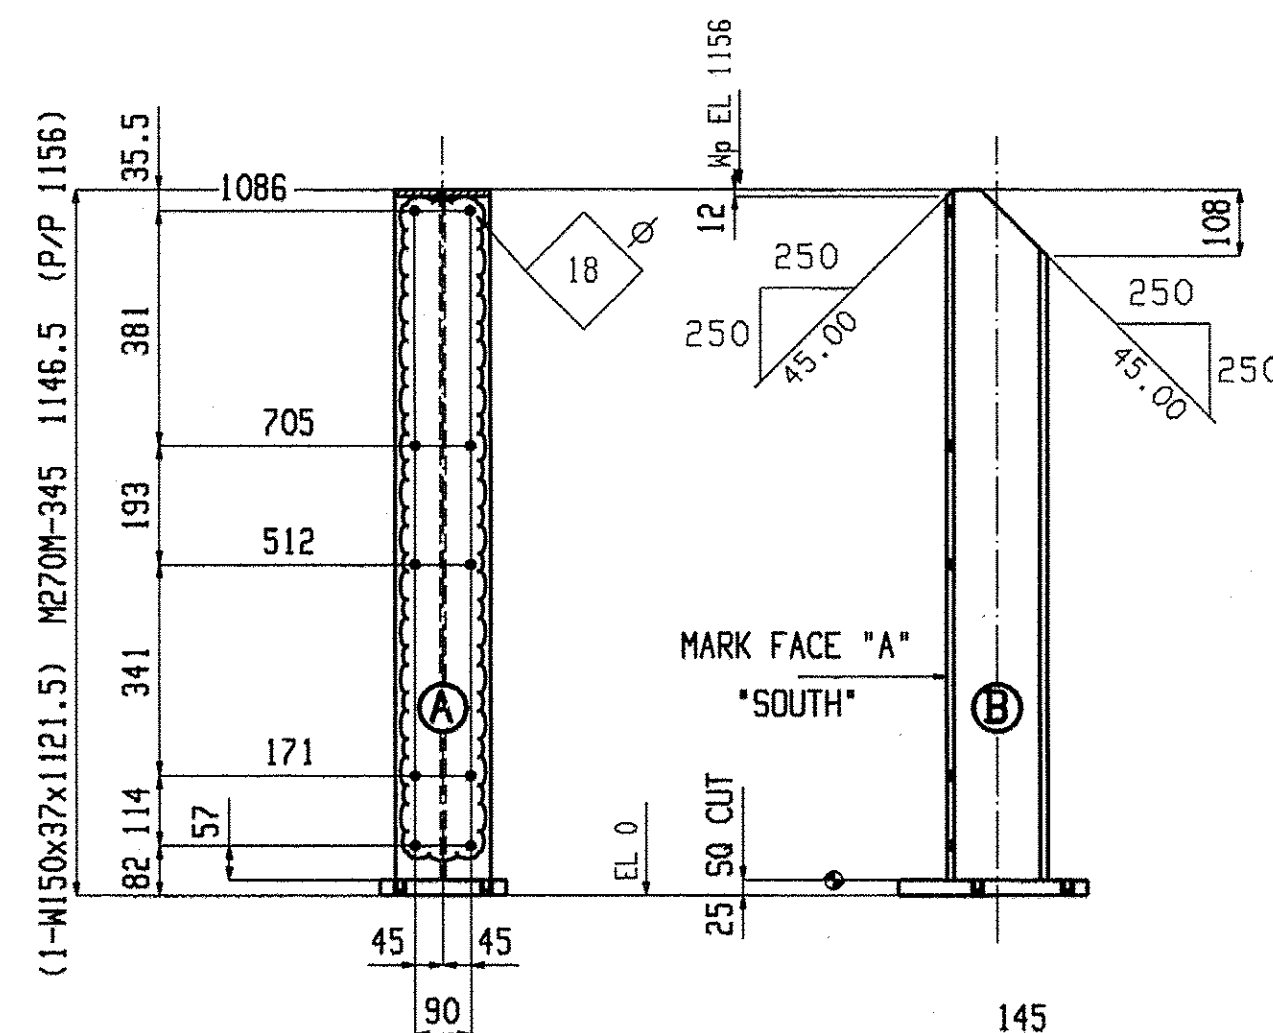


ALL EXPOSED CUT OR SHEARED EDGES
SHALL BE FREE OF BURRS AND
GROUND TO A 2mm RADIUS

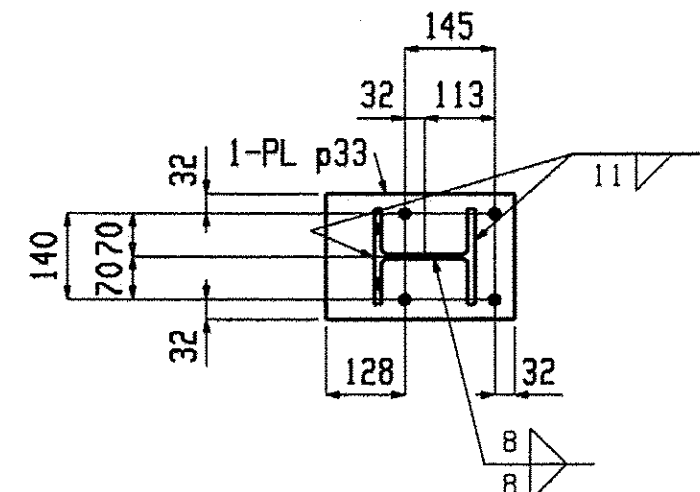

24 COLUMNS C1


W 162x8
F 154.5x11.5
K 20.5x13

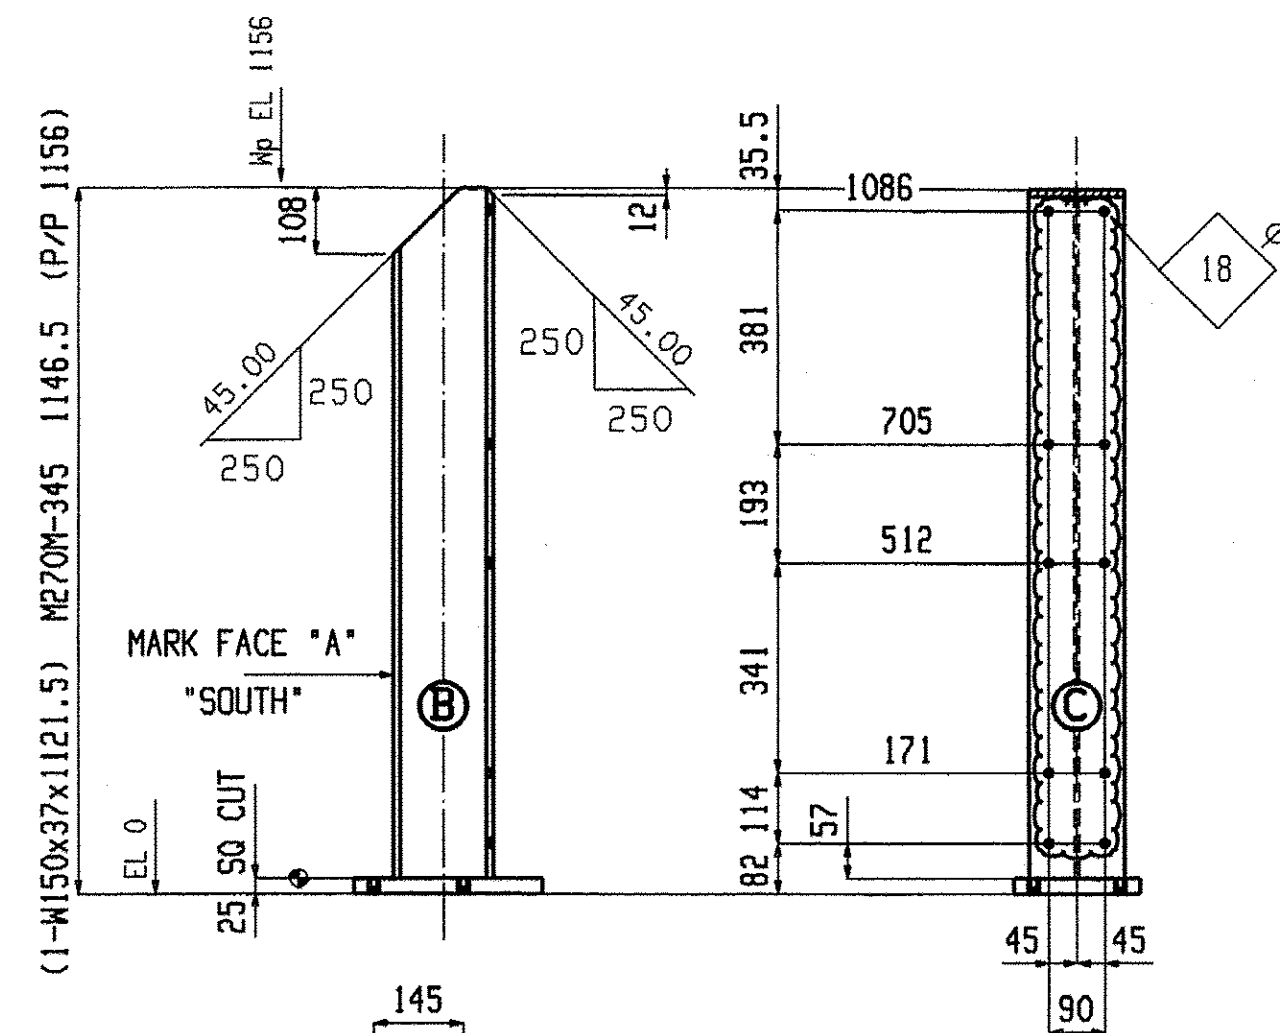

24 COLUMNS C2

W 162x8
F 154.5x11.5
K 20.5x13


ALL EXPOSED CUT OR SHEARED EDGES
SHALL BE FREE OF BURRS AND
GROUND TO A 2mm RADIUS

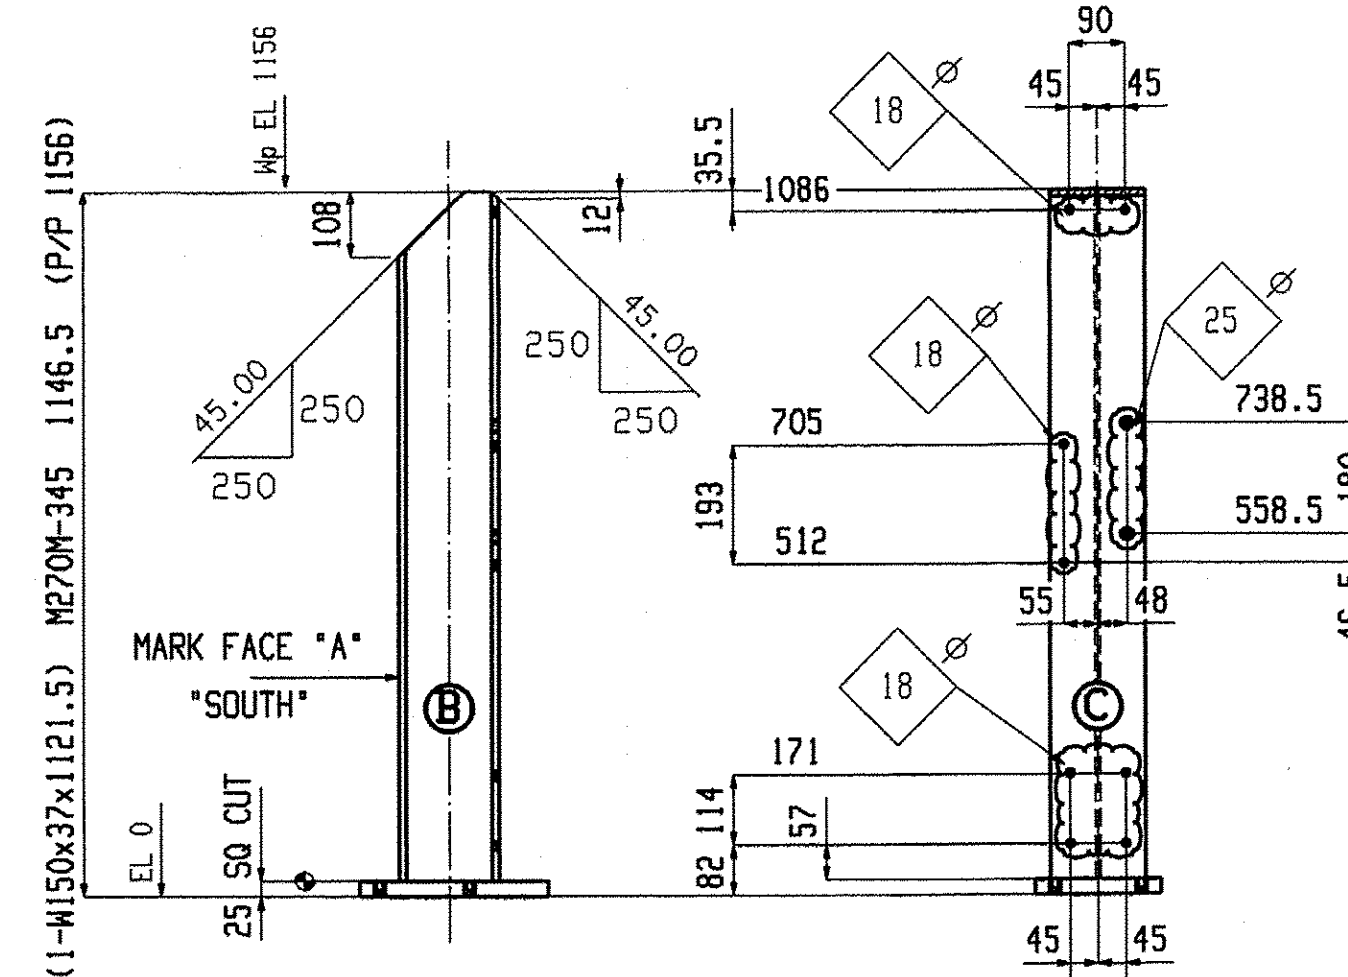


ONE COLUMN C3

W 162x8
F 154.5x11.5
K 20.5x13

ALL EXPOSED CUT OR SHEARED EDGES
SHALL BE FREE OF BURRS AND
GROUND TO A 2mm RADIUS

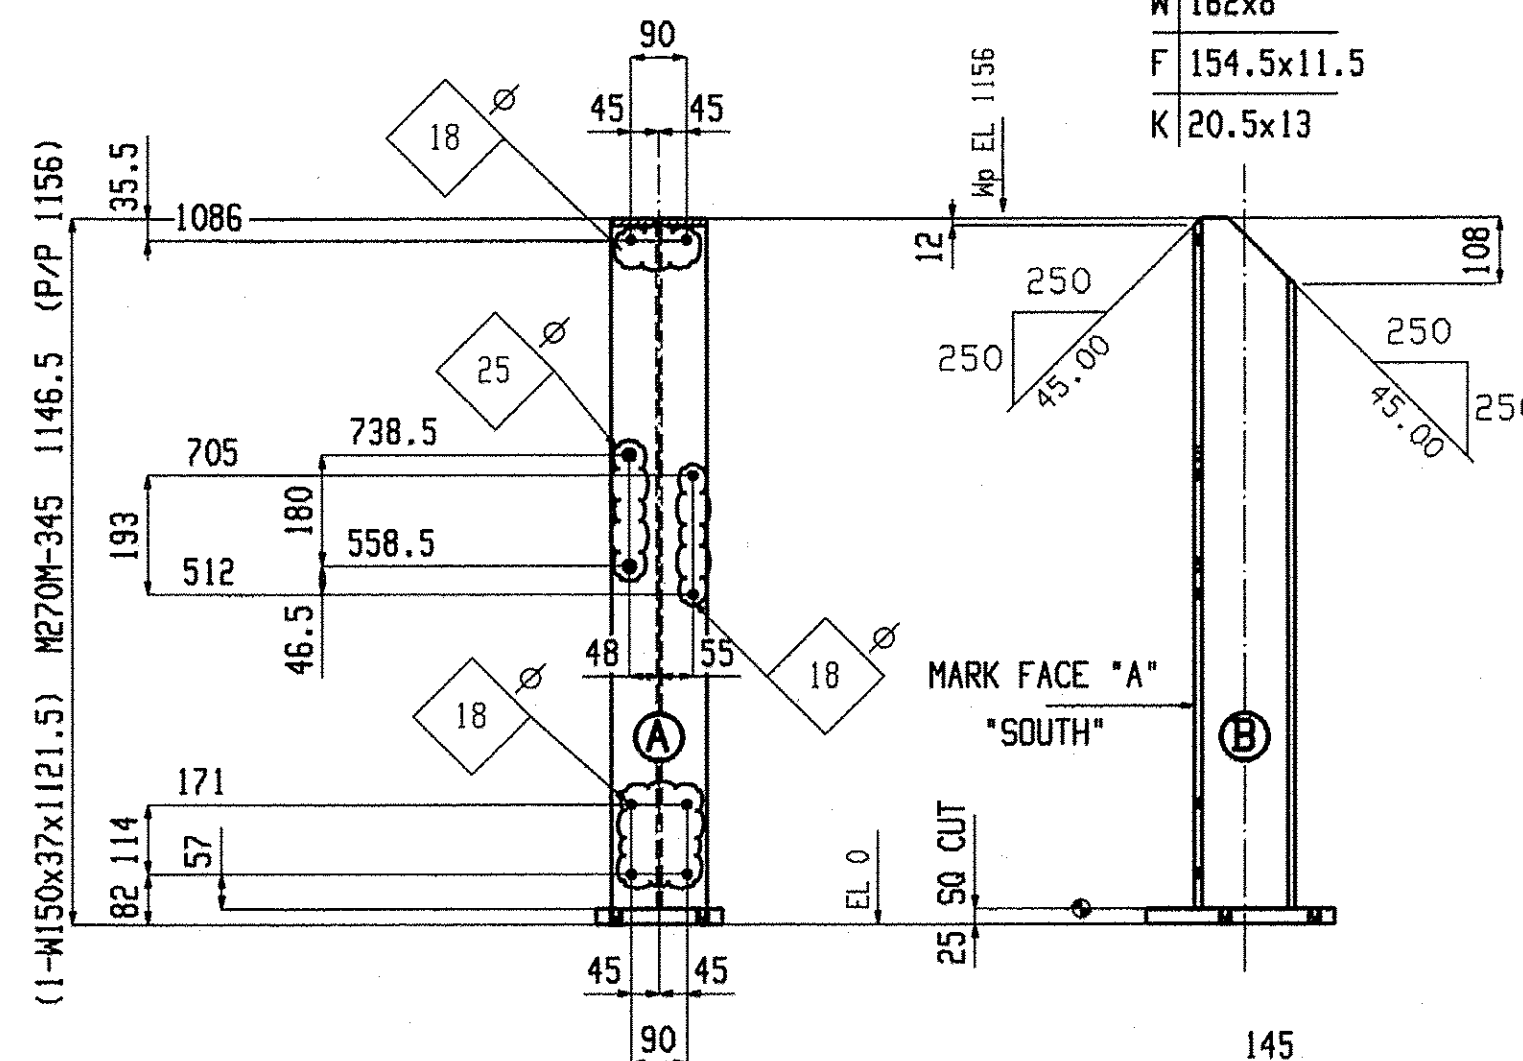


ALL EXPOSED CUT OR SHEARED EDGES
SHALL BE FREE OF BURRS AND
GROUND TO A 2mm RADIUS

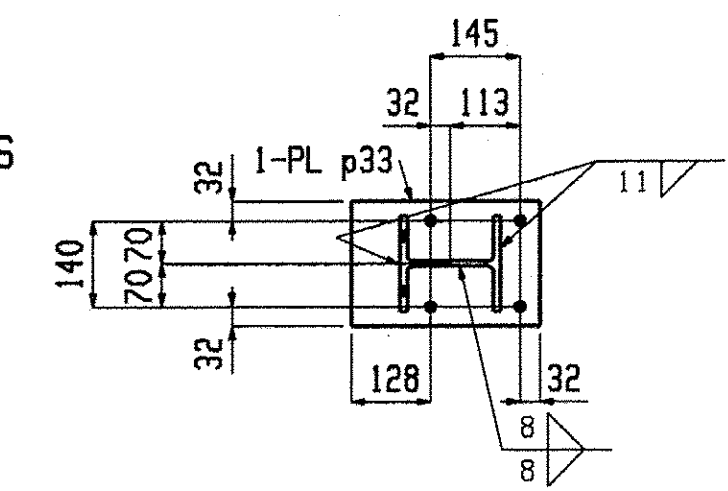

ONE COLUMN C4


W 162x8
F 154.5x11.5
K 20.5x13

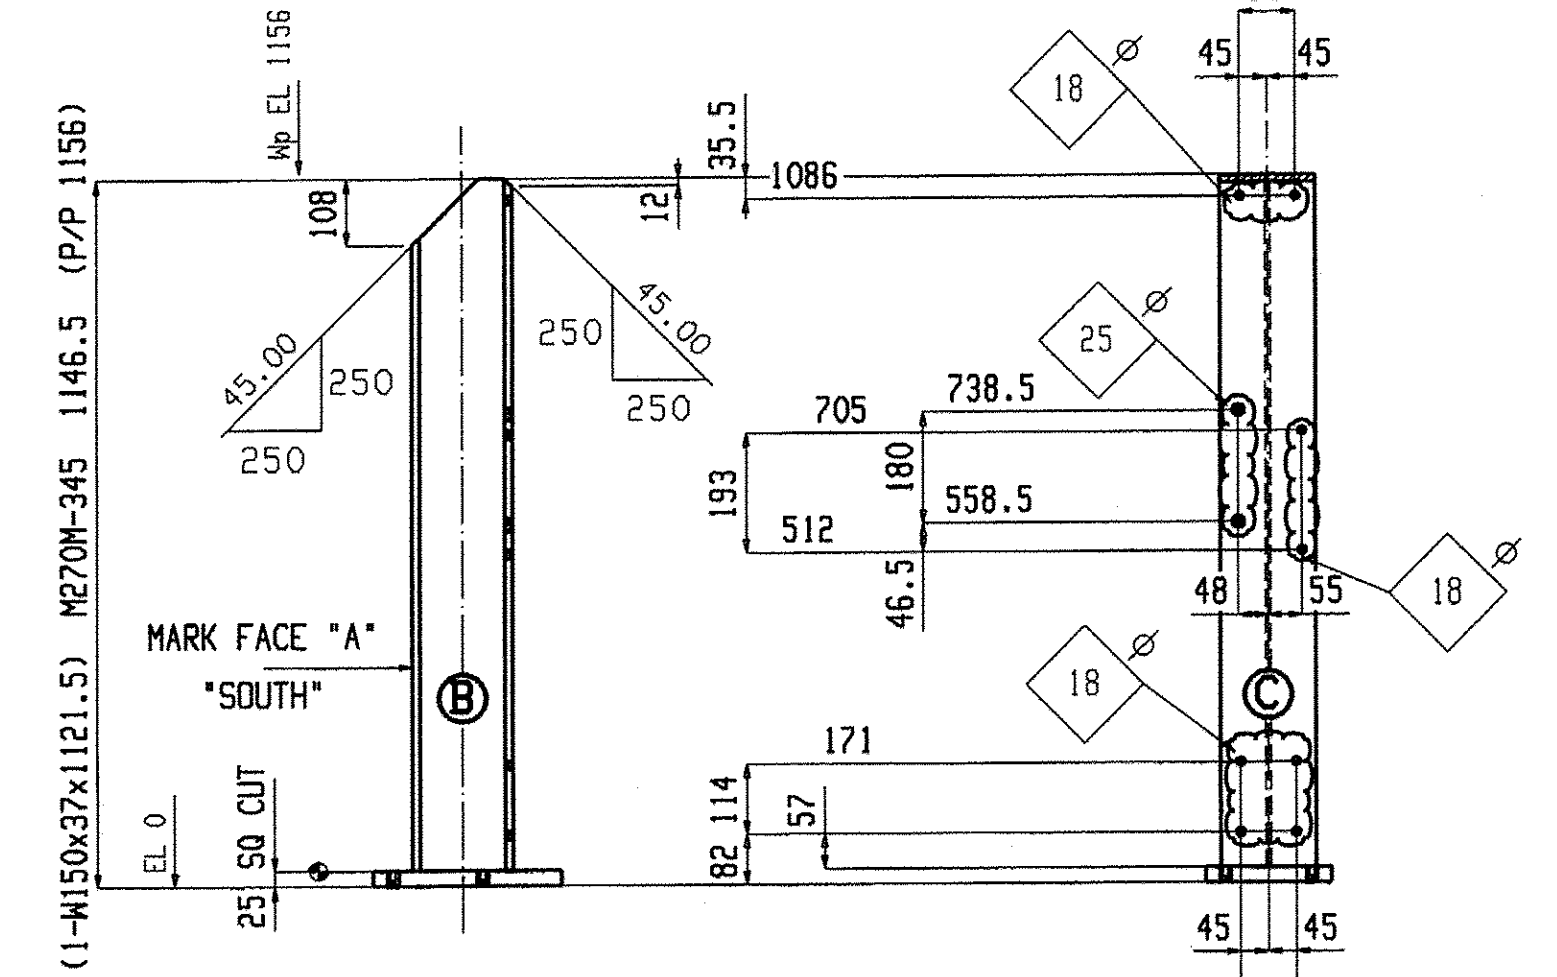


ONE COLUMN C5

W 162x8
F 154.5x11.5
K 20.5x13

ALL EXPOSED CUT OR SHEARED EDGES
SHALL BE FREE OF BURRS AND
GROUND TO A 2mm RADIUS

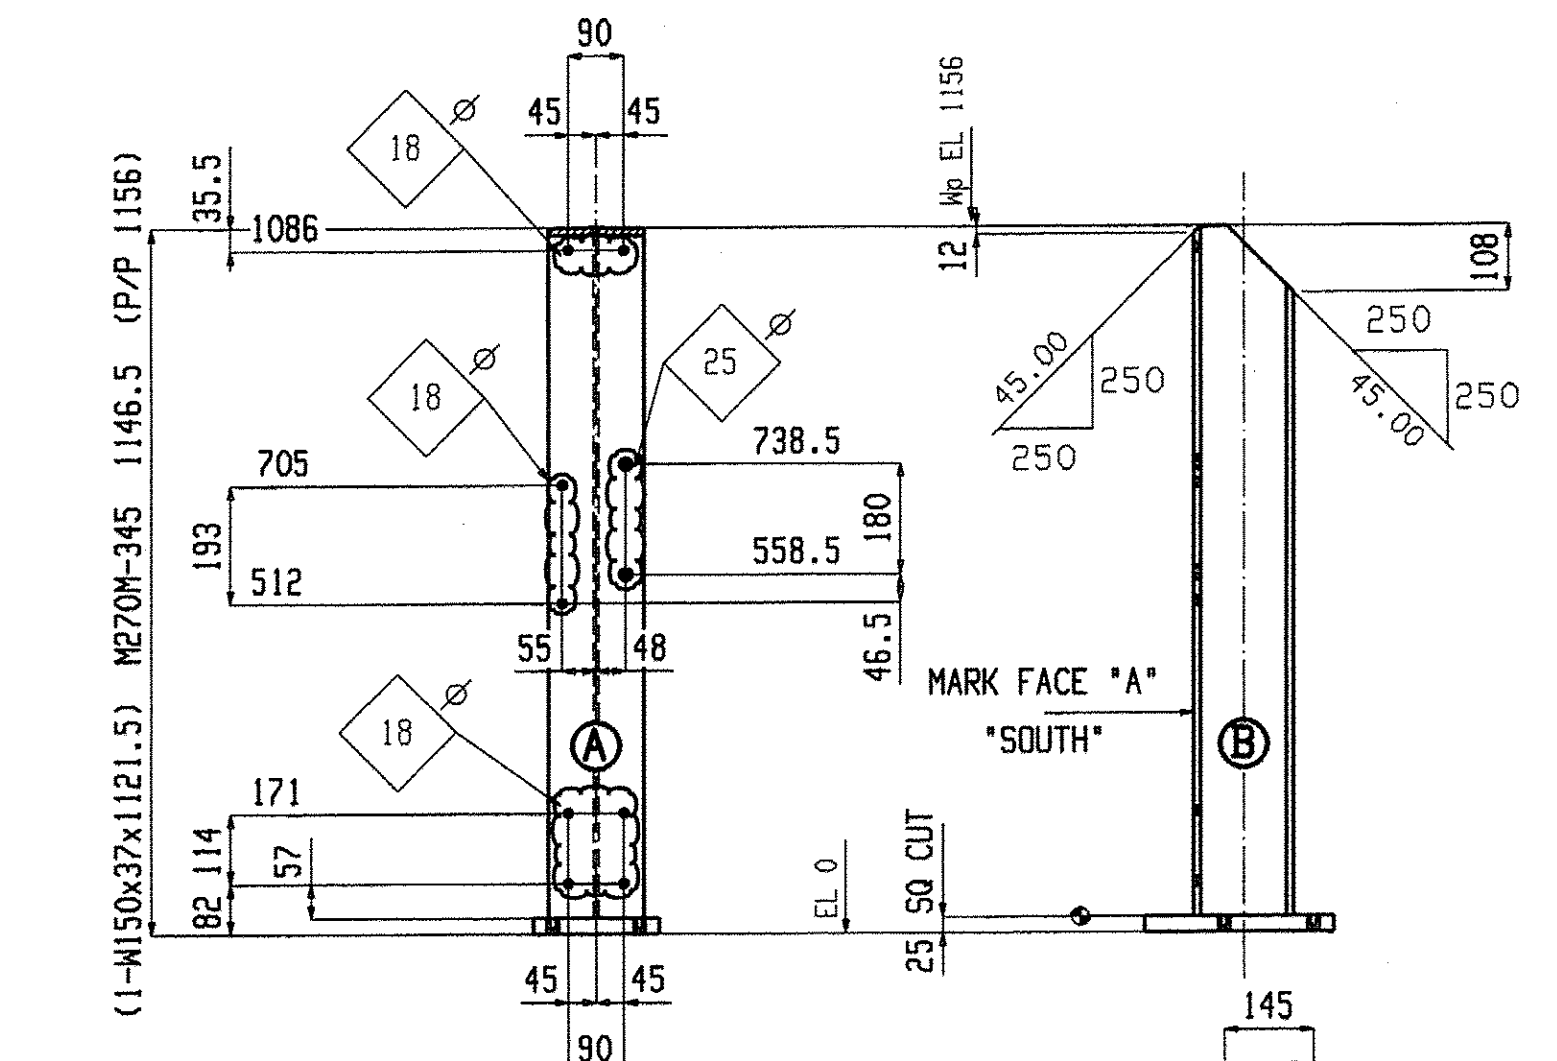

ALL EXPOSED CUT OR SHEARED EDGES
SHALL BE FREE OF BURRS AND
GROUND TO A 2mm RADIUS

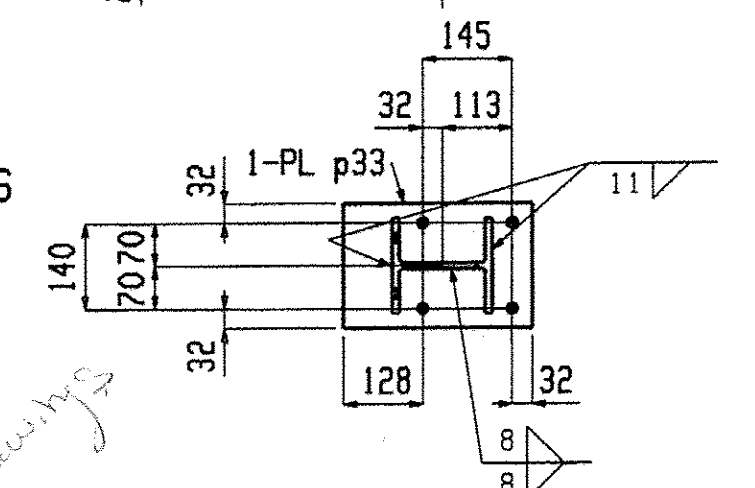

ONE COLUMN C6

W 162x8
F 154.5x11.5
K 20.5x13

BILL OF MATERIAL								BILL OF MATERIAL								BILL OF MATERIAL							
Qty	Piece	Description	Length	Seq	Seq	Adv	Steel	Qty	Piece	Description	Length	Seq	Seq	Adv	Steel	Qty	Piece	Description	Length	Seq	Seq	Adv	Steel
Tot.	Mark			NO.	Qty	ABM #	Grade	Tot.	Mark			NO.	Qty	ABM #	Grade	Tot.	Mark			NO.	Qty	ABM #	Grade
ONE	R32	BEAM		2		1		ONE	C3	COLUMN		2		1		ONE	C5	COLUMN		2		1	
1	R32	L76x64x9.5	10328				M270M-250	1	C3	W150x37	1121.5				M270M-345	1	C5	W150x37	1121.5				M270M-345
24	C1	COLUMN		2		24		1	C3	W150x37	1121.5				M270M-345	1	C5	W150x37	1121.5				M270M-345
24	C1	W150x37	1121.5				M270M-345	1	C3	PL25x204	305				M270M-345	1	C5	PL25x204	305				M270M-345
24	C1	PL25x204	305				M270M-345	24	C4	COLUMN		2		24		ONE	C6	COLUMN		2		1	
ONE	C2	COLUMN		2		1		24	C4	W150x37	1121.5				M270M-345	1	C6	W150x37	1121.5				M270M-345
1	C2	W150x37	1121.5				M270M-345	24	C4	PL25x204	305				M270M-345	1	C6	PL25x204	305				M270M-345

Total weight : 2905

Renaud Bros. Inc.
283 Fort Bridgeman Rd. #2
Vernon, VT. 05354
Phone 1-802 257-7383

Project: **DUMMERSTON BRIDGE**
DUMMERSTON, VT

Rev. No:

Date:

9-9-09

Checked:

MRS

Job No.

Sheet No.

25

Holes: 21mm UNO
BOLTS: 19mm DIA. M164M-I GALV UNO
Steel GR: M270M-GR345 UNO
Paint: PER SPECS (GREEN) UNO
Surface Prep: PER SPECS

Fabrication is not to be done by Renaud Bros. Have fabricator resubmit with name of fabricator on drawing.