
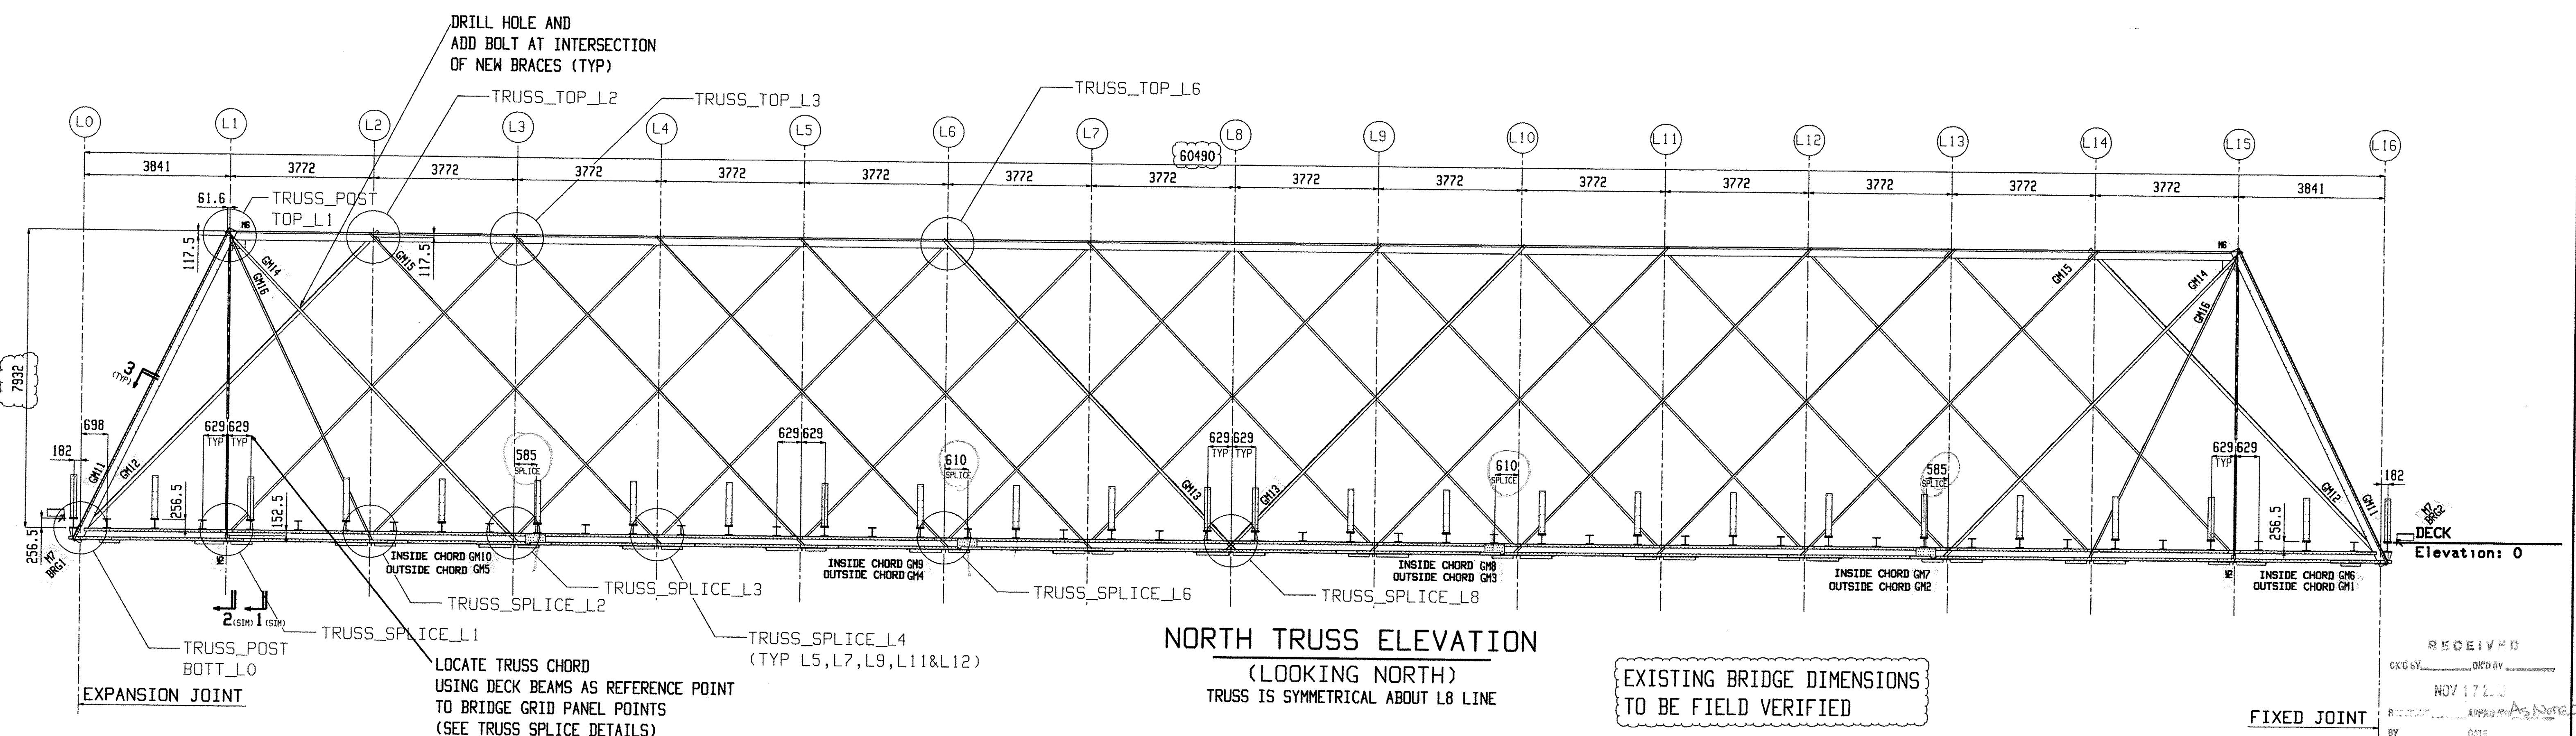


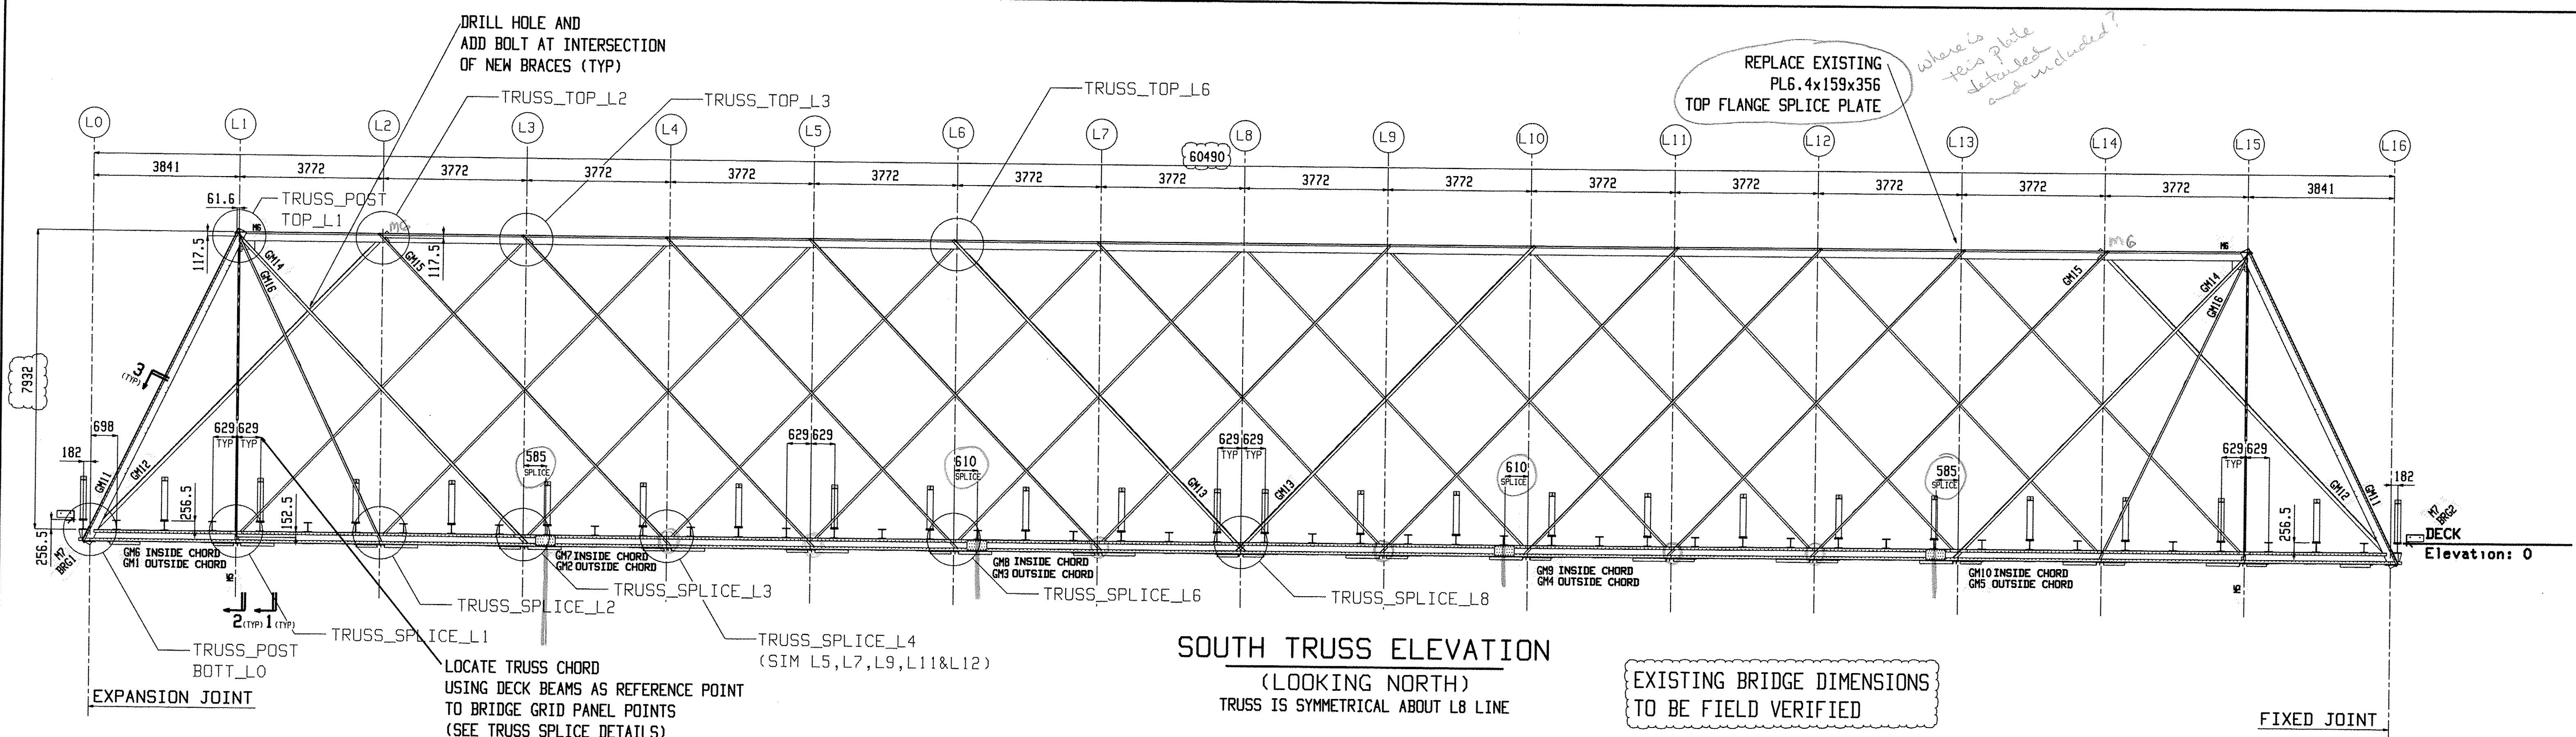

Renaud Bros. Inc. 283 Fort Bridgeman Rd. #2 Vernon, VT. 05354 Phone 1-802 257-7383		Holes:	21mm UNO
		BOLTS:	19mm DIA. M164M-I GALV UNO
		Steel GR:	M270M-GR345 UNO
		Paint:	PER SPECS (GREEN) UNO
Rev.No:	Date:	Surface Prep:	PER SPECS
Project:		Date:	Job No.
DUMMERSTON BRIDGE		9-9-09	BHO 1442 (28)
DWN. BY:	Checked:	Sheet No.	
EG	MRS	E2	

Nov 06 2008 10:55:09 AM