


4 GROUP MEMBERS GM15

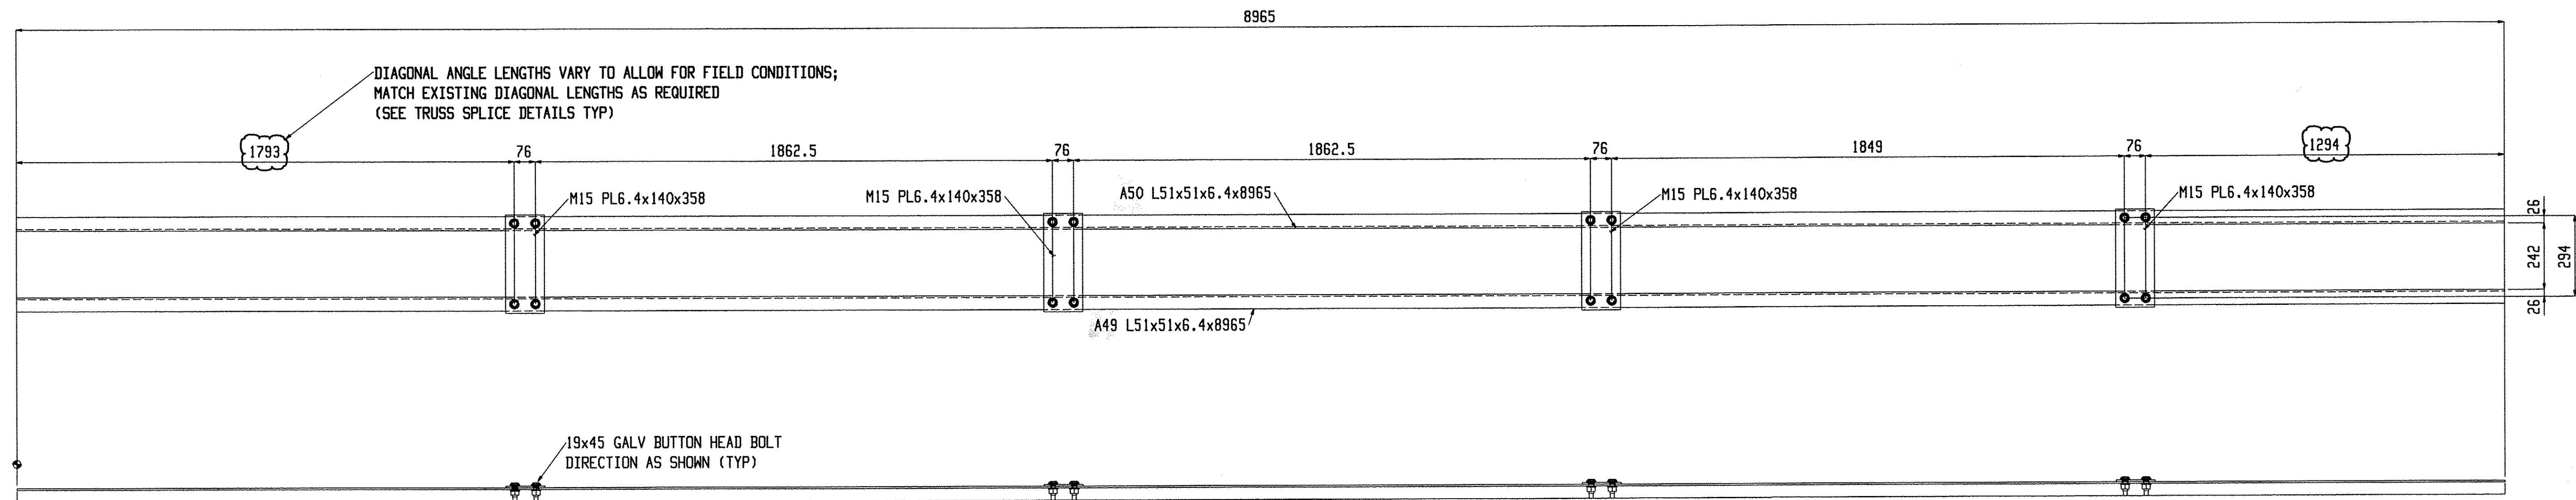

4 GROUP MEMBERS GM16

BILL OF MATERIAL										BILL OF MATERIAL										BILL OF MATERIAL									
Qty	Piece			Seq	Seq	Adv	Steel			Qty	Piece			Seq	Seq	Adv	Steel			Qty	Piece			Seq	Seq	Adv	Steel		
Tot.	Mark	Description	Length	NO.	Qty	ABM #	Grade	Remarks		Tot.	Mark	Description	Length	NO.	Qty	ABM #	Grade	Remarks		Tot.	Mark	Description	Length	NO.	Qty	ABM #	Grade	Remarks	
4	GM15	GROUP MEMBER								4	GM16	GROUP MEMBER																	
16	M15	PL6.4x140	358				M270M-345			16	M15	PL6.4x140	358				M270M-345												
4	A51	L51x51x6.4	11272				M270M-345			4	A49	L51x51x6.4	8965				M270M-345												
4	A52	L51x51x6.4	11272				M270M-345			4	A50	L51x51x6.4	8965				M270M-345												

Total weight : 848

RECEIVED
 CK'D BY _____ OK'D BY _____
 NOV 17 2009
 REQUESTED _____ APPROVED _____
 BY _____ DATE _____

Renaud Bros. Inc. 283 Fort Bridgeman Rd. #2 Vernon, VT. 05354 Phone 1-802 257-7383		Rev.No:	Date:	Holes:	21mm UNO
				BOLTS:	19mm DIA. M164M-I GALV UNO
				Steel GR:	M270M-GR345 UNO
				Paint:	PER SPECS (GREEN) UNO
Project:		DWN. BY:	Checked:	Sheet No.	Job No.
DUMMERSTON BRIDGE		EG	MRS	GM15, GM16	BHO 442(28)
DUMMERSTON, VT					

Nov 06 2009 10:54:25 AM

Product

Sheet