




24 MISCS M6

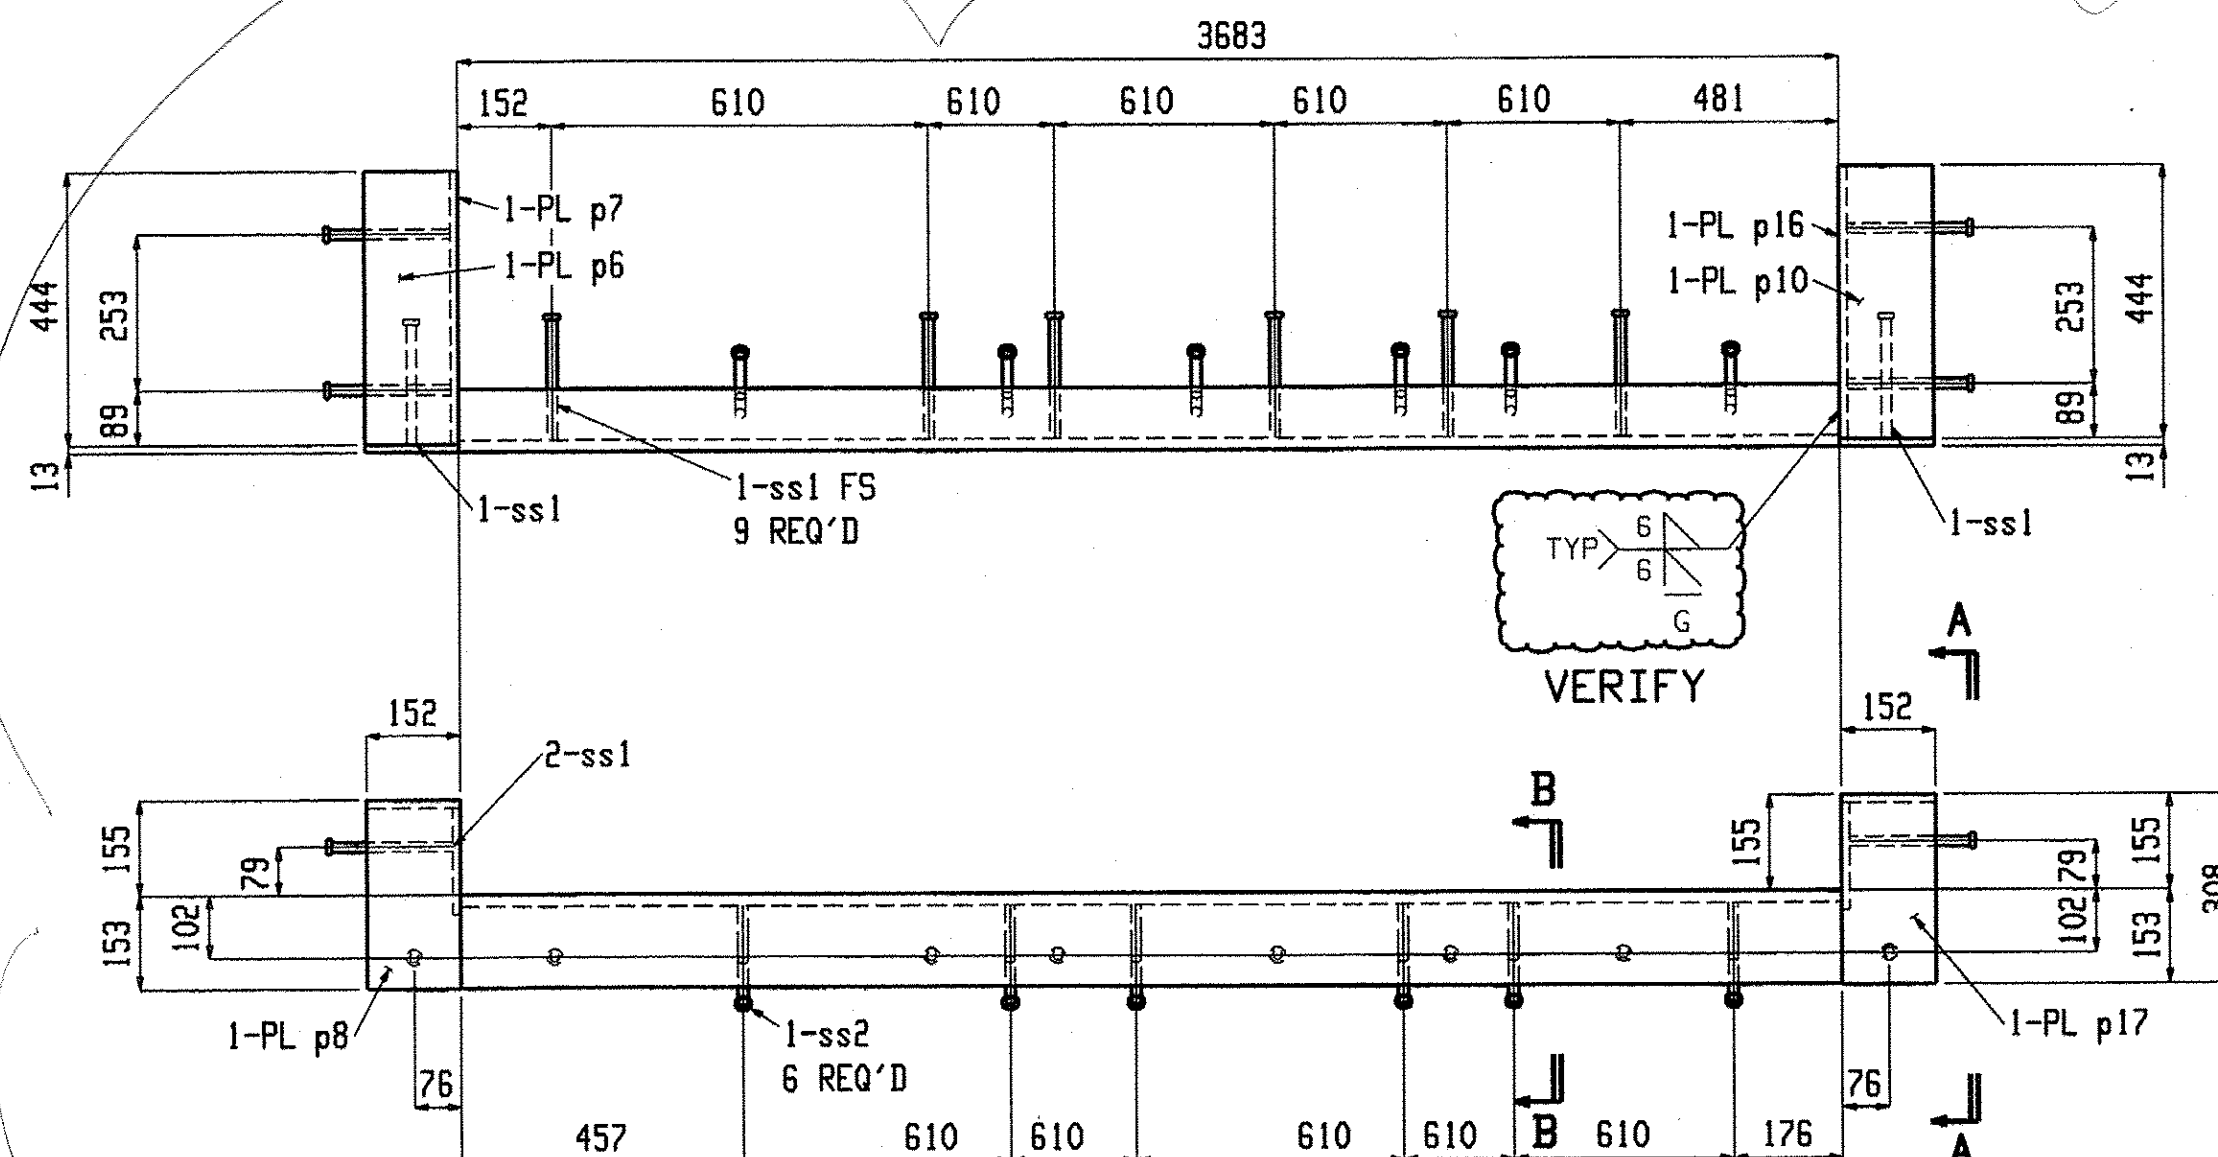


2 MISCS M7

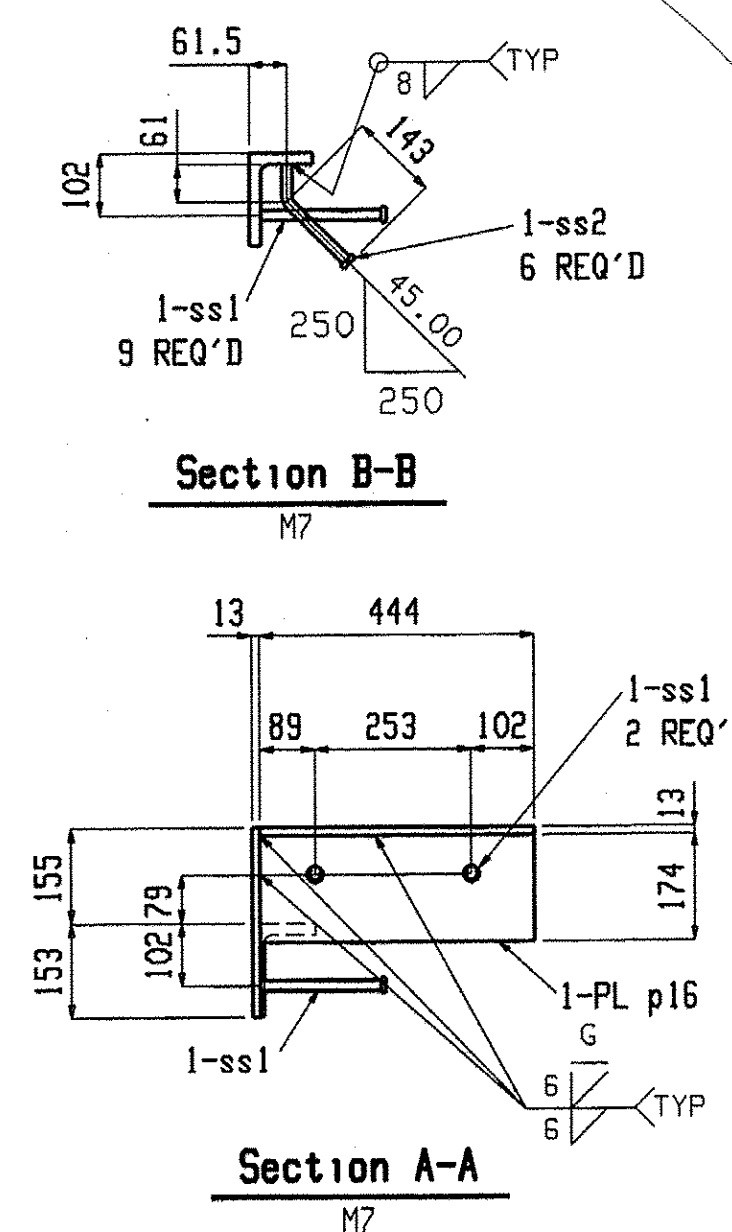

These pieces are part of expansion joint item and drawings.

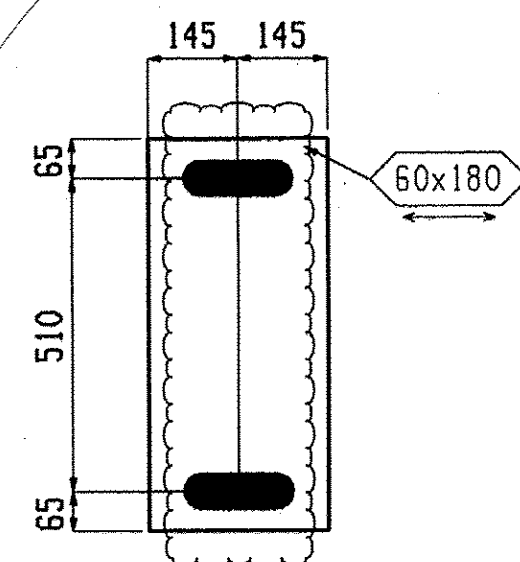

2 MISCS BRG1

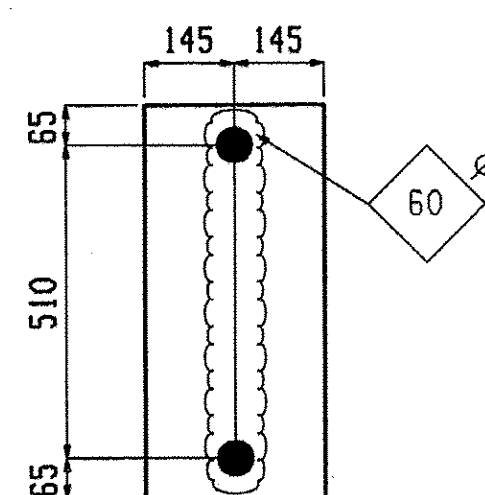

2 MISCS BRG2

These pieces are part of the bearing device item and drawings.

Need to separate out beams as they are paid by weight. Other pieces are lump sum payment

Total weight : 482

BILL OF MATERIAL									BILL OF MATERIAL									BILL OF MATERIAL								
Qty	Piece			Seq	Seq	Adv	Steel		Qty	Piece			Seq	Seq	Adv	Steel		Qty	Piece			Seq	Seq	Adv	Steel	
Tot.	Mark	Description	Length	NO.	Qty	ABM #	Grade	Remarks	Tot.	Mark	Description	Length	NO.	Qty	ABM #	Grade	Remarks	Tot.	Mark	Description	Length	NO.	Qty	ABM #	Grade	Remarks
24	M6	MISC		1	24				2	p10	PL13x152	444				M270M-345		2	BRG1	PL20x290	640				M270M-345	
24	M6	L51x51x6.4	140				M270M-345		2	p8	PL13x152	308				M270M-345										
									2	p17	PL13x152	308				M270M-345										
									18	ss1	CP16	203				A108		2	BRG2	MISC		1	2			
2	M7	MISC		1	2				6	ss3	CP16	203				A108		2	BRG2	PL20x290	640				M270M-345	
2	M7	L152x102x19	3683				M270M-345		12	ss2	CP16	103				A108										
2	p7	PL13x174	444				M270M-345																			
2	p16	PL13x174	444				M270M-345																			
2	p6	PL13x152	444				M270M-345		2	BRG1	MISC		1	2												

Renaud Bros. Inc. 283 Fort Bridgeman Rd. #2 Vernon, VT. 05354 Phone 1-802 257-7383		Holes:		21mm UNO
		BOLTS:		19mm DIA. M16M-I GALV UNO
		Steel GR:		M270M-GR345 UNO
		Paint:		PER SPECS (GREEN) UNO
Rev.No:	Date:	Surface Prep:		PER SPECS
Project:		Date:		Job No.
DUMMERSTON BRIDGE		9-9-09		BHO 1442(28)
DUMMERSTON, VT		DWN. BY:	Checked:	Sheet No.
		EG	MRS	4

Nov 05 2009 10:54:37 AM