


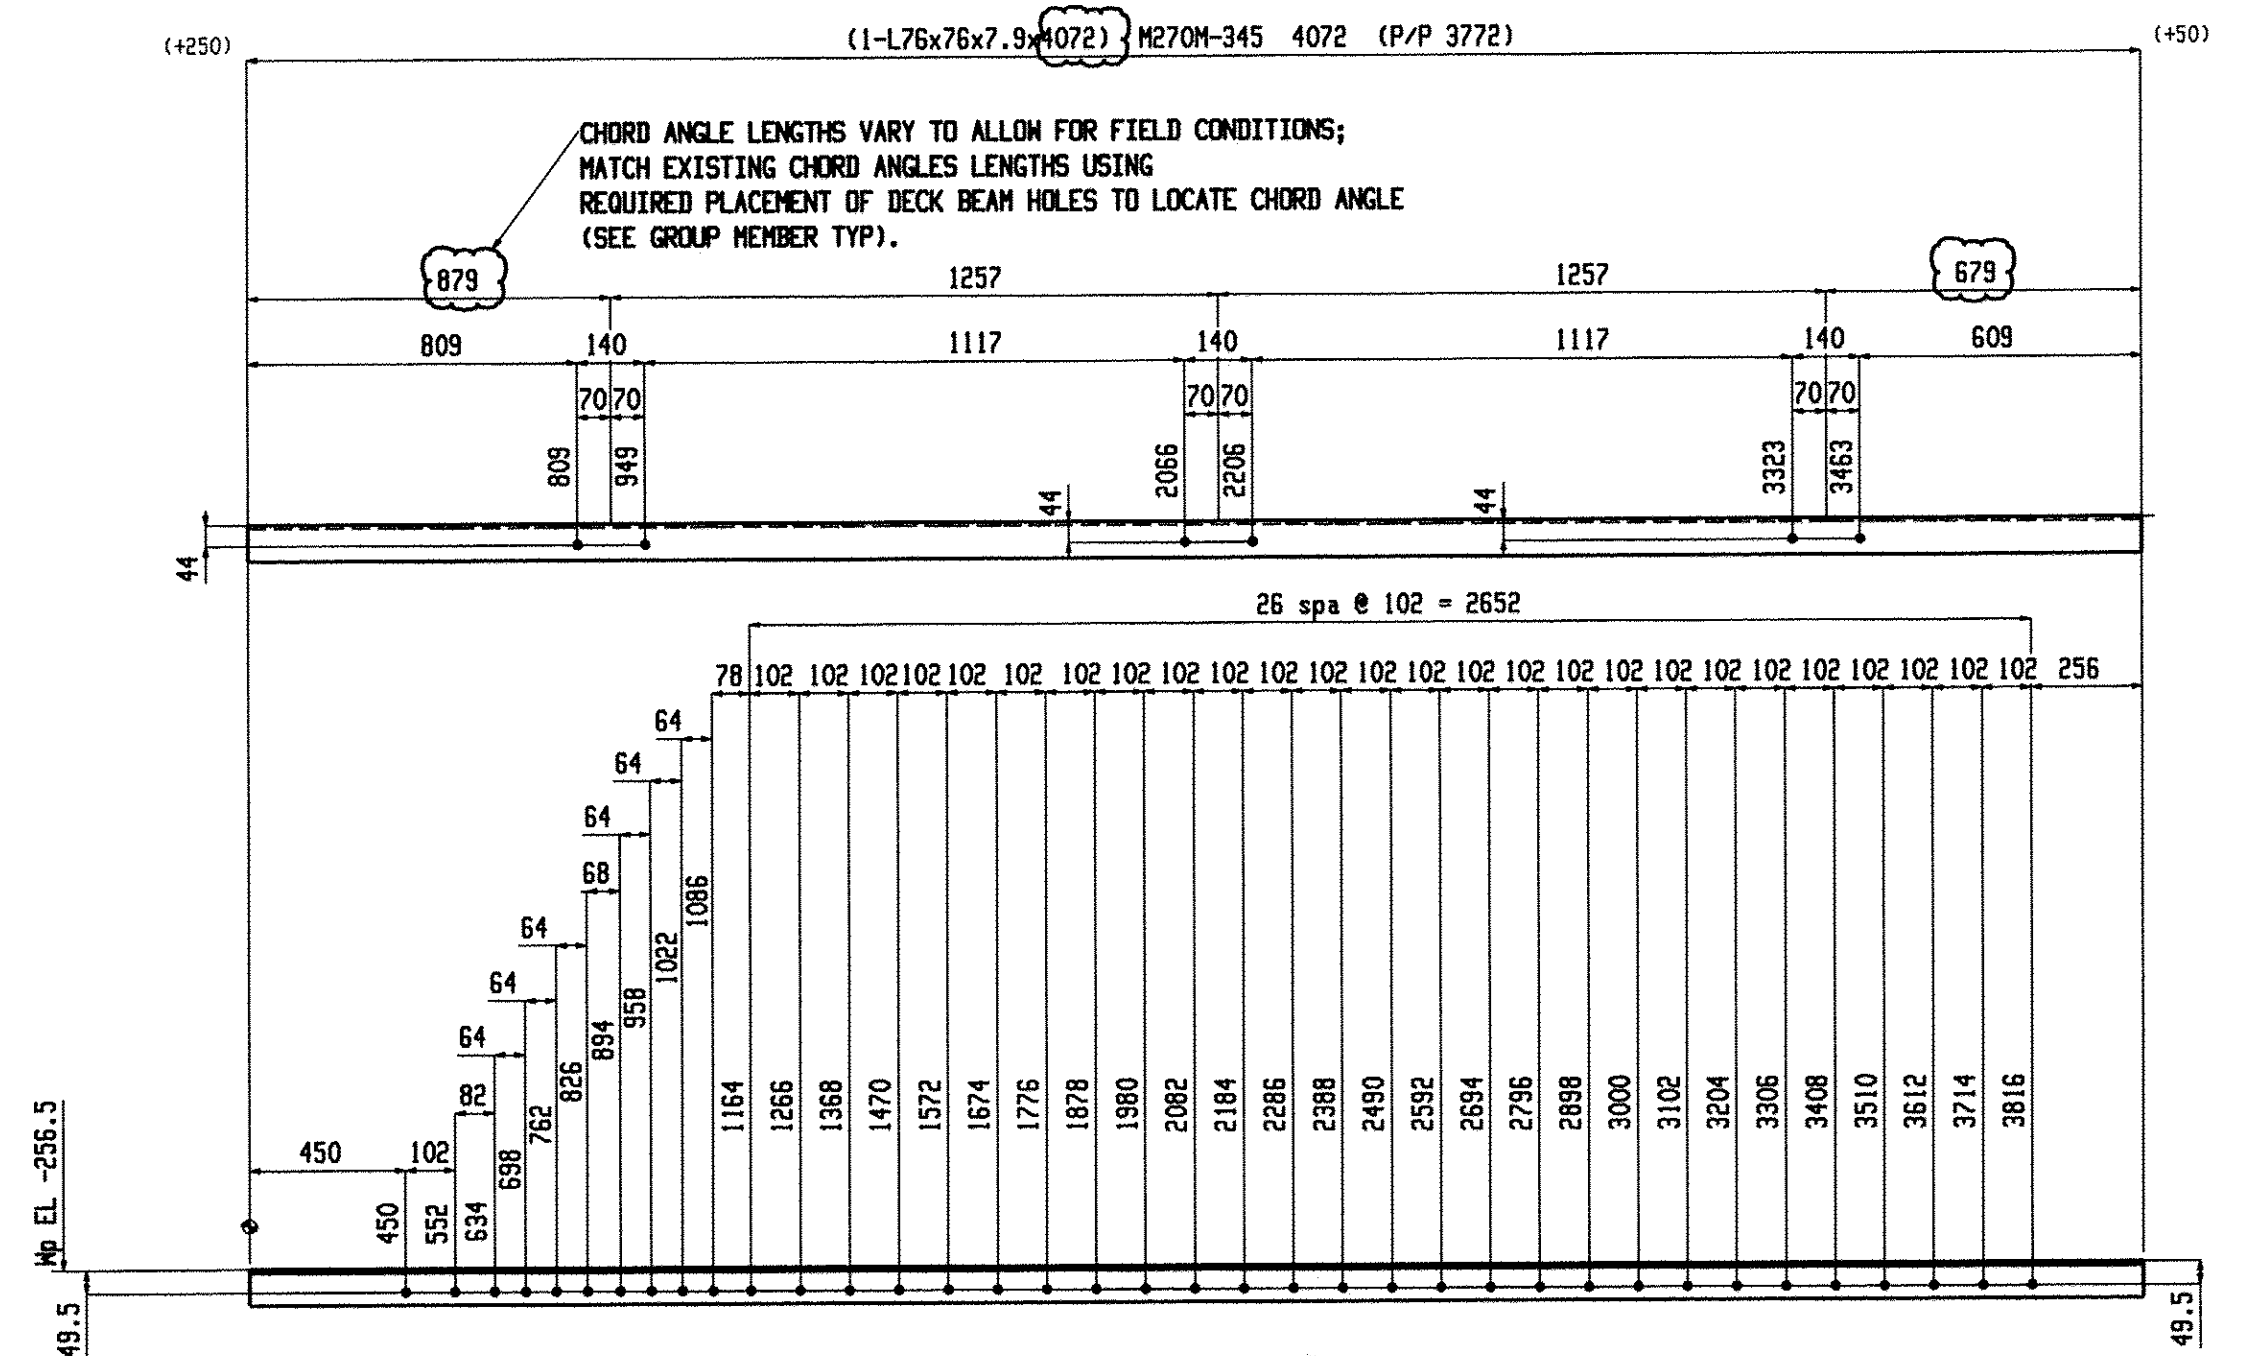


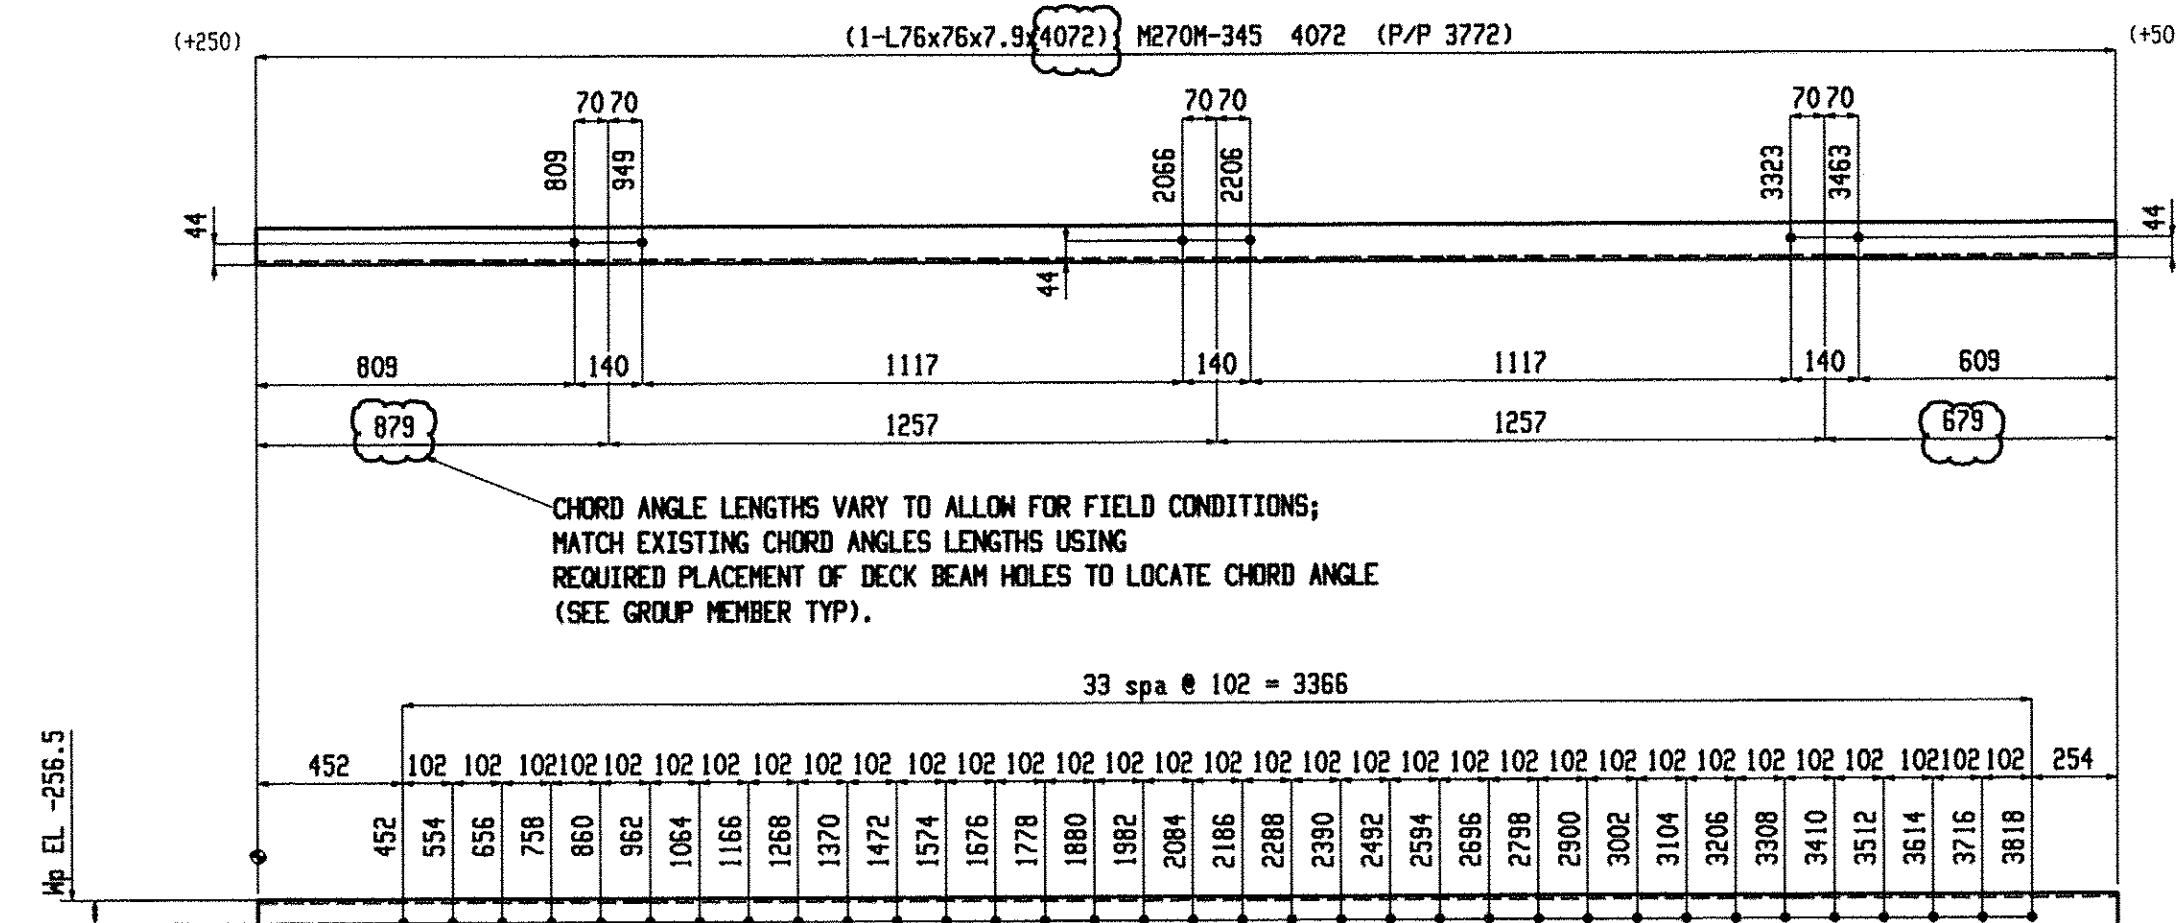


2 ANGLES A31

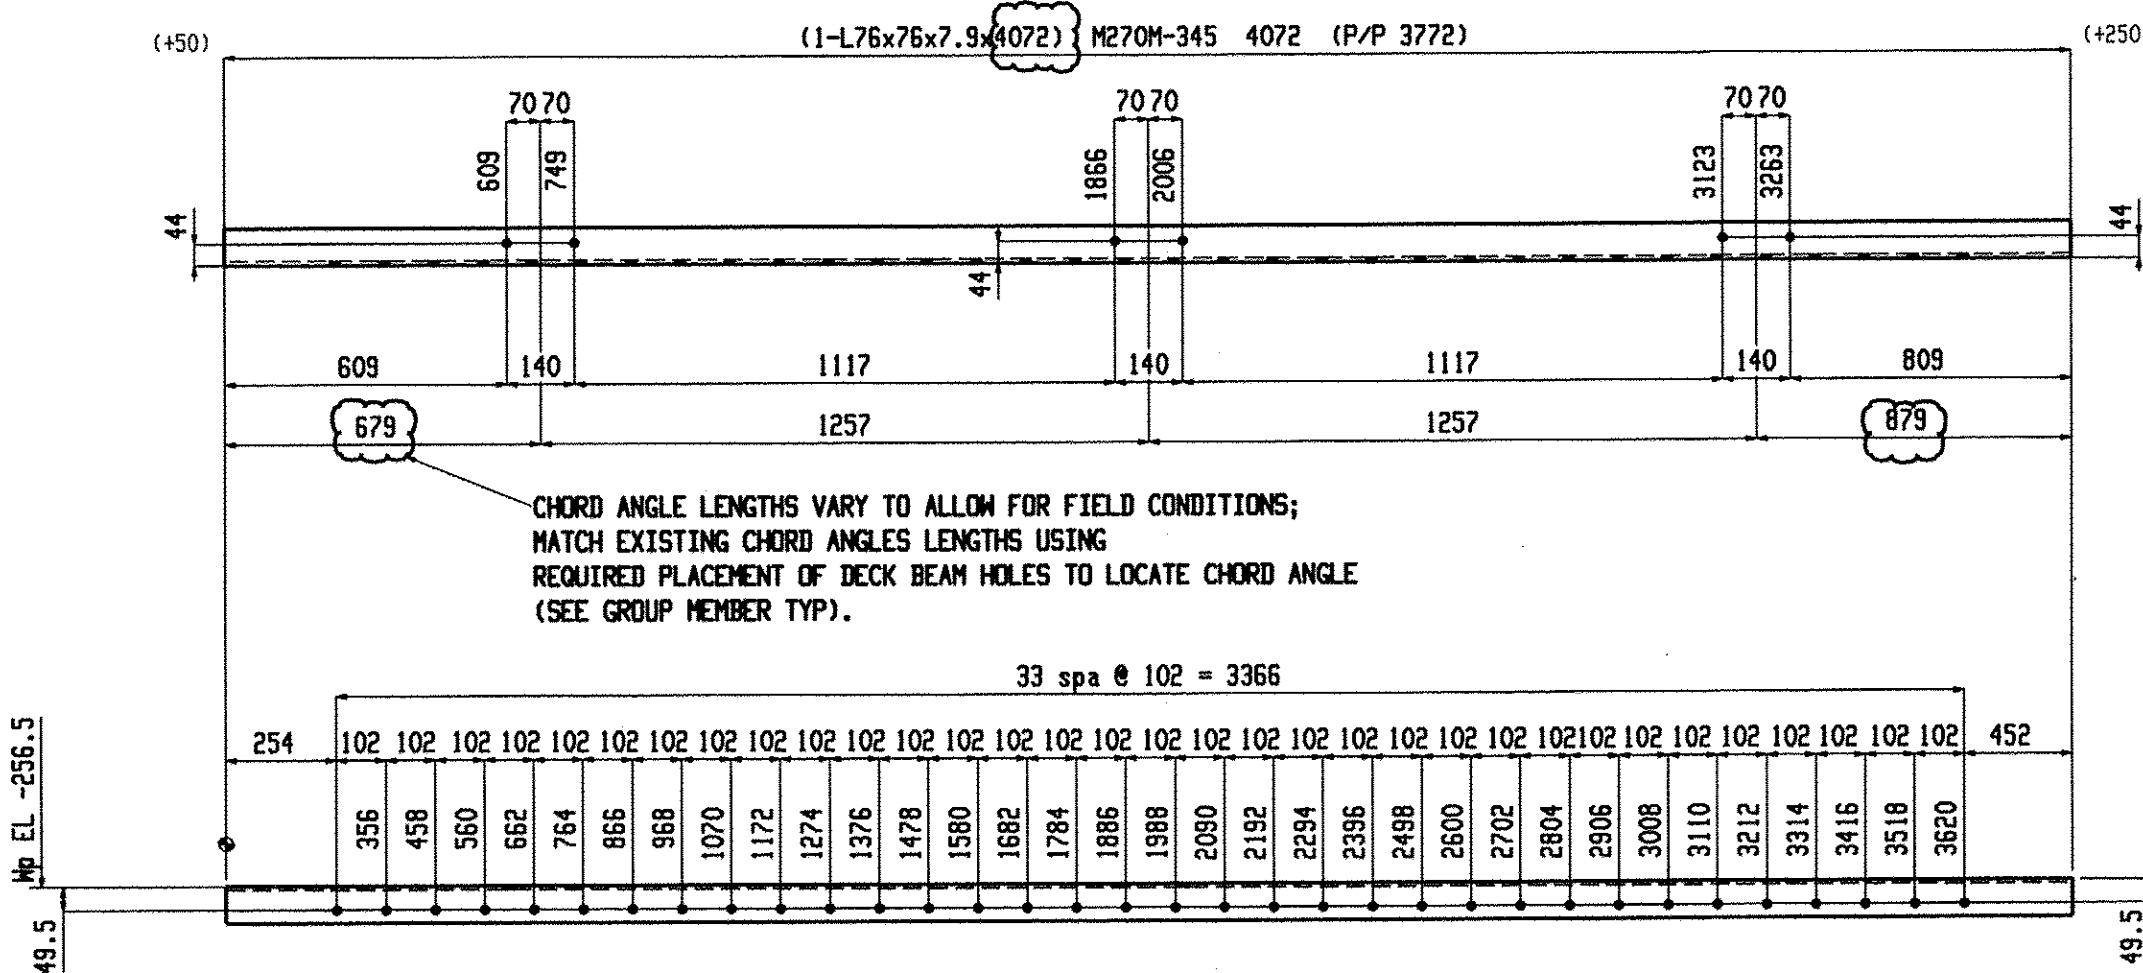

2 ANGLES A33

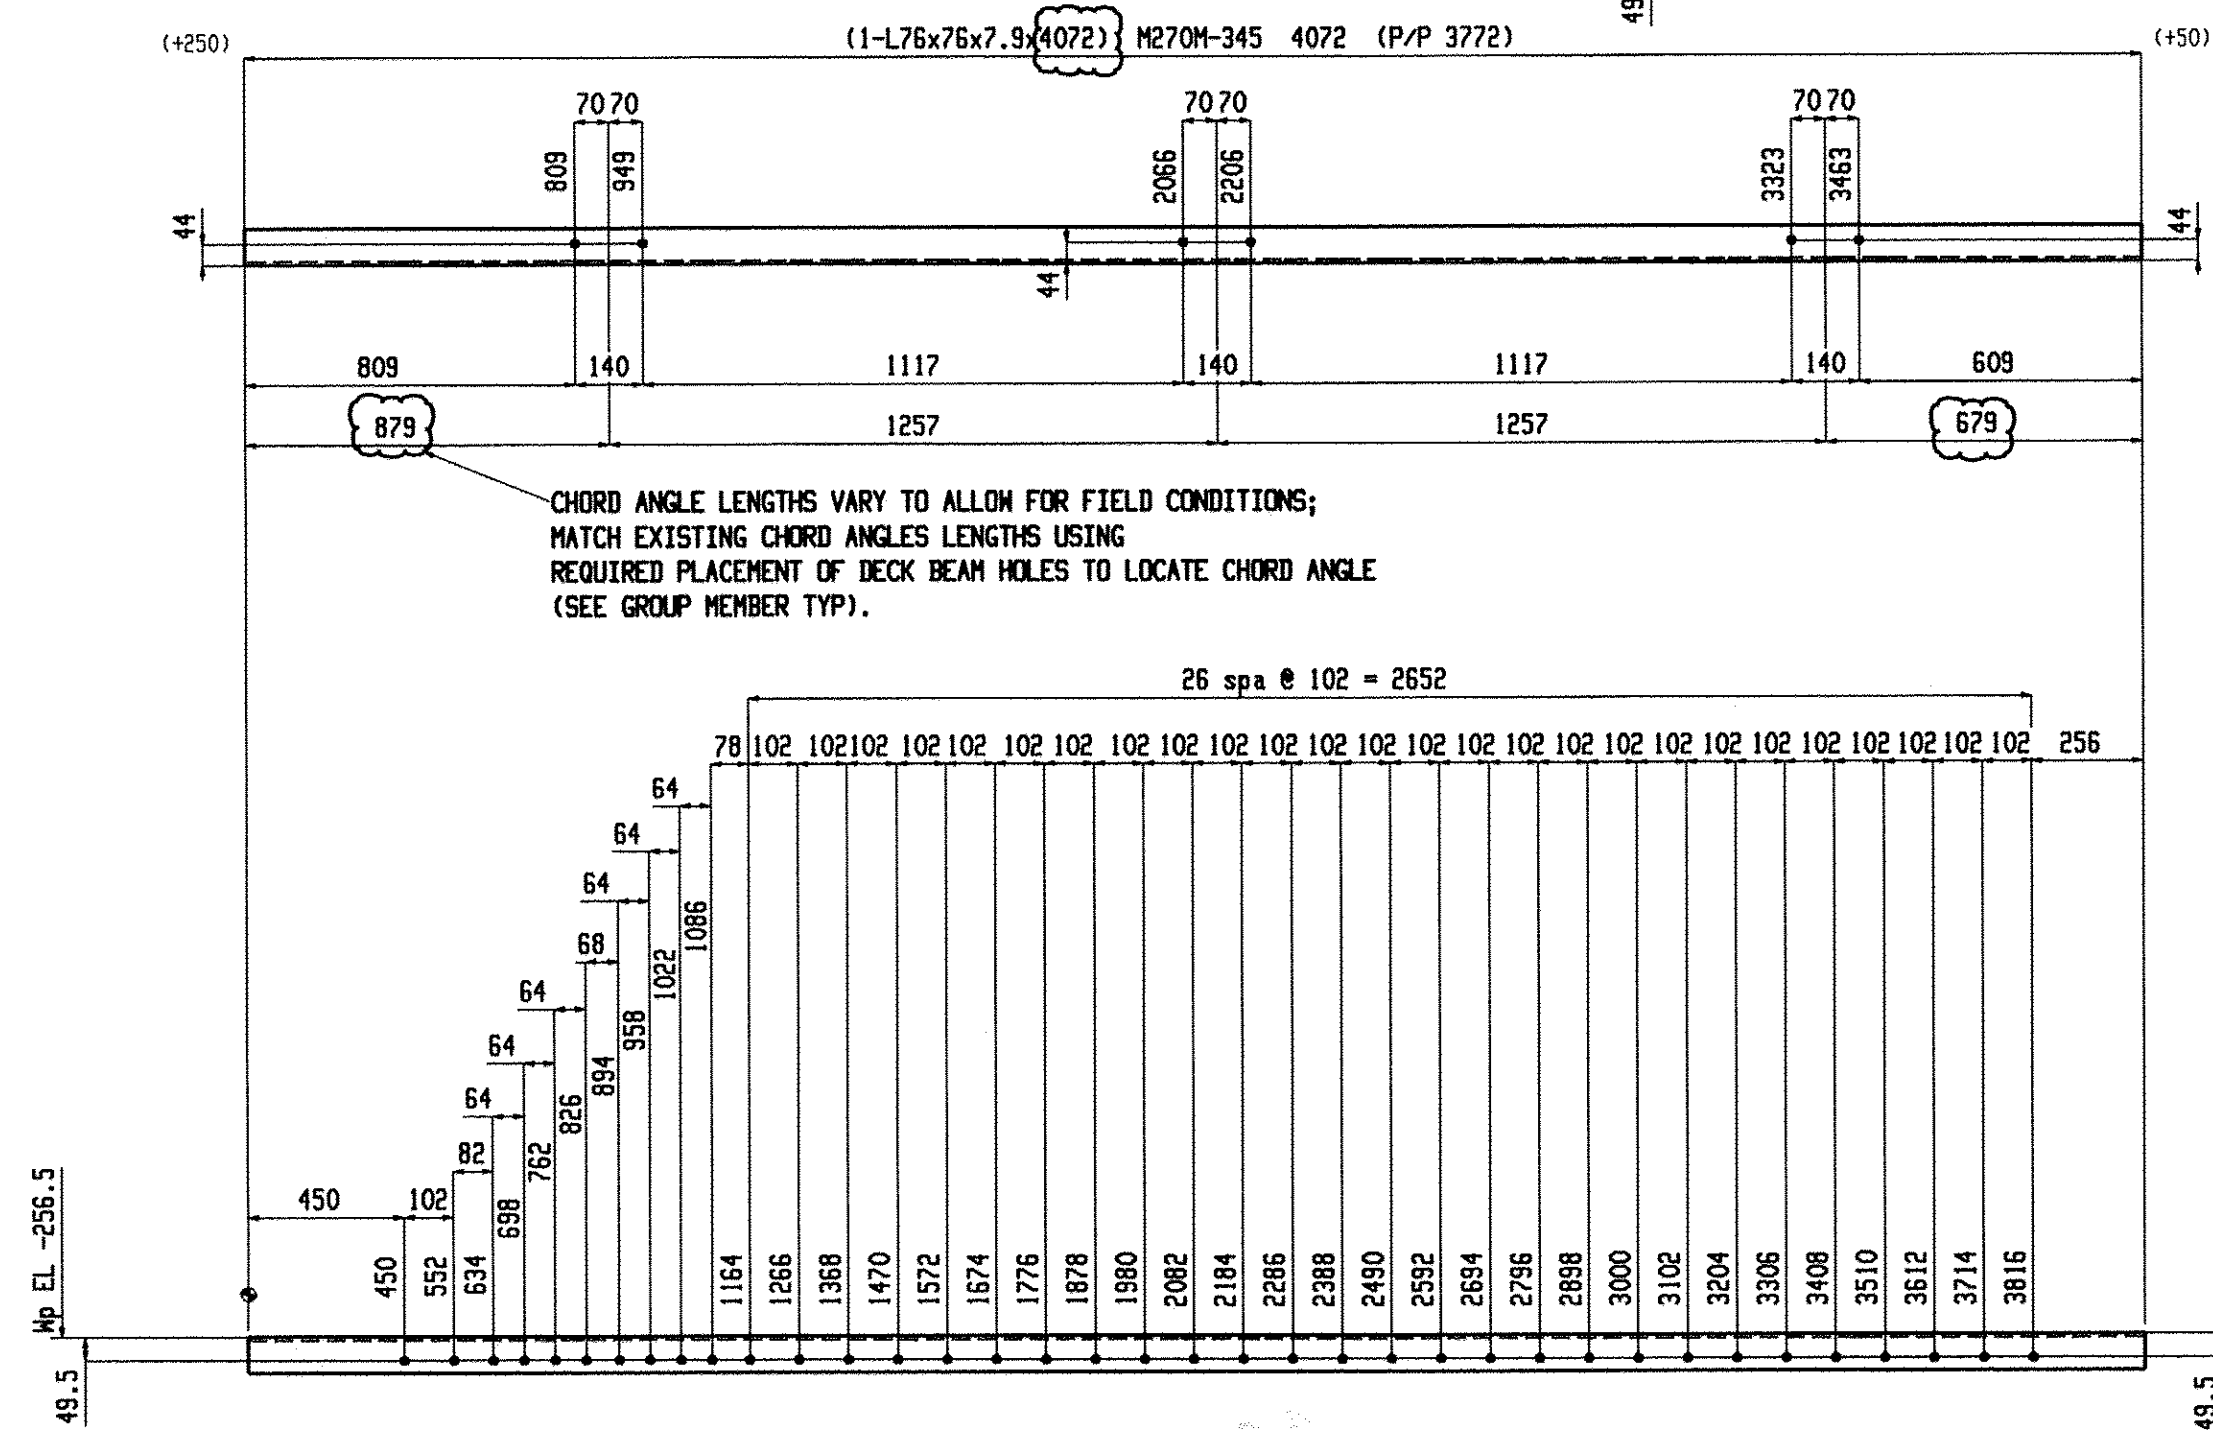

2 ANGLES A30

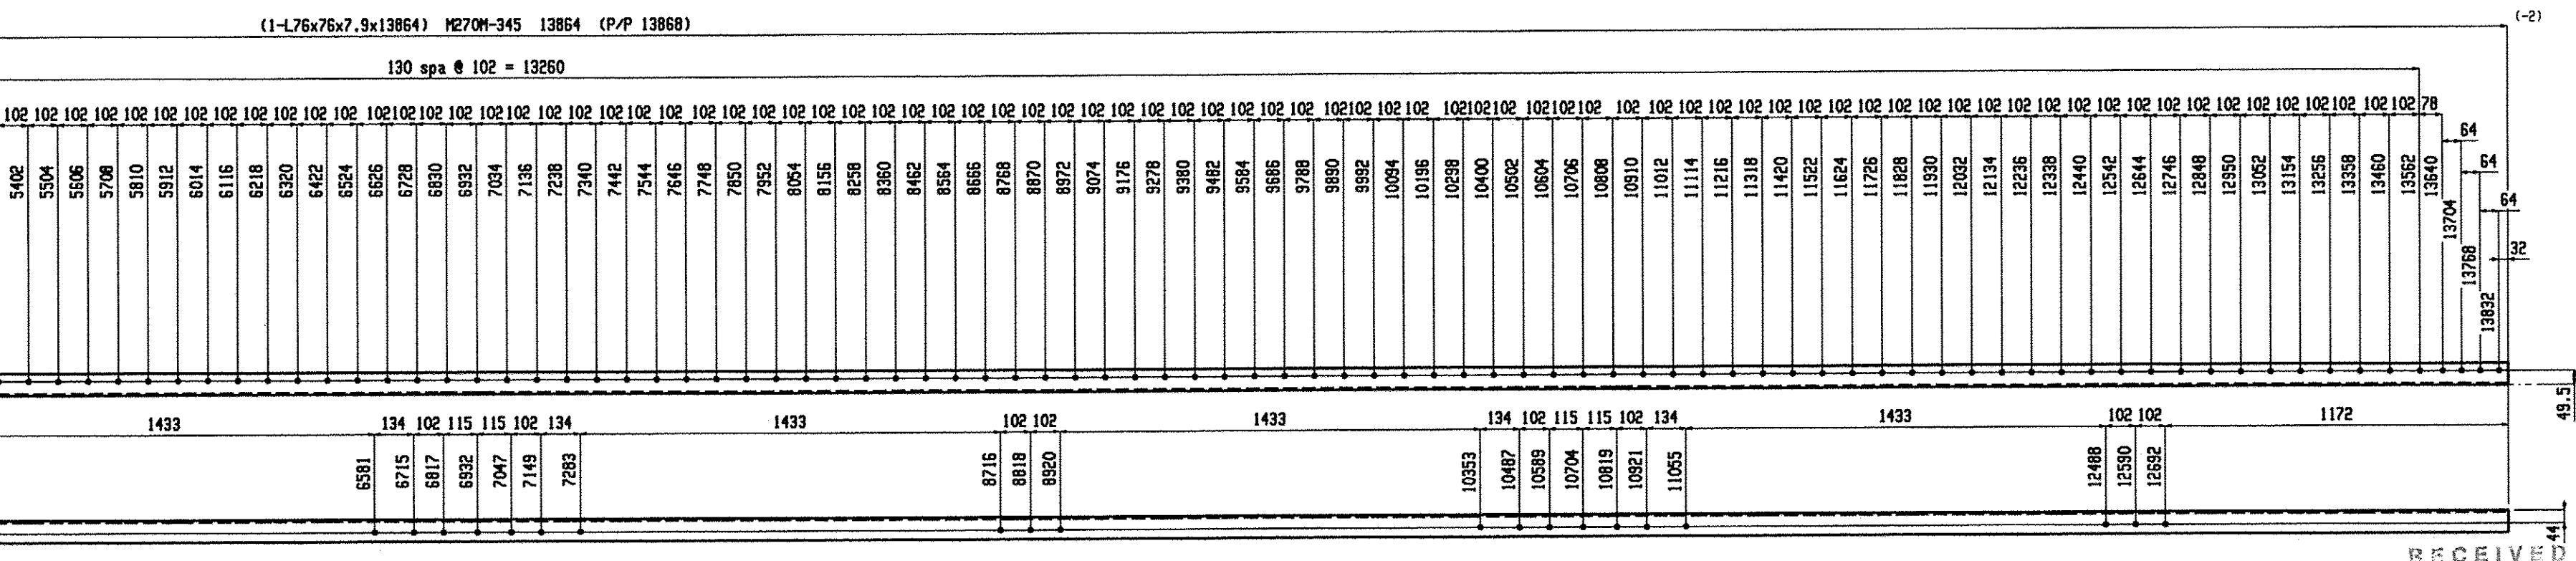

2 ANGLES A34

[illegible]

NOTE: WORK THIS DRAWING WITH
GROUP MEMBER GM8

Renaud Bros. Inc. 283 Fort Bridgeman Rd. #2 Vernon, VT. 05354 Phone 1-802 257-7383			Holes:	21mm UNO
			BOLTS:	19mm DIA. M16M-I GALV UNO
			Steel GR:	M270M-GR345 UNO
			Paint:	PER SPECS (GREEN) UNO
Rev. No:		Date:	Surface Prep: PER SPECS	
Project: DUMMERSTON BRIDGE DUMMERSTON, VT		Date: 9-9-09		Job No. BHO 1442 (28)
		DWN. BY: EG	Checked: MRS	Sheet No. 12