




4 MISCS A47

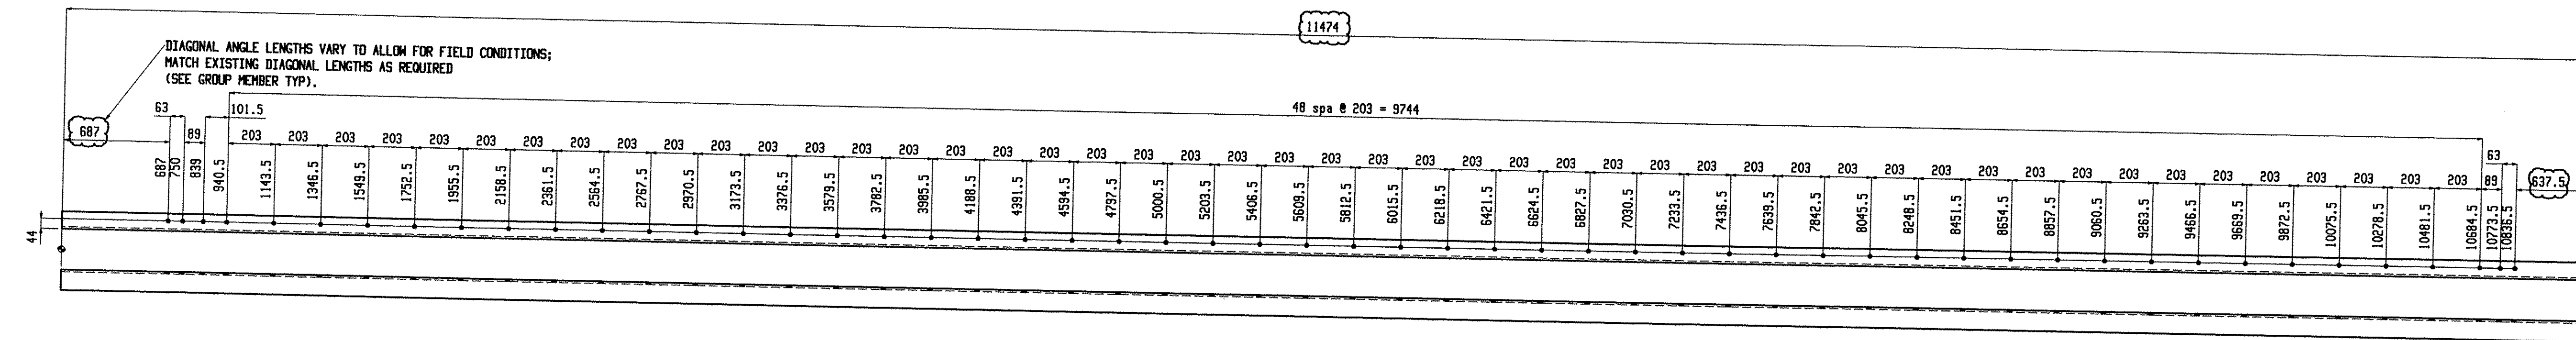


4 MISCS A48

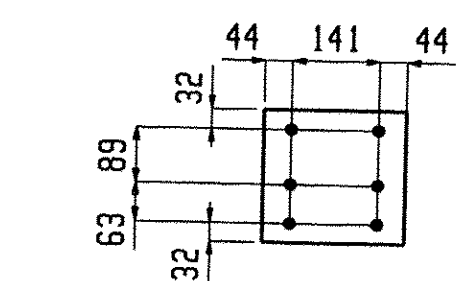


8 MISCS M12

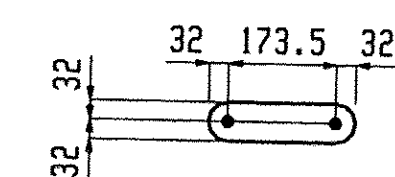

388 MISCS M13

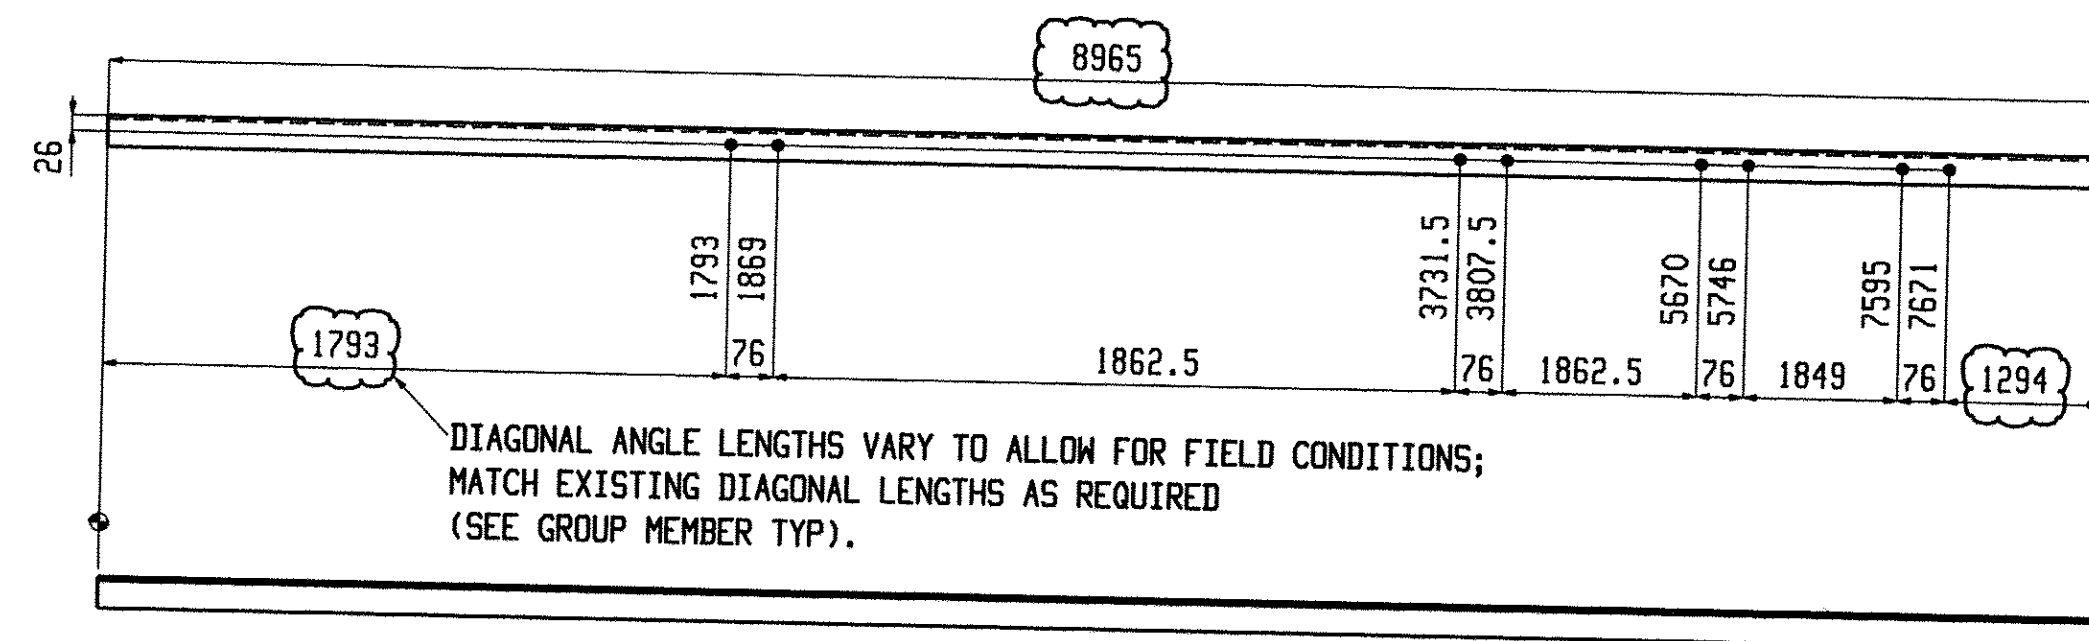

4 MISCS A49

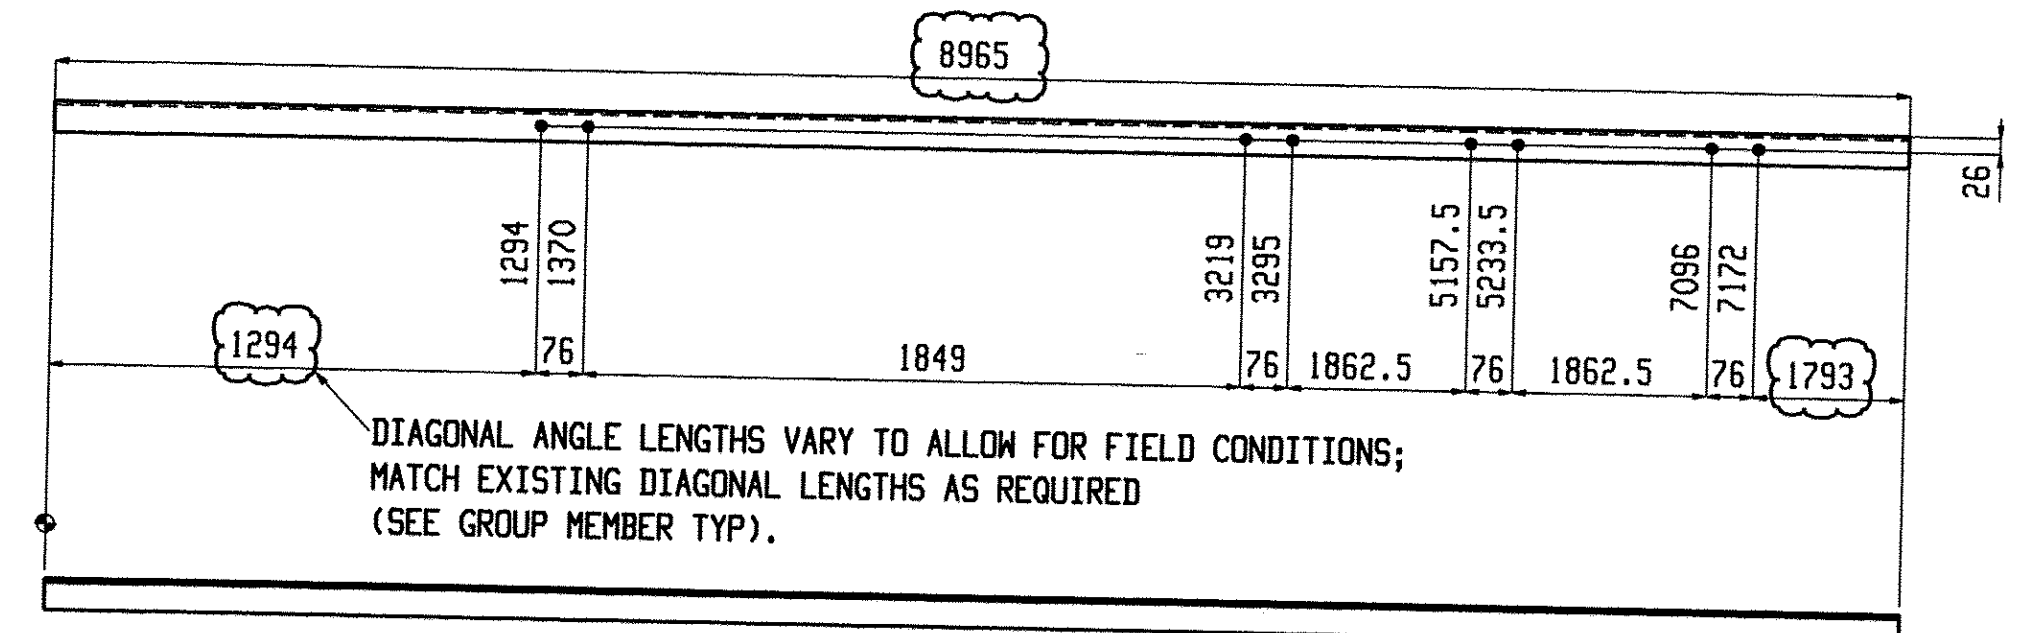

4 MISCS A50

BILL OF MATERIAL

Qty	Piece		Seq	Seq	Adv	Steel	
Tot.	Mark	Description	Length	NO.	Qty	ADM #	Grade
4	A47	MISC	1	4			
4	A47	L89x76x9.5	11474				M270M-345
4	A48	MISC	1	4			
4	A48	L89x76x9.5	11474				M270M-345
8	M12	MISC	1	8			

BILL OF MATERIAL

Qty	Piece		Seq	Seq	Adv	Steel	
Tot.	Mark	Description	Length	NO.	Qty	ADM #	Grade
8	M12	PL6.4x216	229				M270M-345
388	M13	MISC	1	388			
388	M13	PL6.4x64	237.5				M270M-345
4	A49	MISC	1	4			
4	A49	L51x51x6.4	8965				M270M-345

BILL OF MATERIAL

Qty	Piece		Seq	Seq	Adv	Steel	
Tot.	Mark	Description	Length	NO.	Qty	ADM #	Grade
4	A50	MISC	1	4			
4	A50	L51x51x6.4	8965				M270M-345

Total weight : 1721

RECEIVED
NOV 17 2010
BY DATE

NOTE: WORK THIS DRAWING WITH
GROUP MEMBER GM12&GM16

Renaud Bros. Inc.
283 Fort Bridgeman Rd. #2
Vernon, VT. 05354
Phone 1-802 257-7383

Holes:	21mm UNO
BOLTS:	19mm DIA. M164M-I GALV UNO
Steel GR:	M270M-GR345 UNO
Paint:	PER SPECS (GREEN) UNO
Surface Prep:	PER SPECS

Project:
DUMMERSTON BRIDGE
DUMMERSTON, VT

Date: 9-9-09
Job No. BHD 1442(28)
DMN. BY: EG
Checked: MRS
Sheet No. 18