



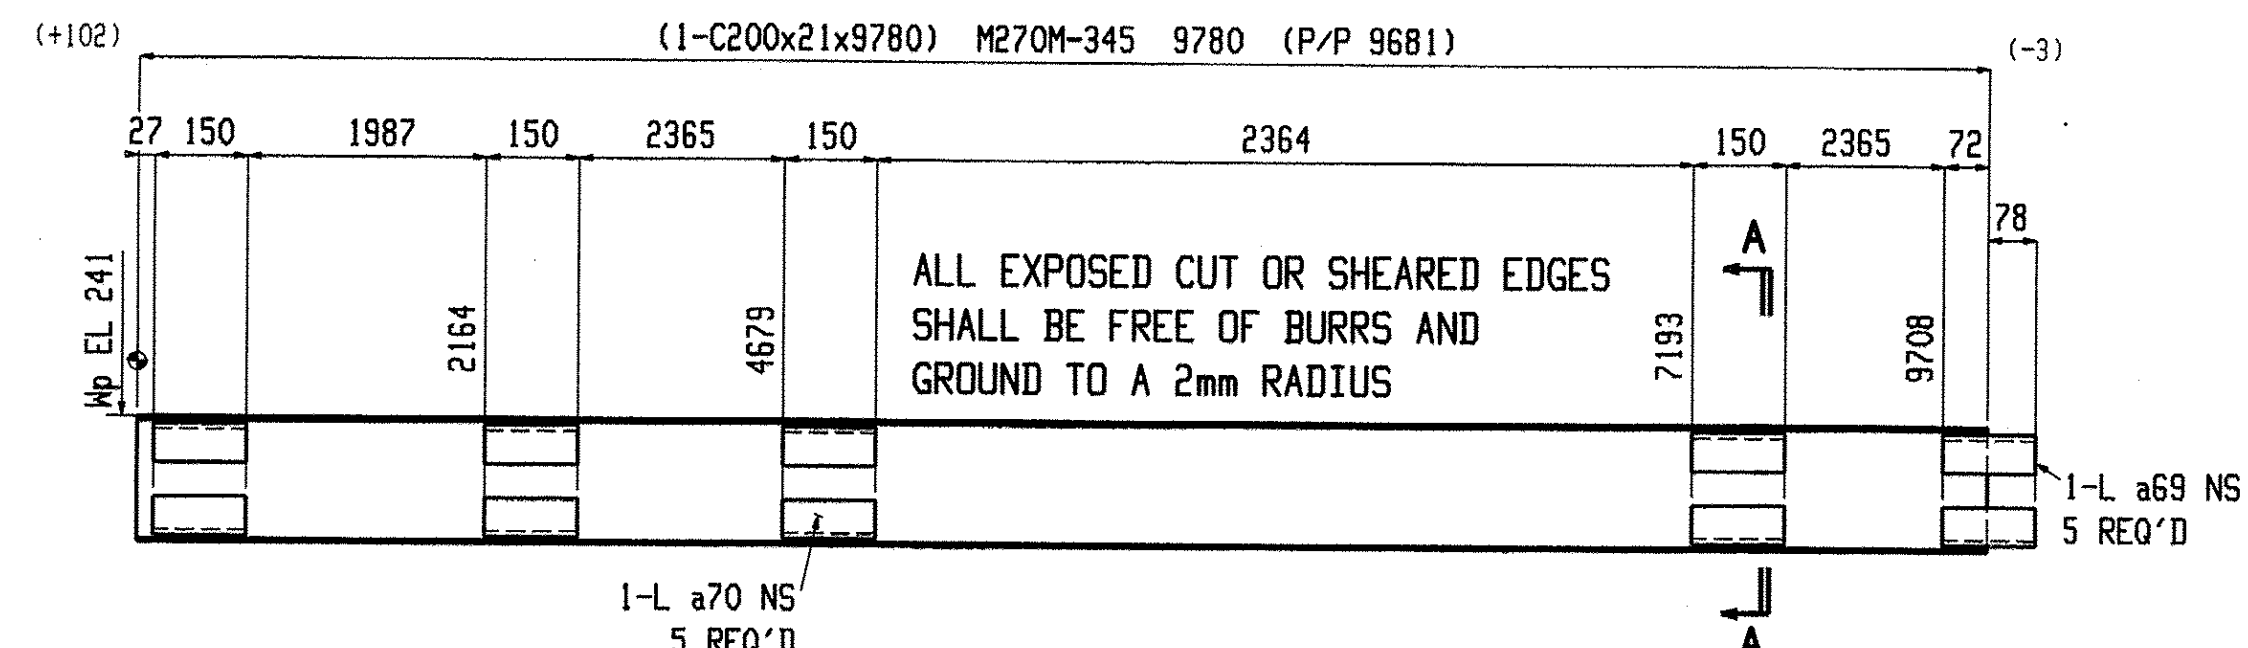

ONE BEAM R1

W 203x7.5
F 59.5x10
K 24x18


SHOP NOTE:
TOE DIRECTION NEAR SIDE

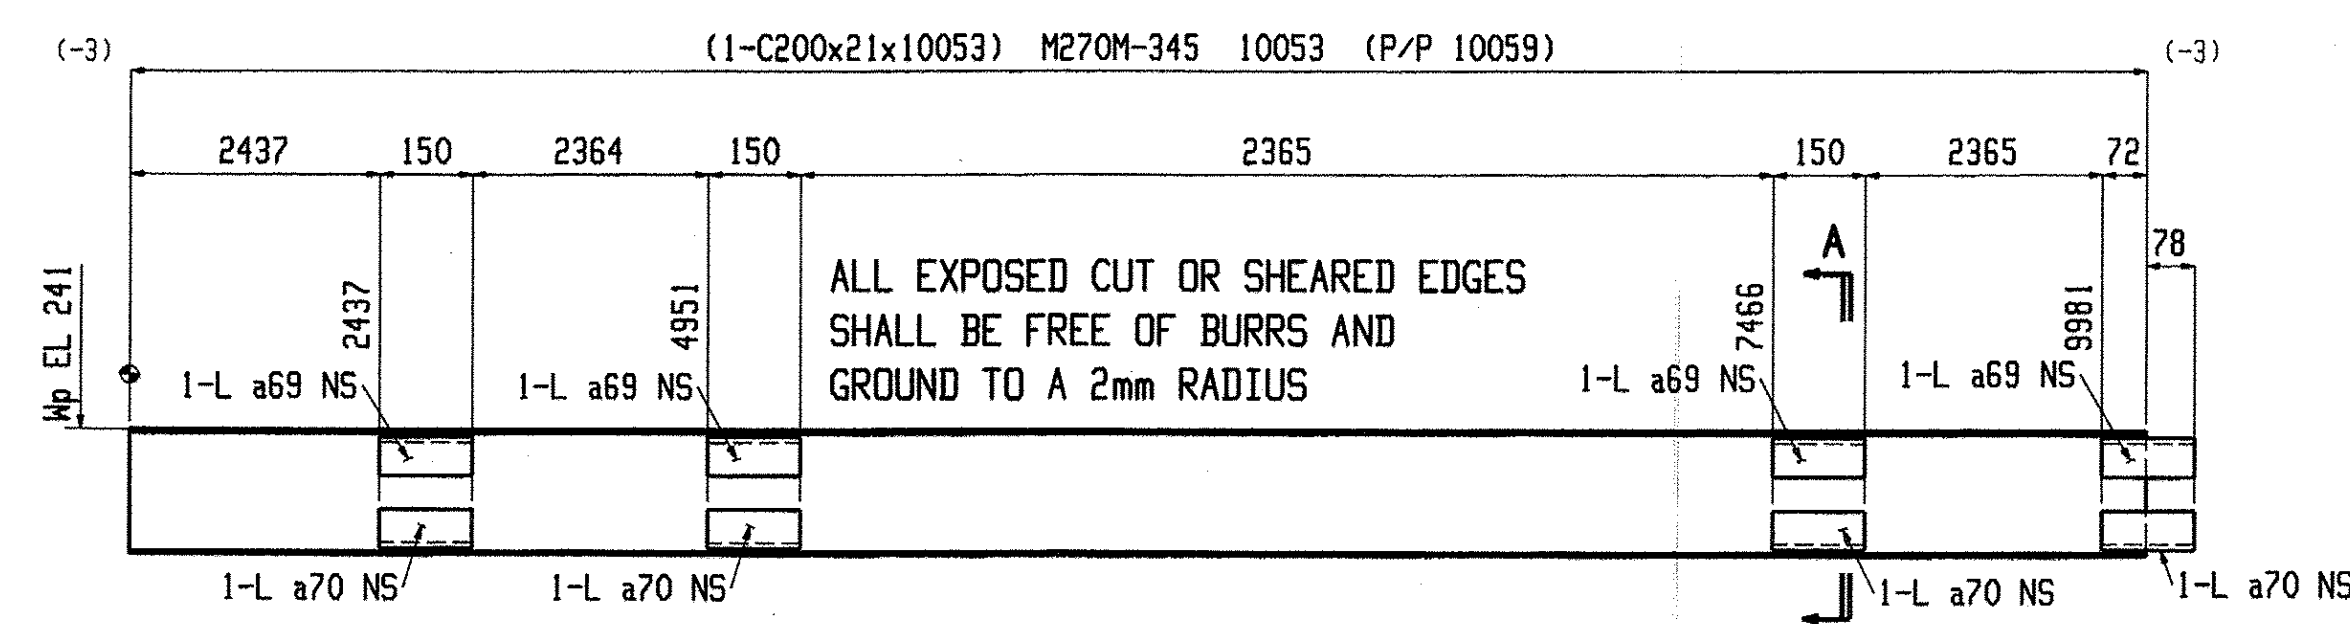

ONE BEAM R2

W 203x7.5
F 59.5x10
K 24x18


SHOP NOTE:
TOE DIRECTION NEAR SIDE

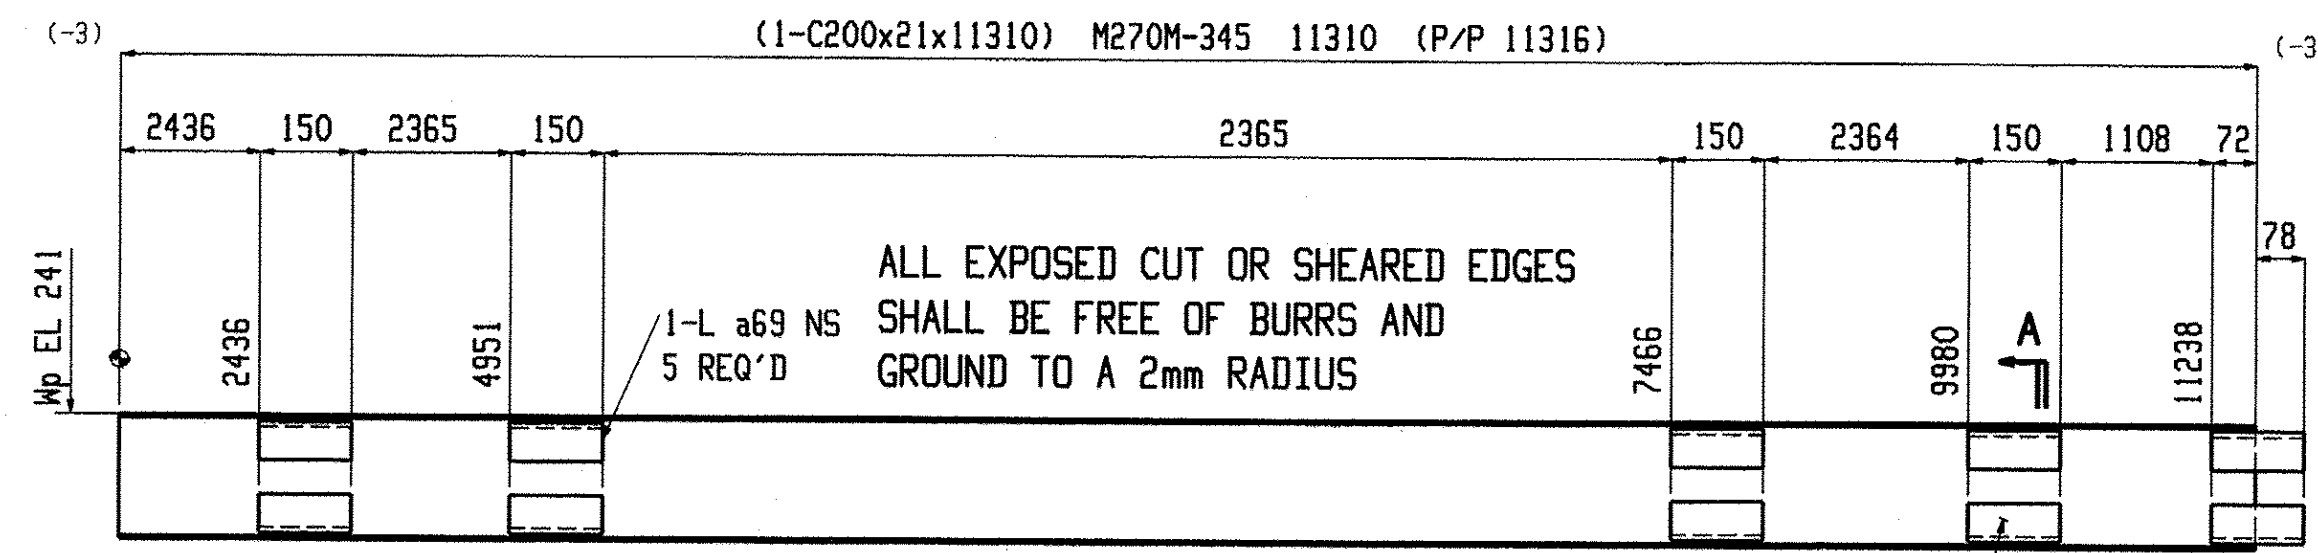

ONE BEAM R3

W 203x7.5
F 59.5x10
K 24x18


SHOP NOTE:
TOE DIRECTION NEAR SIDE

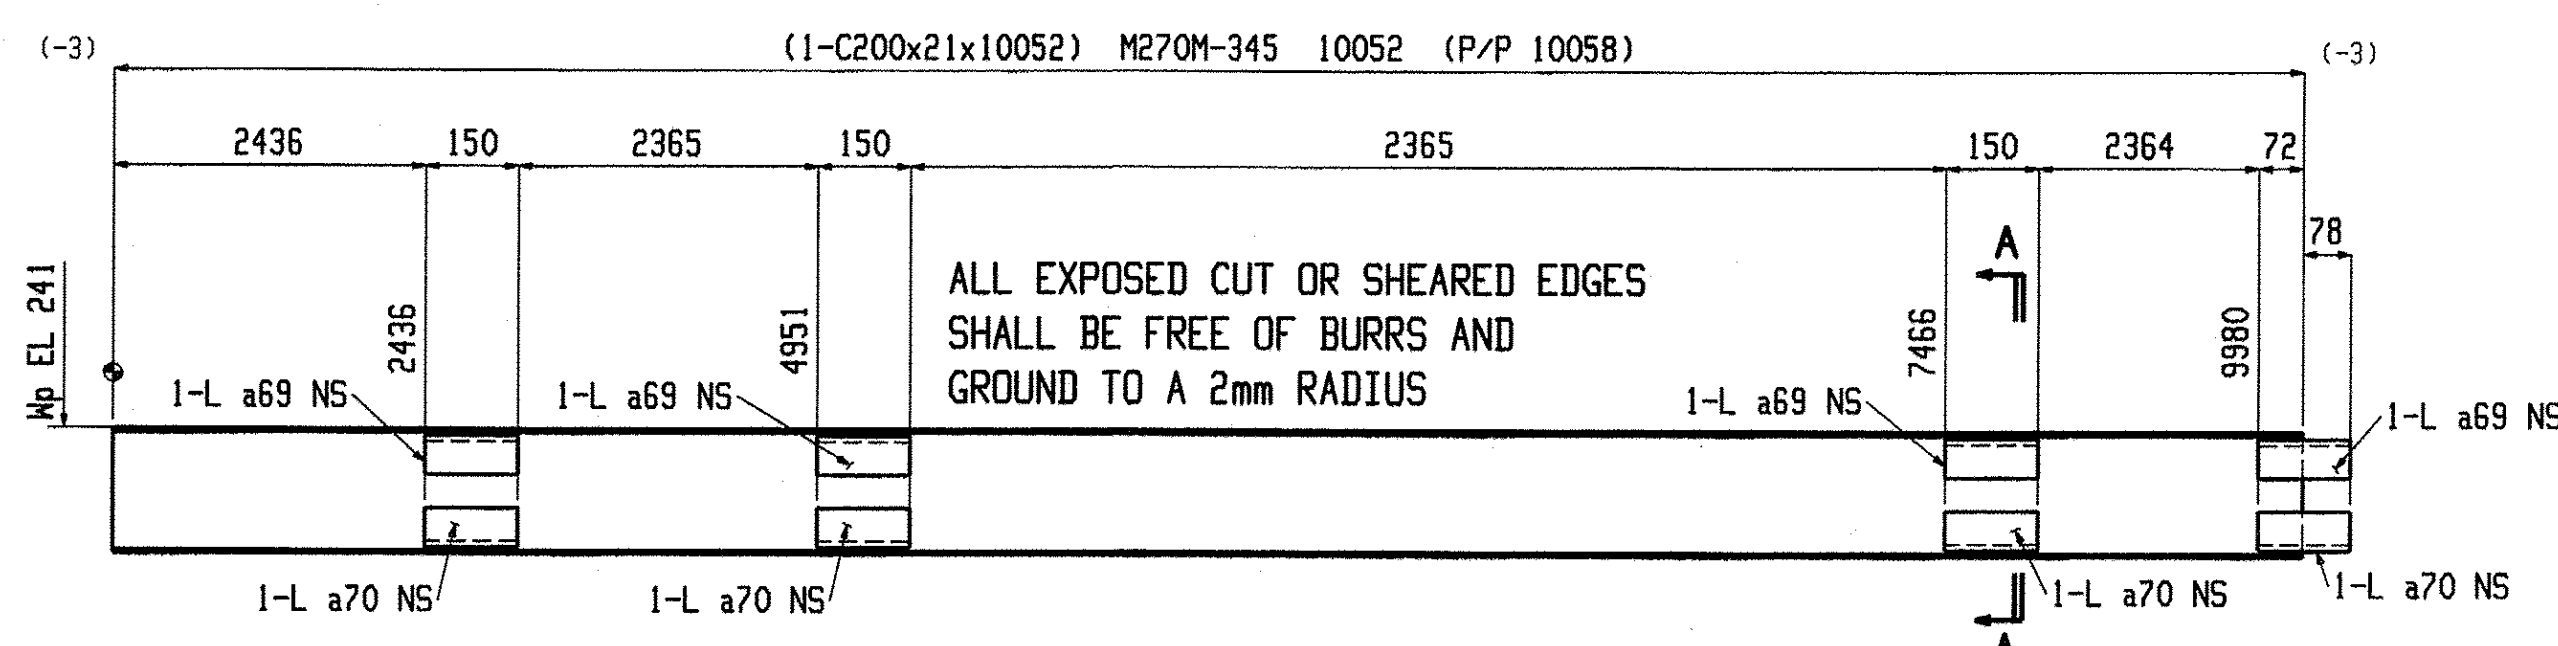

ONE BEAM R4

W 203x7.5
F 59.5x10
K 24x18


SHOP NOTE:
TOE DIRECTION NEAR SIDE

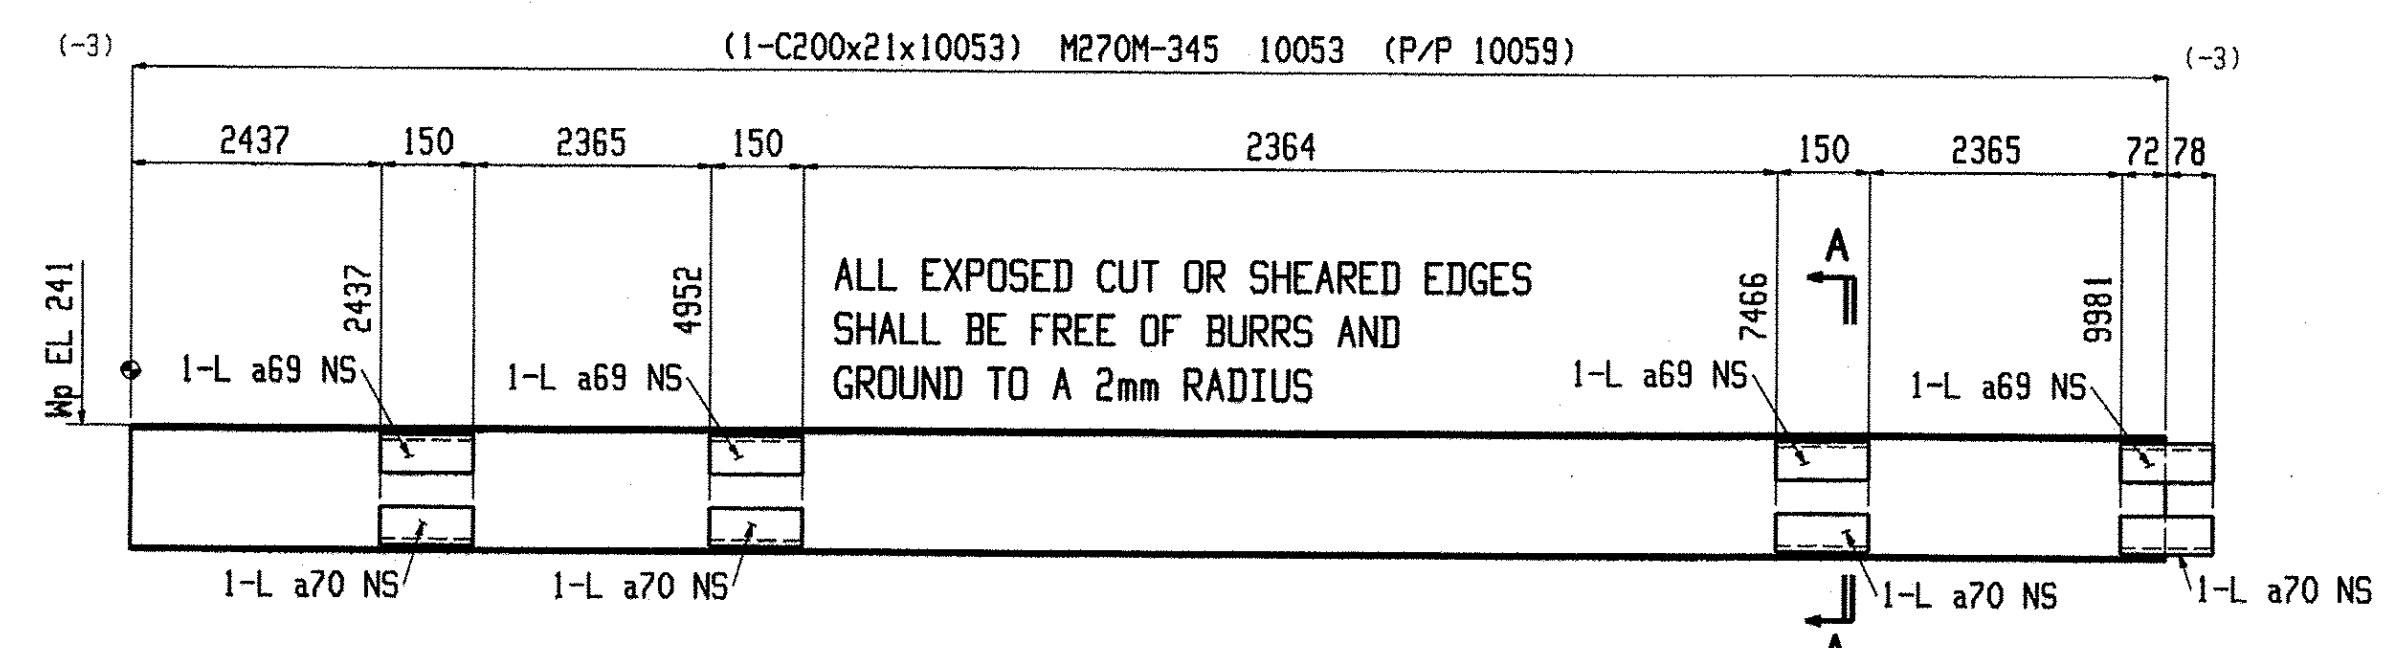


ONE BEAM R5

W 203x7.5
F 59.5x10
K 24x18


SHOP NOTE:
TOE DIRECTION NEAR SIDE

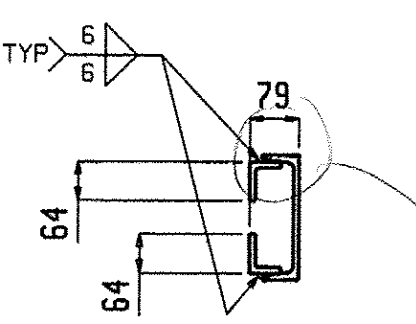

Section A-A
R1

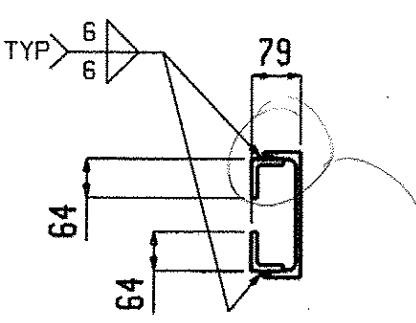



Section A-A
R3

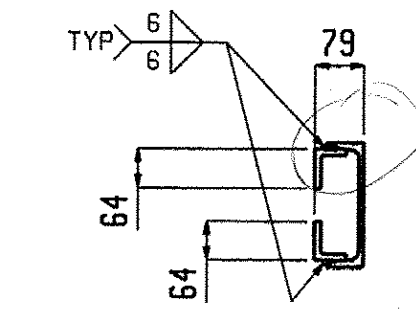


Section A-A
R5

will this be a fillet weld?

weld type?

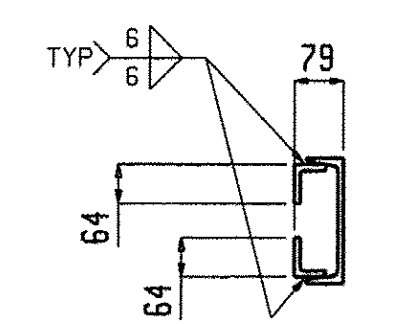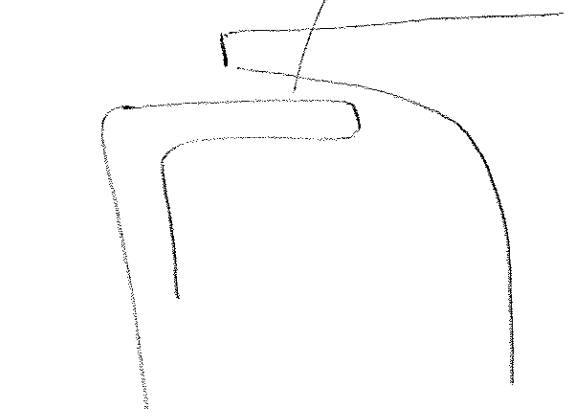

Section A-A
R2

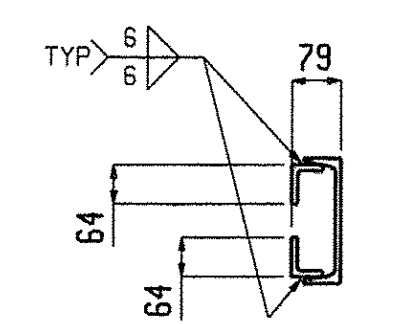

Section A-A
R4

BILL OF MATERIAL								BILL OF MATERIAL								BILL OF MATERIAL							
Qty	Piece			Seq	Seq	Adv	Steel	Qty	Piece			Seq	Seq	Adv	Steel	Qty	Piece			Seq	Seq	Adv	Steel
Tot.	Mark	Description	Length	NO.	Qty	ARM #	Grade	Tot.	Mark	Description	Length	NO.	Qty	ARM #	Grade	Tot.	Mark	Description	Length	NO.	Qty	ARM #	Grade
ONE R1	BEAM			2	1			ONE R3	BEAM			2	1			ONE R5	BEAM			2	1		
1 R1	C200x21	9780					M270M-345	1 R3	C200x21	11310					M270M-345	1 R5	C200x21	10053					M270M-345
5 a69	L64x51x9.5	150					M270M-345	5 a69	L64x51x9.5	150					M270M-345	4 a69	L64x51x9.5	150					M270M-345
5 a70	L64x51x9.5	150					M270M-345	5 a70	L64x51x9.5	150					M270M-345	4 a70	L64x51x9.5	150					M270M-345
ONE R2	BEAM			2	1			ONE R4	BEAM			2	1										
1 R2	C200x21	10053					M270M-345	1 R4	C200x21	10052					M270M-345								
4 a69	L64x51x9.5	150					M270M-345	4 a69	L64x51x9.5	150					M270M-345								
4 a70	L64x51x9.5	150					M270M-345																

Total weight : 1100

Fabrication is not to be done by Renaud Bros. Have fabricator resubmit with name of fabricator on sheets.

Renaud Bros. Inc. 283 Fort Bridgeman Rd. #2 Vernon, VT. 05354 Phone 1-802 257-7383		Holes: 21mm UNO	
BOLTS: 19mm DIA. M164M-I GALV UNO		Steel GR: M270M-GR345 UNO	
Paint: PER SPECS (GREEN) UNO		Surface Prep: PER SPECS	
Project: DUMMERSTON BRIDGE DUMMERSTON, VT	Date: 9-9-09	Job No. 1942(25)	Sheet No. 20
Rev. No:	EG	Checked: MRS	

Nov 08 2009 10:55:40 AM