



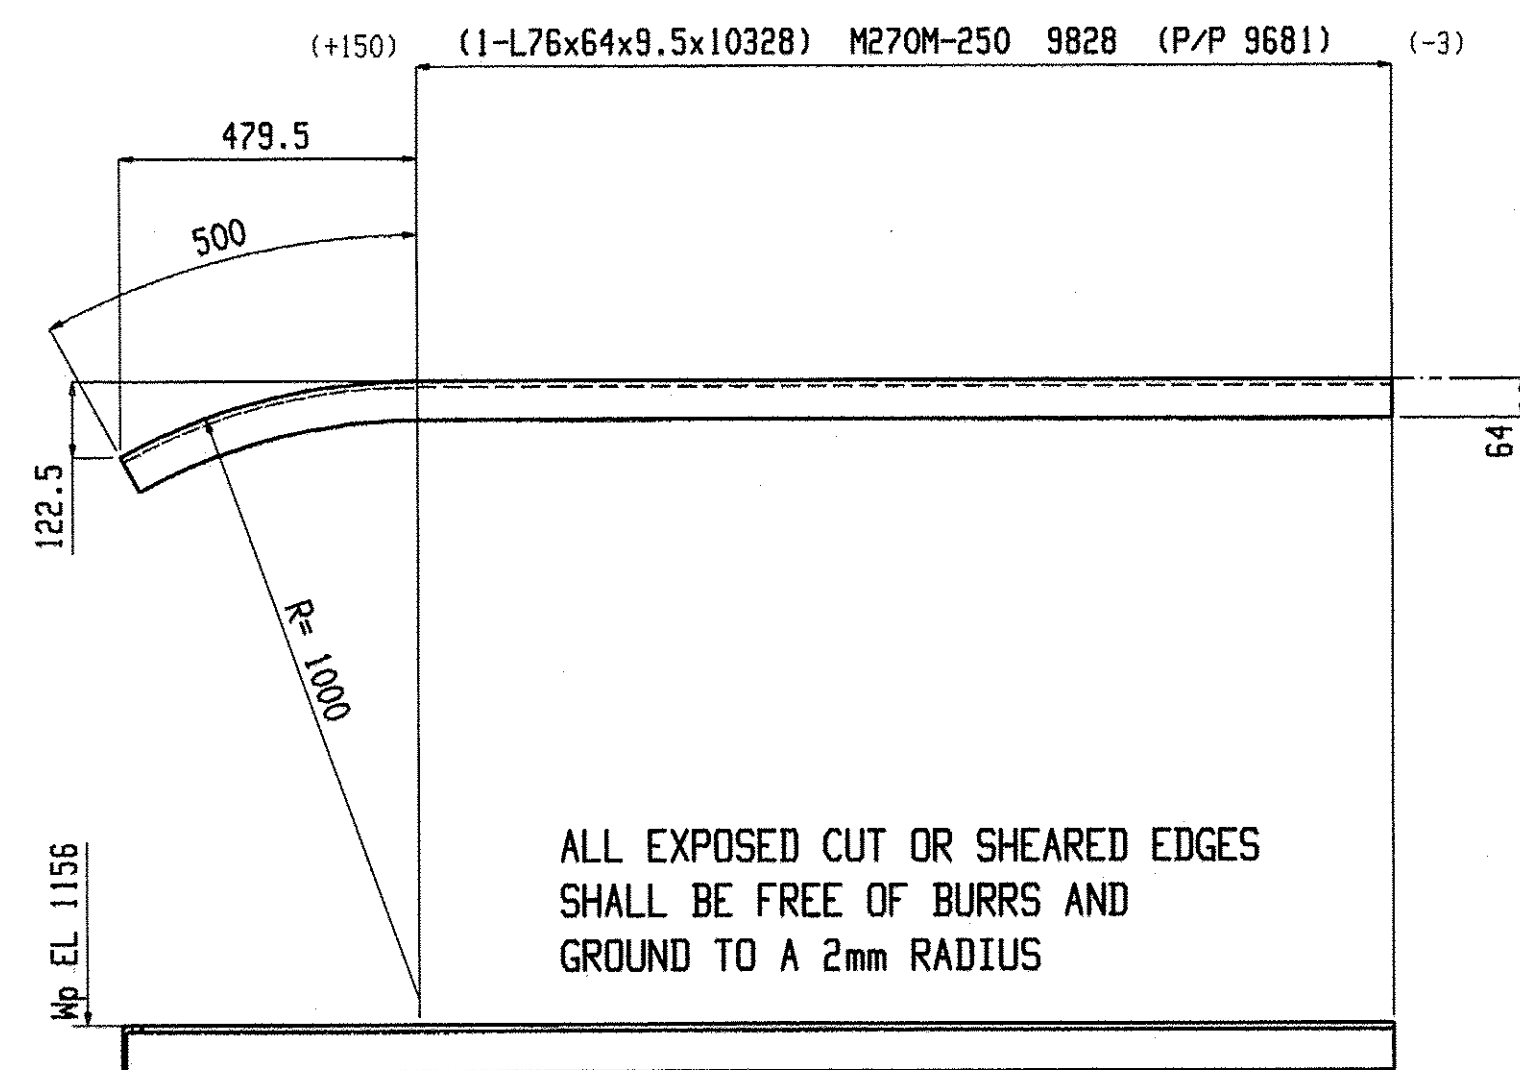


ONE BEAM R23

SHOP NOTE:
TOE DIRECTION NEAR SIDE

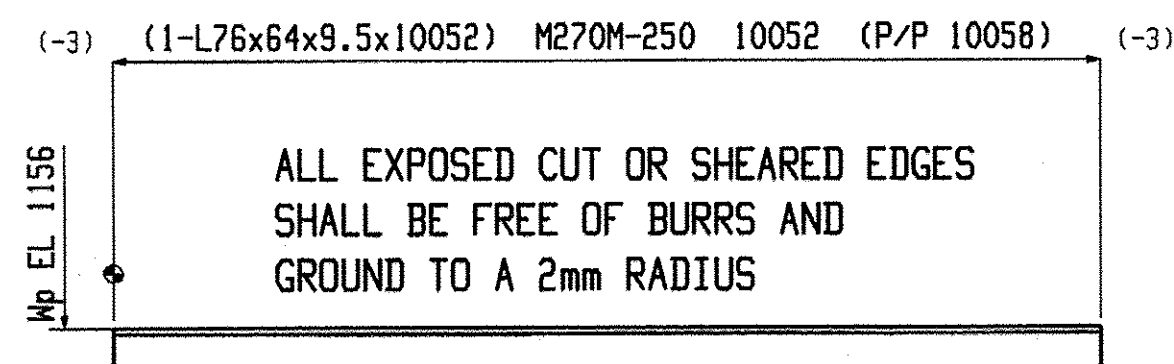


ONE BEAM R26

SHOP NOTE:
TOE DIRECTION NEAR SIDE

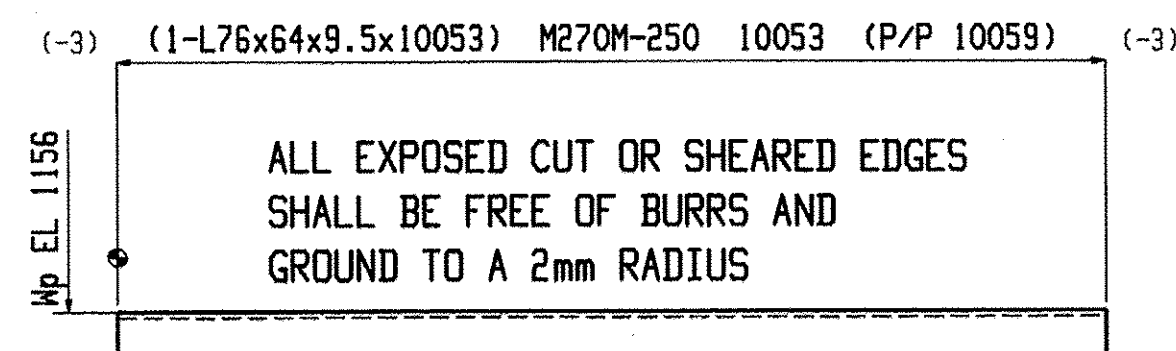


2 BEAMS R29

SHOP NOTE:
TOE DIRECTION FAR SIDE

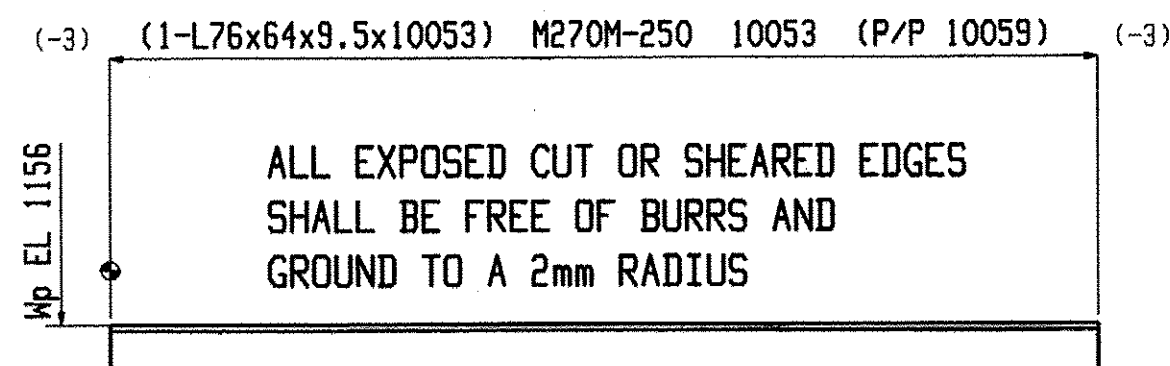


2 BEAMS R24

SHOP NOTE:
TOE DIRECTION NEAR SIDE

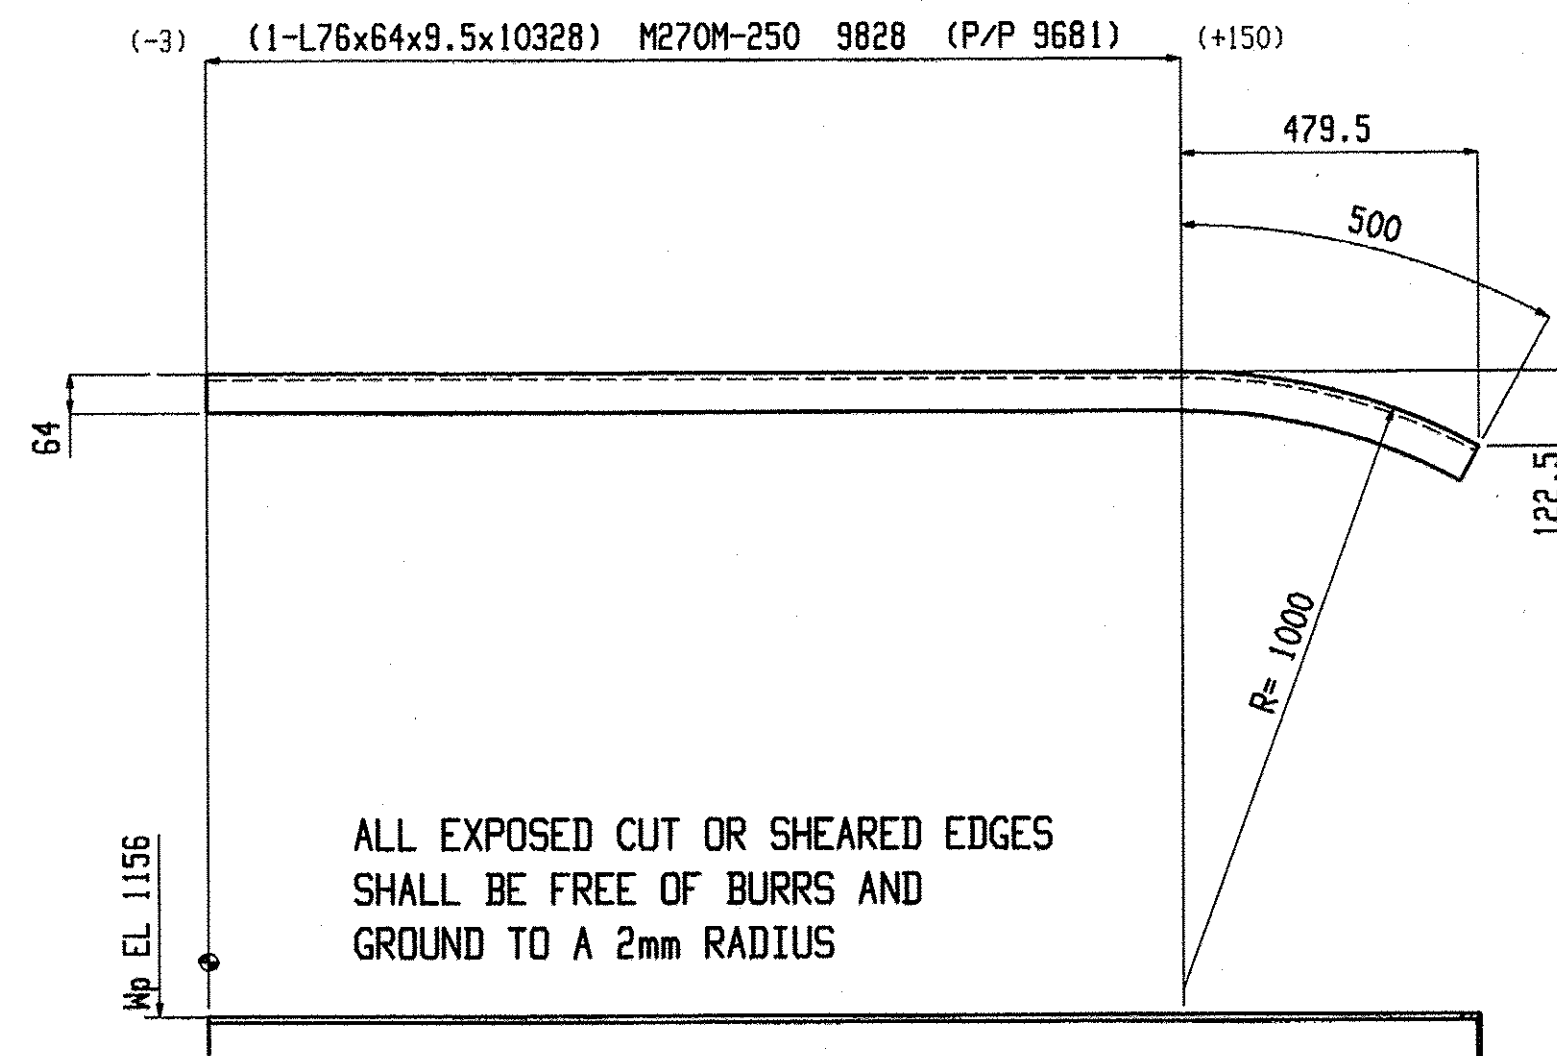


ONE BEAM R27

SHOP NOTE:
TOE DIRECTION NEAR SIDE

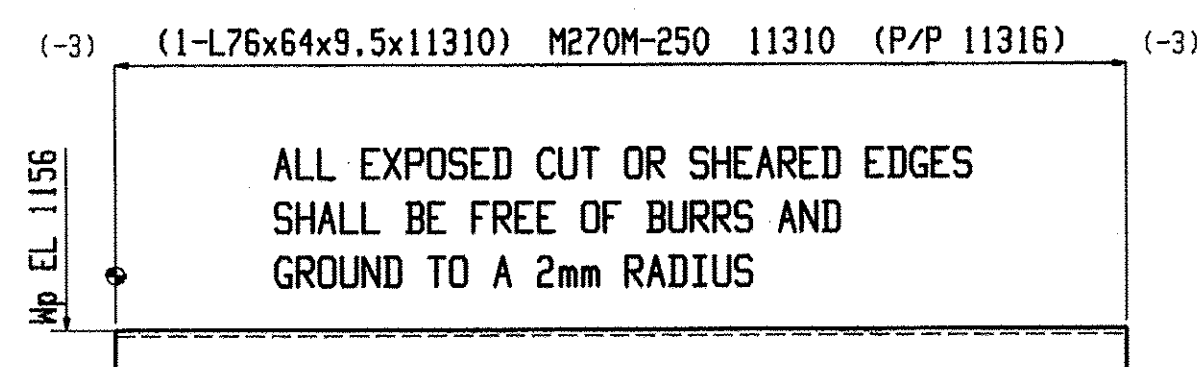


ONE BEAM R30

SHOP NOTE:
TOE DIRECTION FAR SIDE

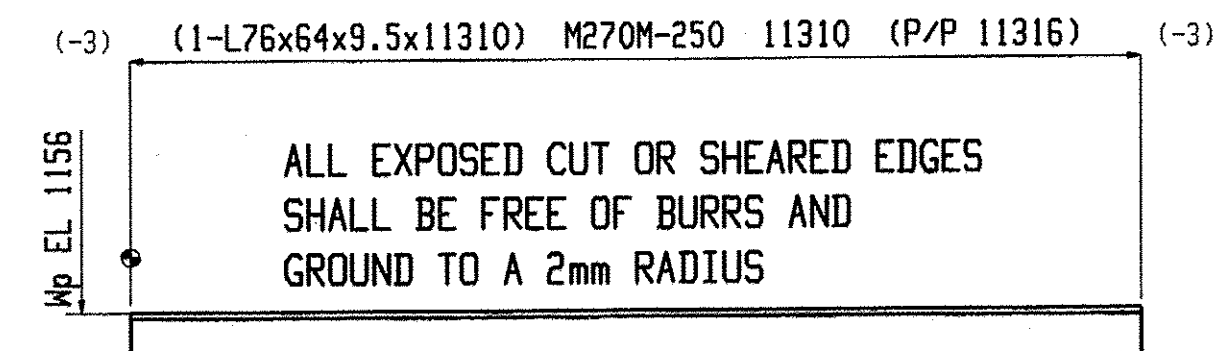


ONE BEAM R25

SHOP NOTE:
TOE DIRECTION NEAR SIDE

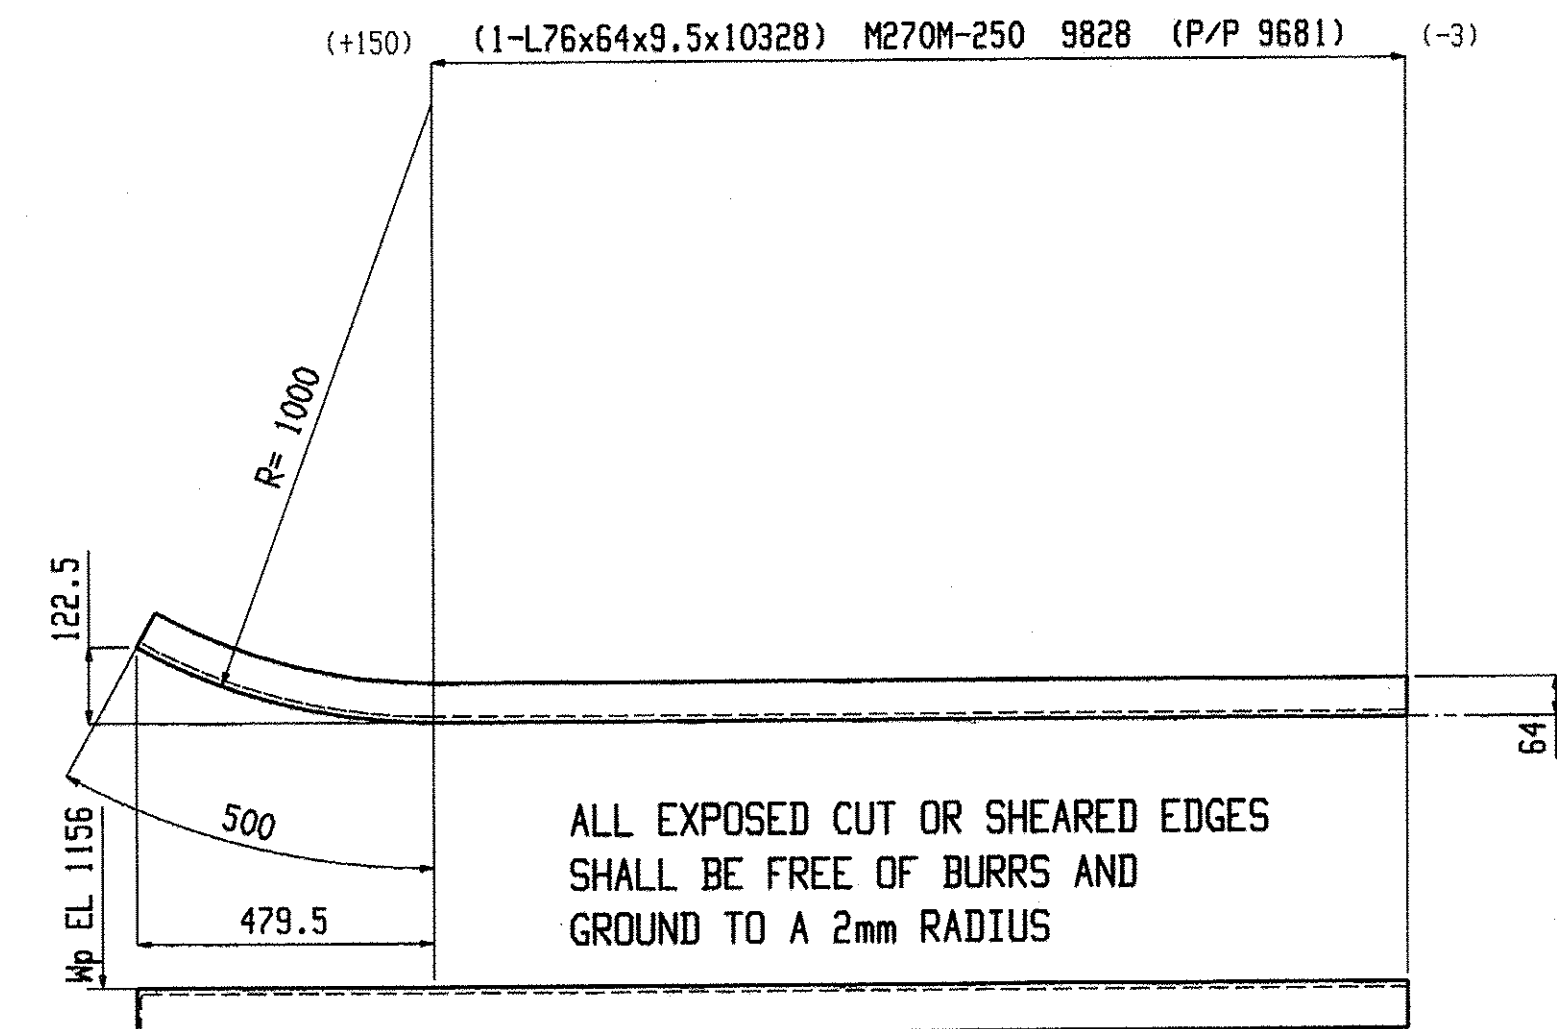

ONE BEAM R28

SHOP NOTE:
TOE DIRECTION FAR SIDE

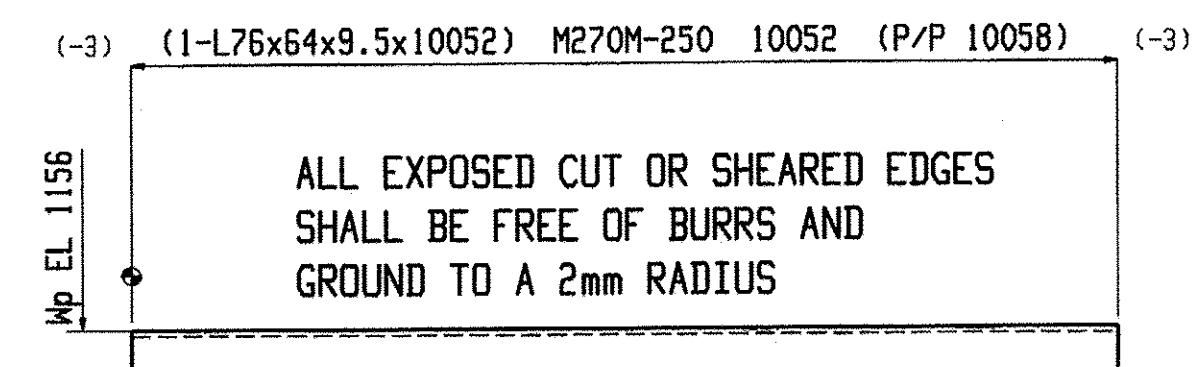

ONE BEAM R31

SHOP NOTE:
TOE DIRECTION FAR SIDE

Nov 05 2009 10:55:52 AM

Nov 06 2008 10:55:52 AM

BILL OF MATERIAL									BILL OF MATERIAL									BILL OF MATERIAL								
Qty	Piece			Seq	Seq	Adv	Steel		Qty	Piece			Seq	Seq	Adv	Steel		Qty	Piece			Seq	Seq	Adv	Steel	
Tot.	Mark	Description	Length	NO.	Qty	ABM #	Grade	Remarks	Tot.	Mark	Description	Length	NO.	Qty	ABM #	Grade	Remarks	Tot.	Mark	Description	Length	NO.	Qty	ABM #	Grade	Remarks
ONE	R23	BEAM		2	1				ONE	R26	BEAM		2	1				2	R29	BEAM		2	2			
1	R23	L76x64x9.5	10328				M270M-250		1	R26	L76x64x9.5	10052				M270M-250		2	R29	L76x64x9.5	10053				M270M-250	
2	R24	BEAM		2	2				ONE	R27	BEAM		2	1				ONE	R30	BEAM		2	1			
2	R24	L76x64x9.5	10053				M270M-250		1	R27	L76x64x9.5	10328				M270M-250		1	R30	L76x64x9.5	11310				M270M-250	
ONE	R25	BEAM		2	1				ONE	R28	BEAM		2	1				ONE	R31	BEAM		2	1			
1	R25	L76x64x9.5	11310				M270M-250		1	R28	L76x64x9.5	10328				M270M-250		1	R31	L76x64x9.5	10052				M270M-250	

Total weight : 1110

Fabrication is not to be done by Renaud Bros. Have fabricator resubmit with name of fabricator on the drawings.

Renaud Bros. Inc.		Holes: 21mm UNF	
283 Fort Bridgeman Rd. #2		BOLTS: 19mm DIA. M16M-1 GALV UNF	
Vernon, VT. 05354		Steel GR: M270M-GR345 UNF	
Phone 1-802 257-7383		Paint: PER SPECS (GREEN) UNF	
Rev.No:	Date:	Surface Prep:	PER SPECS
Project: DUMMERSTON BRIDGE		Job No. BHO 1442 (28)	
DUMMERSTON, VT		Sheet No. 24	
DWN. BY: EG	Checked: MRS		