
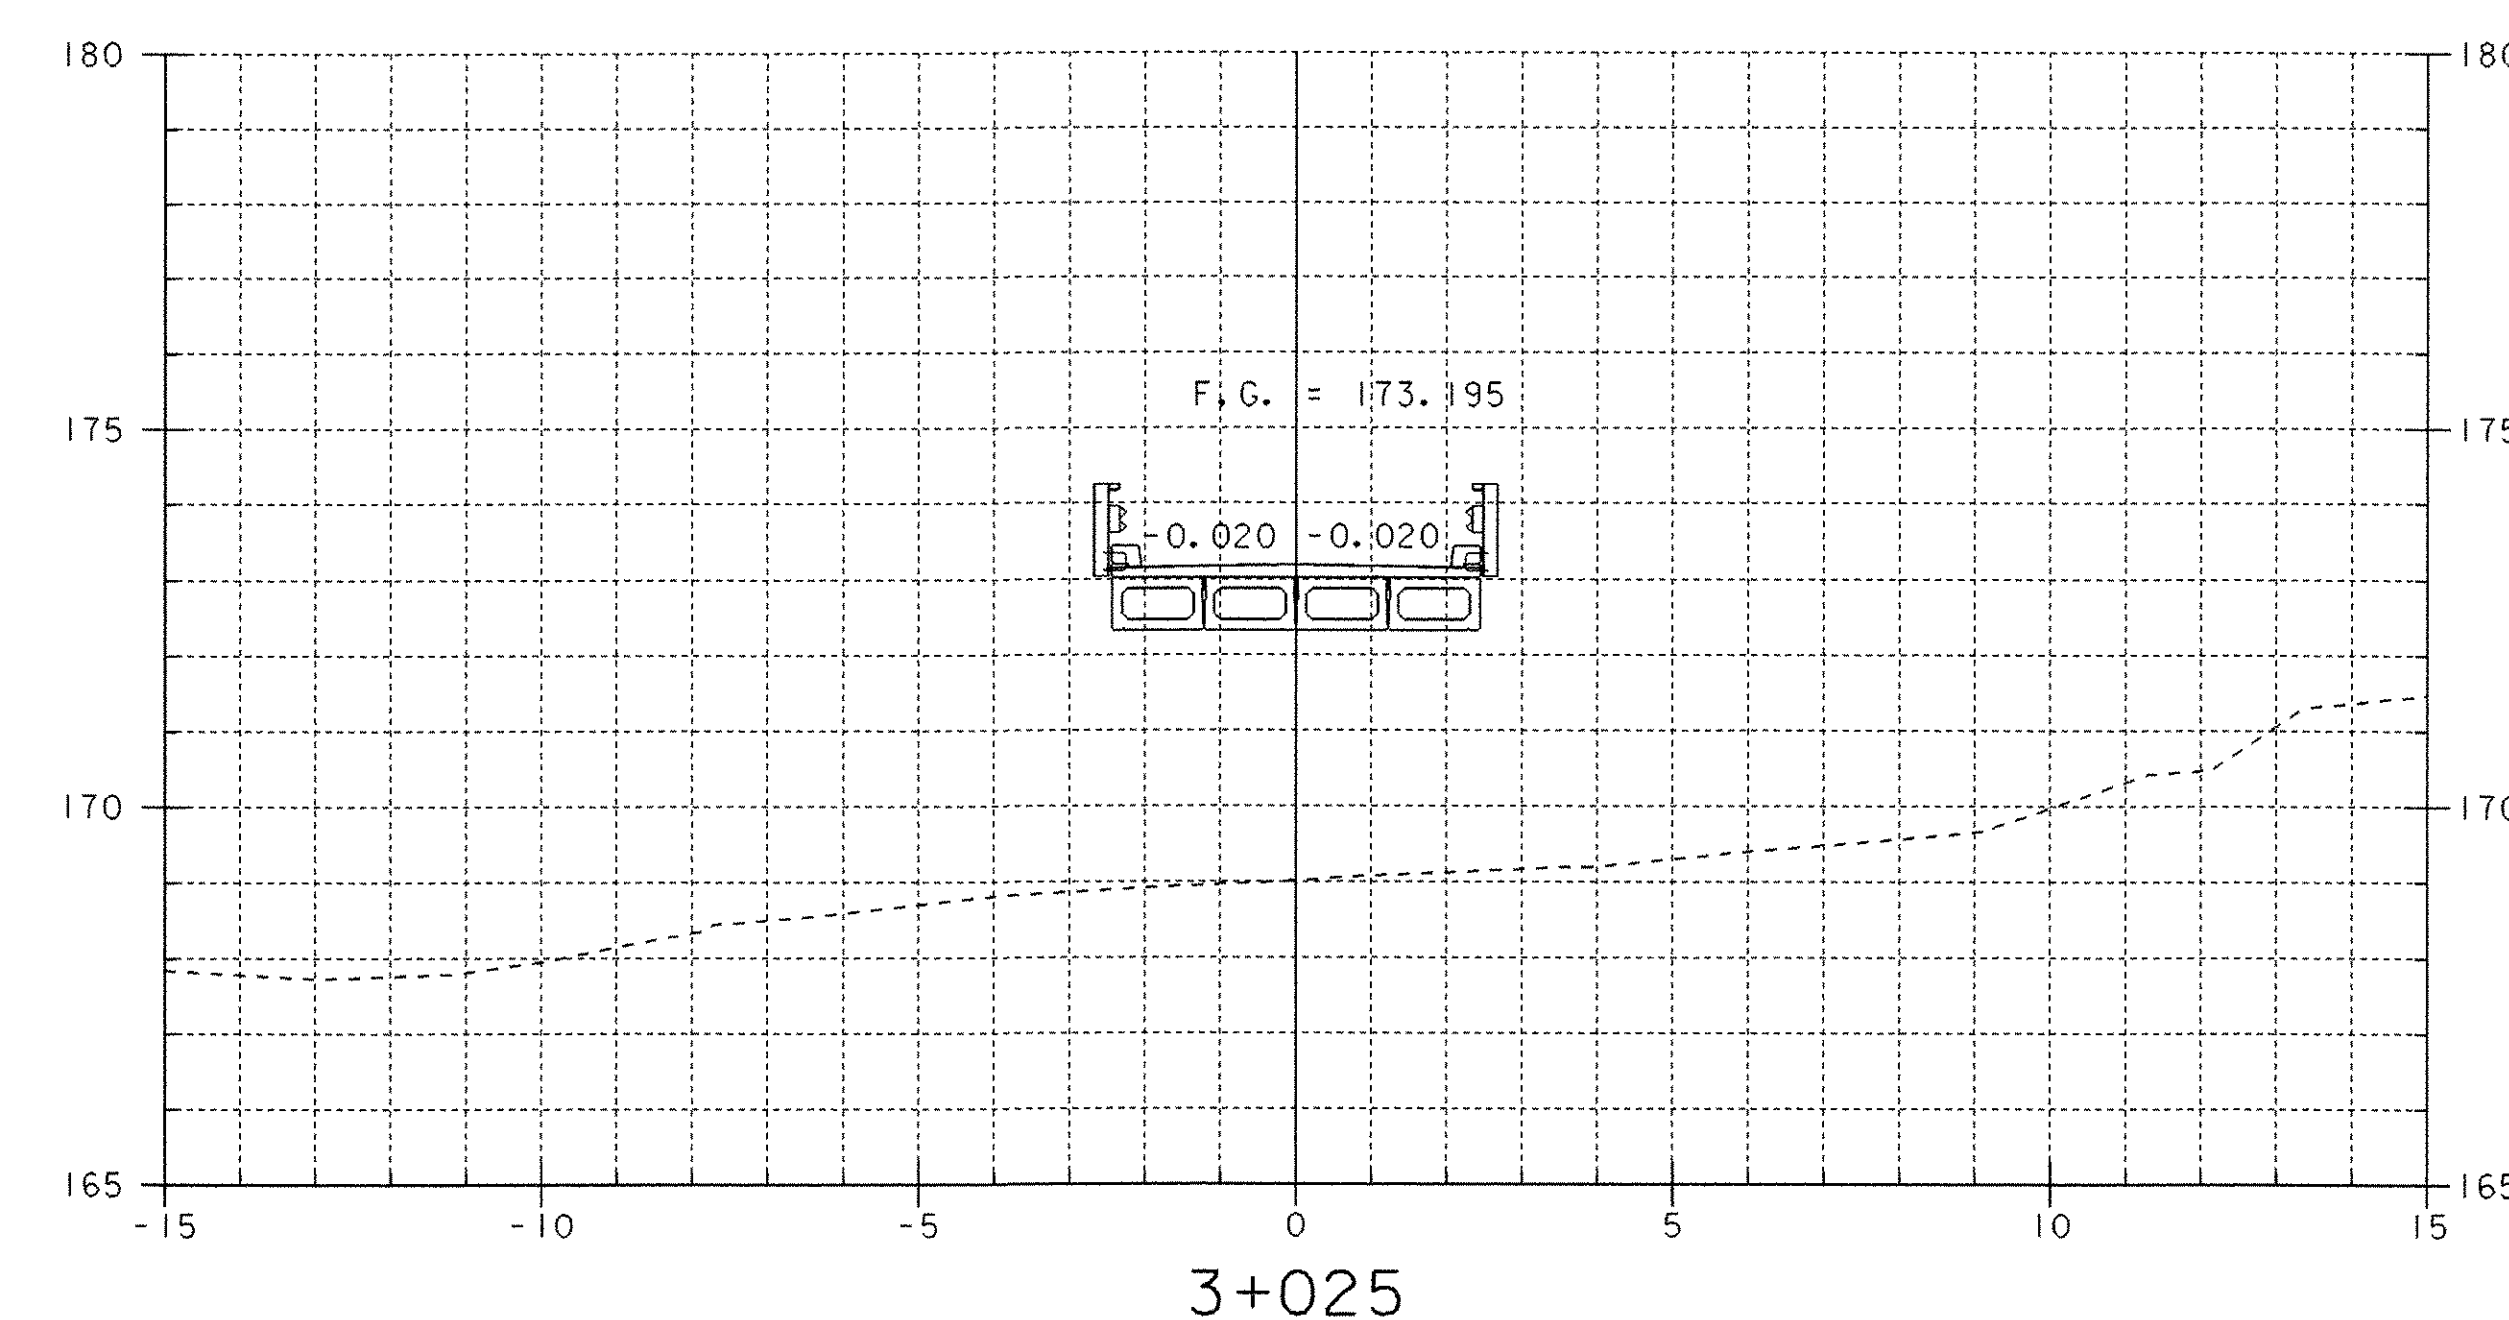
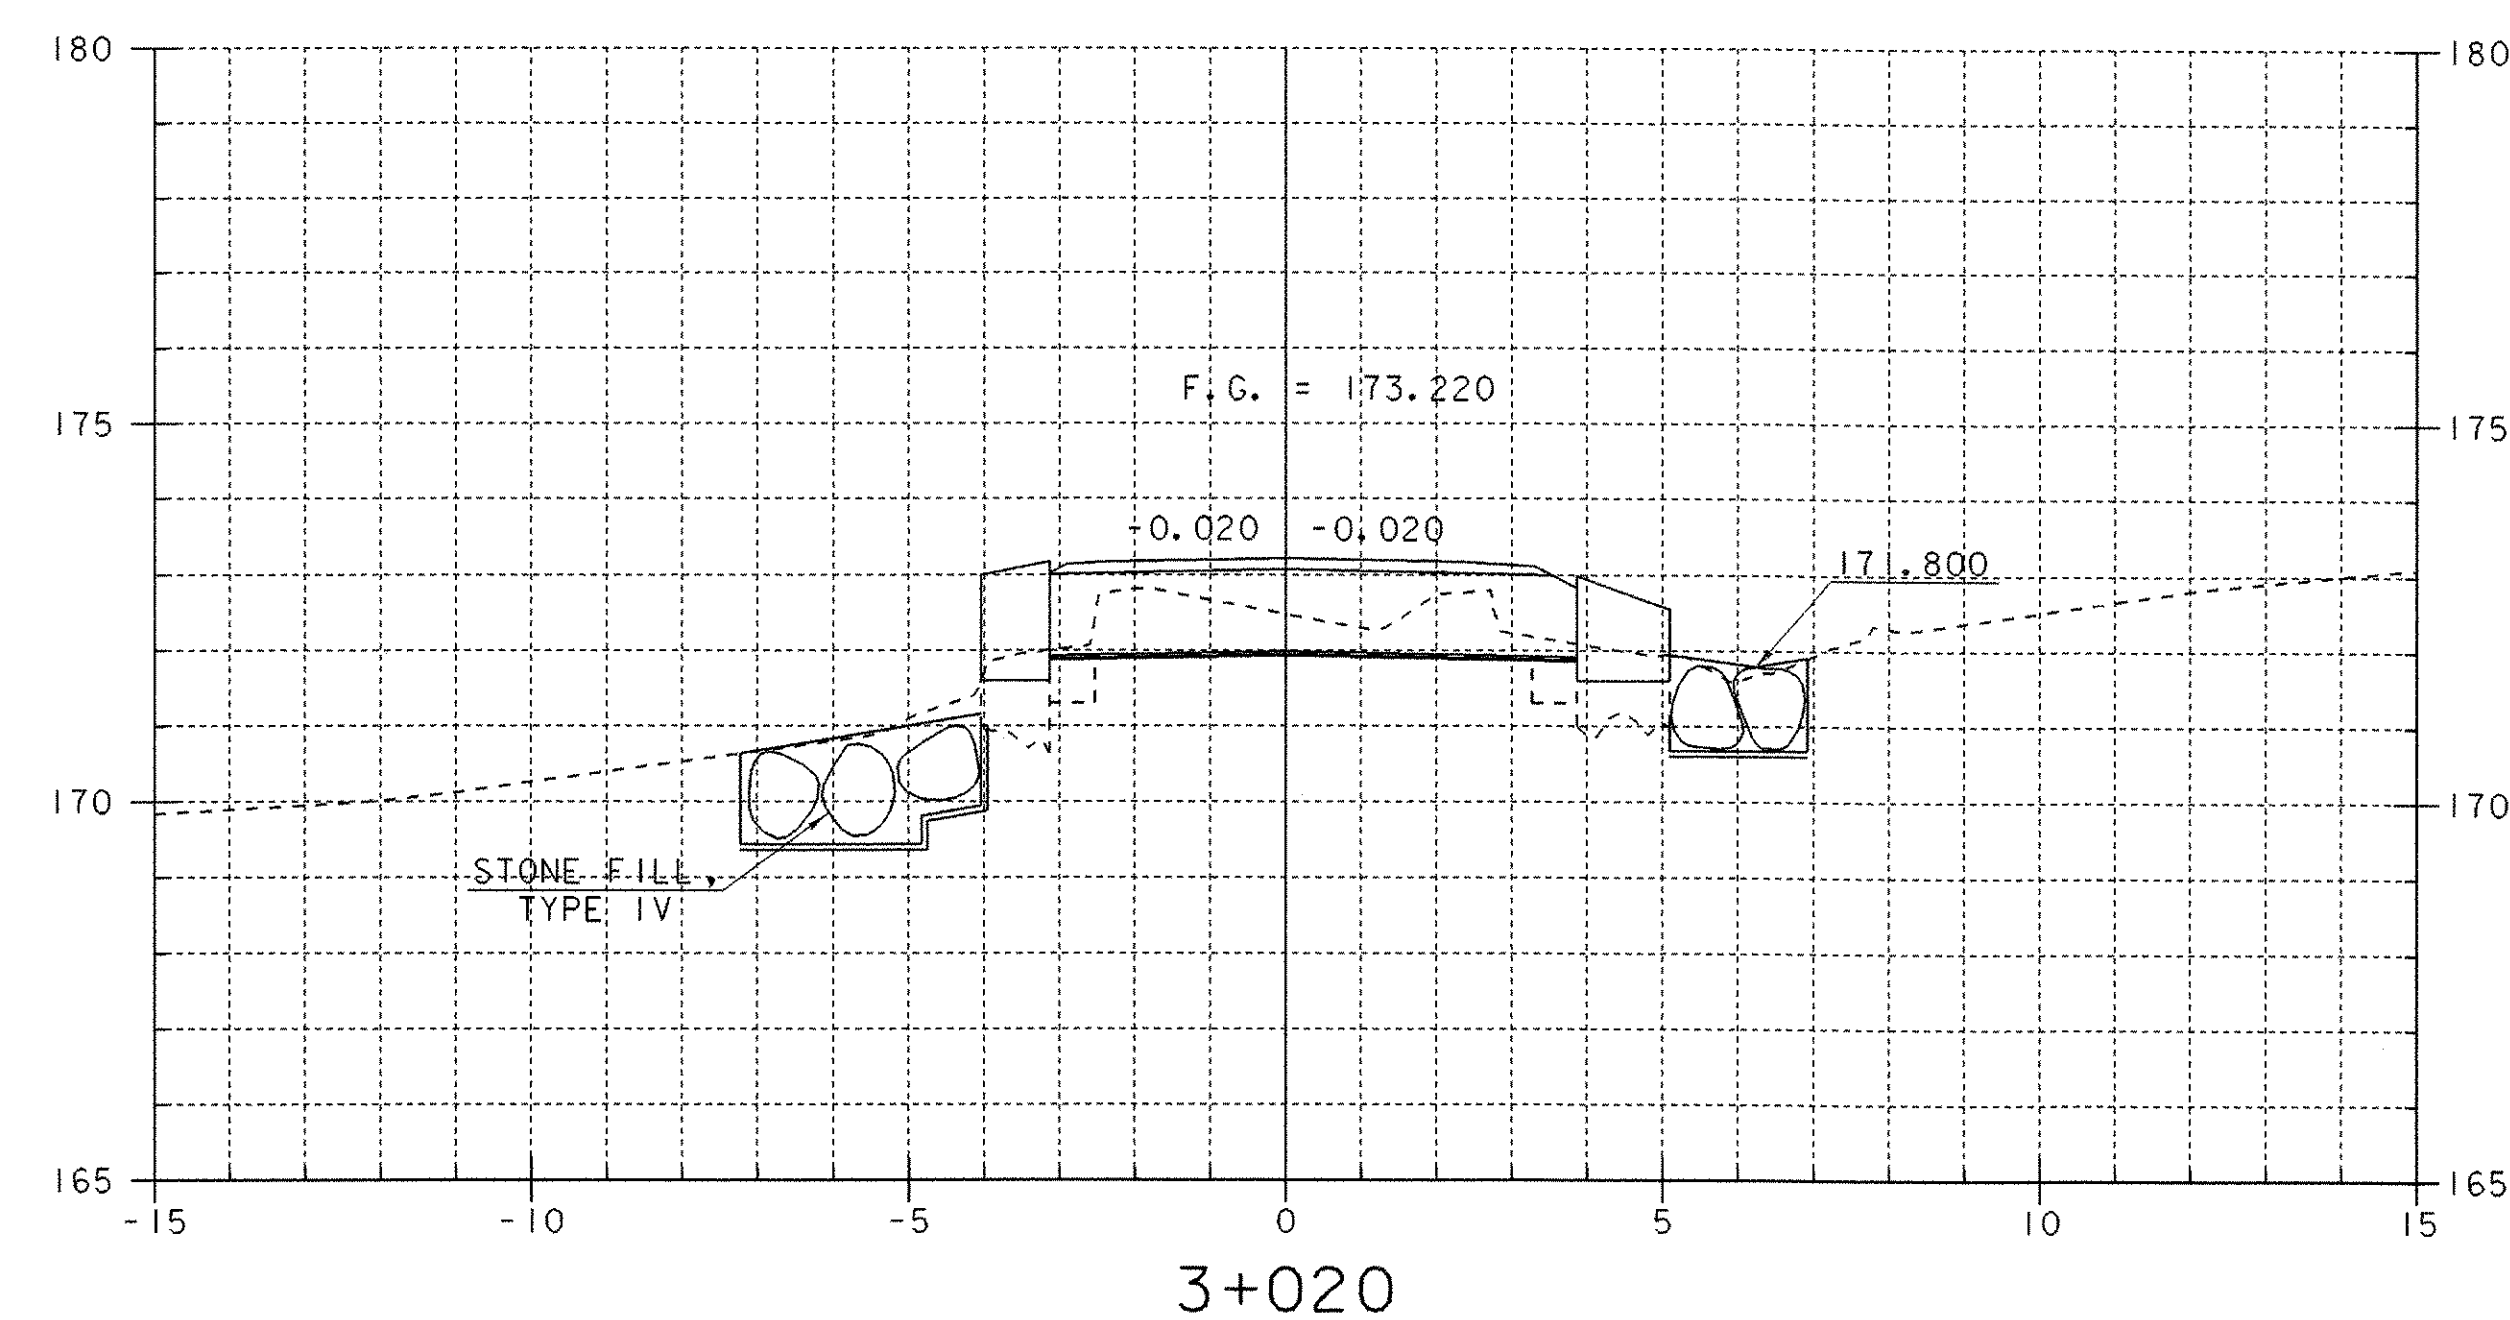
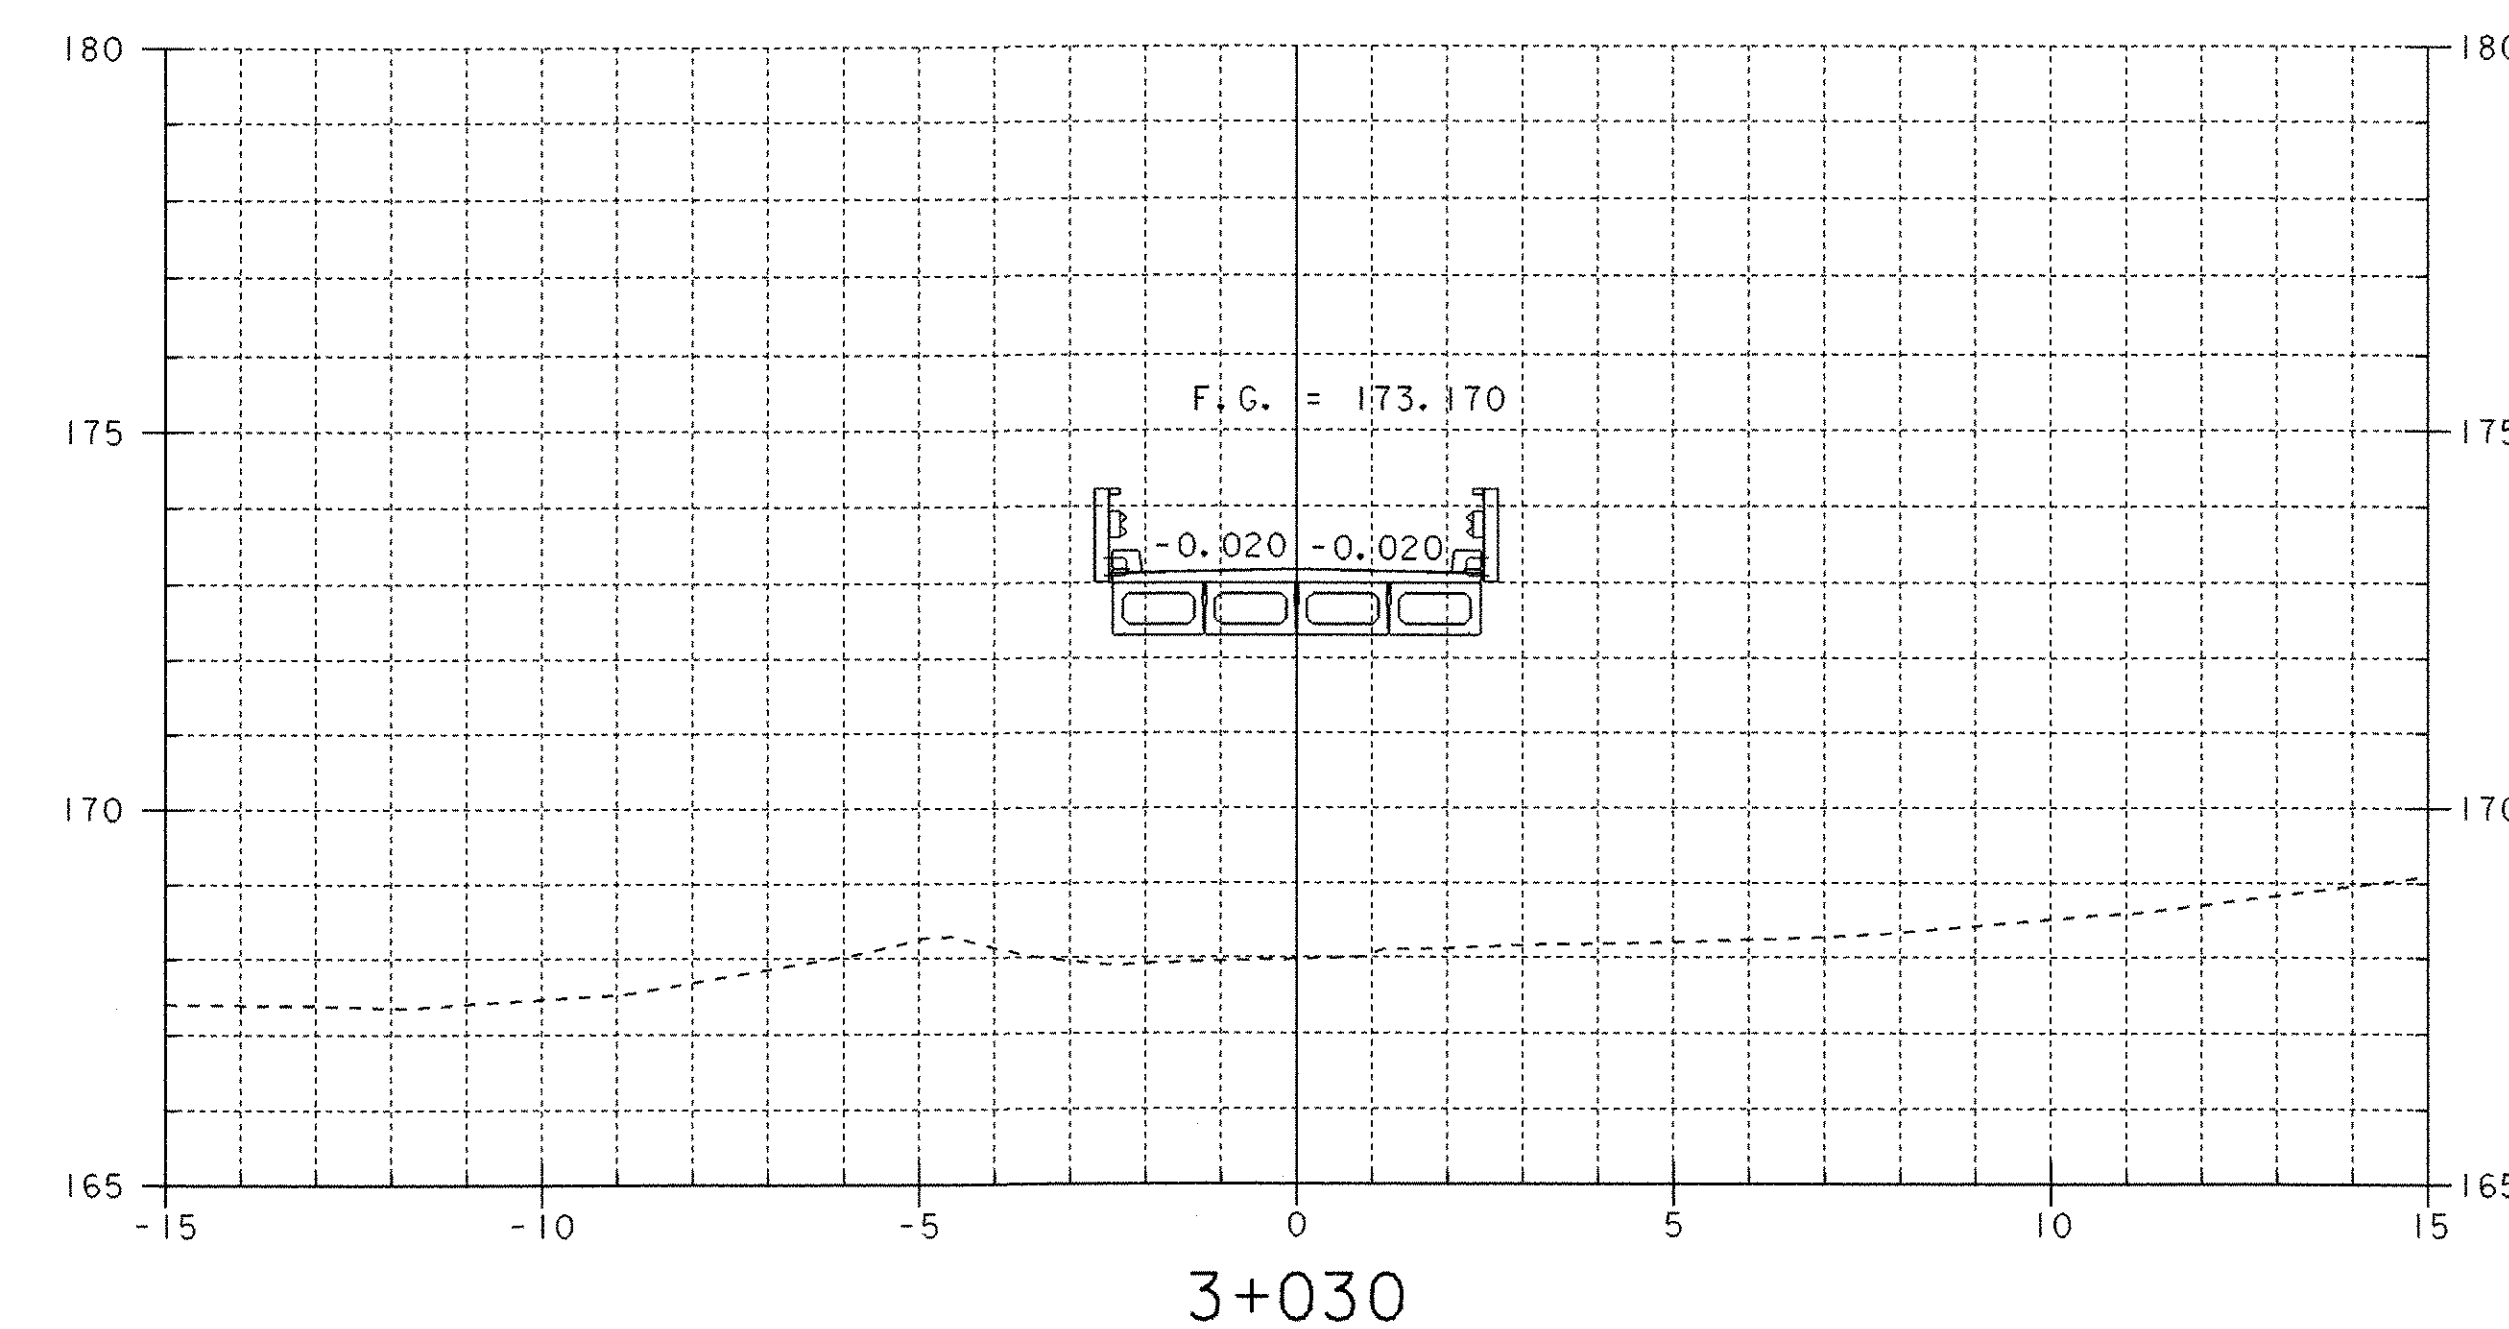


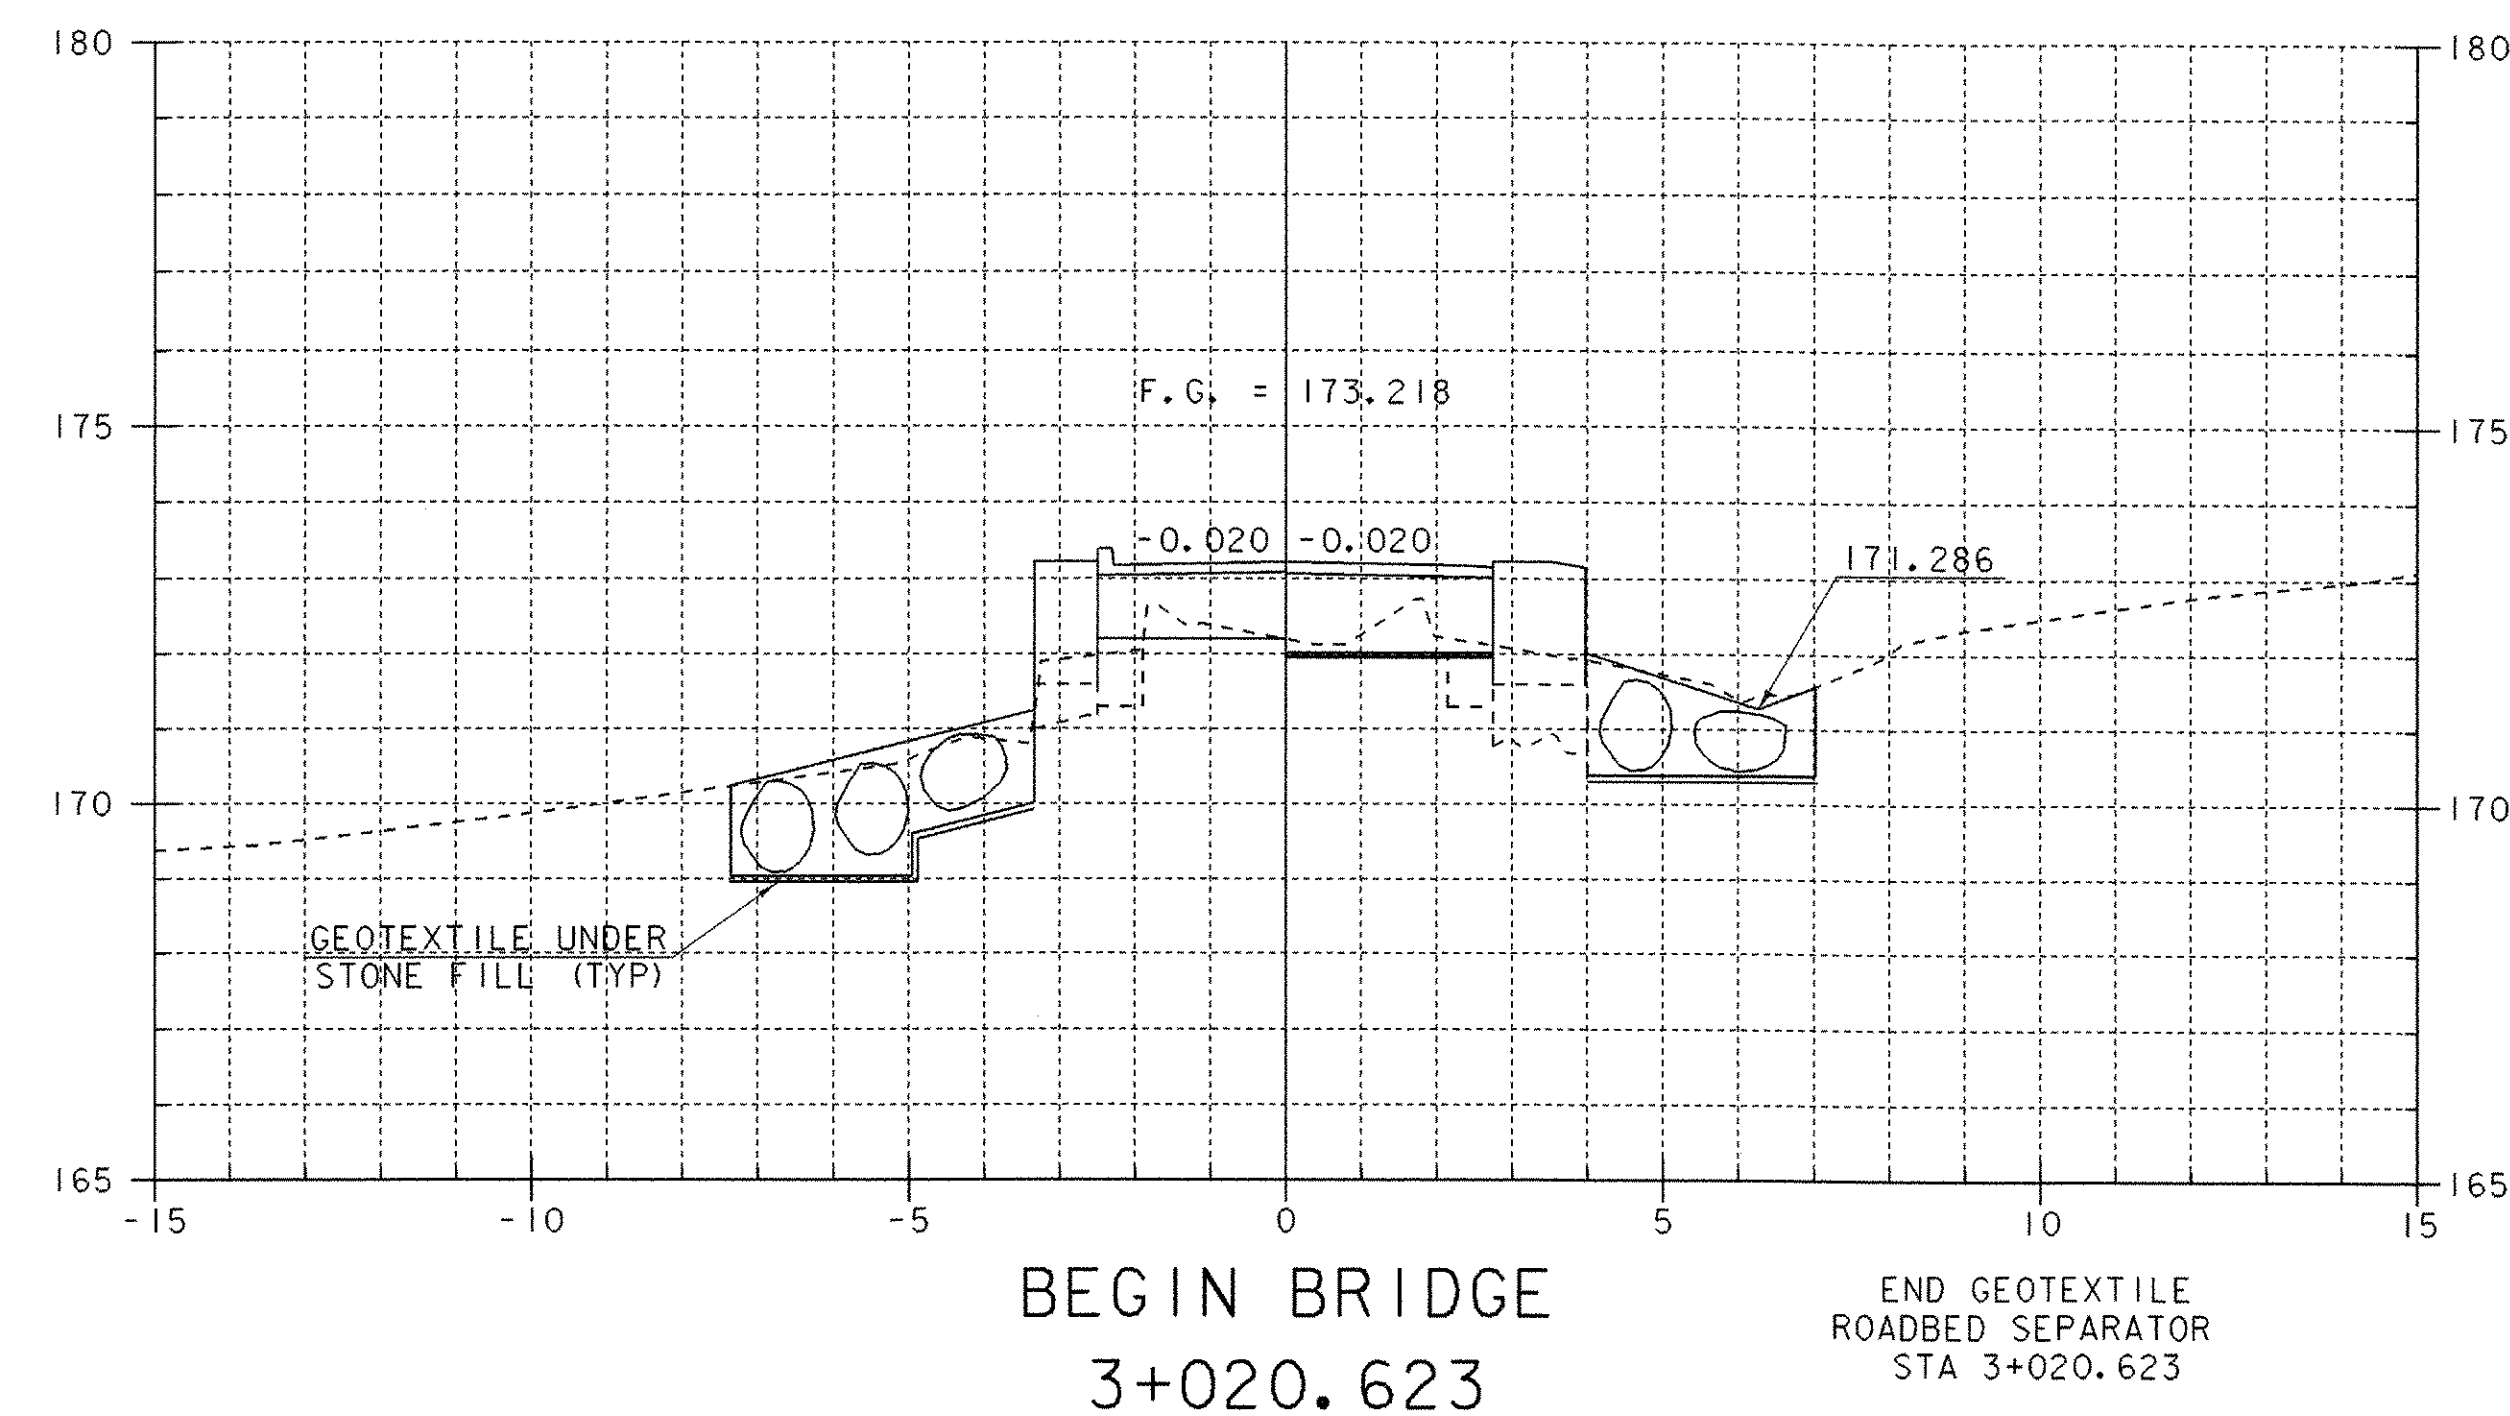

SHEET NAME: MAINLINE CROSS SECTIONS		
PROJECT NAME: WALLINGFORD	HIGHWAY NO.: TH 60	
PROJECT NUMBER: BRO 1443(3I)	BRIDGE NO.: 50	
	OVER: OTTER CREEK	
FILE NAME: /PW/94j084/sj084xs.dgn	PLOT DATE: 24-OCT-2005	
PROJECT MANAGER: R. WHITCOMB	DRAWN BY: K. UPMAL	
DESIGNED BY: K. UPMAL	IPARM NAME: sj084mx2.1	
BRIDGE SHEET NUMBER:	SHEET 32 OF 38	