




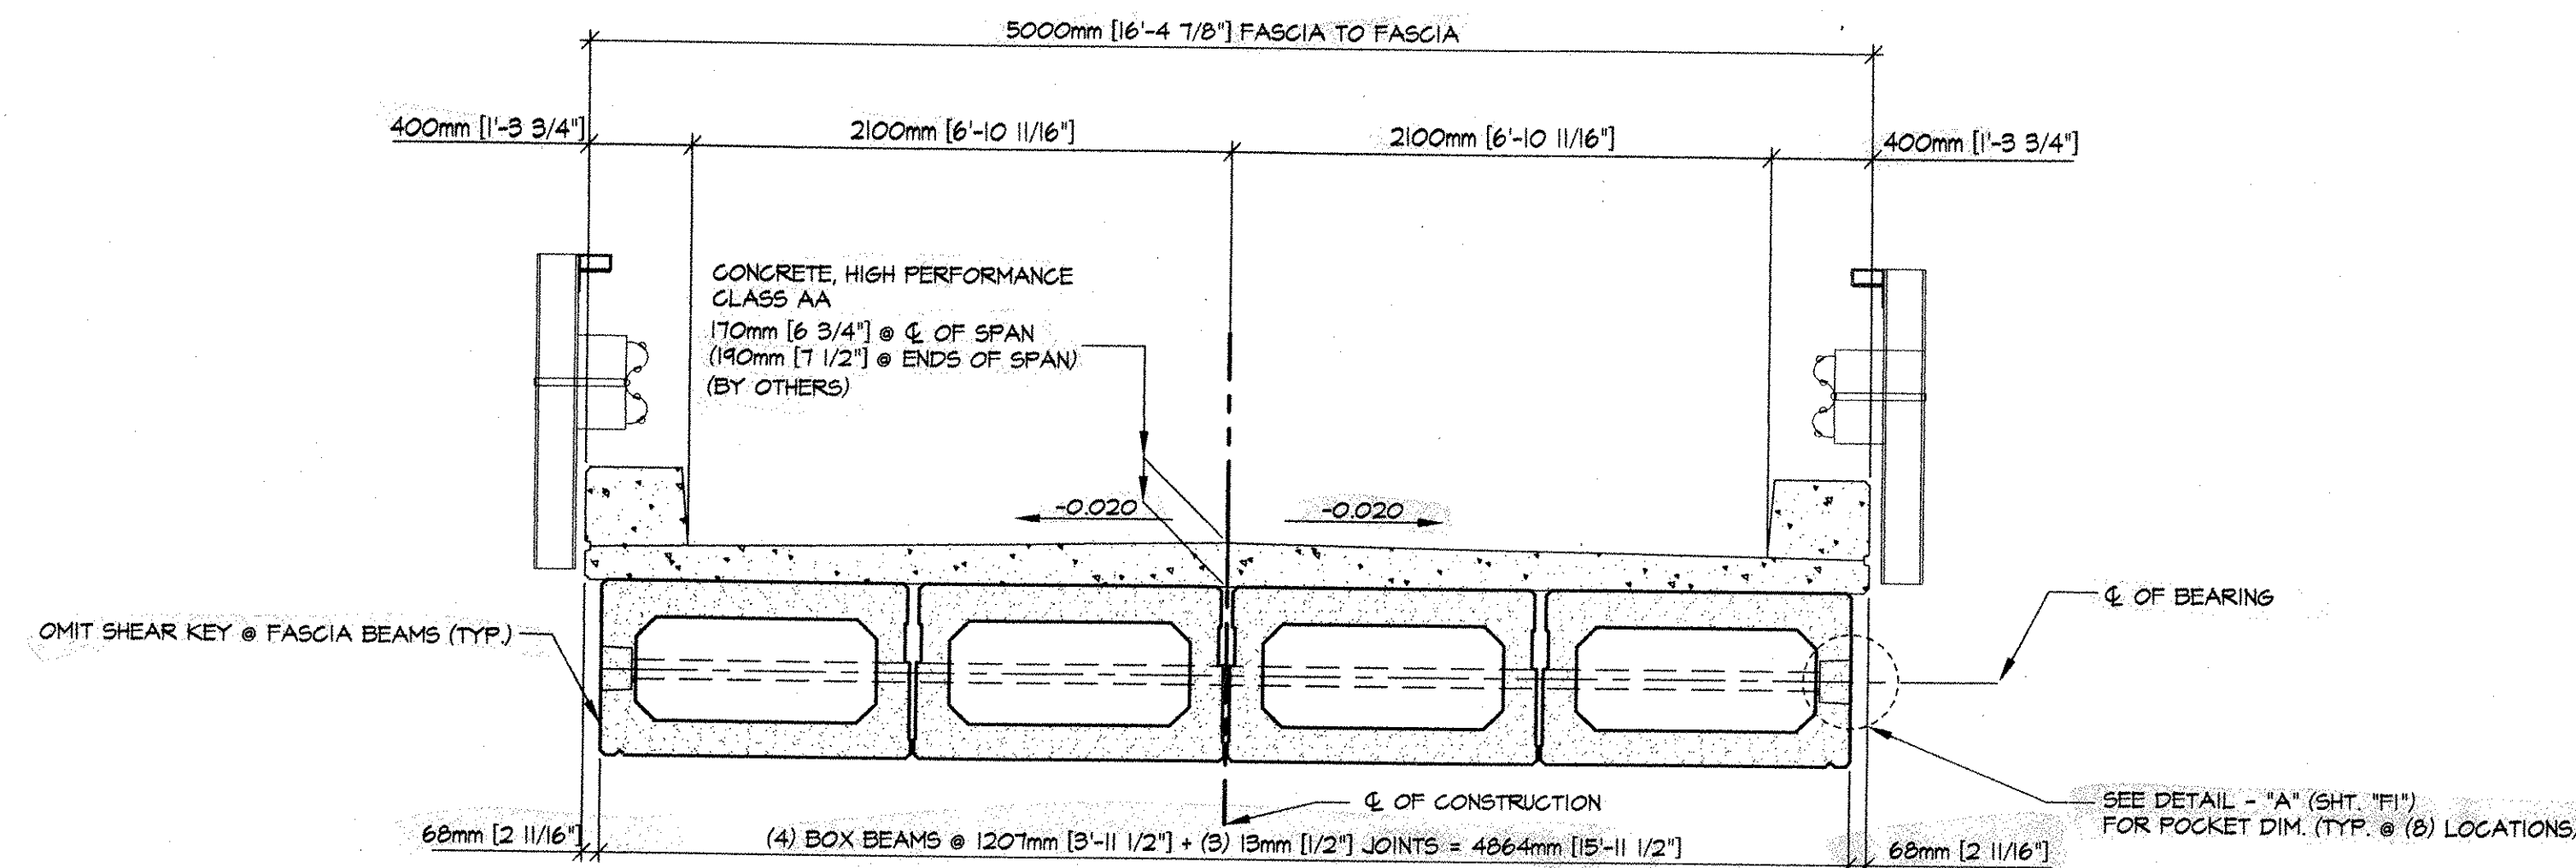


2 TRANSVERSE SECTION
F2 1:25

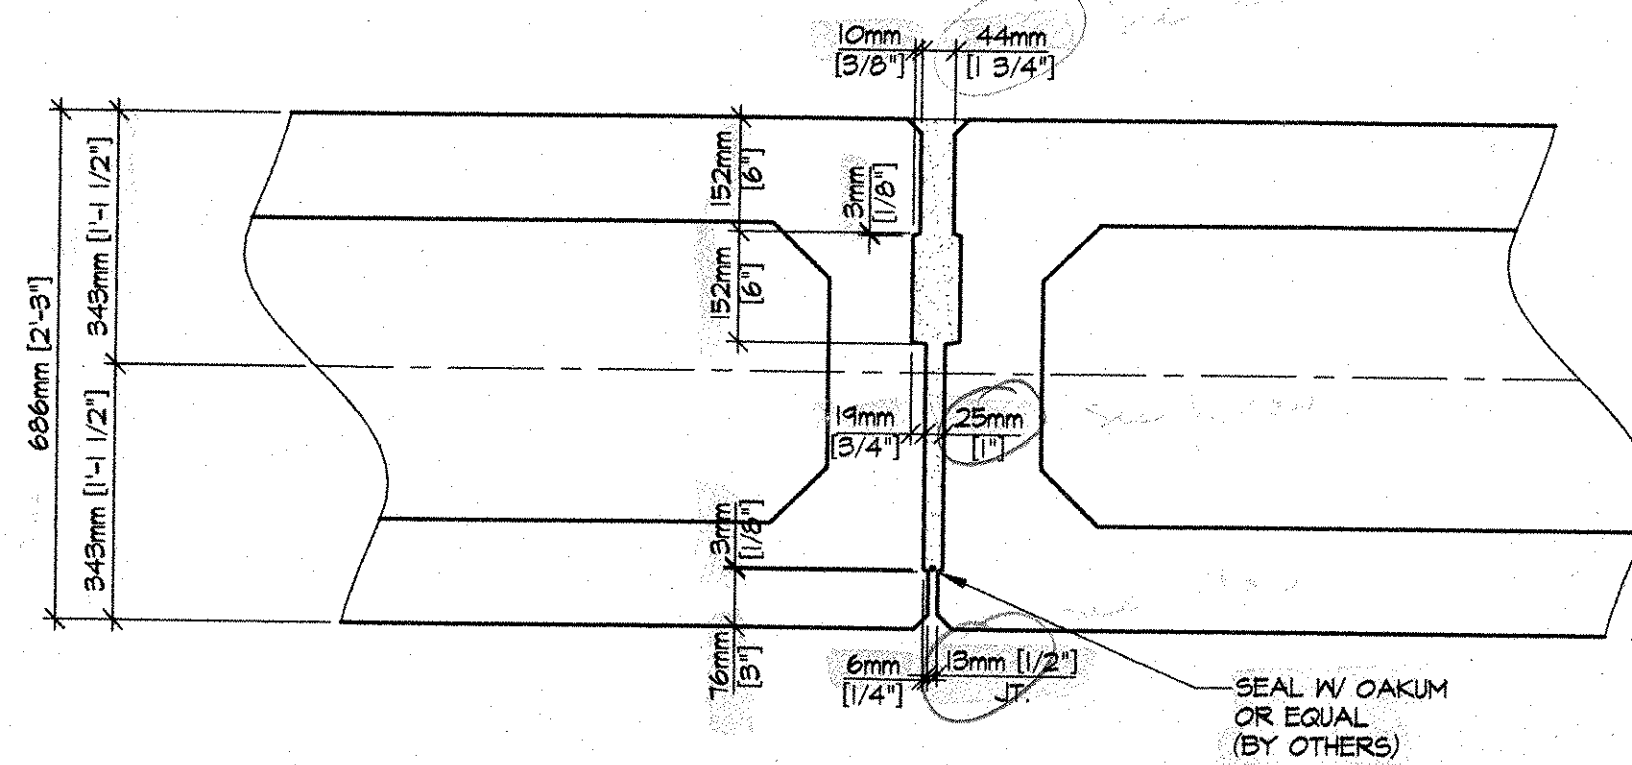


C TYP. SHEAR KEY SECTION
F2 1:10

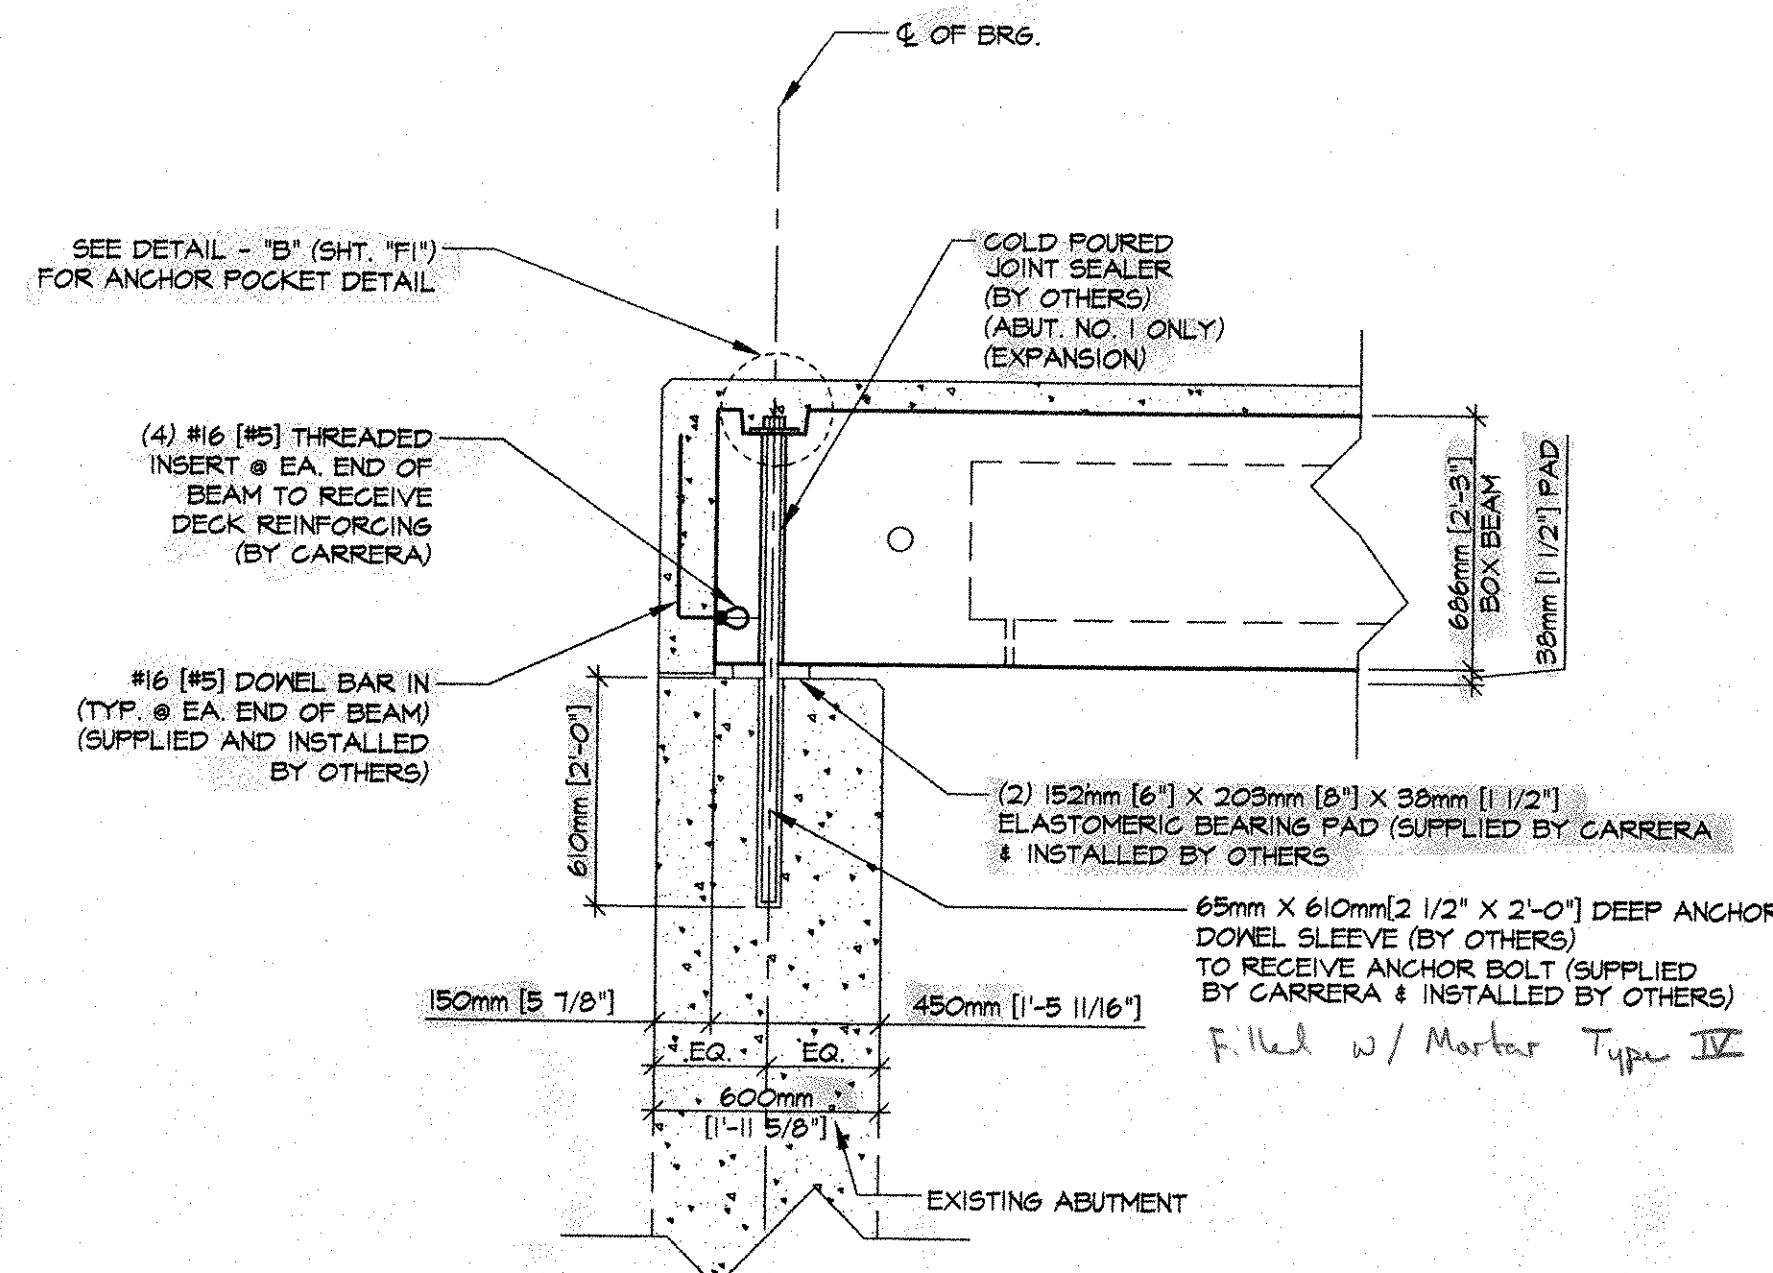


A SECTION AT BEARING (EXPANSION)
F2 1:20

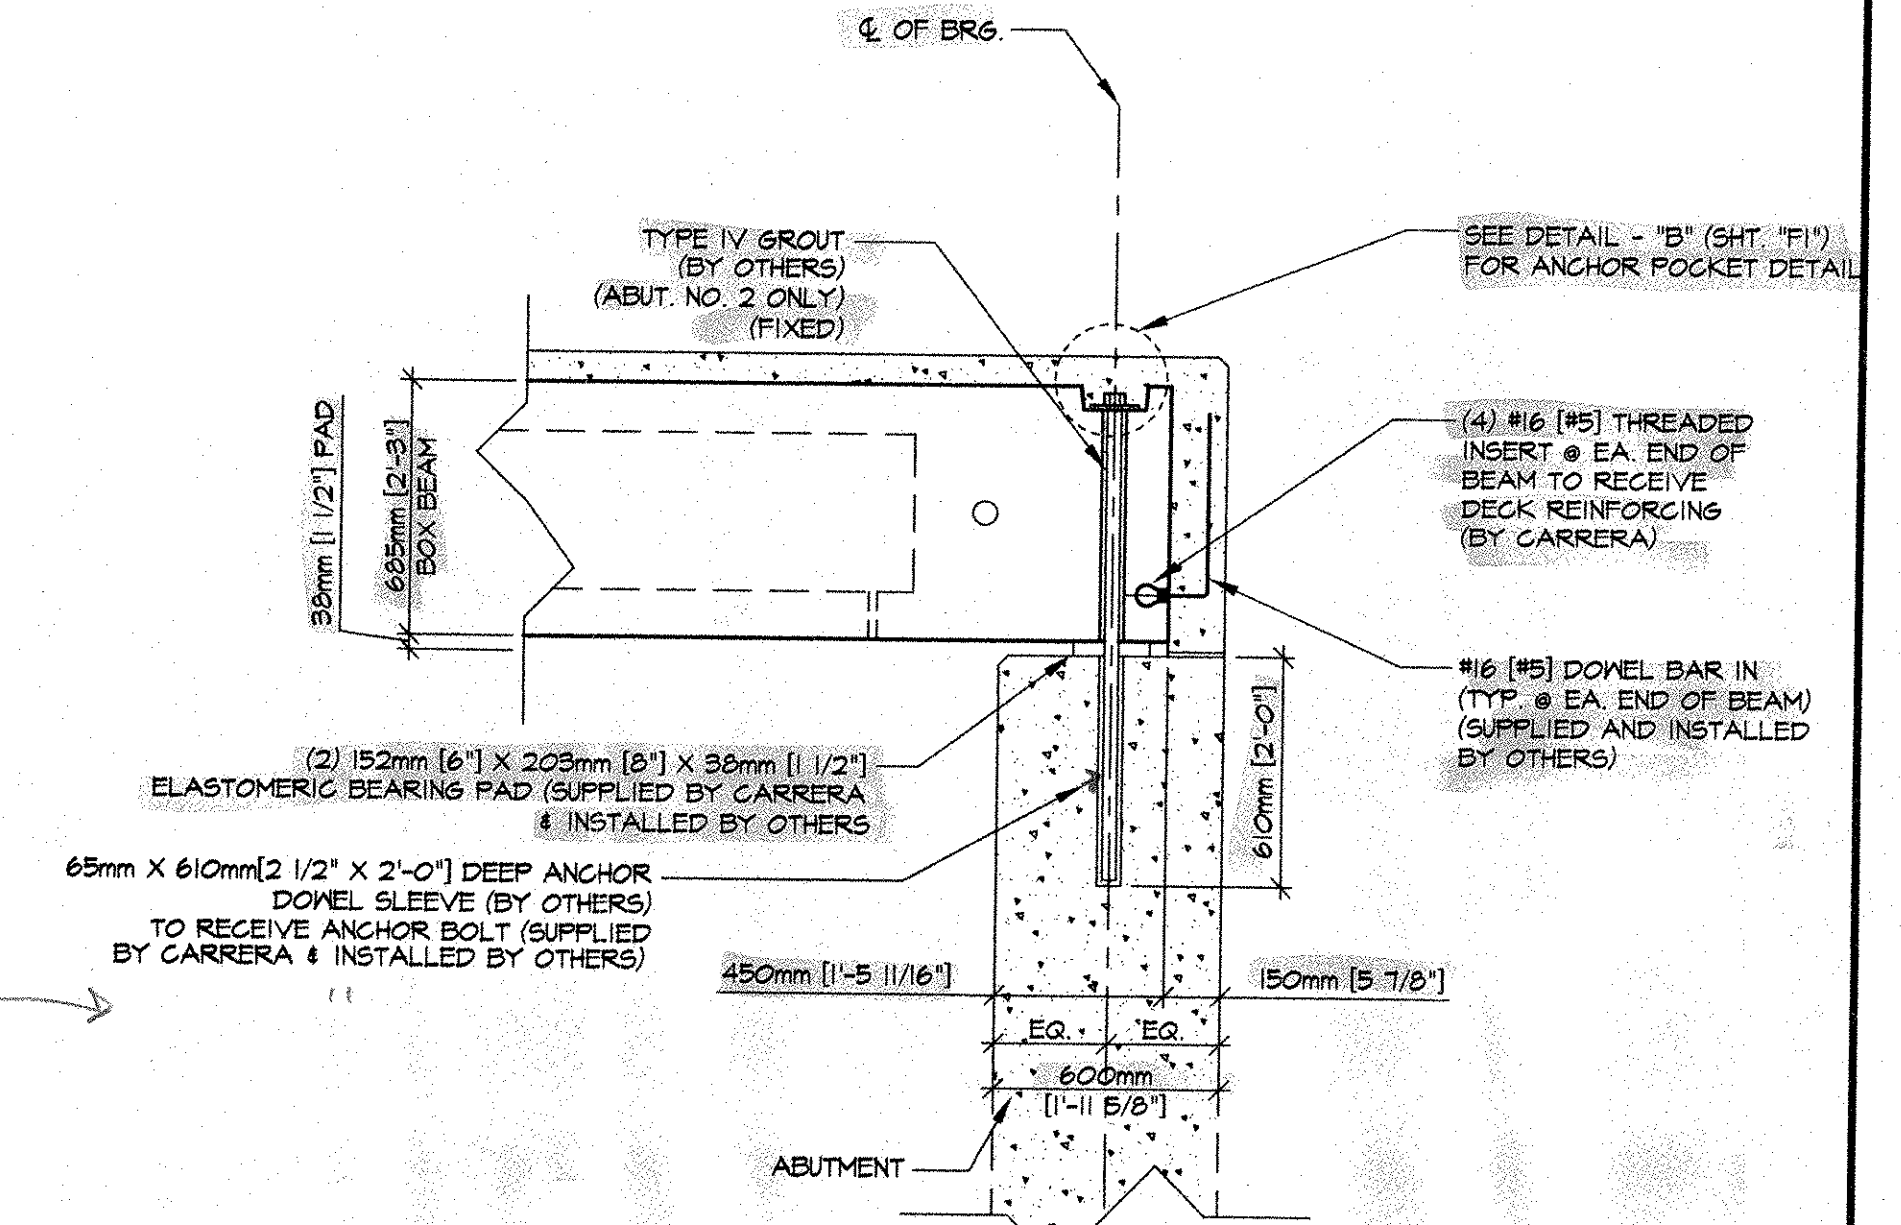

B SECTION AT BEARING (FIXED)
F2 1:20

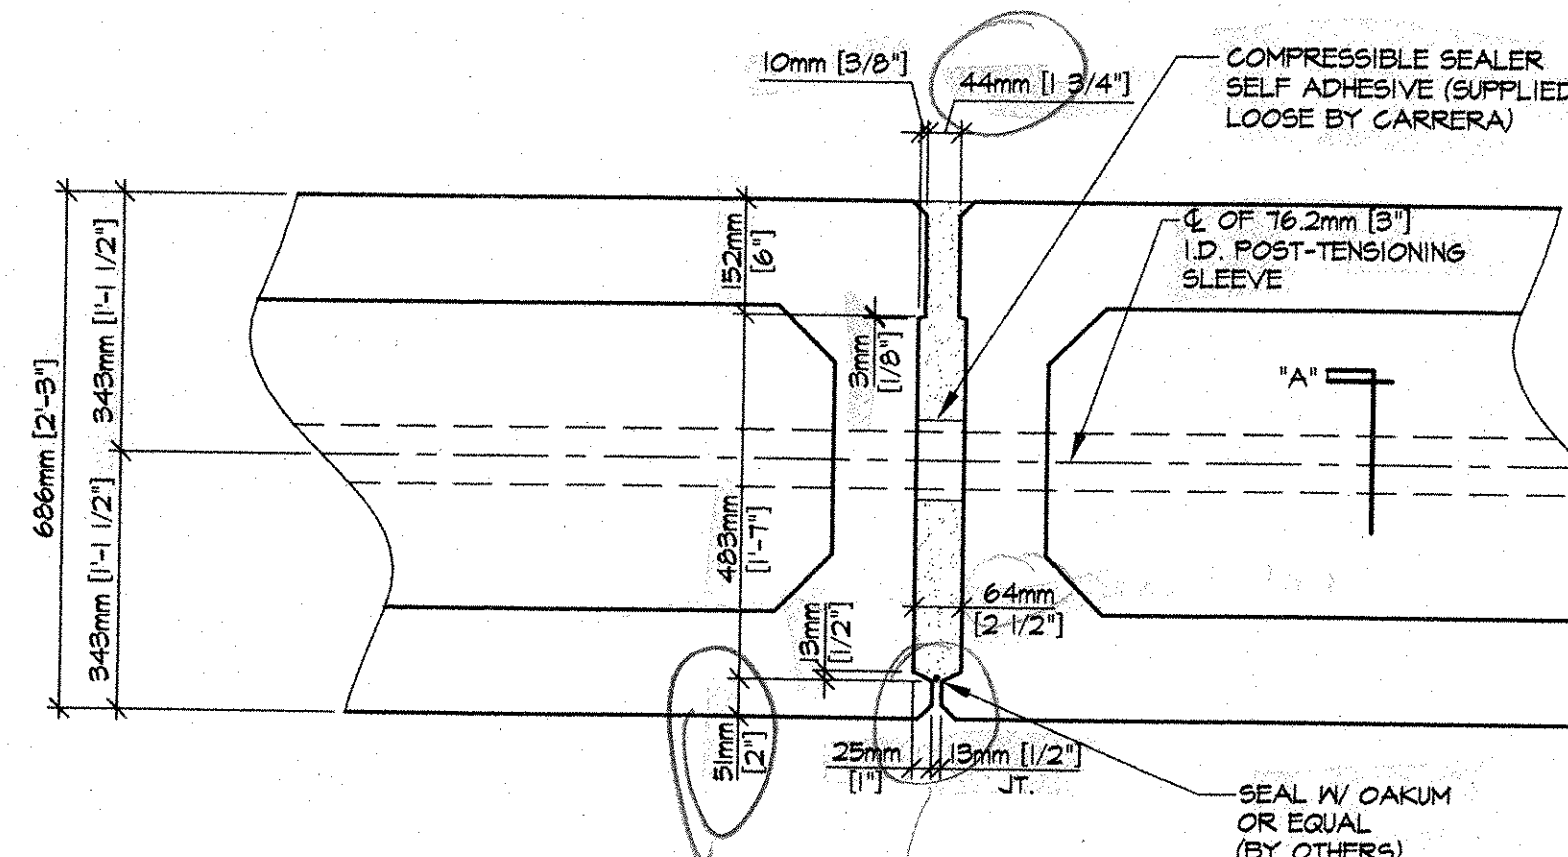

D SHEAR KEY SECTION @ P.T. SLEEVE
F2 1:10

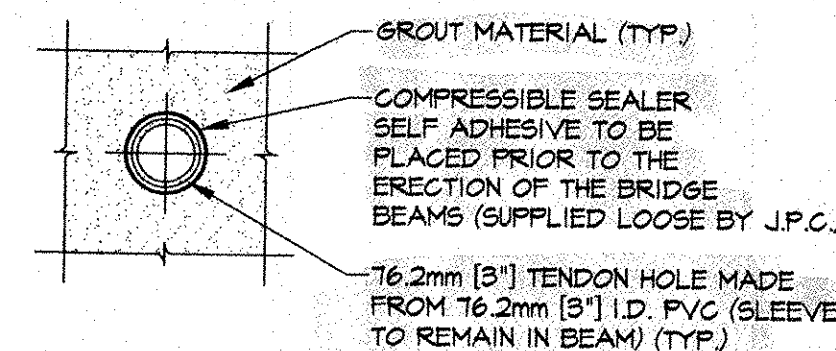

SECTION "A"
1:10

APPROVAL STAMP:		J.P. CARRARA & SONS INC. Precast & Prestress Manufacturer 2464 CASE ST., MIDDLEBURY, VERMONT 05753 Phone: (802) 388-6361 Fax: (802) 388-9010		ALPINE CONSTRUCTION, LLC CONTRACTOR SCHUYLERVILLE, NY	
RECEIVED OK'D BY: <i>[Signature]</i> OK'D BY: <i>[Signature]</i> MAR 17 2006 RESUBMIT: <i>[Signature]</i> APPROVED: <i>[Signature]</i> BY: <i>[Signature]</i> DATE: 4.6.06		STATE OF VERMONT A.O.T. COUNTY OF RUTLAND TOWN OF WALLINGFORD PROJECT NUMBER: BRD 1448(B1) TH 60, CLASS 3 (LOCAL BRIDGE), BRIDGE NO. 50		DATE: FEB. 14, 2006 SCALE: NOTED CHKD: B.L. DFTM: B.J.B. JOB NO: 23235-06	
SUPERSTRUCTURE SECTION & DETAILS				DWG. NO: F2 040 PCC	