



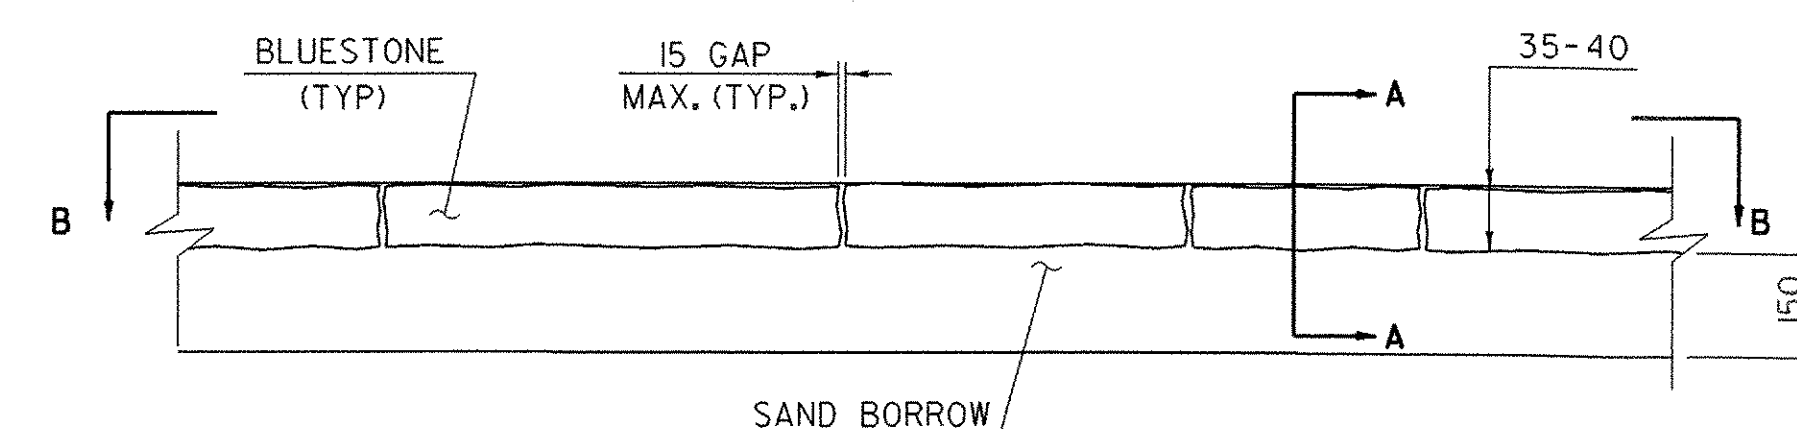


SPECIAL WALKWAY @ STA. I+129.6 RT. DETAIL
NTS

LABOR AND MATERIALS FOR SPECIAL WALKWAY SHALL BE PAID
FOR UNDER ITEM 618.10, "PORTLAND CEMENT CONCRETE SIDEWALK, 125 mm (MOD.)"



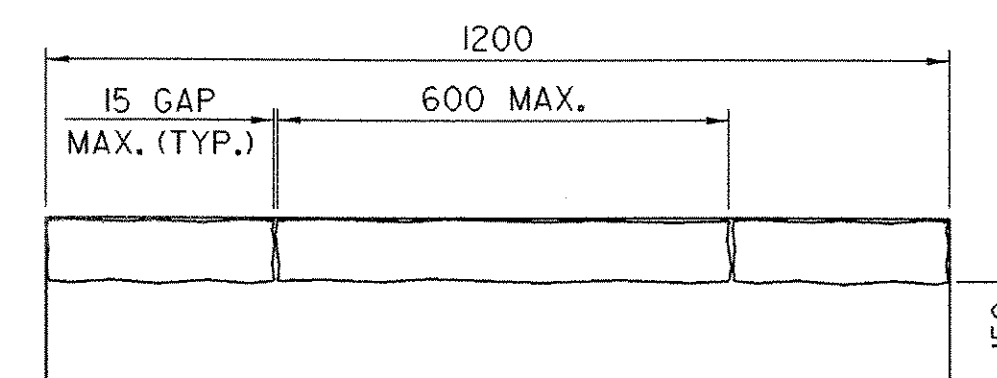


SECTION A-A
NTS

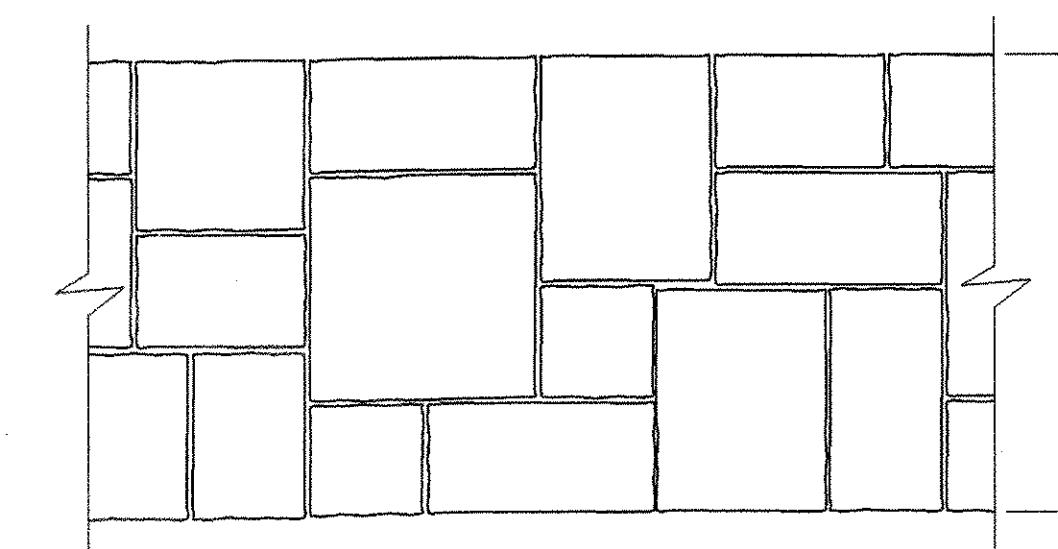


SECTION B-B
NTS

GAPS BETWEEN BLUESTONES TO
BE FILLED IN WITH STONE DUST FILLER.

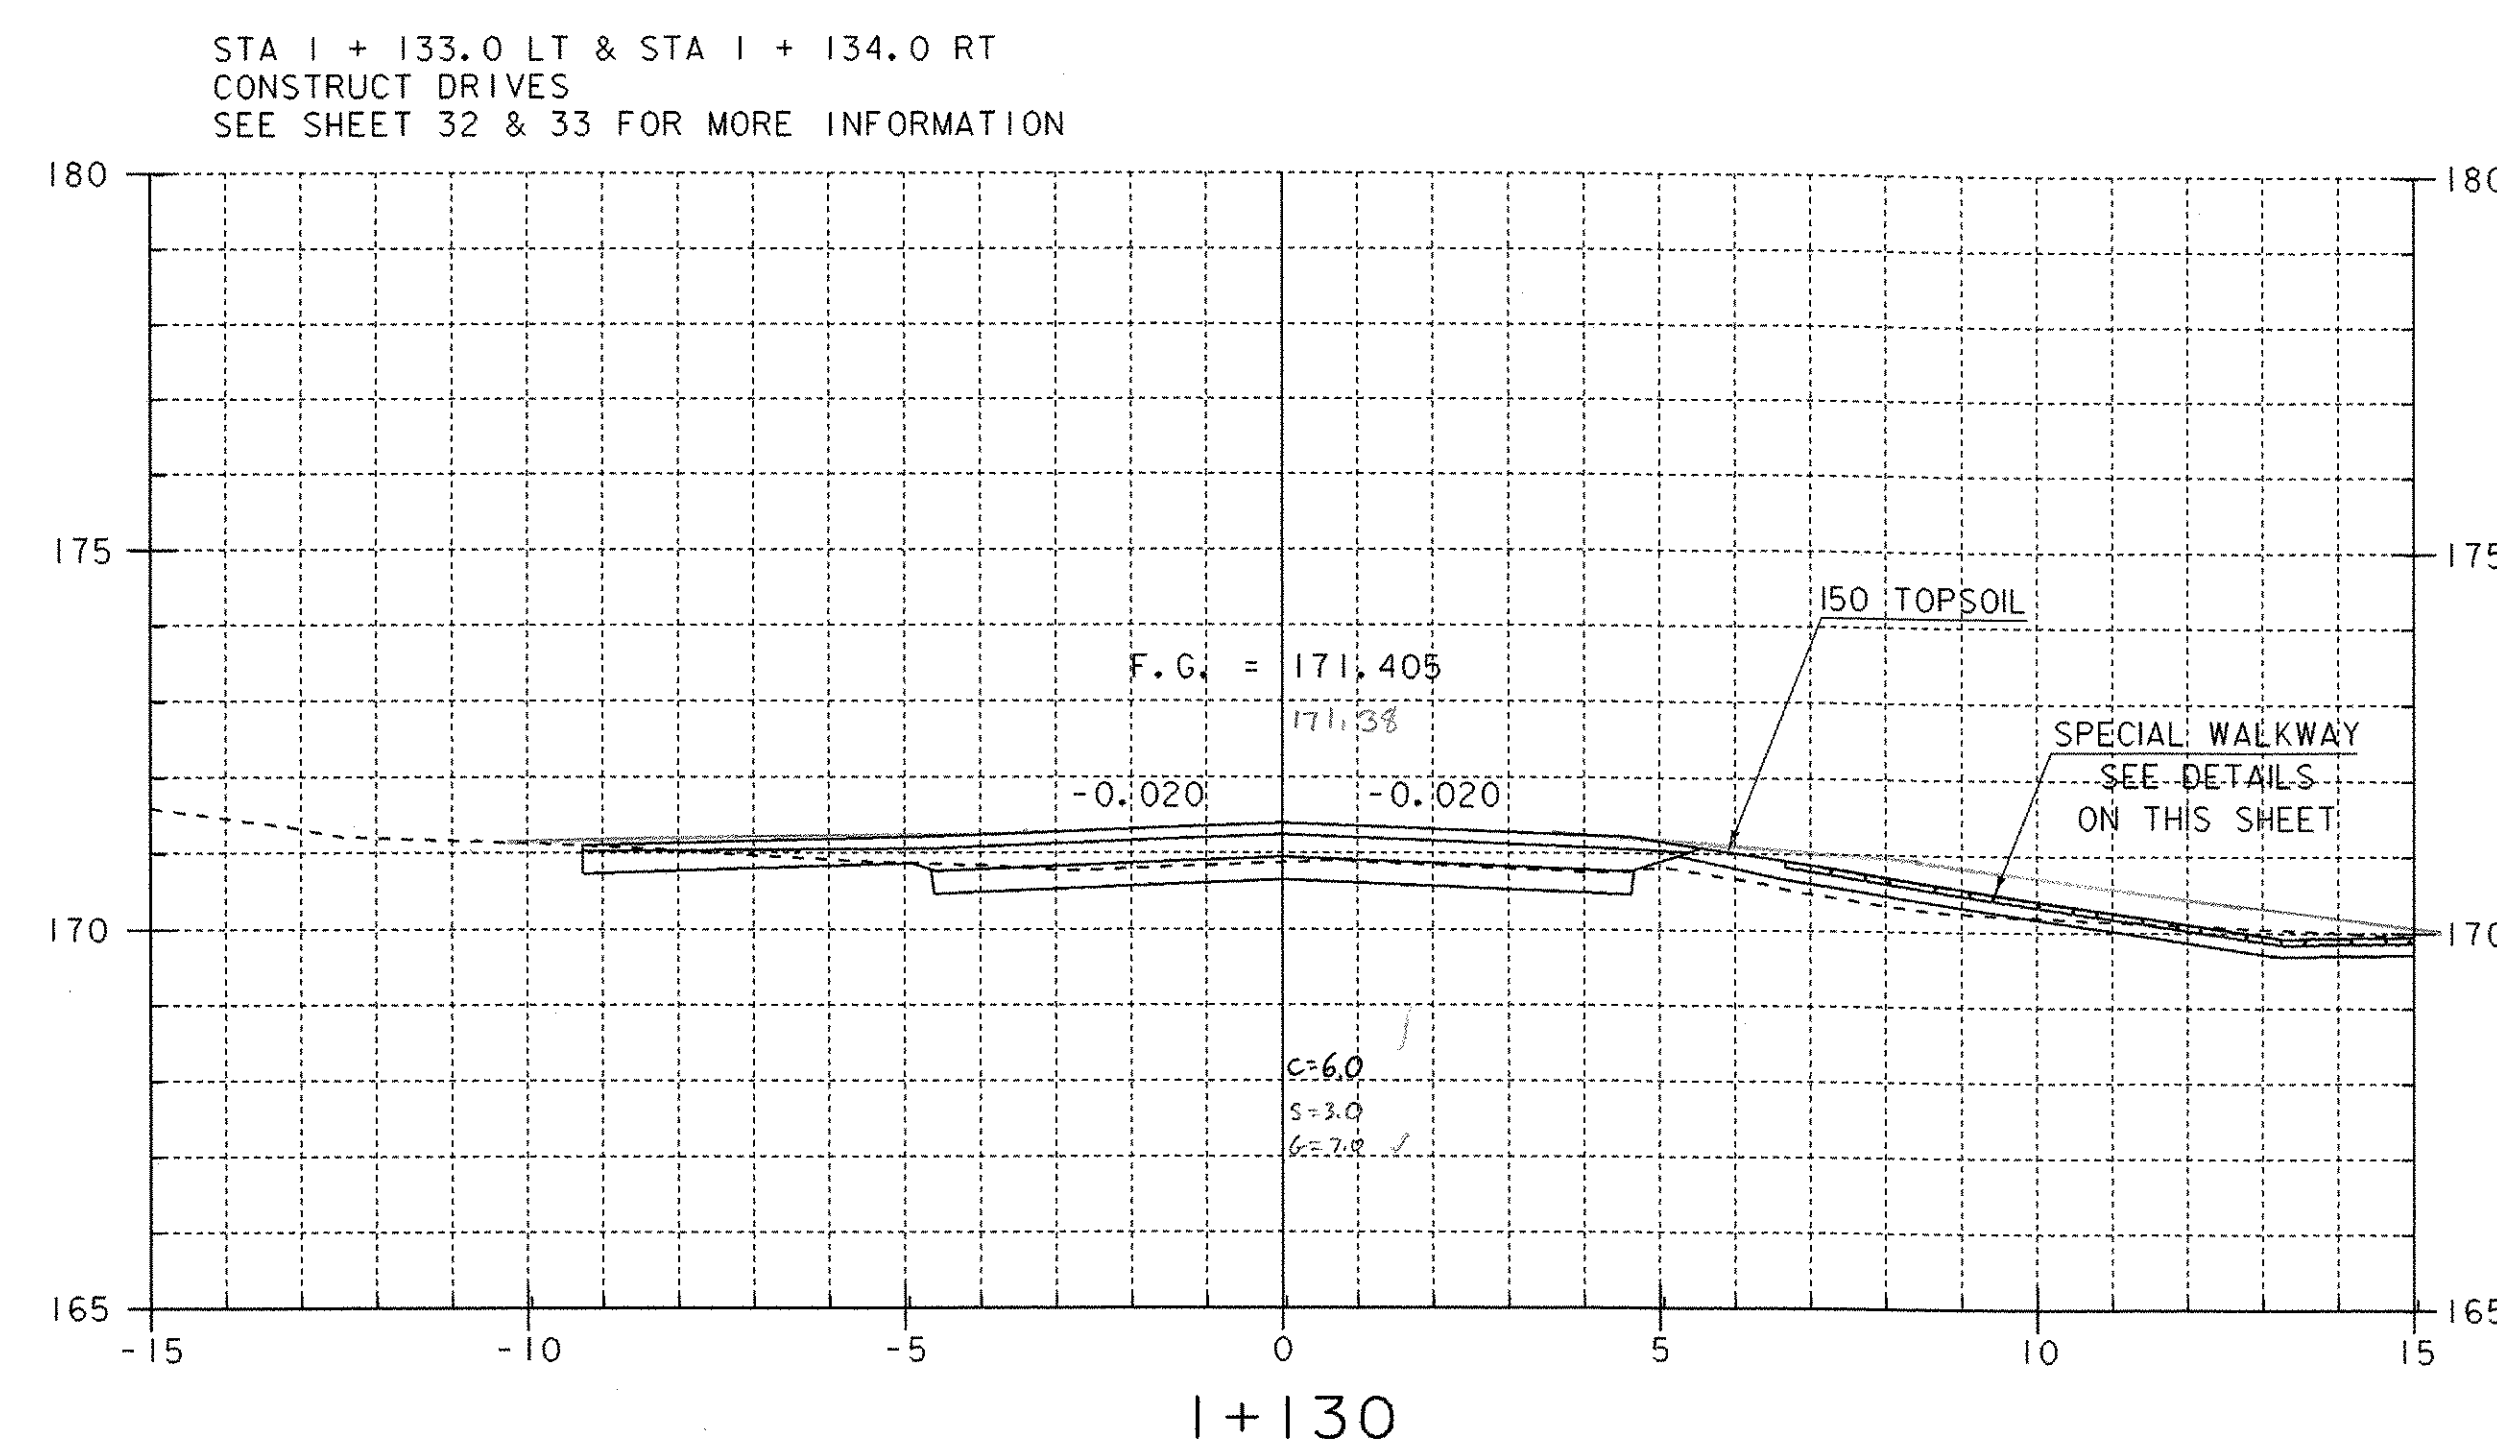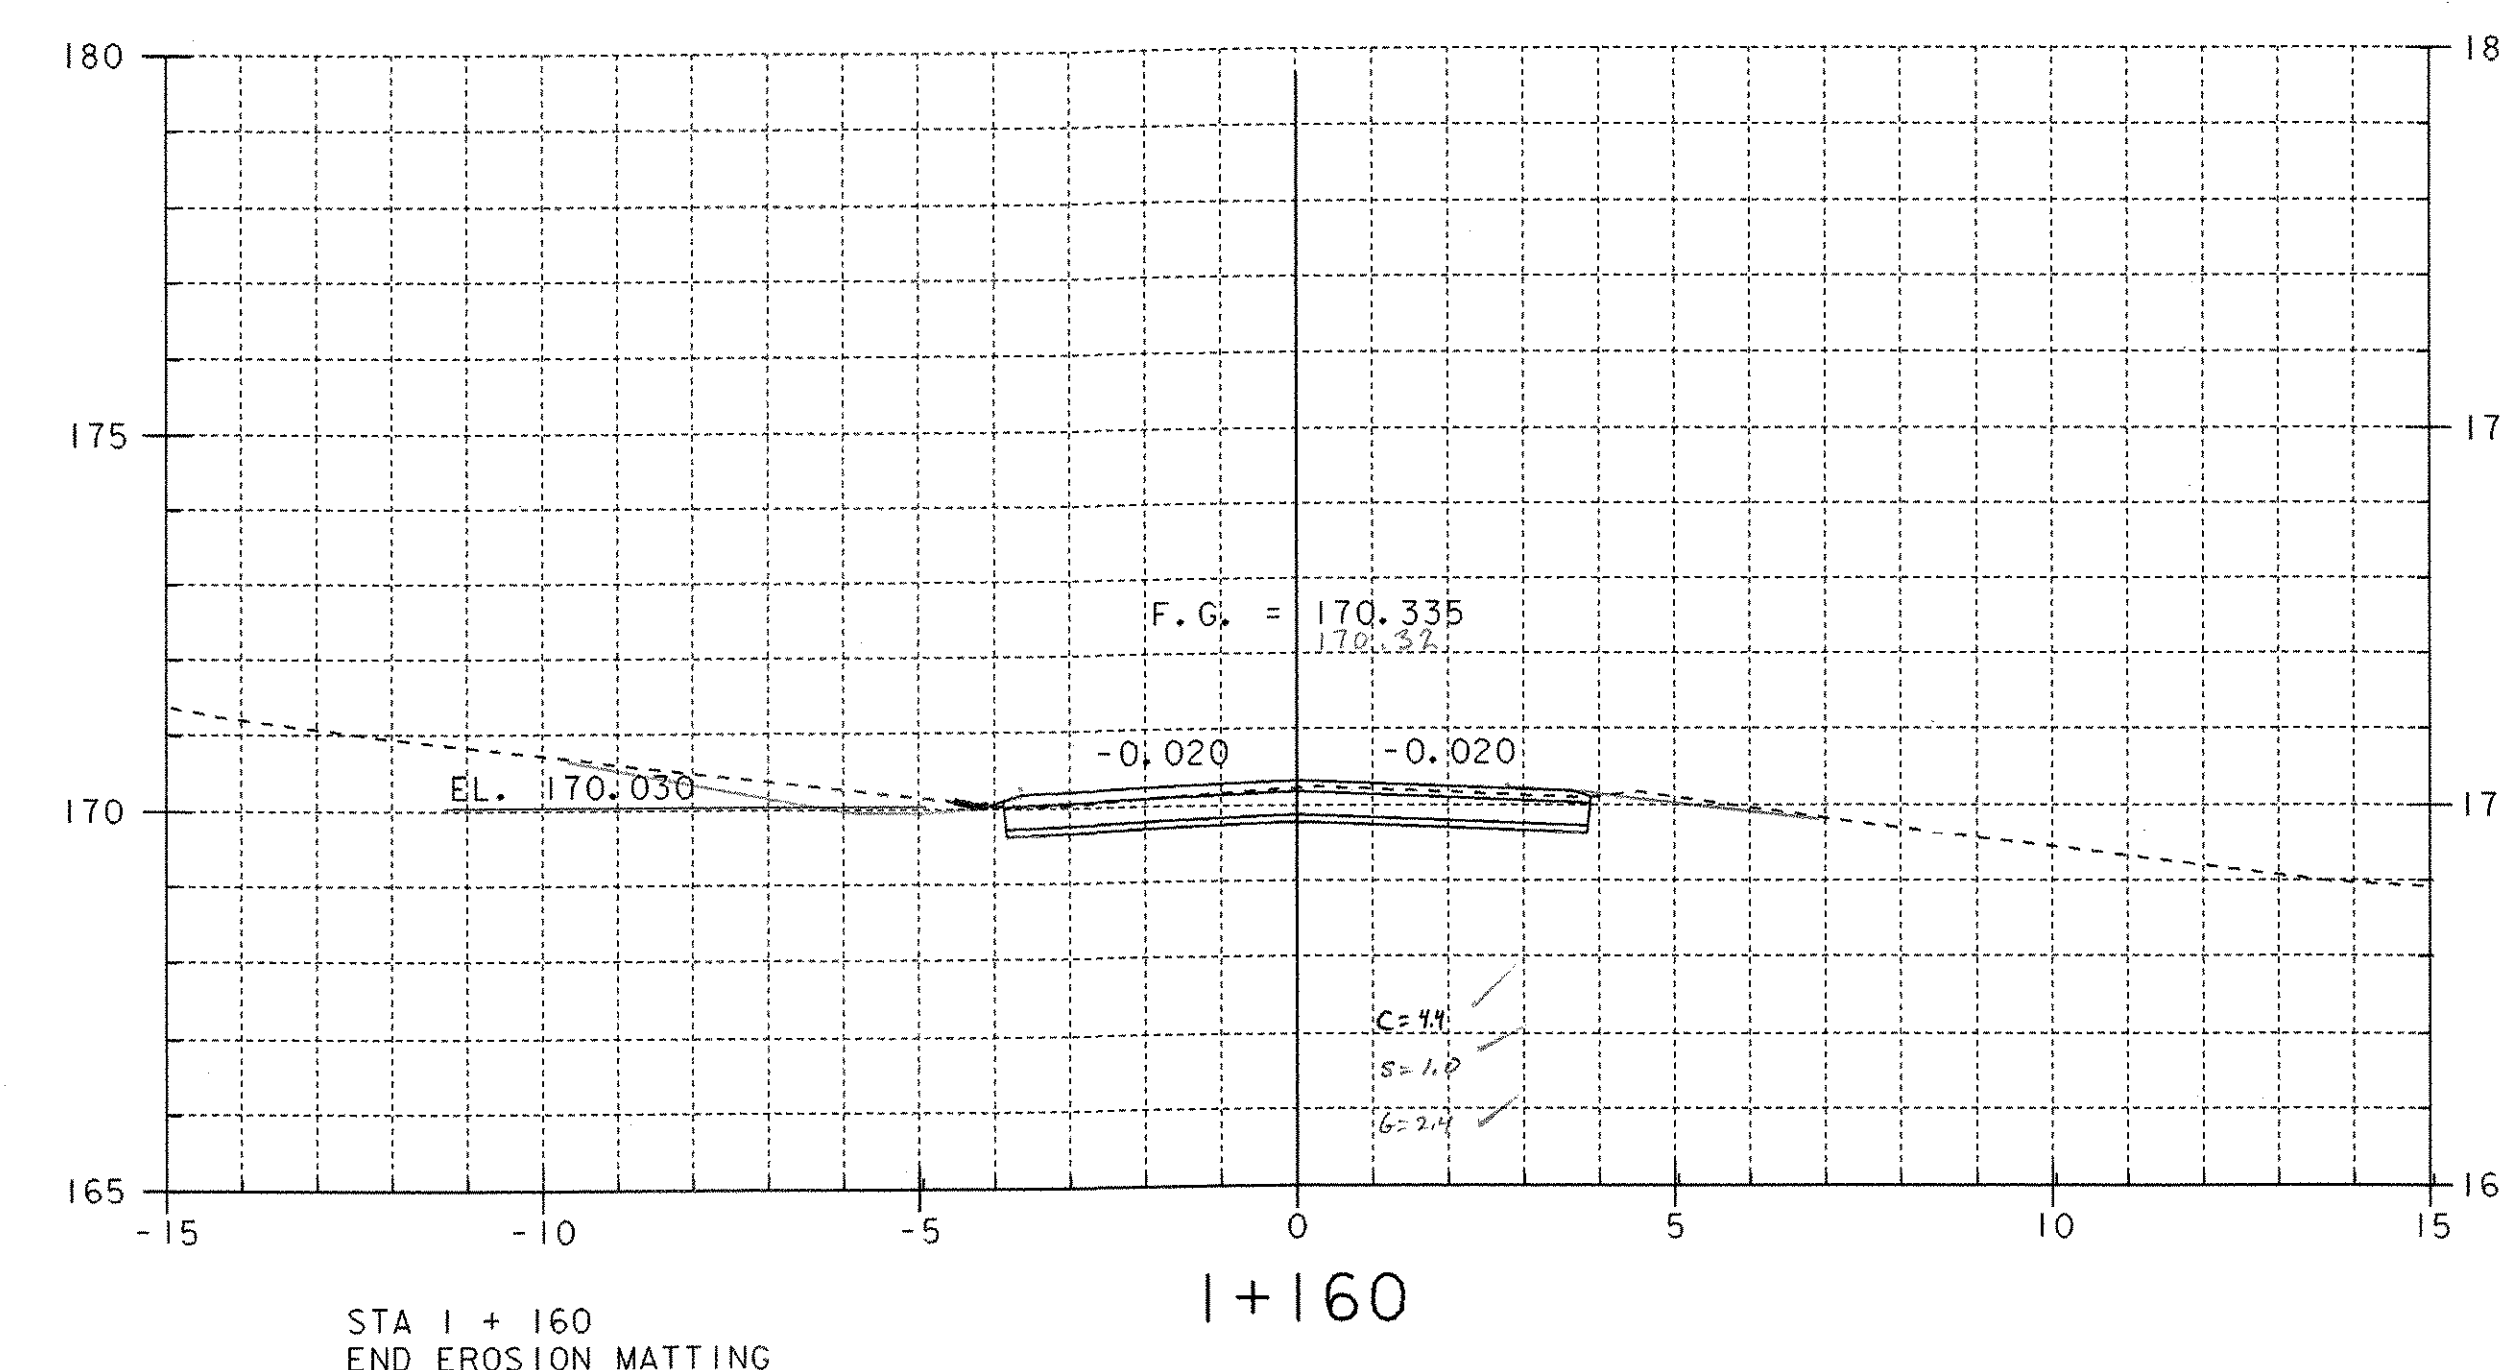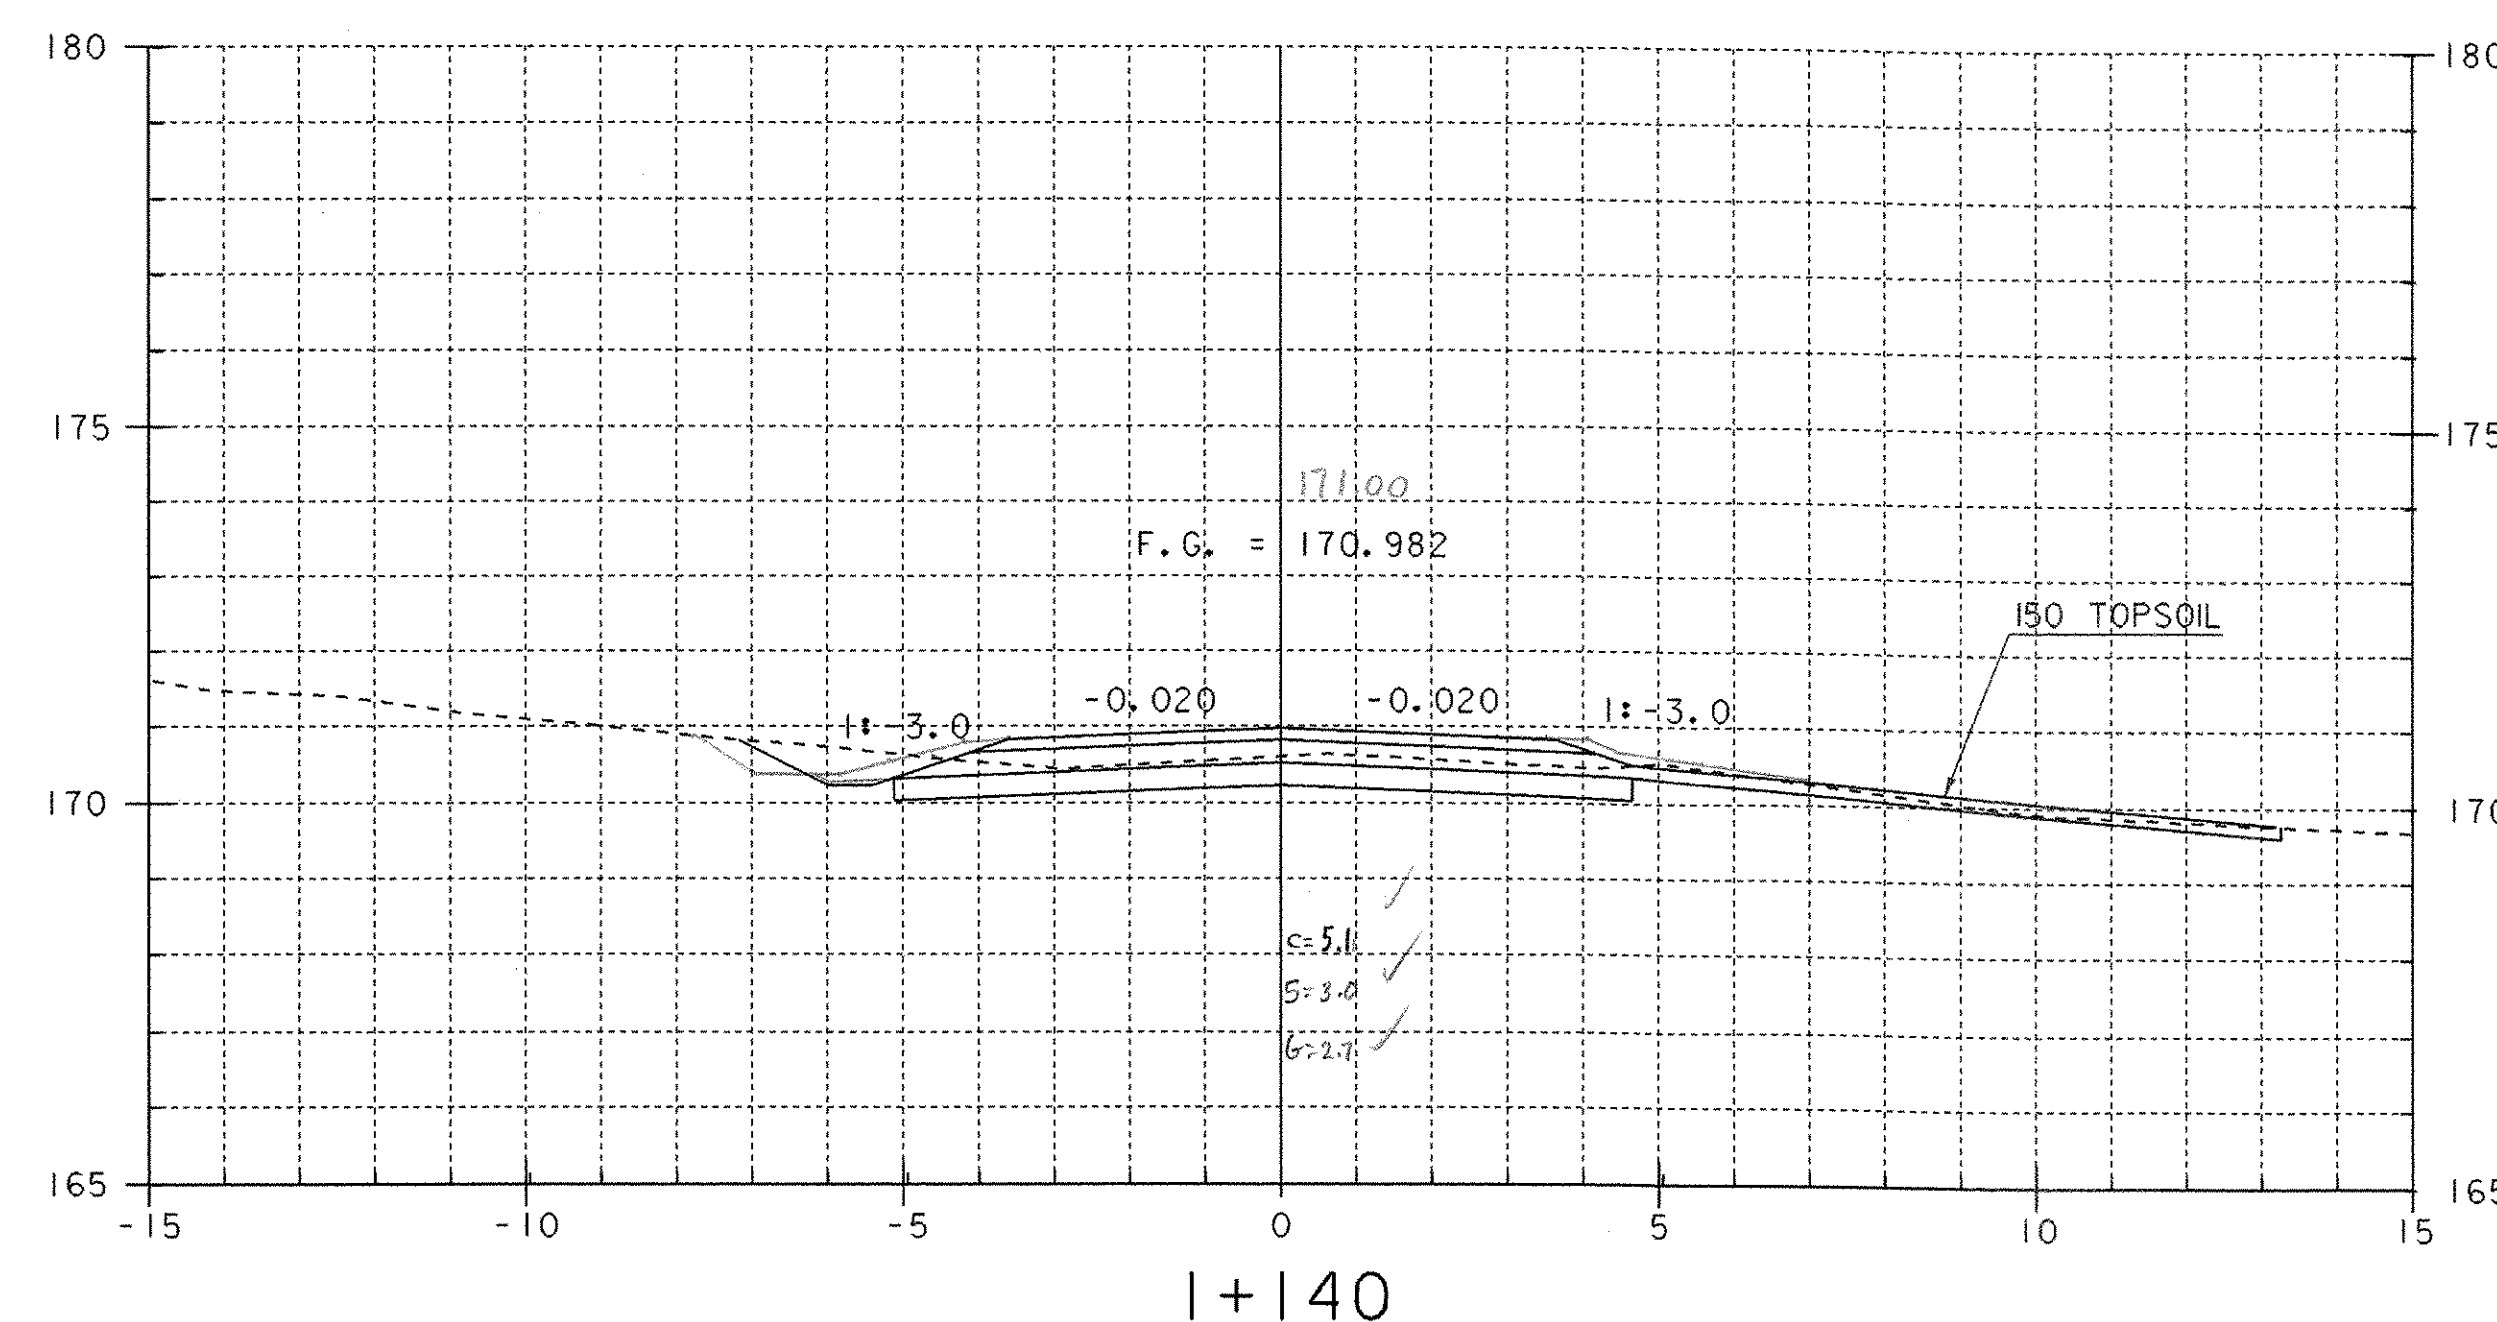

STA I + 129.600 RT
CONSTRUCT SPECIAL WALKWAY

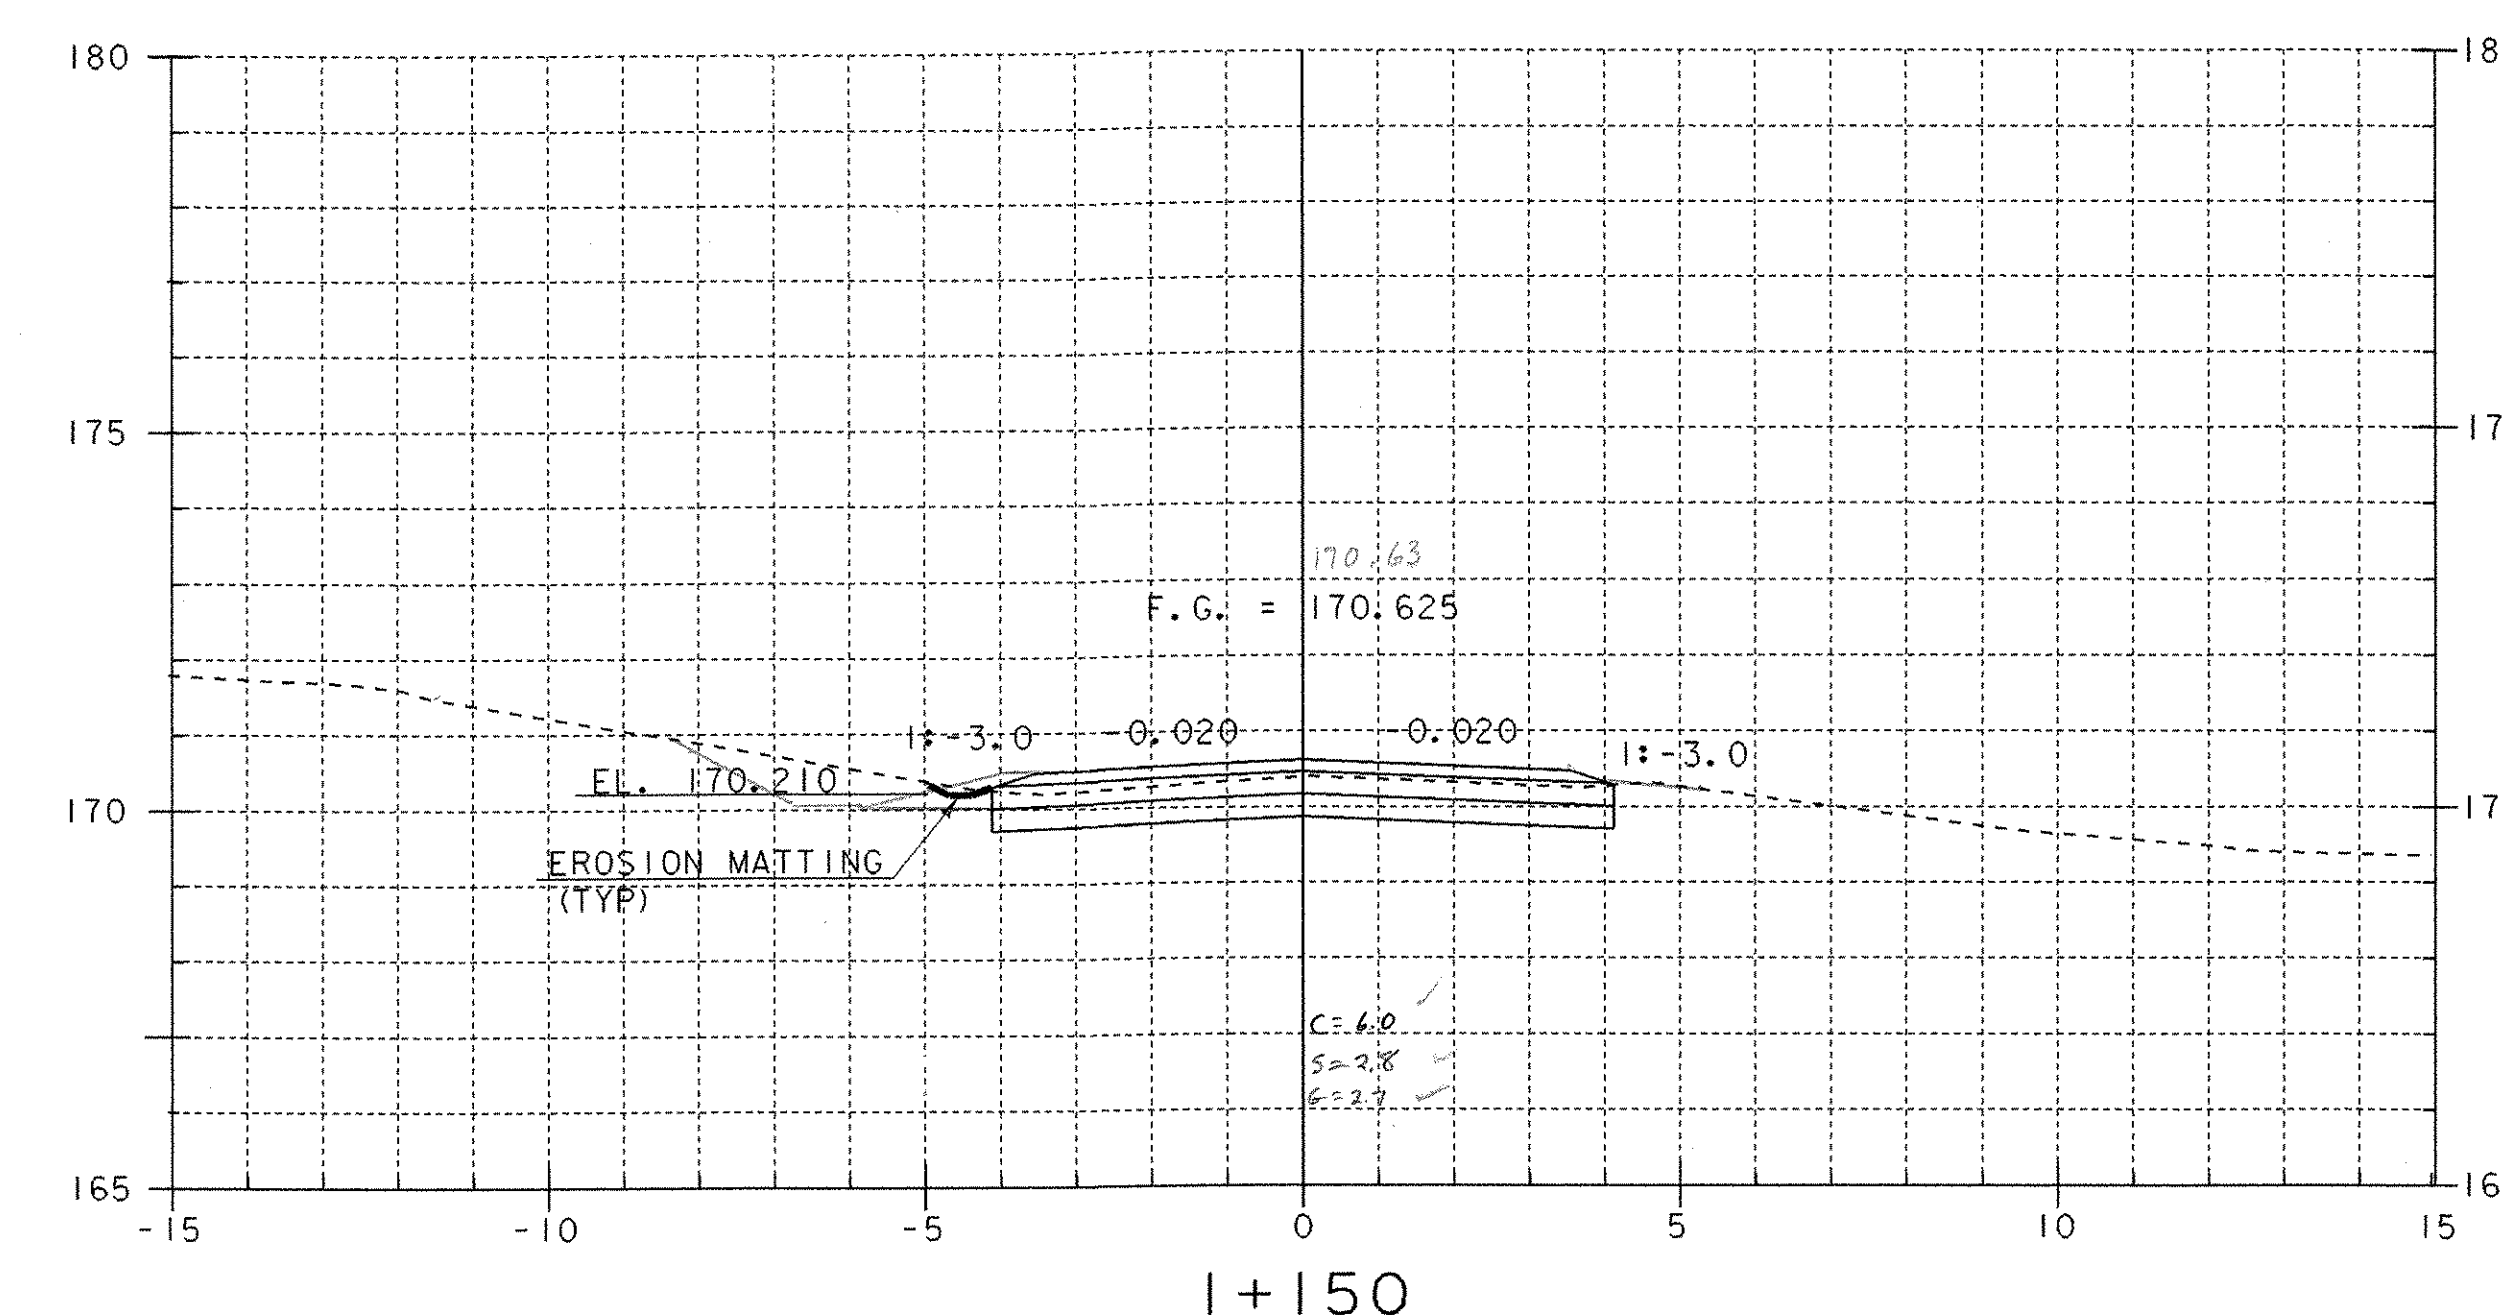

END PROJECT/BEGIN APPROACH

STA I + 140.75
BEGIN EROSION MATTING

SHEET NAME: MAINLINE CROSS SECTIONS

PROJECT NAME: WESTFORD

PROJECT NUMBER: TH2 9436

FILE NAME: /PW/941122/sj122xs2.dgn

PROJECT MANAGER: R. R. WHITCOMB

DESIGNED BY: C. CARLSON

BRIDGE SHEET NUMBER:

TH 4
2

OVER: ROGERS BROOK

PLOT DATE: 25-MAR-2005

DRAWN BY: STRI

IPARM NAME: sj122mx5.1

SHEET 48 OF 56