



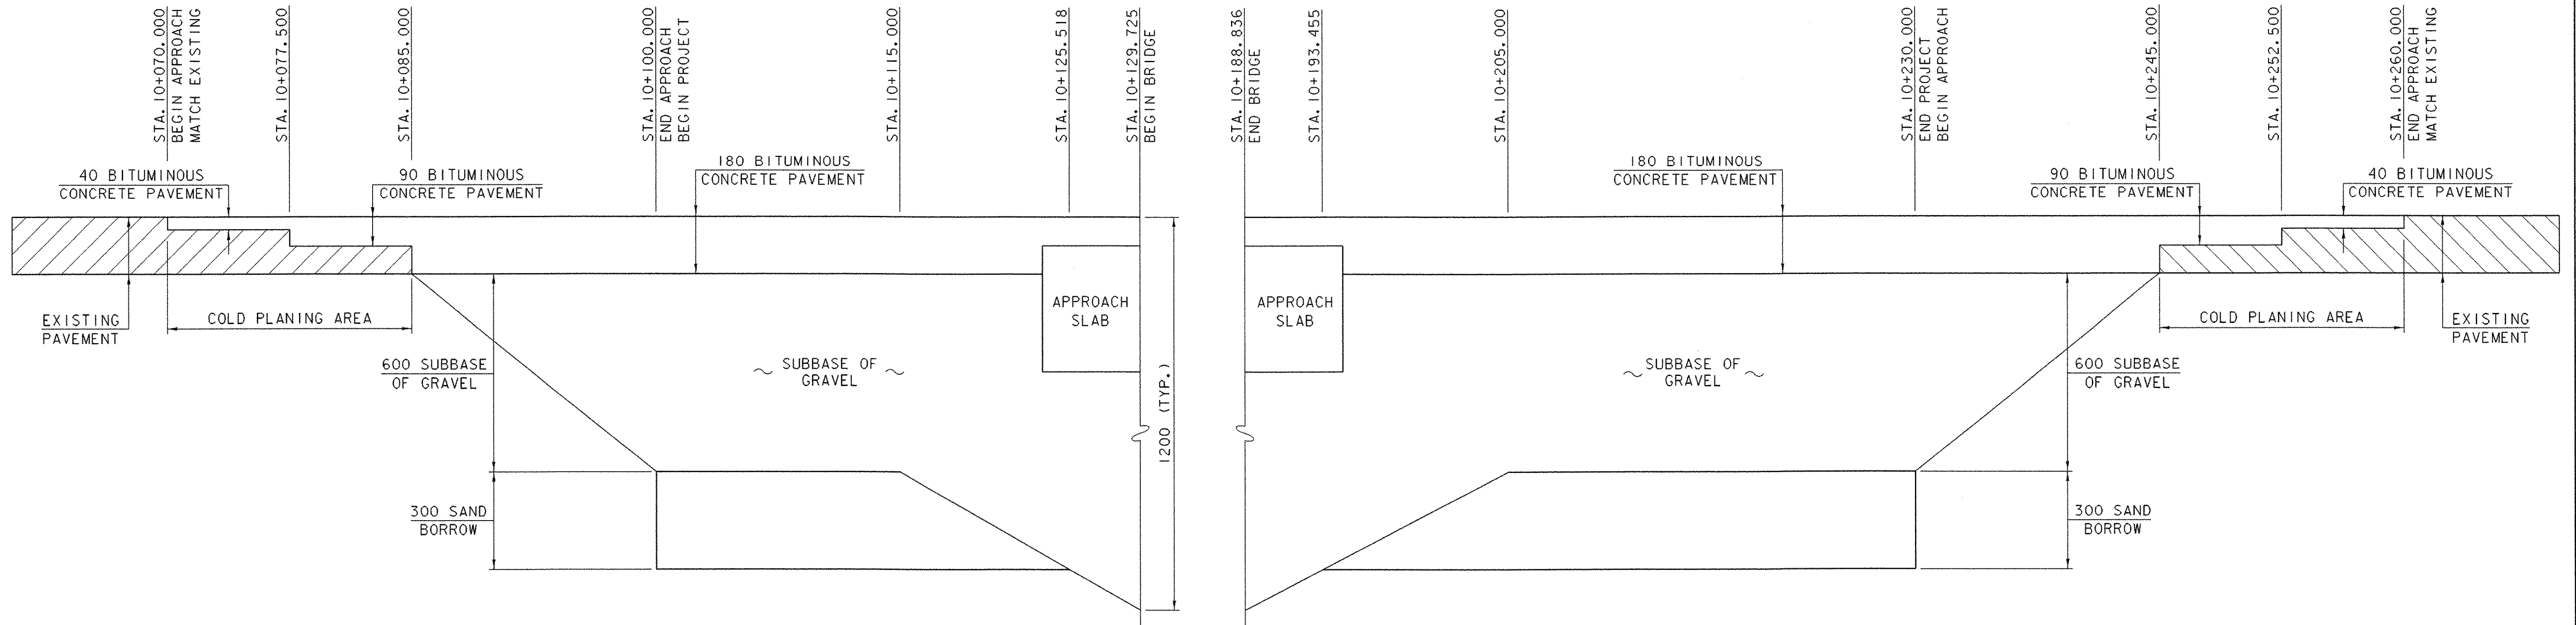


MATERIAL TRANSITION DETAIL

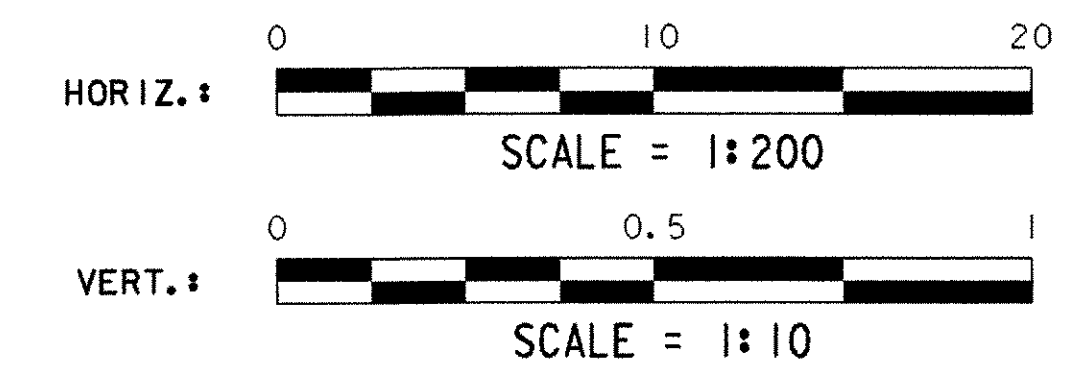


NOTES:

1. SEE ROADWAY CROSS SECTIONS TO DETERMINE CUT OR FILL.
2. SEE SHEET 3 OF THE PLANS FOR ADDITIONAL ABUTMENT EARTHWORK DETAILS.
3. SEE APPROACH SLAB END DETAIL ON SHEET 40 OF THE PLANS FOR PAVEMENT TRANSITION DETAILS AT THE END OF APPROACH SLABS.

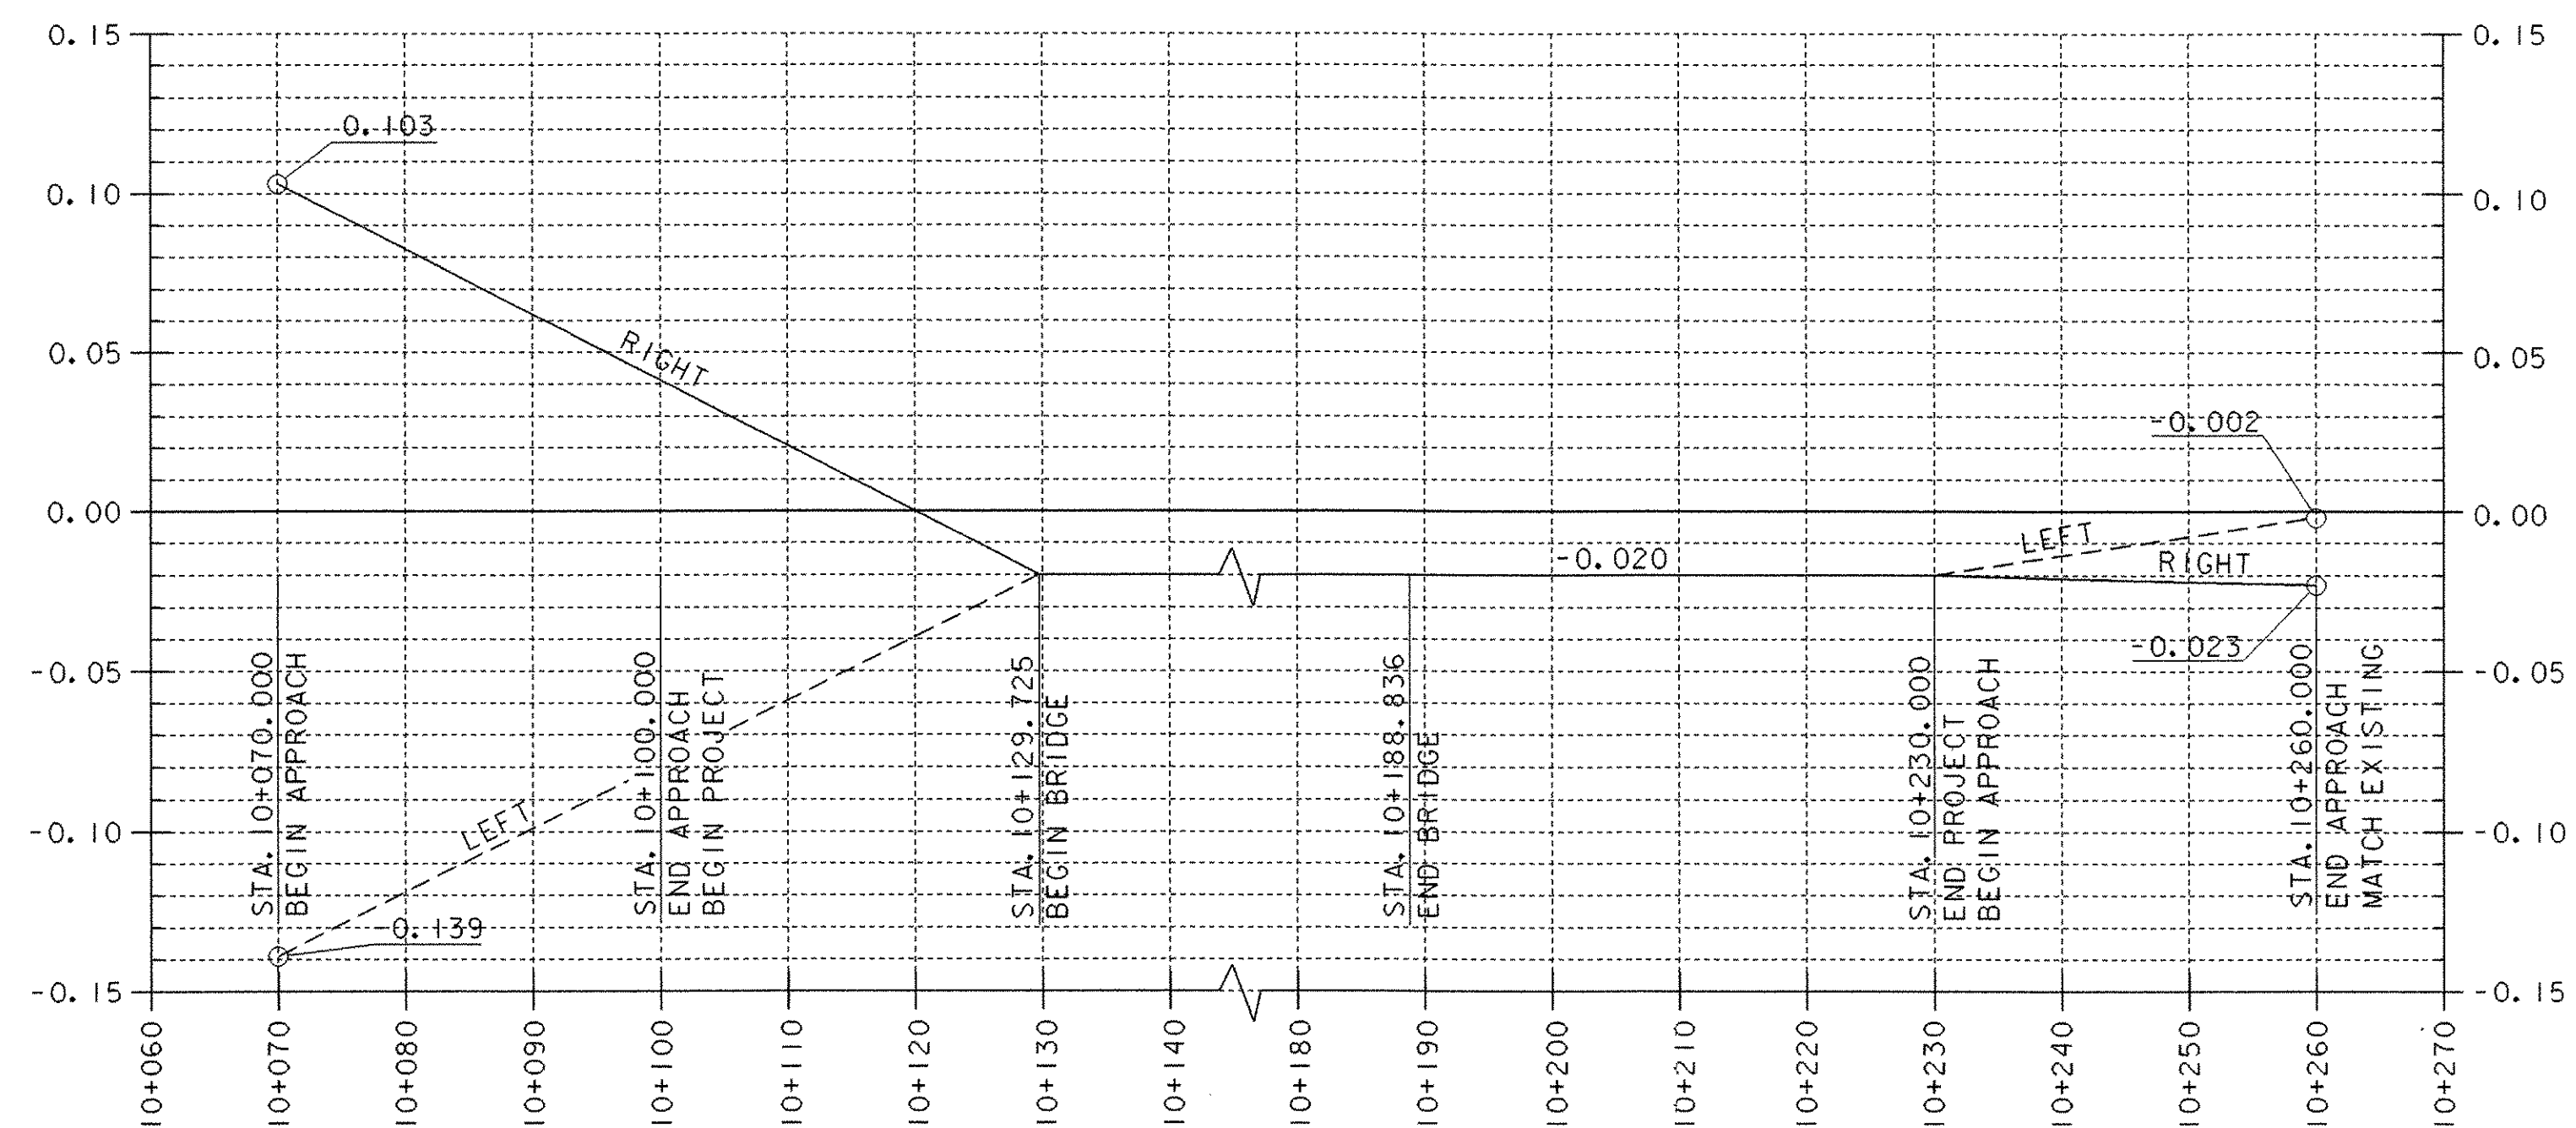

BANKING DIAGRAM

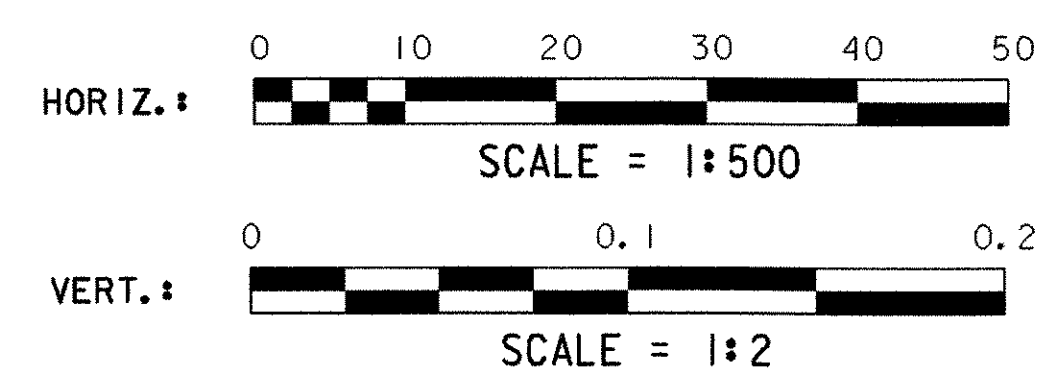

ADDITIONAL MAINLINE ROADWAY DETAILS

PROJECT NAME:	BROOKLINE NEWFANE
PROJECT NUMBER:	BHO 1442 (25)
FILE NAME:	951278\Structures\sj266mat.i
PROJECT MANAGER:	R. WHITCOMB
DESIGNED BY:	G. ROY
PLOT DATE:	26-JUN-2003
DRAWN BY:	G. ROY
CHECKED BY:	M. LOZIER
SHEET	48 OF 78