

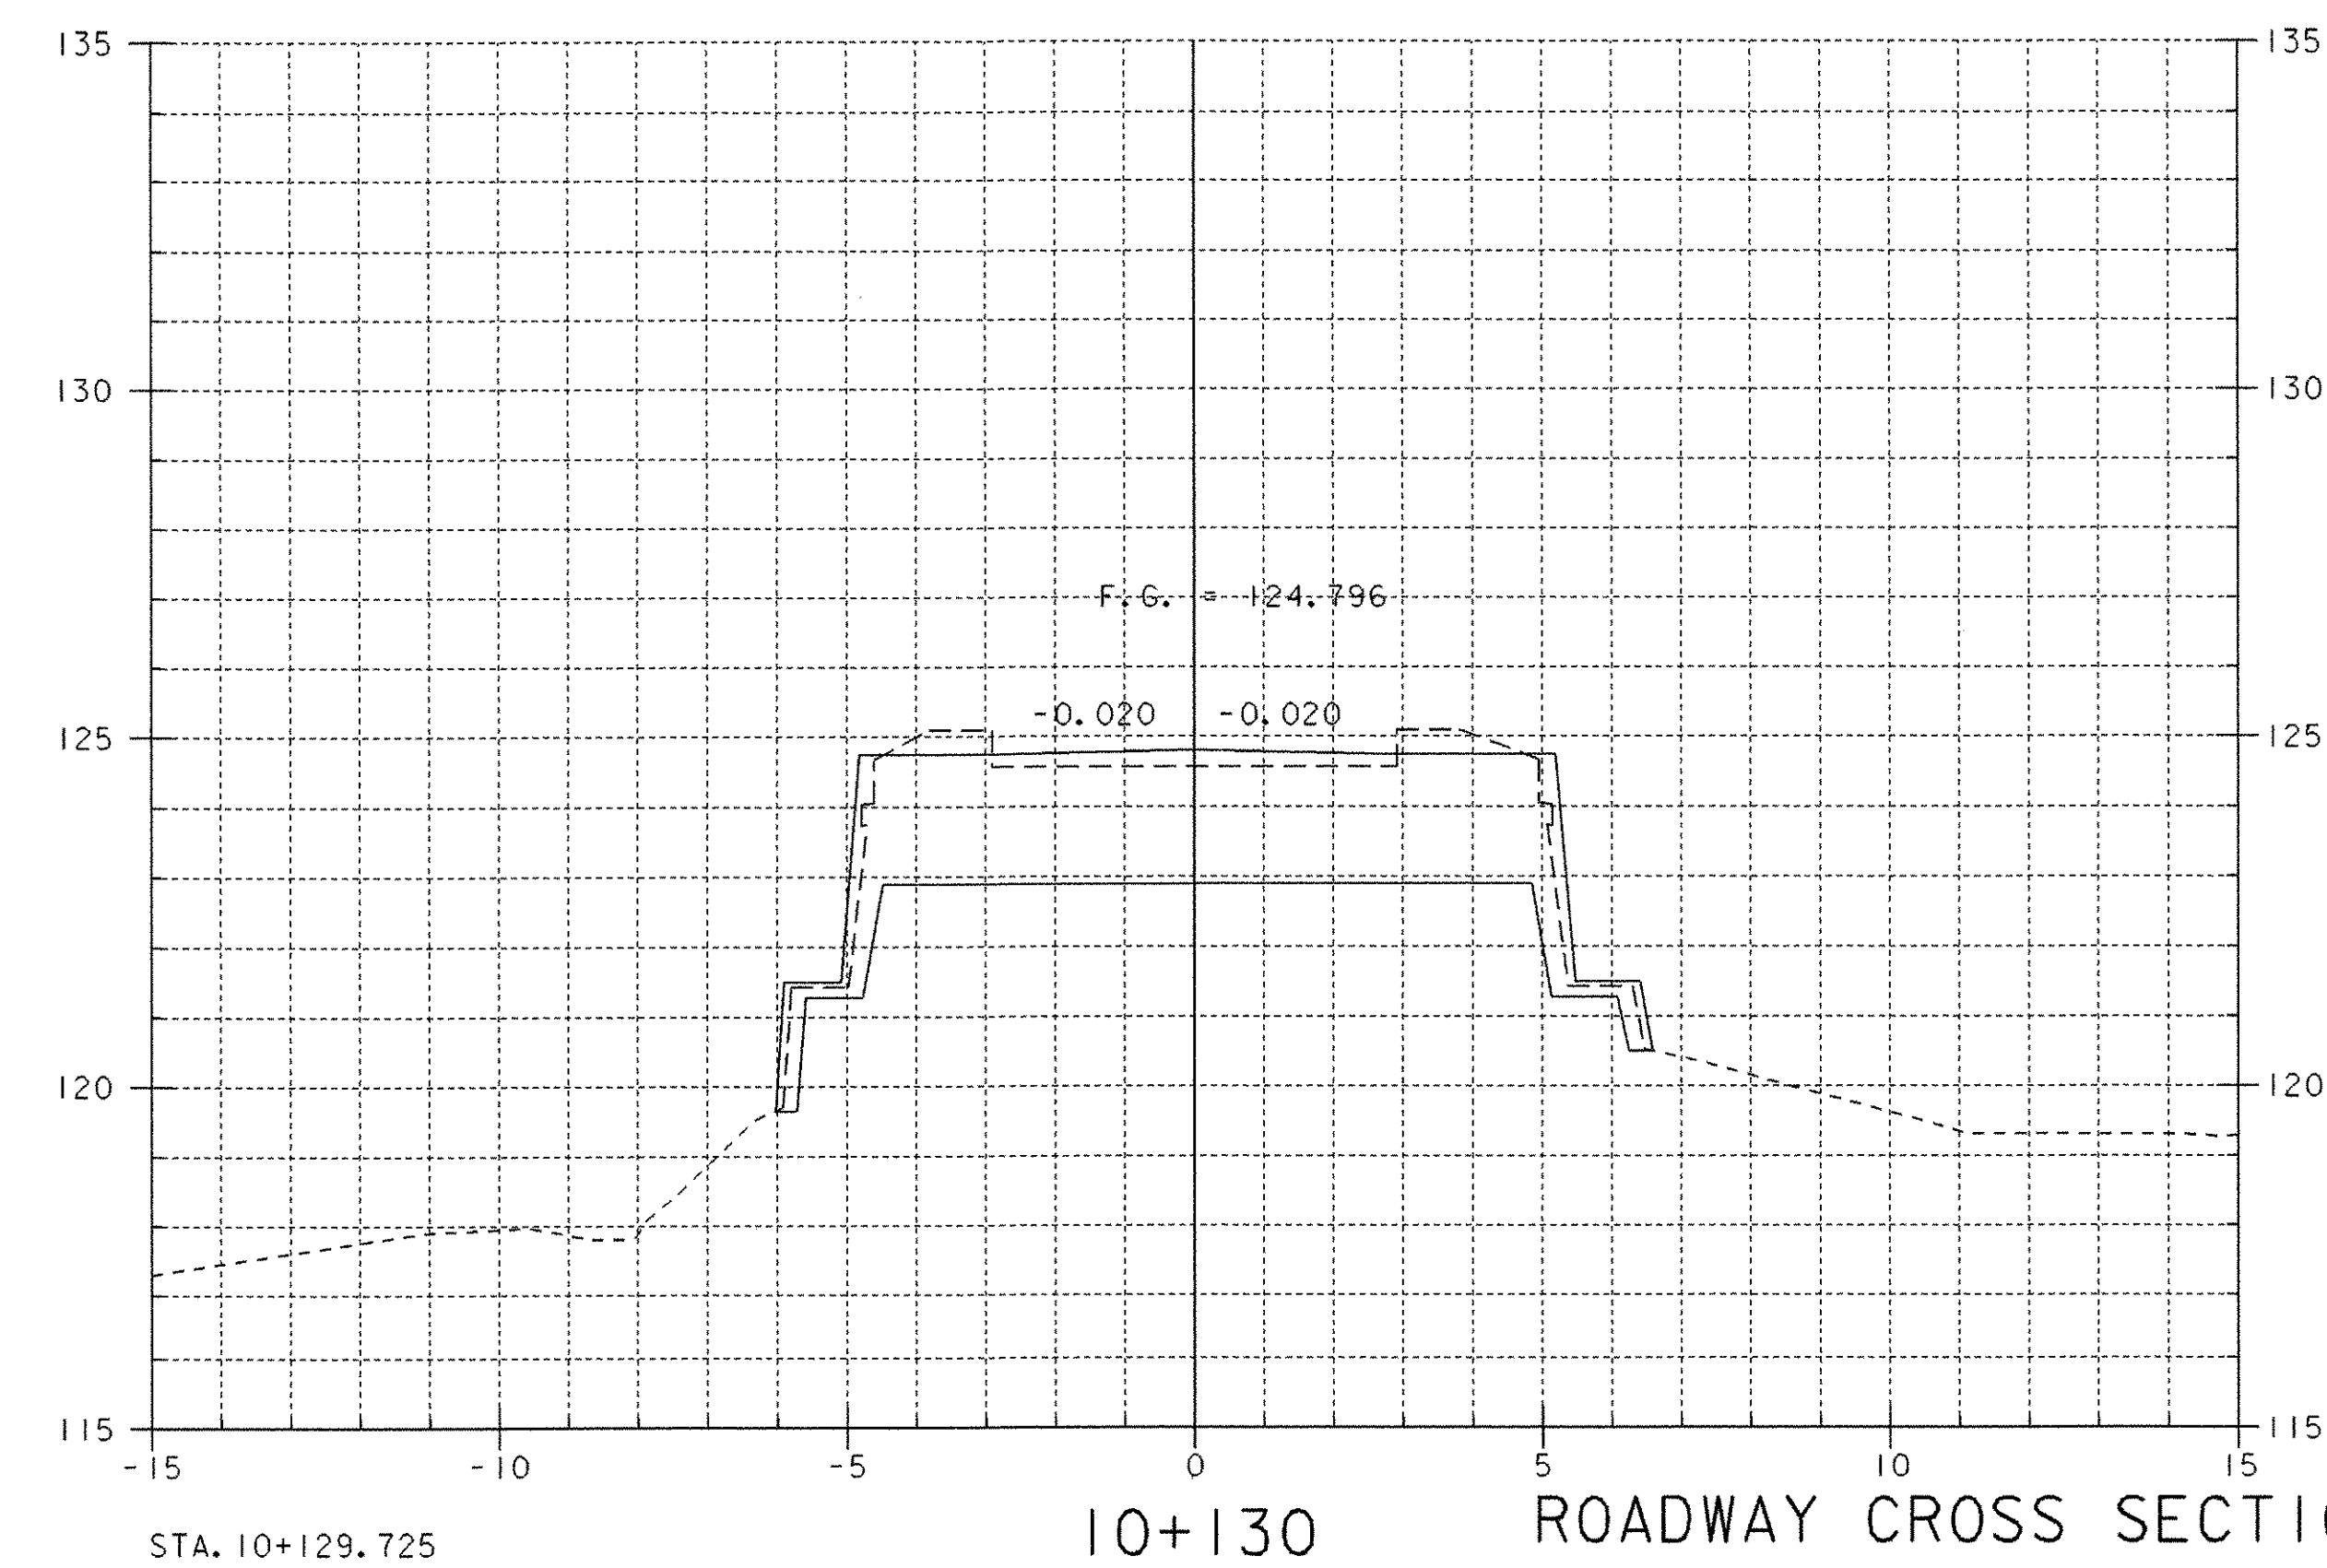
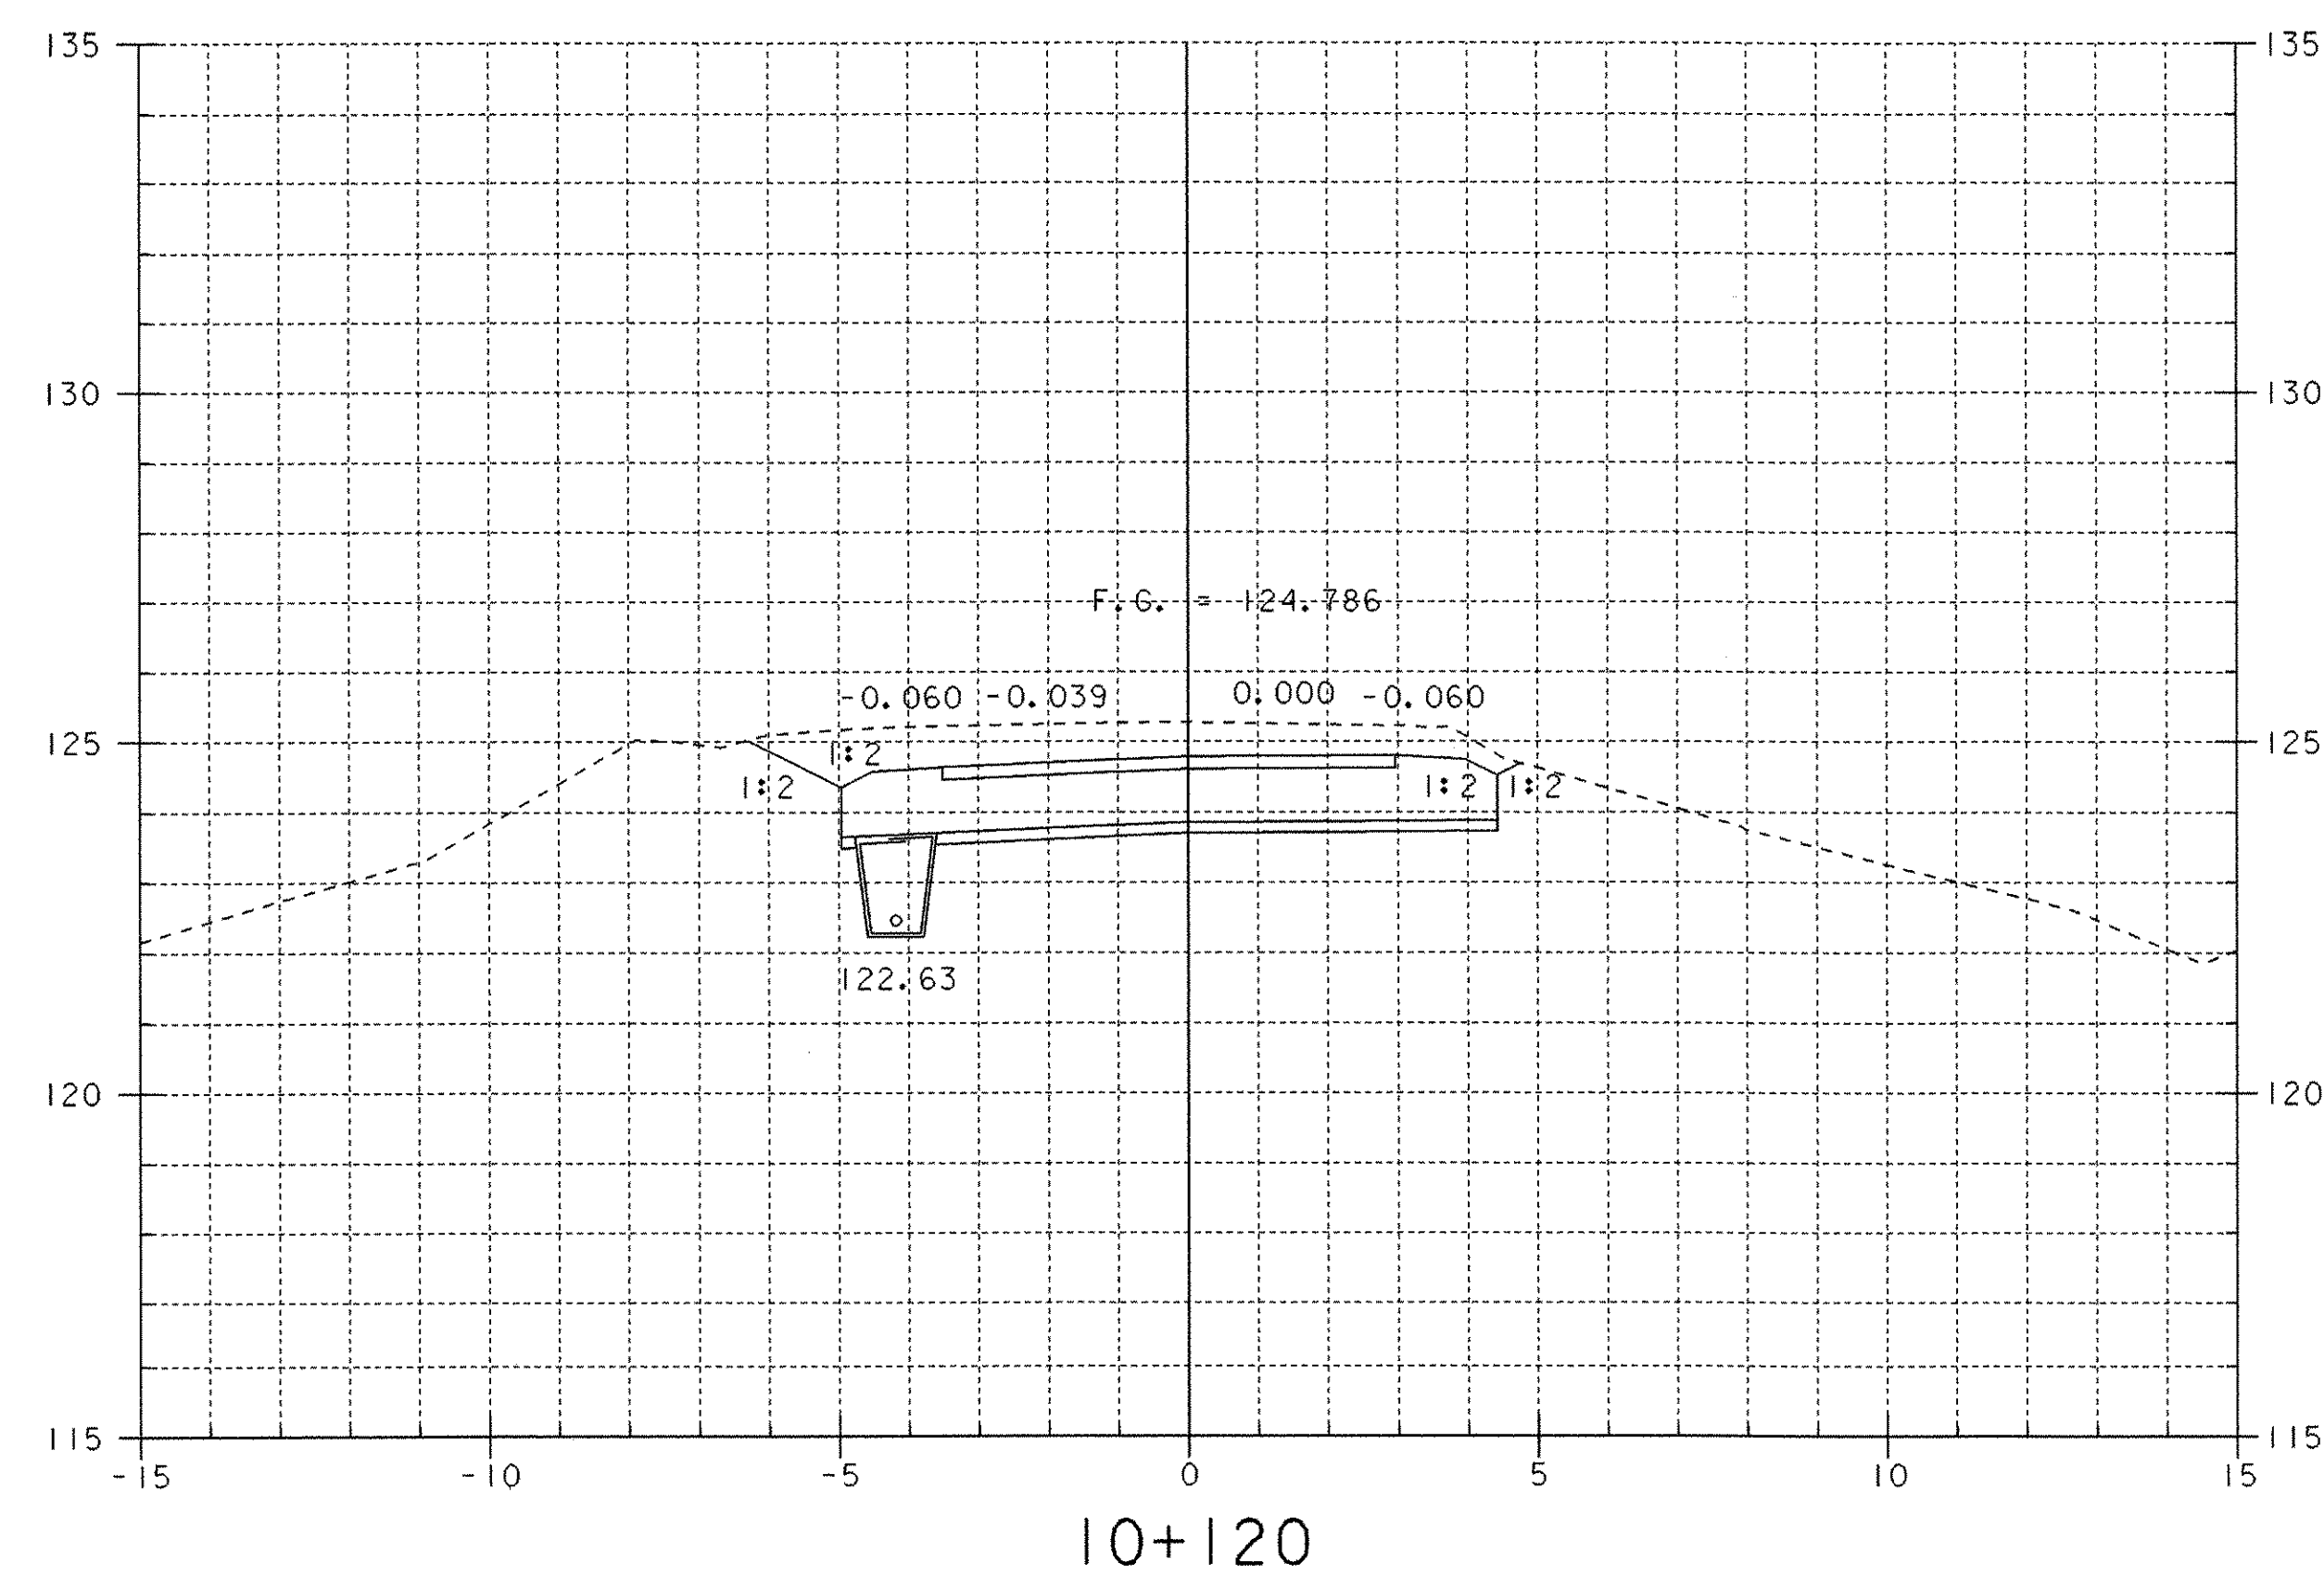
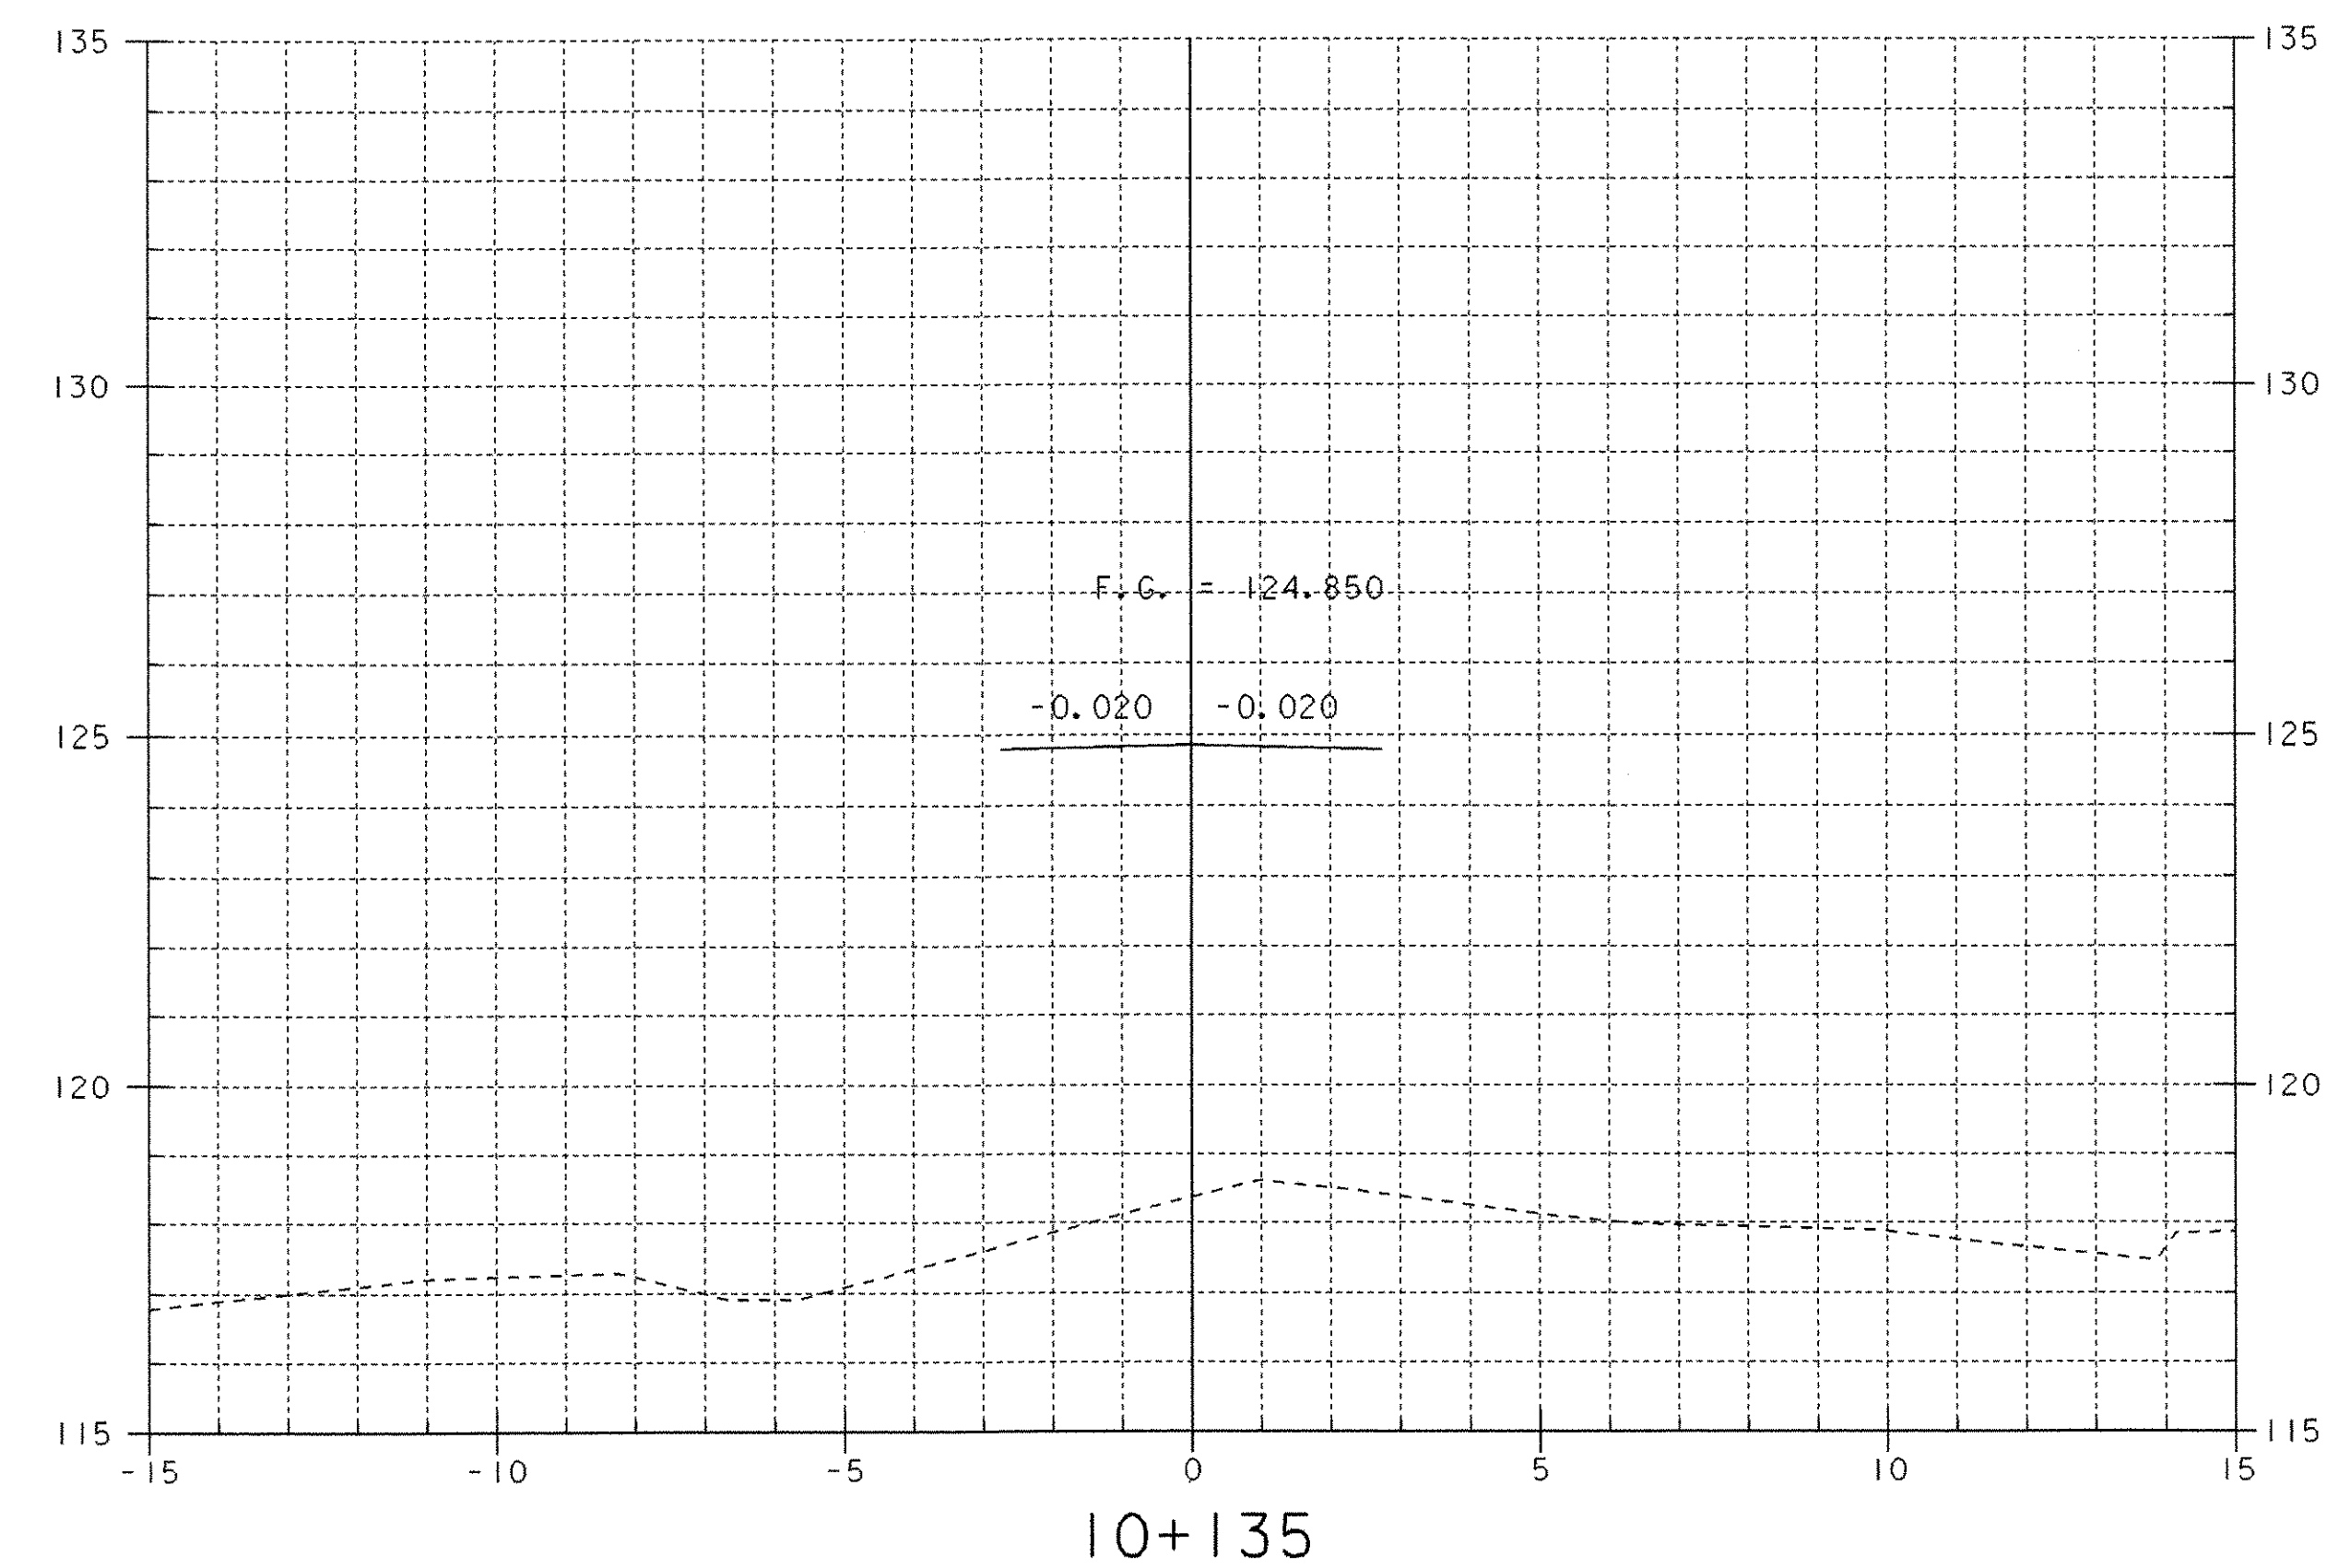


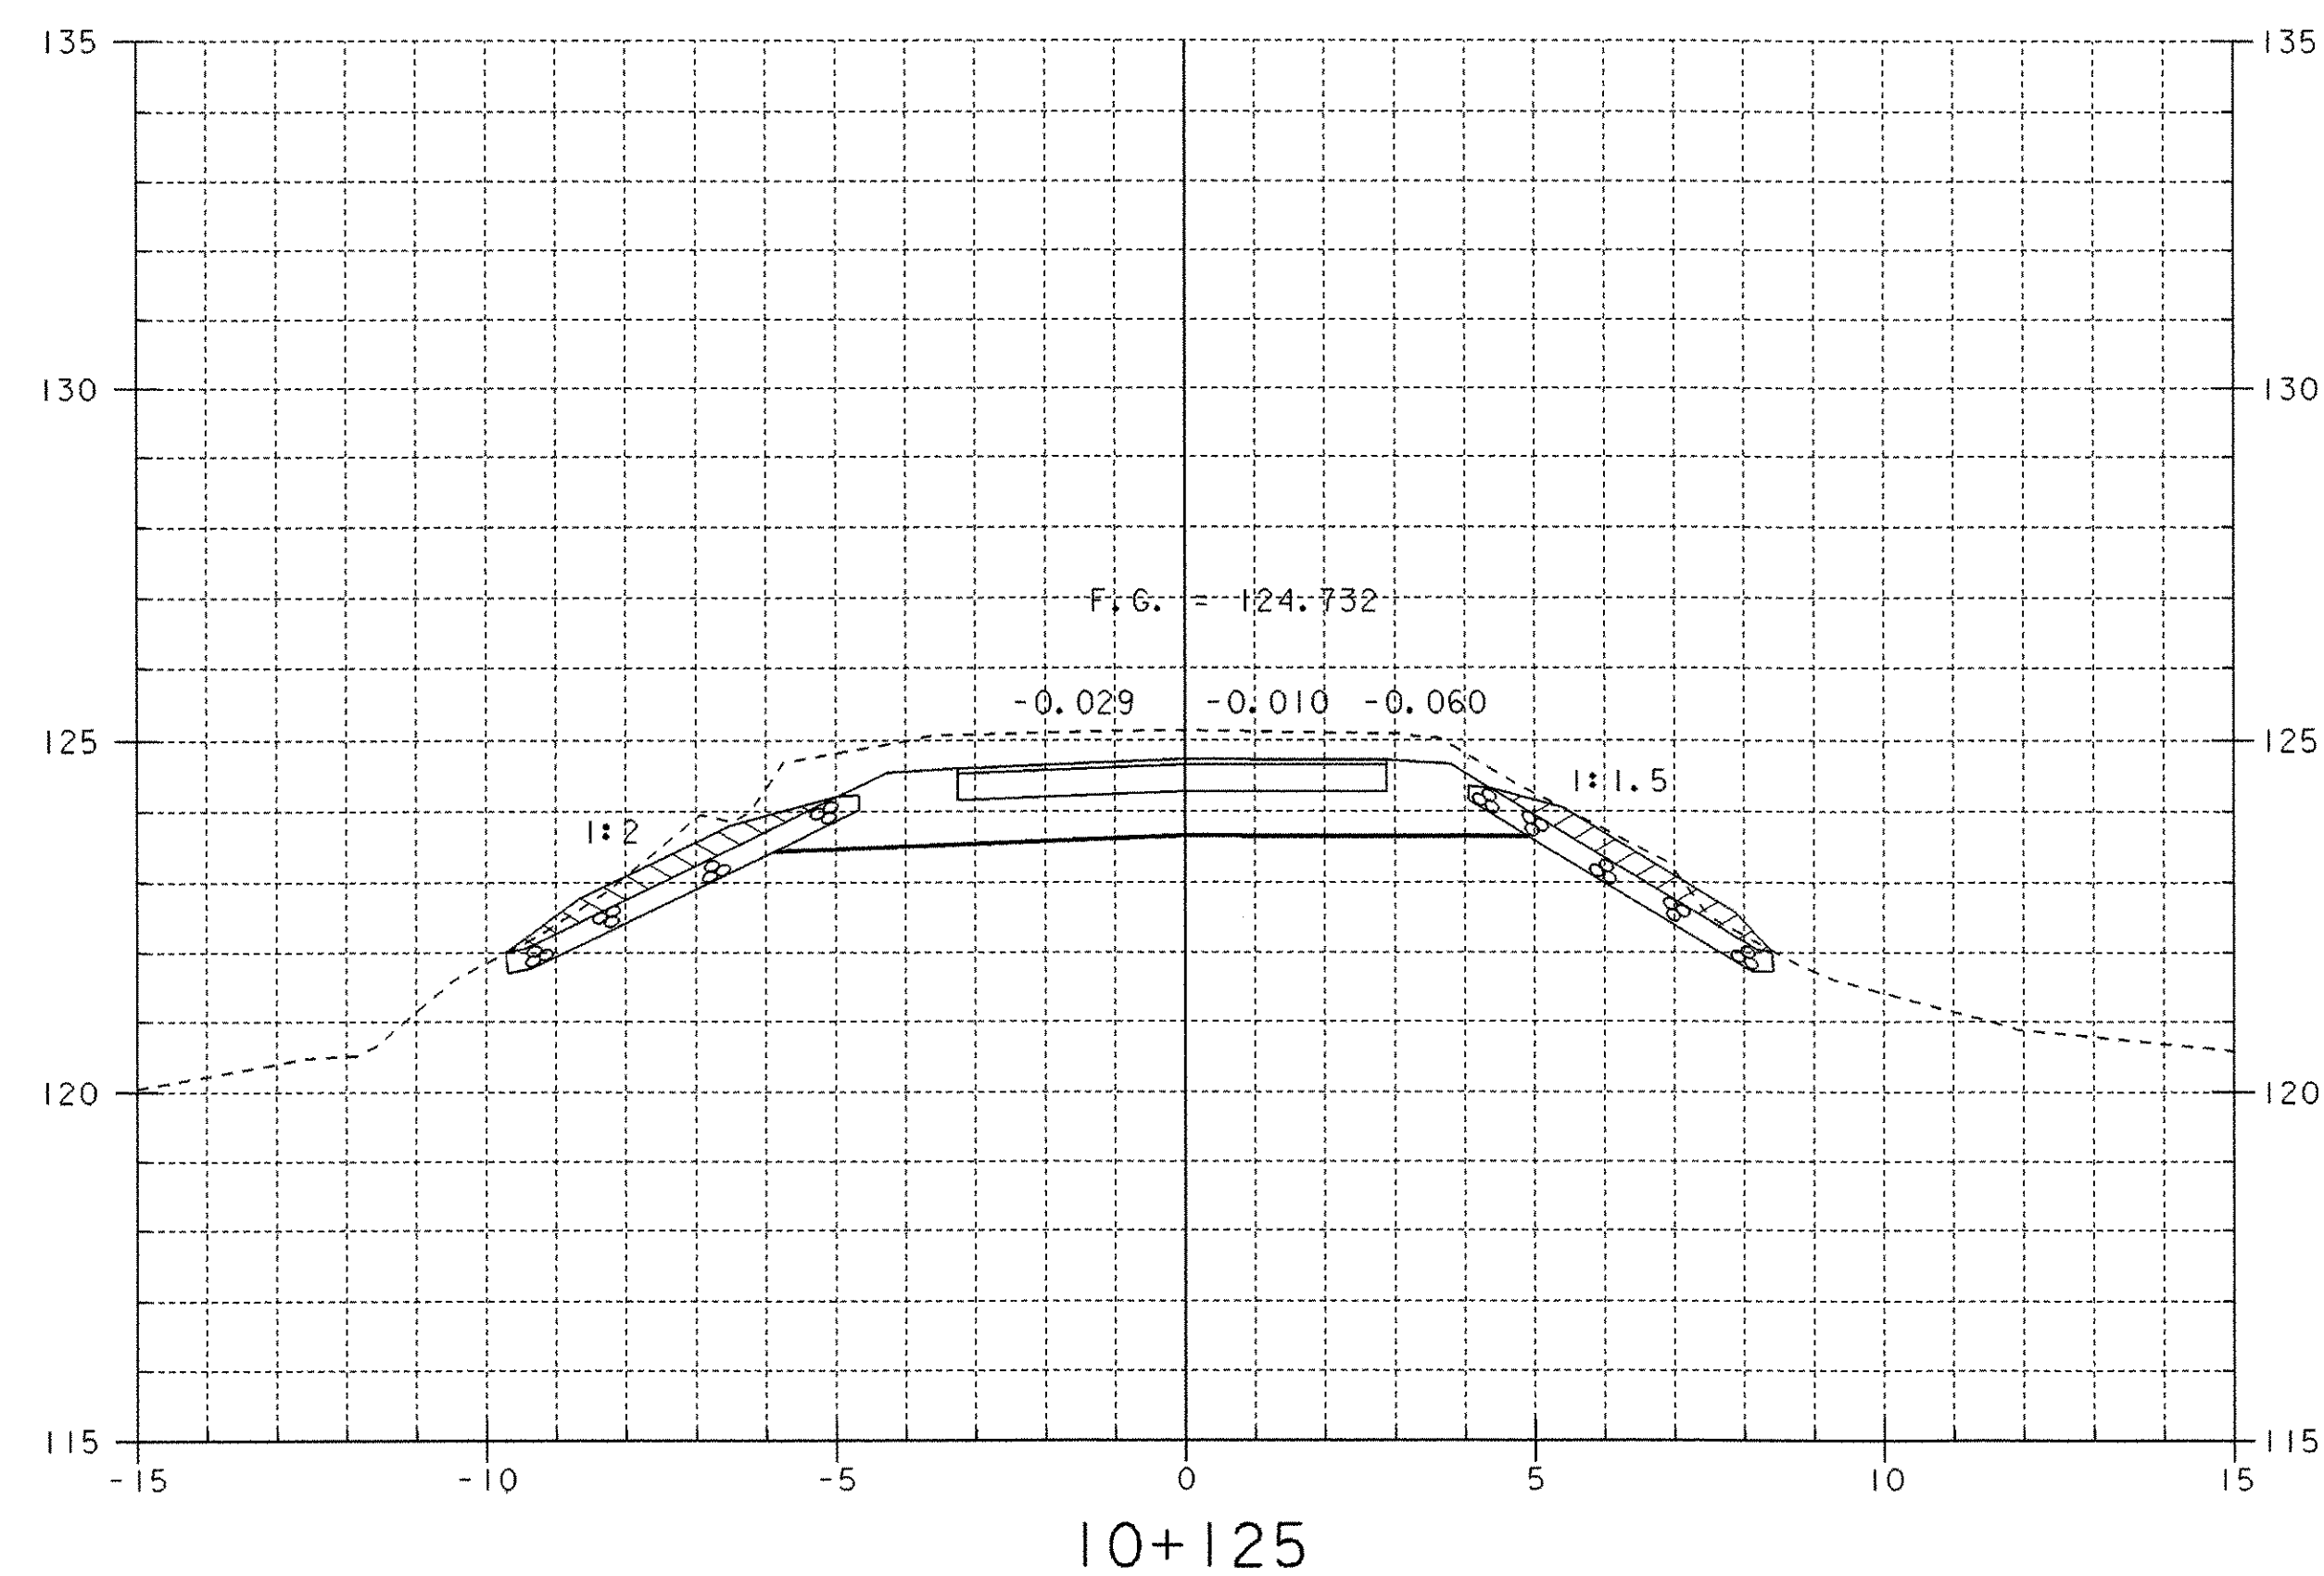

STA. 10+129.725
END ROADWAY
BEGIN BRIDGE

ROADWAY CROSS SECTIONS (3)

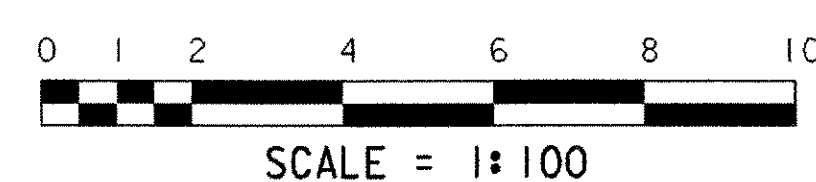

PROJECT NAME:	BROOKLINE NEWFANE	FILE NAME:	951278\Structures\sj266m03.1	PLOT DATE:	26-JUN-2003
PROJECT NUMBER:	BHO 1442 (25)	PROJECT MANAGER:	R. WHITCOMB	DRAWN BY:	G. ROY
		DESIGNED BY:	G. ROY	CHECKED BY:	M. LOZIER
				SHEET	51 OF 78