

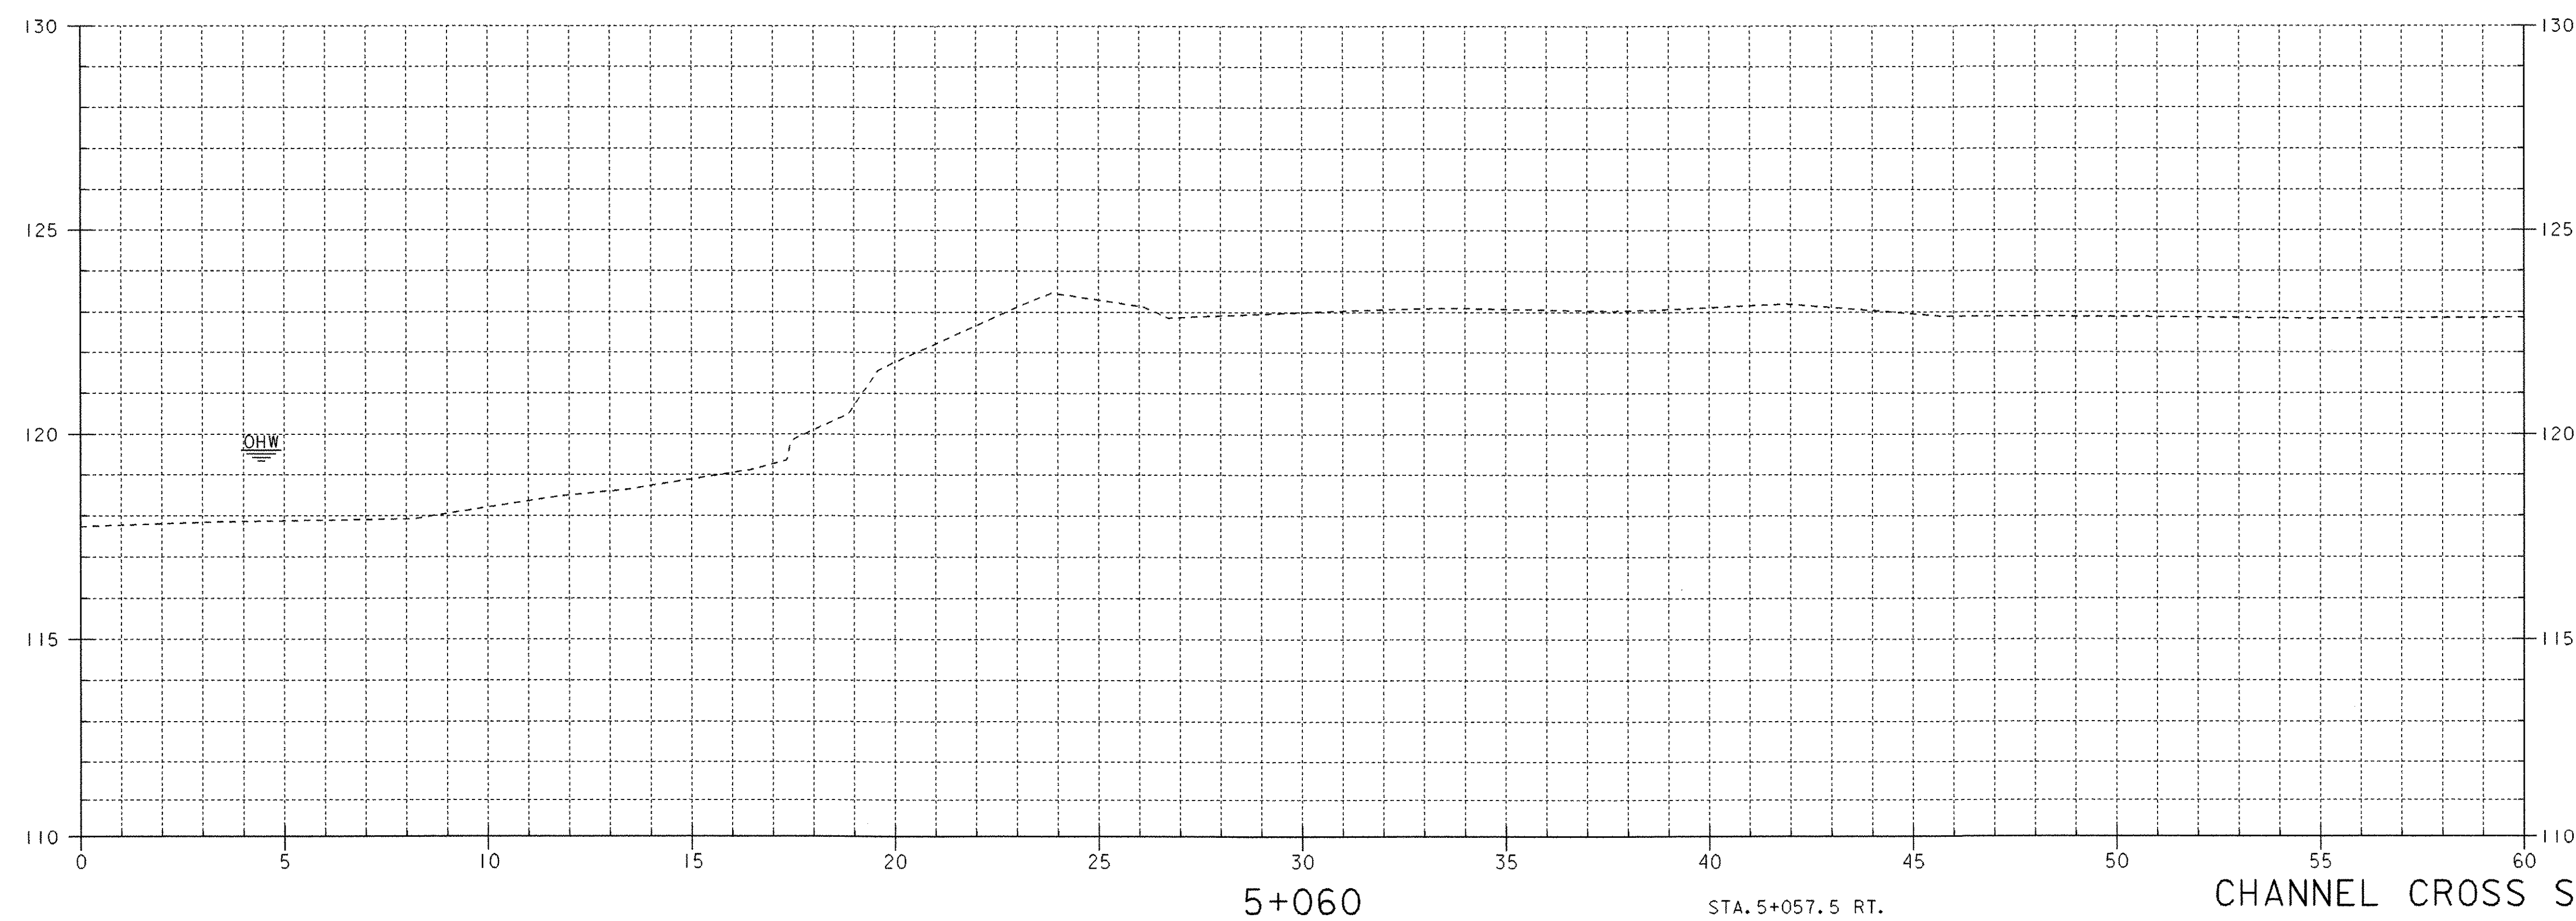


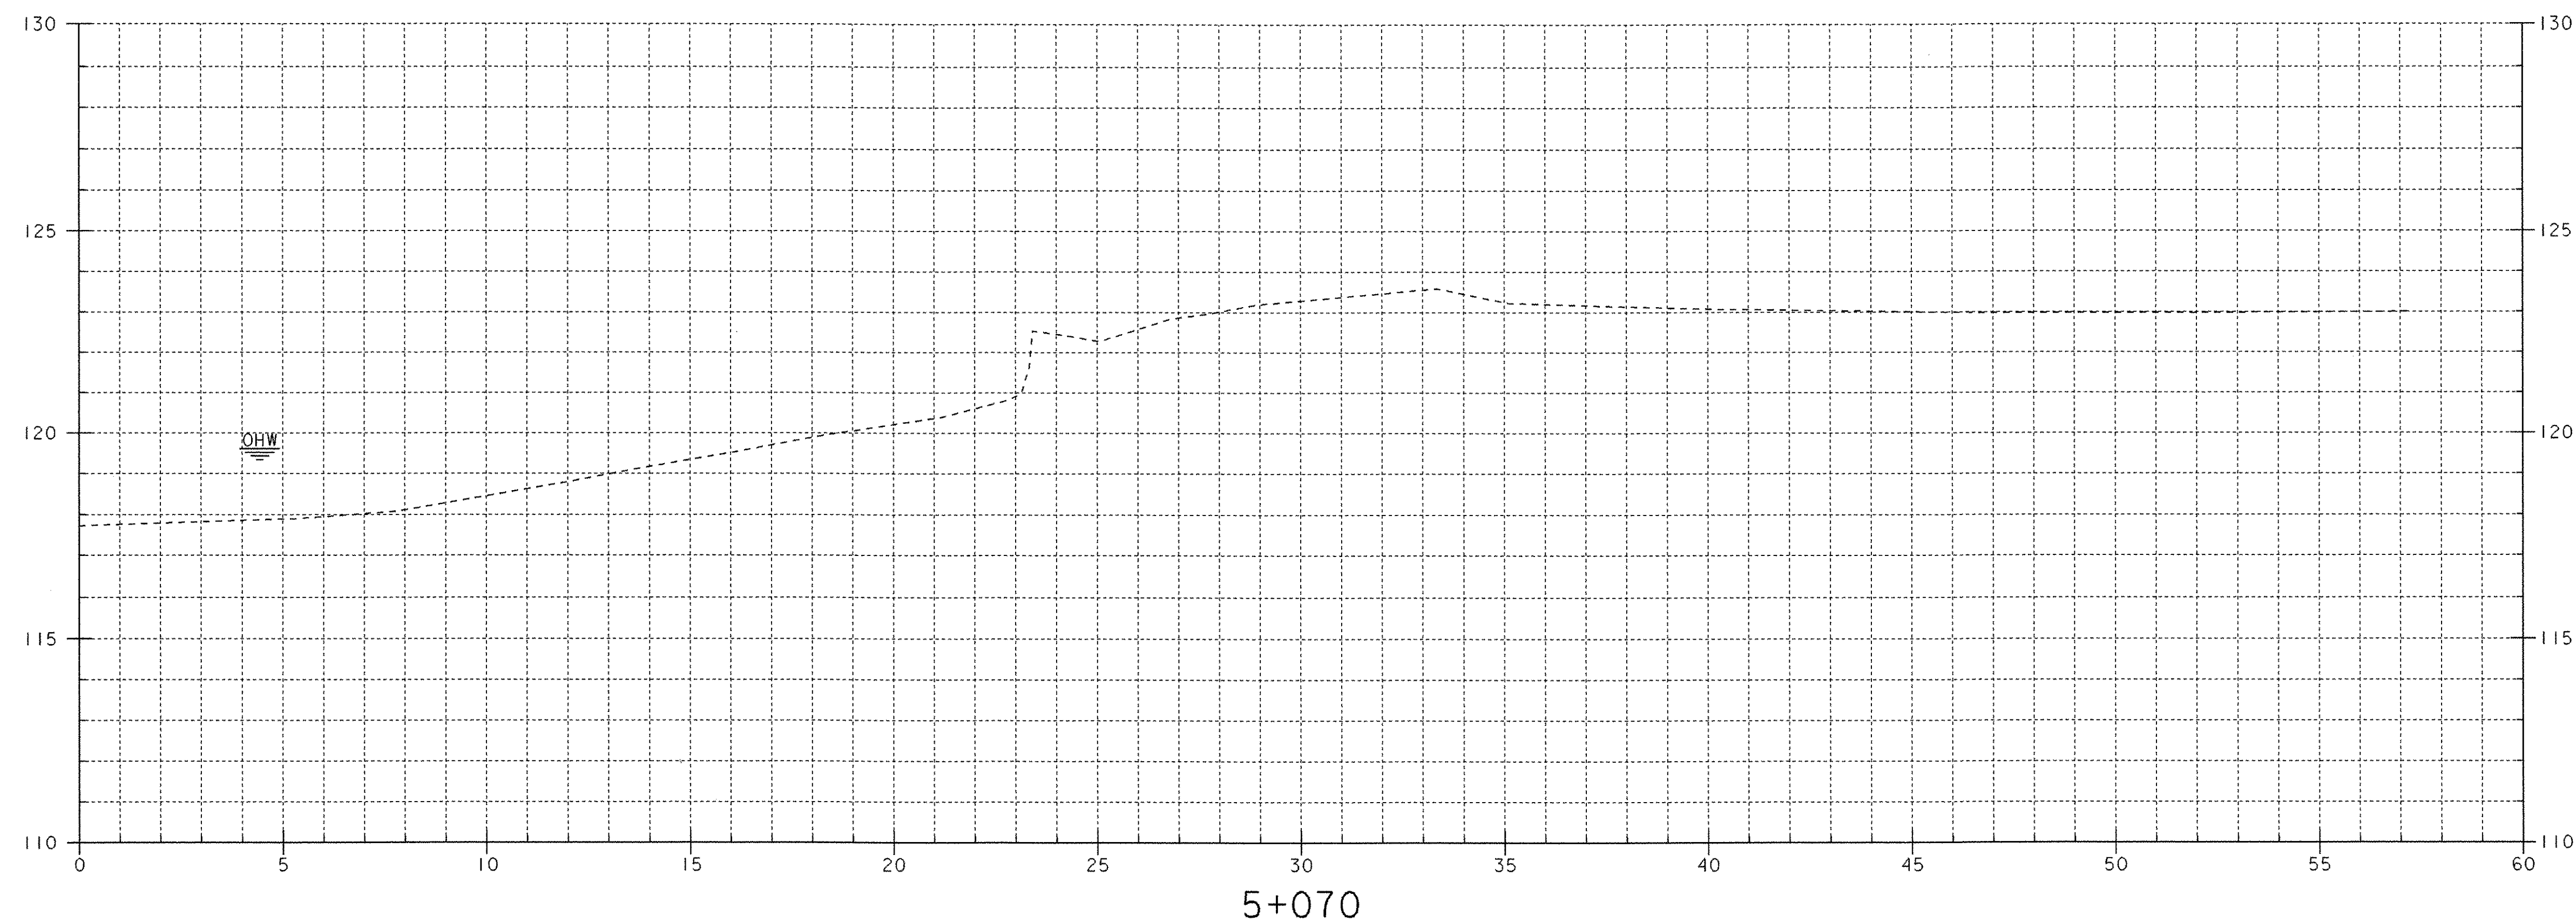

STA. 5+057.5 RT.
END UNCLASS. CHANNEL EXCAVATION
GEOTEXTILE UNDER STONE FILL
STONE FILL, TYPE IV
GRUBBING MATERIAL

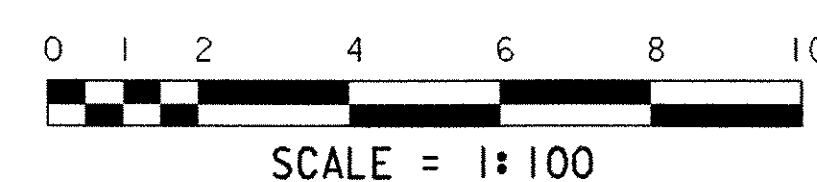

CHANNEL CROSS SECTIONS RIGHT (5)

PROJECT NAME:	BROOKLINE NEWFANE
PROJECT NUMBER:	BH0 1442 (25)
FILE NAME:	95\278\Structures\sj266cll.i
PROJECT MANAGER:	R. R. WHITCOMB
DESIGNED BY:	G. ROY
PLOT DATE:	26-JUN-2003
DRAWN BY:	G. ROY
CHECKED BY:	M. LOZIER
SHEET	66 OF 78