



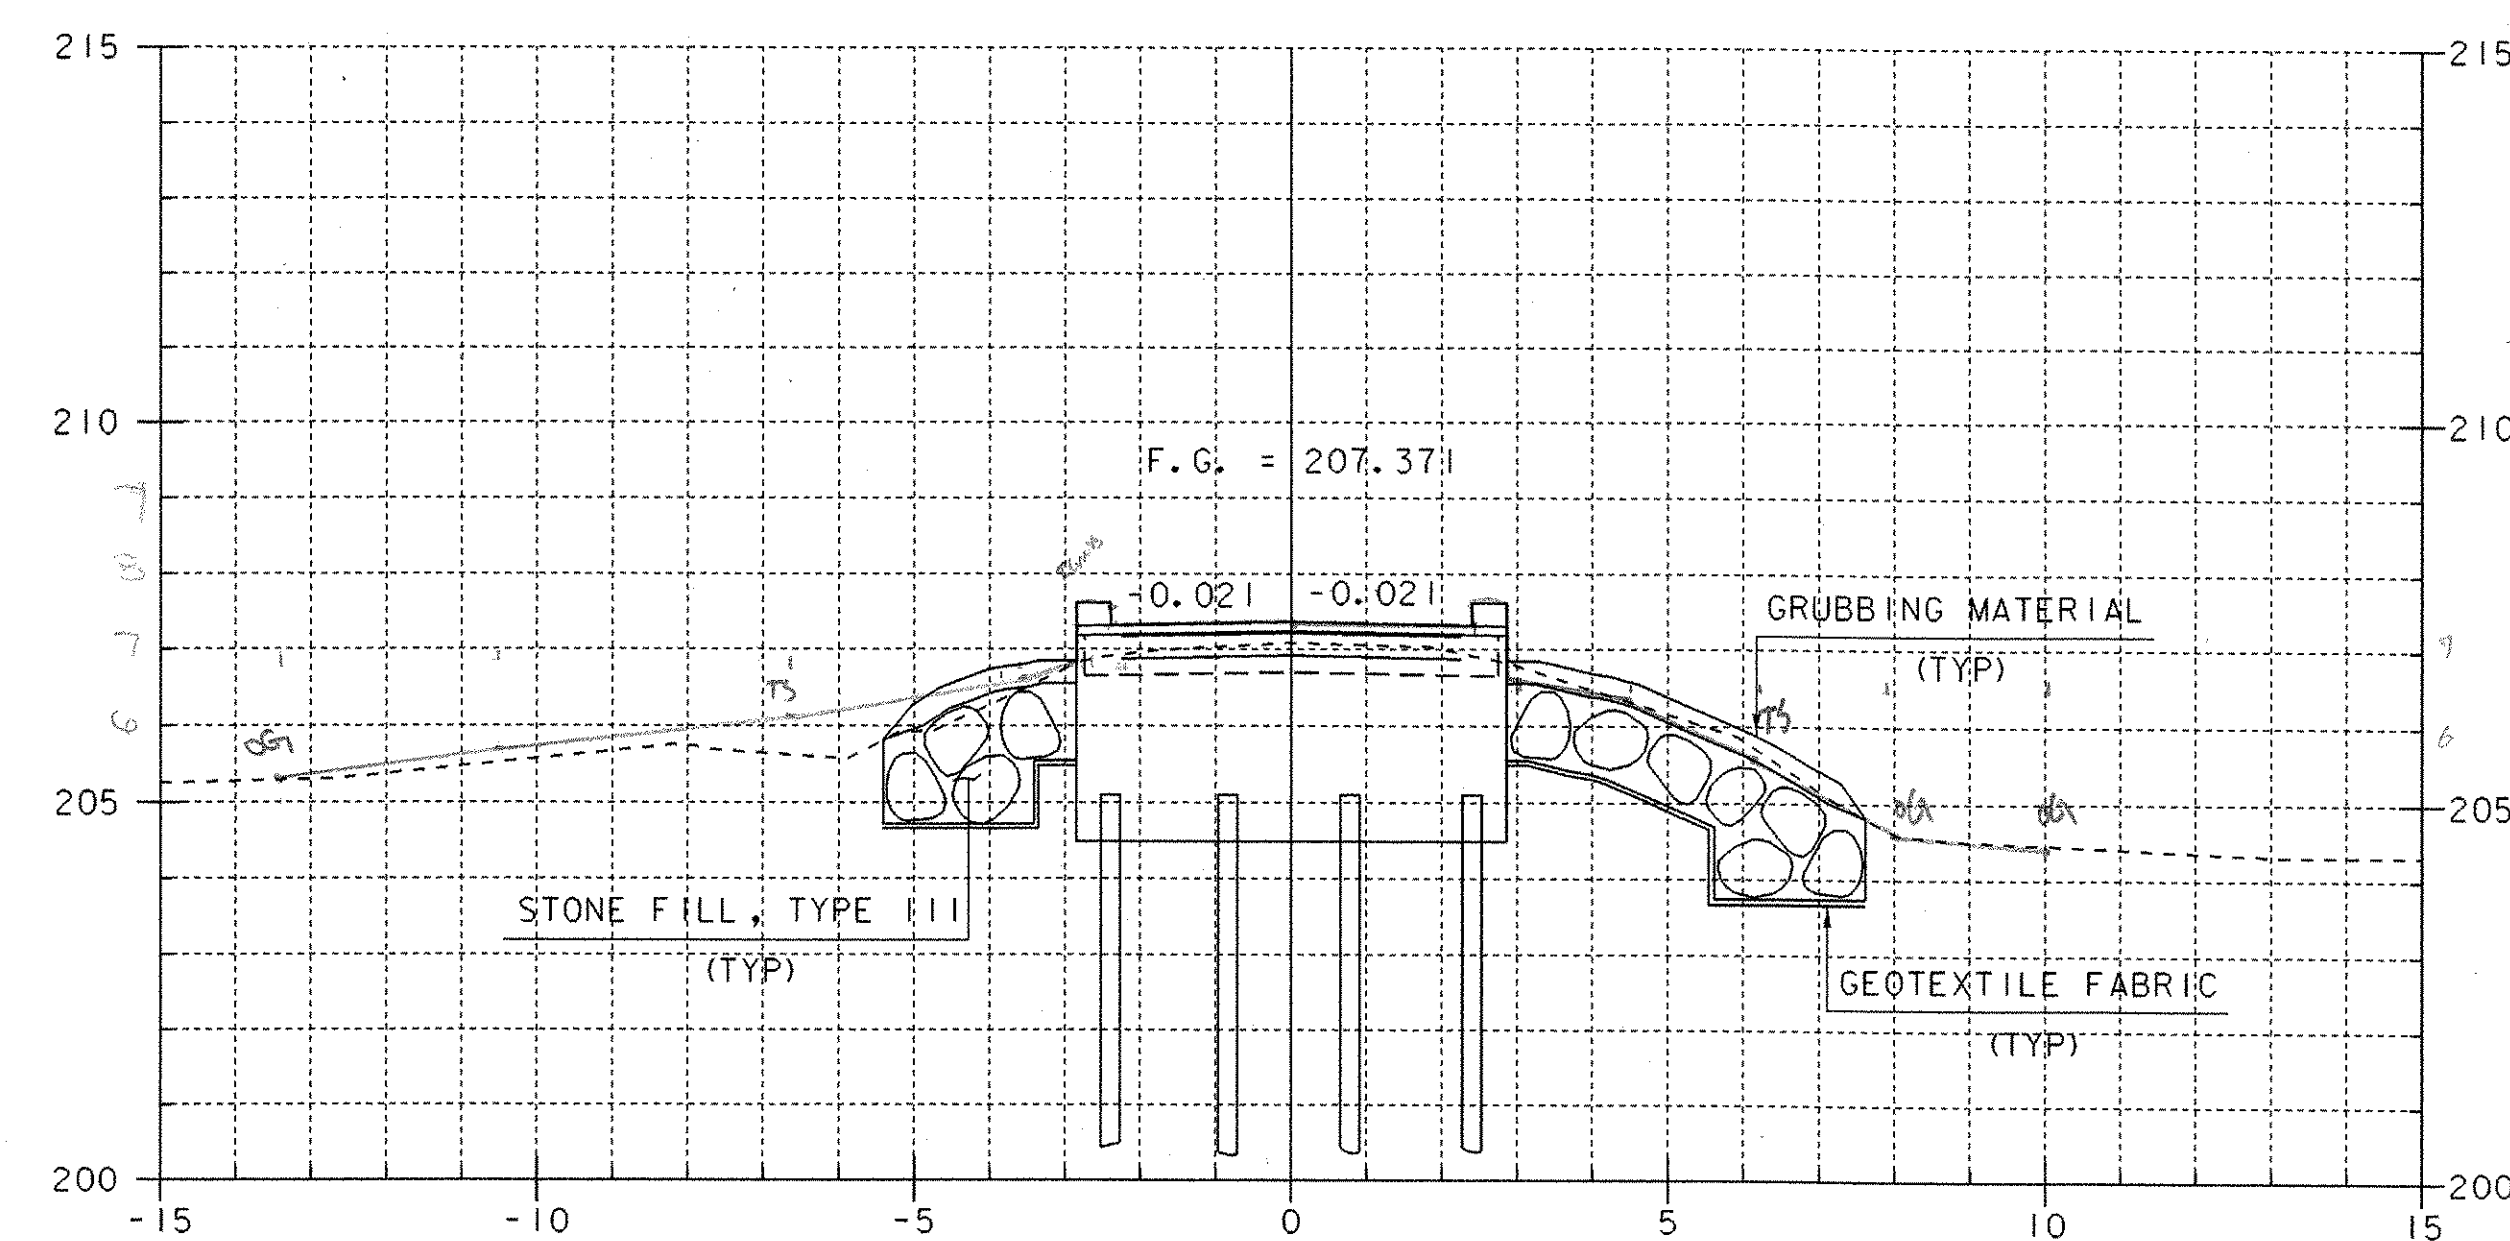


I+038.000
BEGIN BRIDGE


FINAL
SECTIONS
DETAILS ON SURVEY
RISKS BY L. ORRIS
11/1/02
DATA
2/9/02

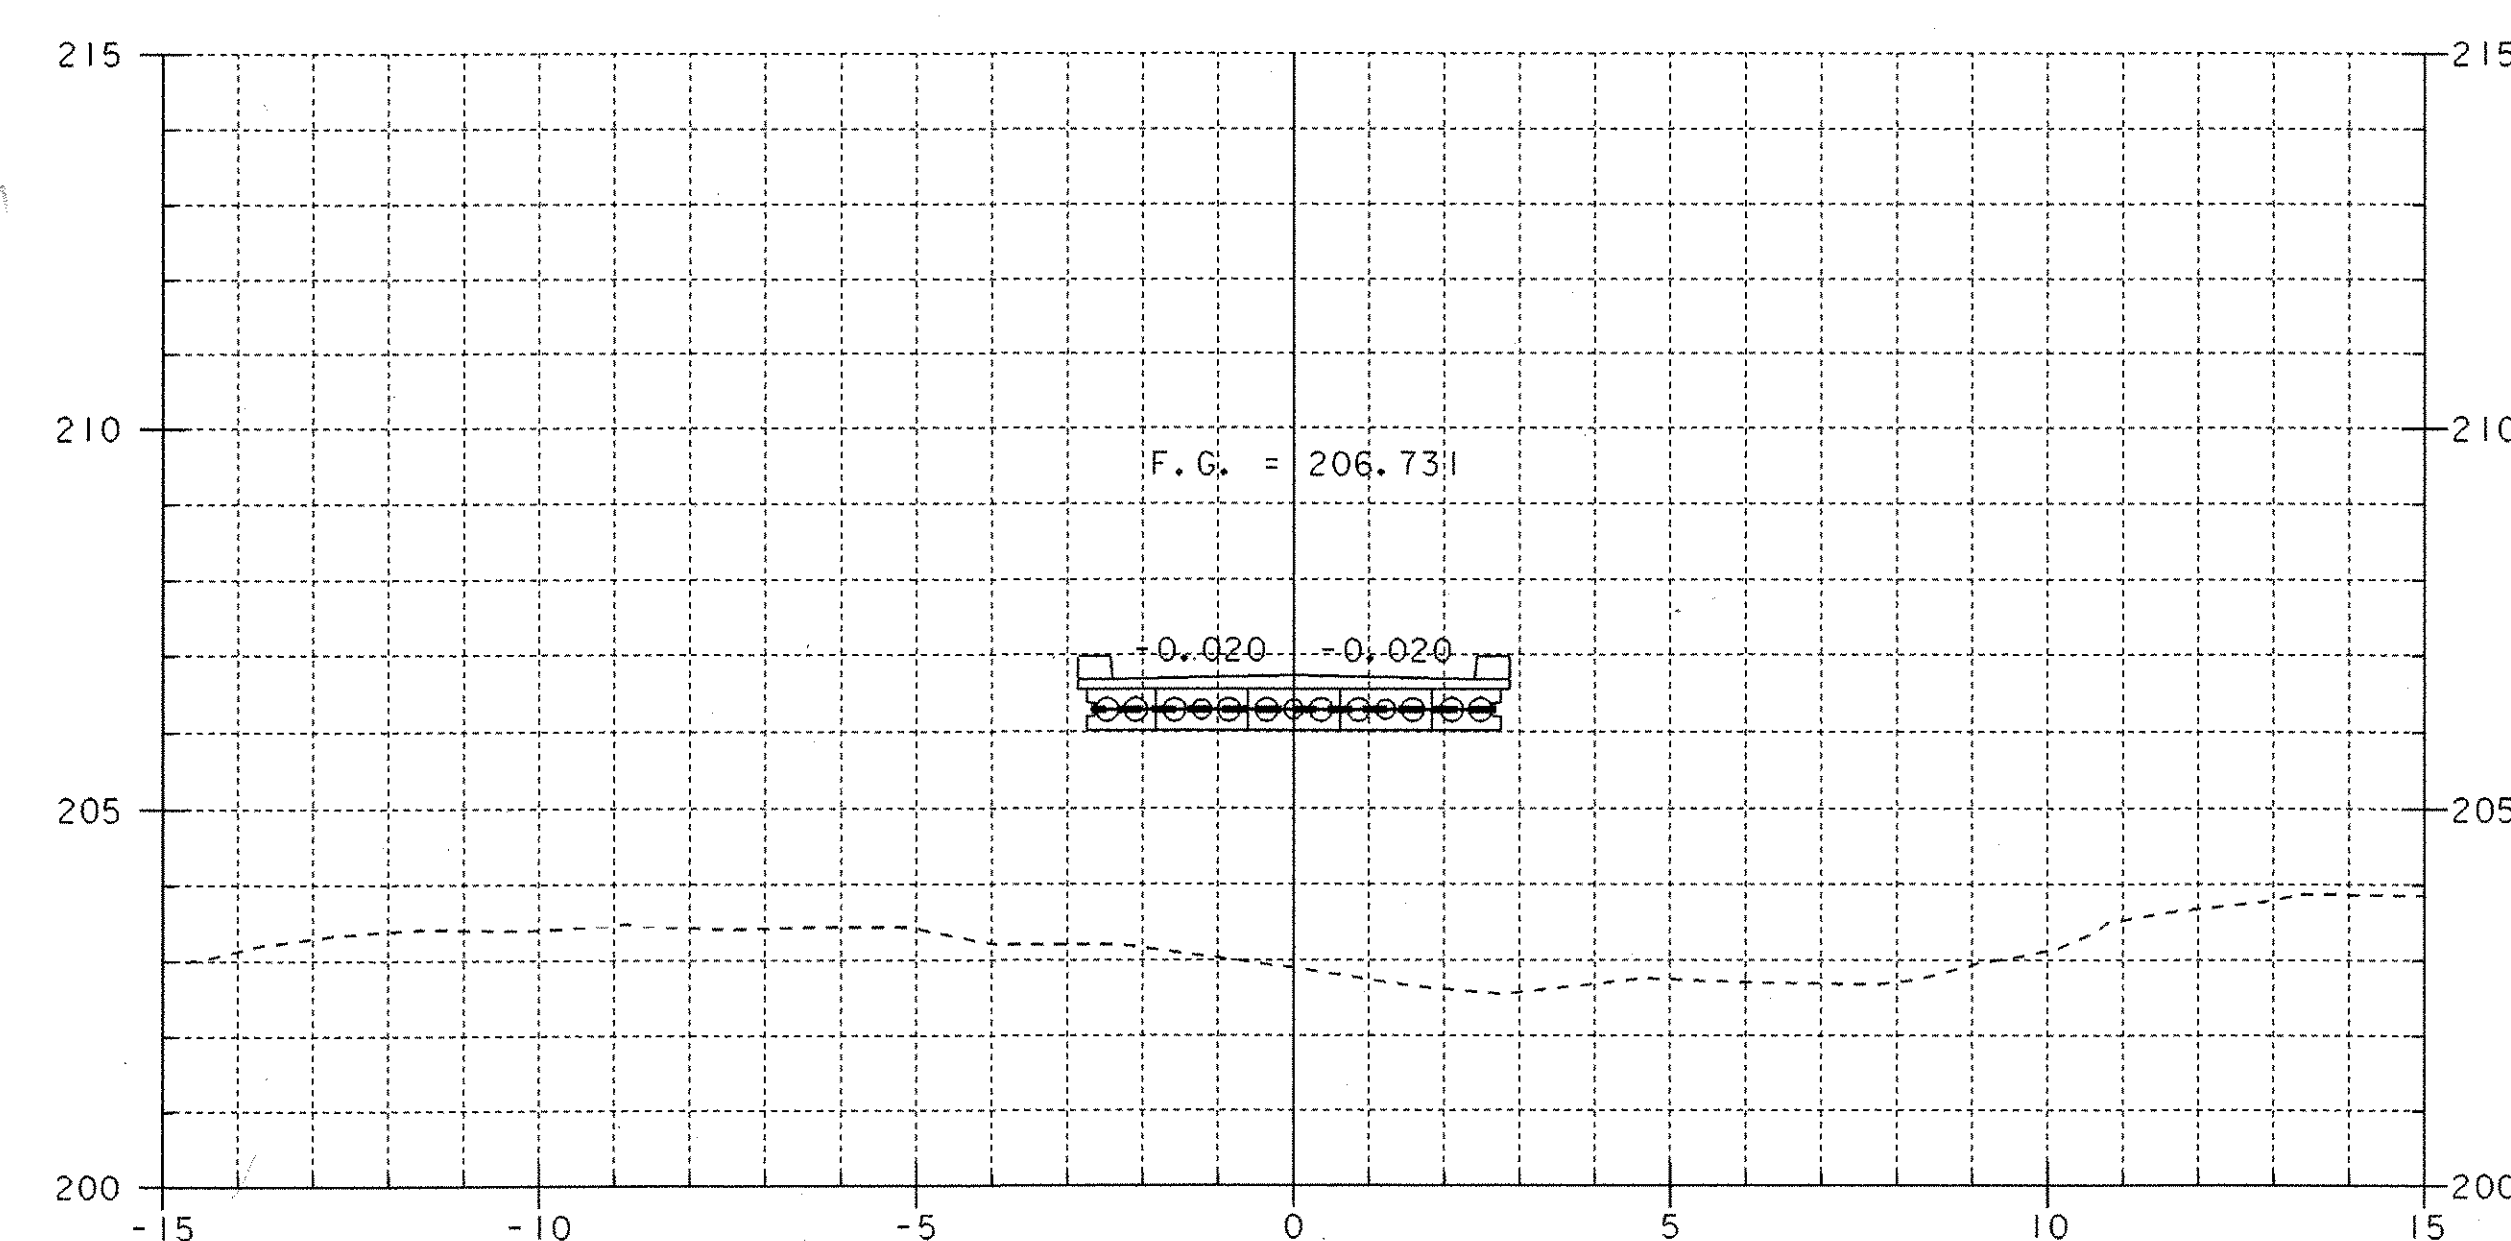

I+050

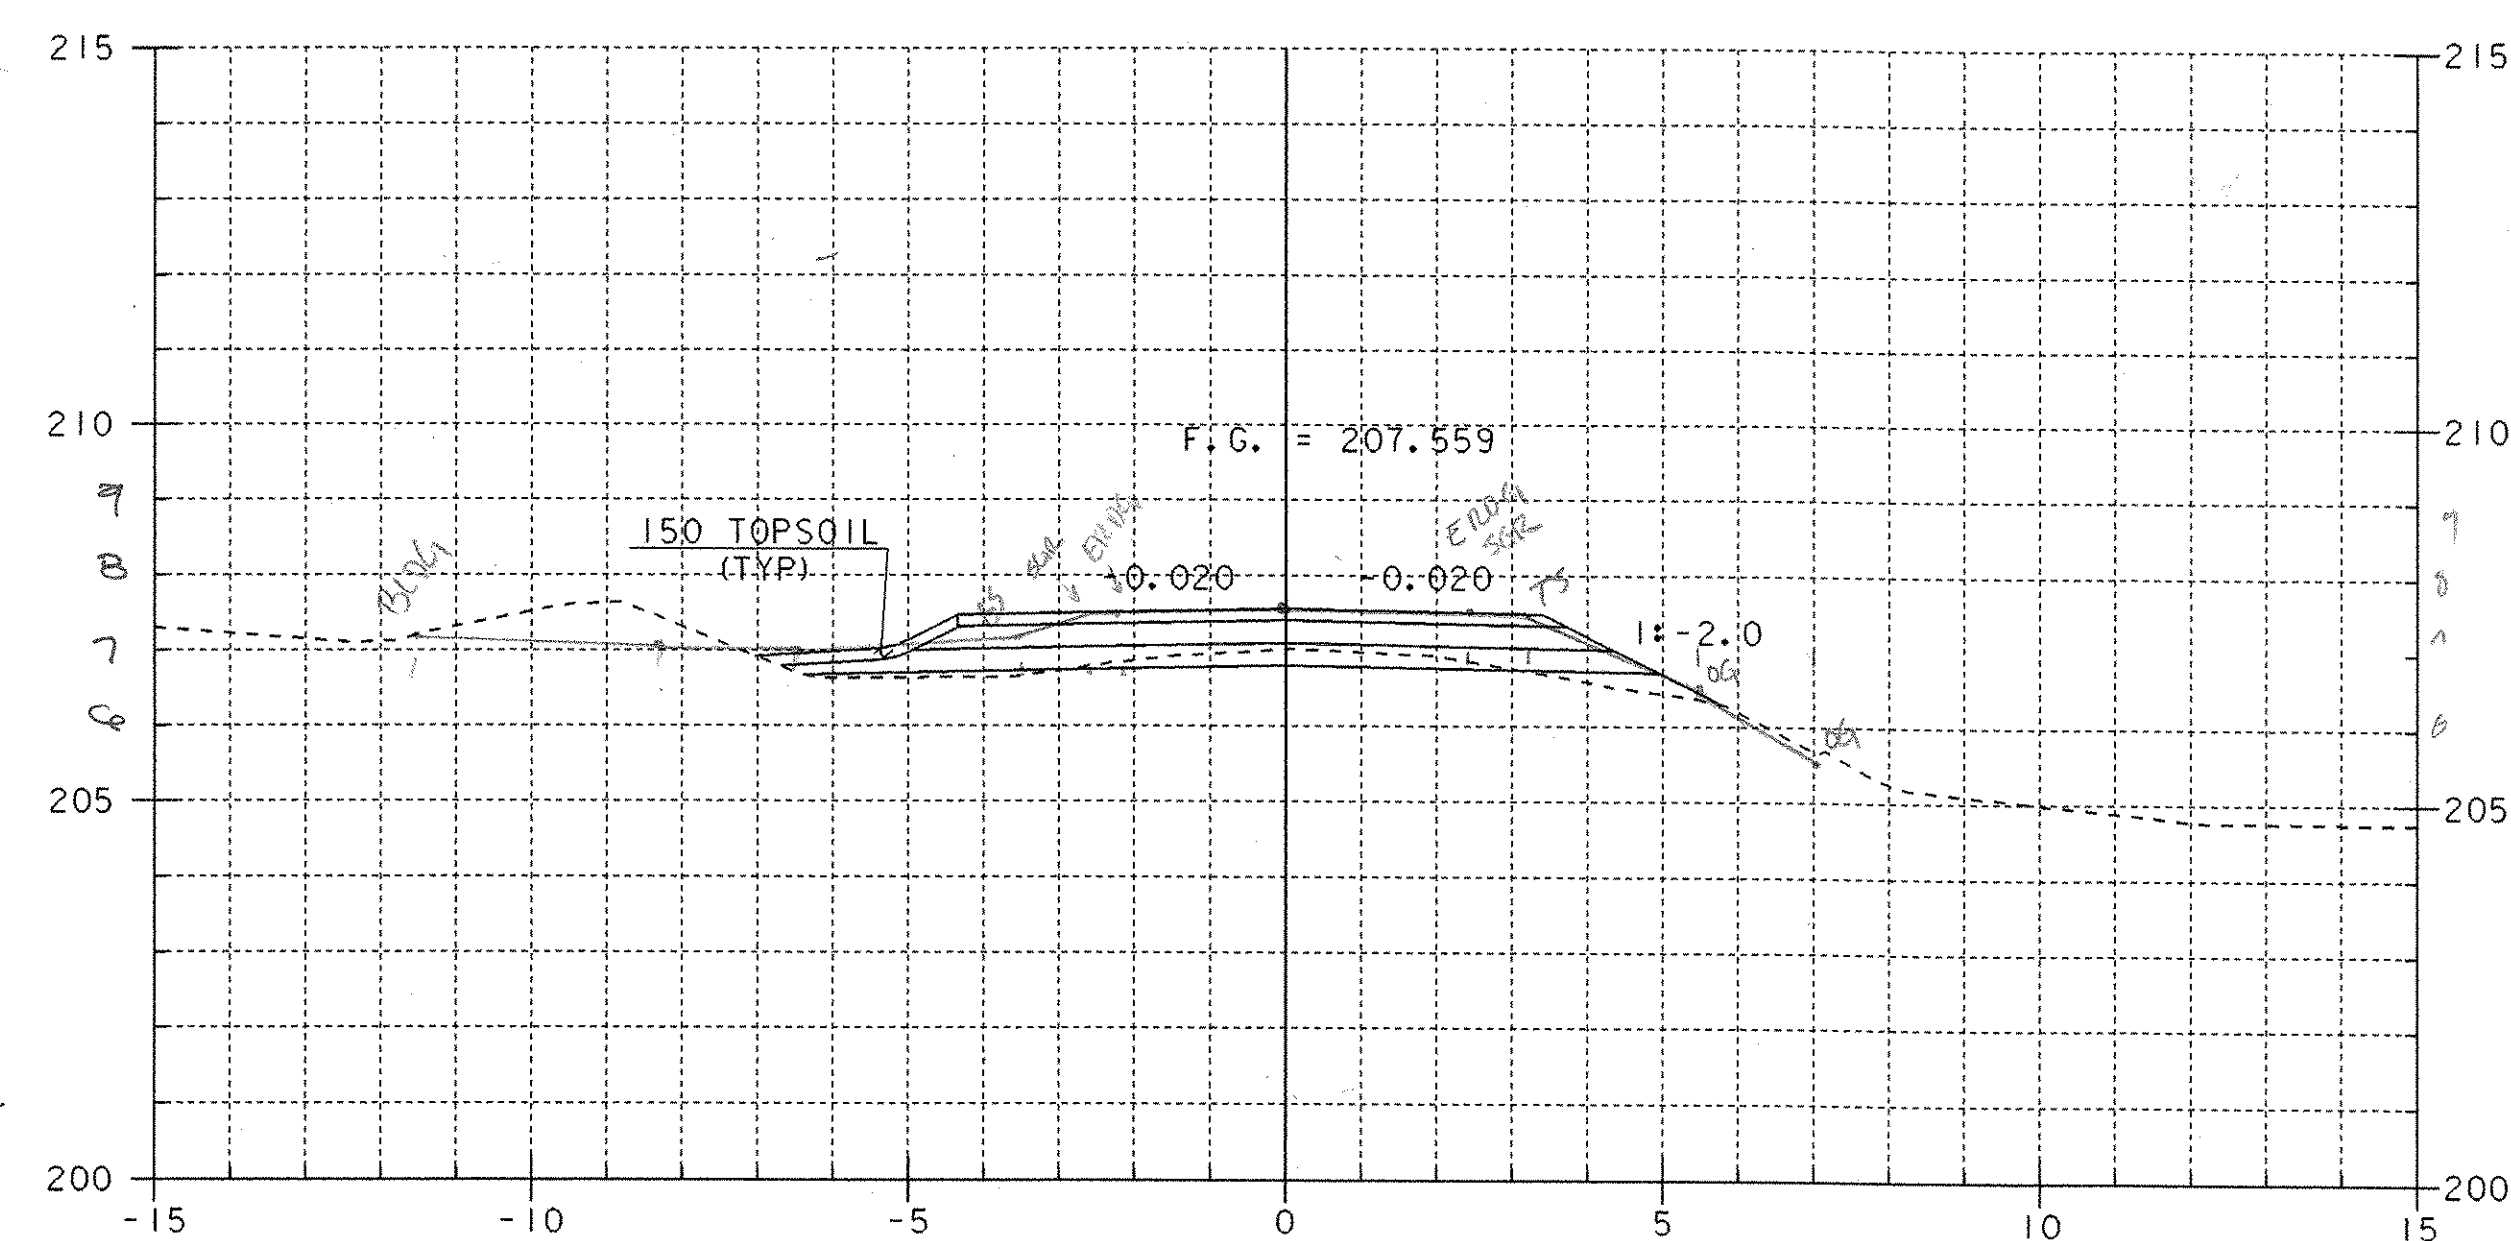

I+030

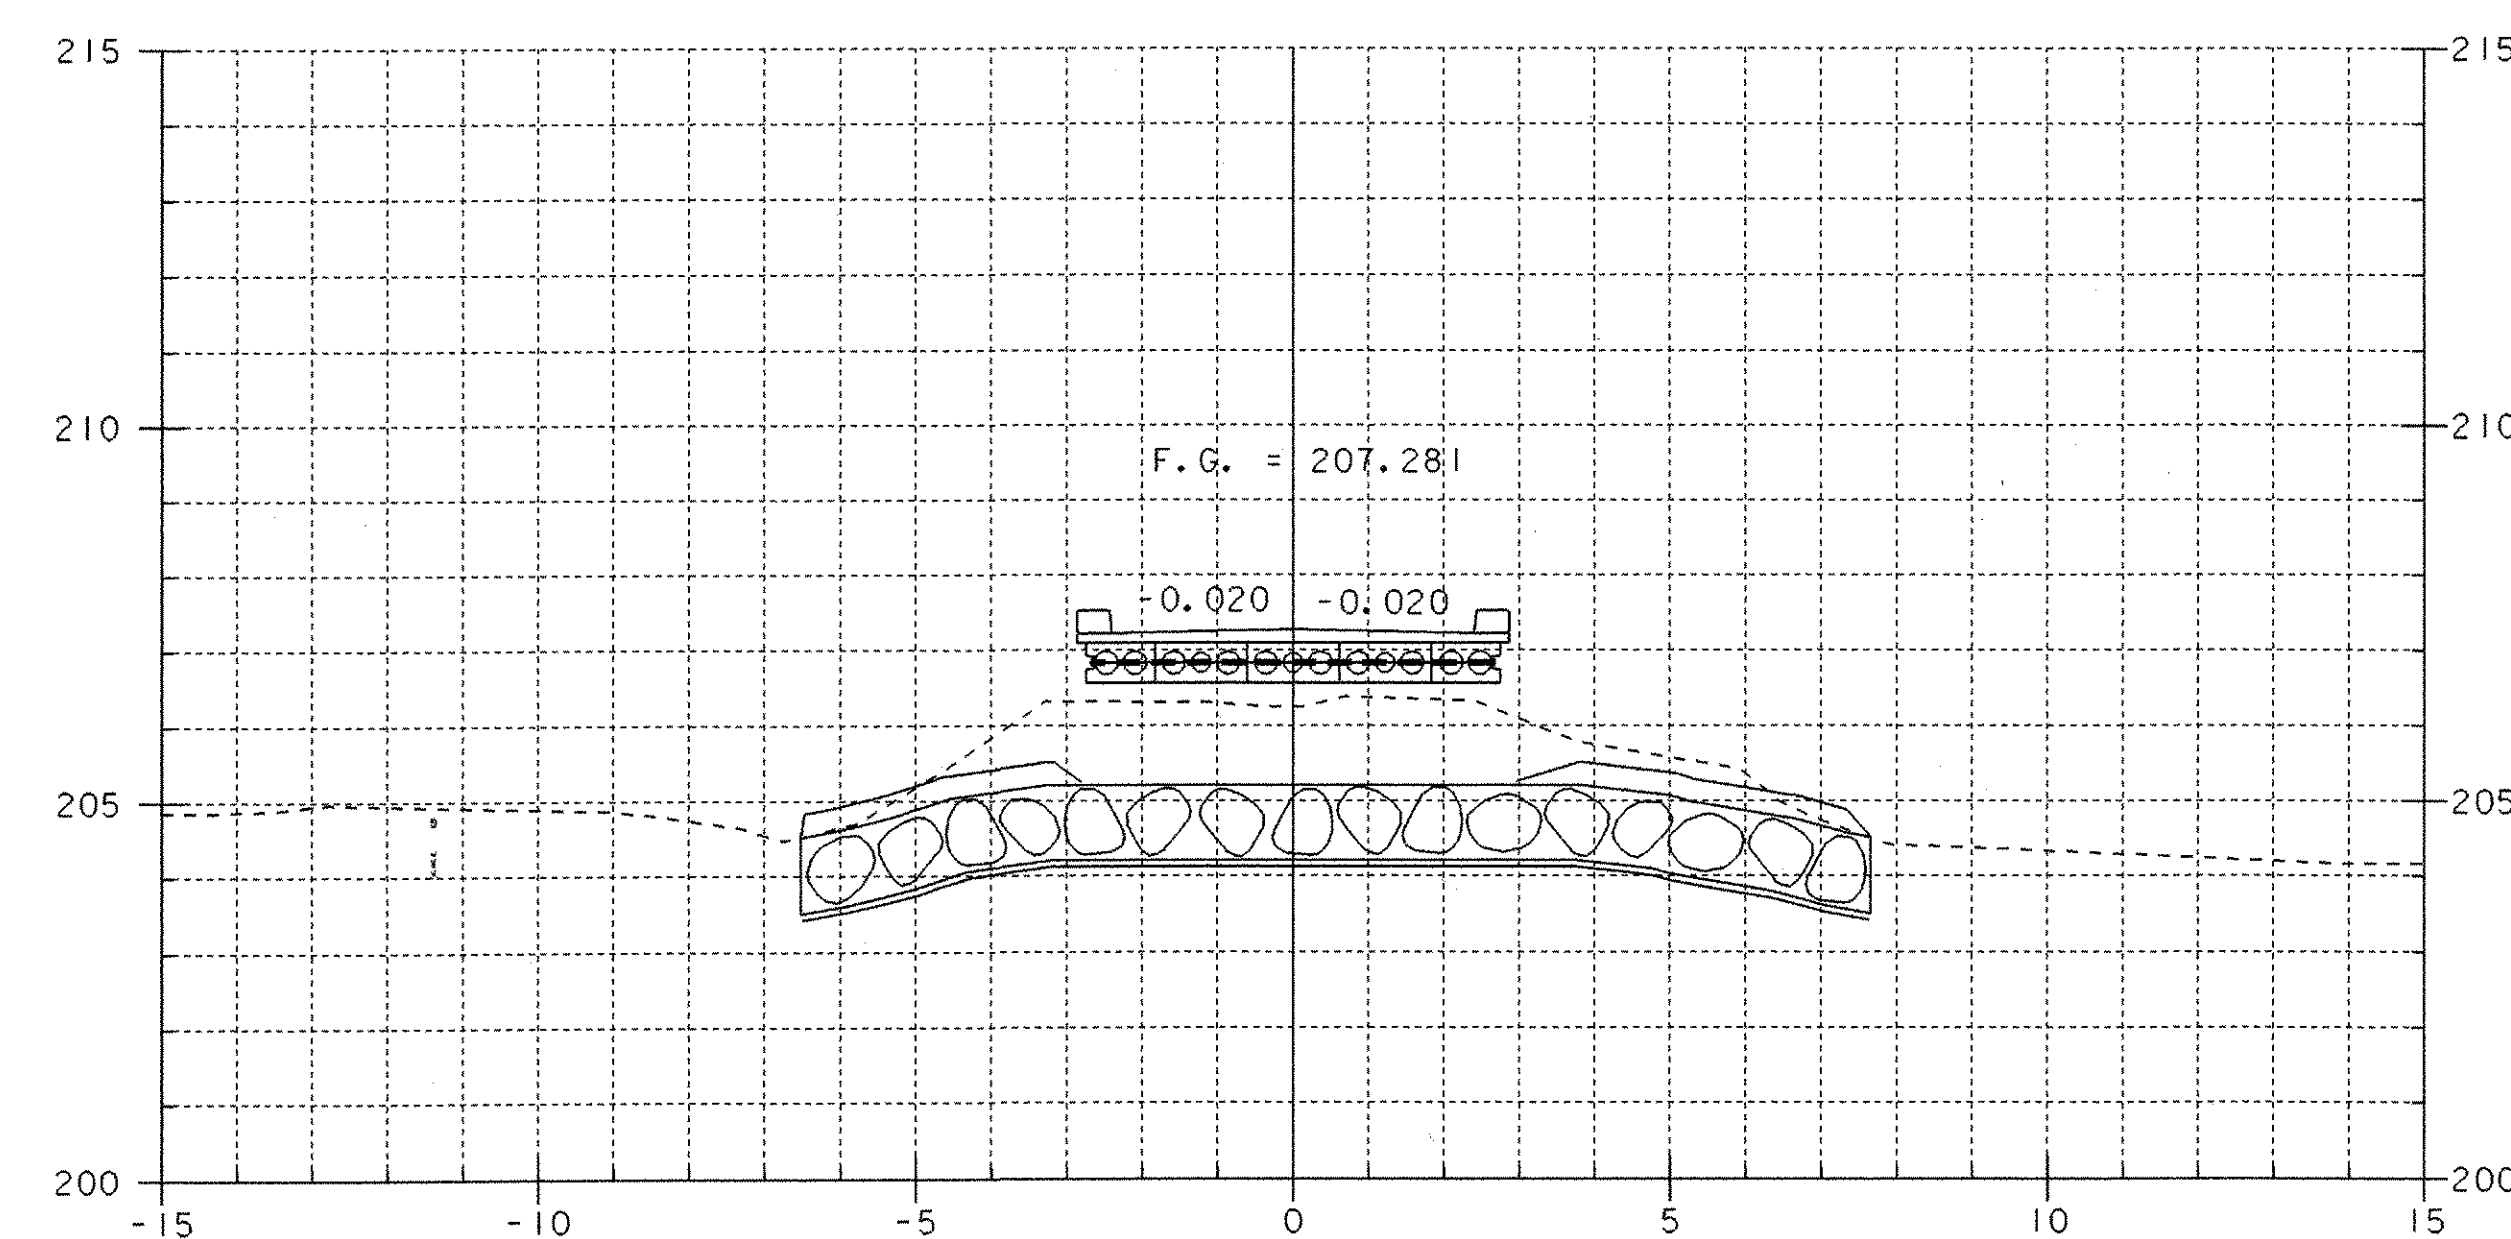

I+040

SHEET NAME: MAINLINE SECTIONS			
PROJECT NAME: CLARENDON	HIGHWAY NO.: TH 16		
PROJECT NUMBER: BRO 1443(34)	BRIDGE NO.: 24		
	OVER: CLARENDON RIVER		
FILE NAME: /PW/95J286/sj286xsl.dgn	PLOT DATE: 01-DEC-2005		
PROJECT MANAGER: R. WHITCOMB	DRAWN BY: STRI		
DESIGNED BY: C. CARLSON	IPARM NAME: sj286m2.1		
BRIDGE SHEET NUMBER:	SHEET 38 OF 43		