



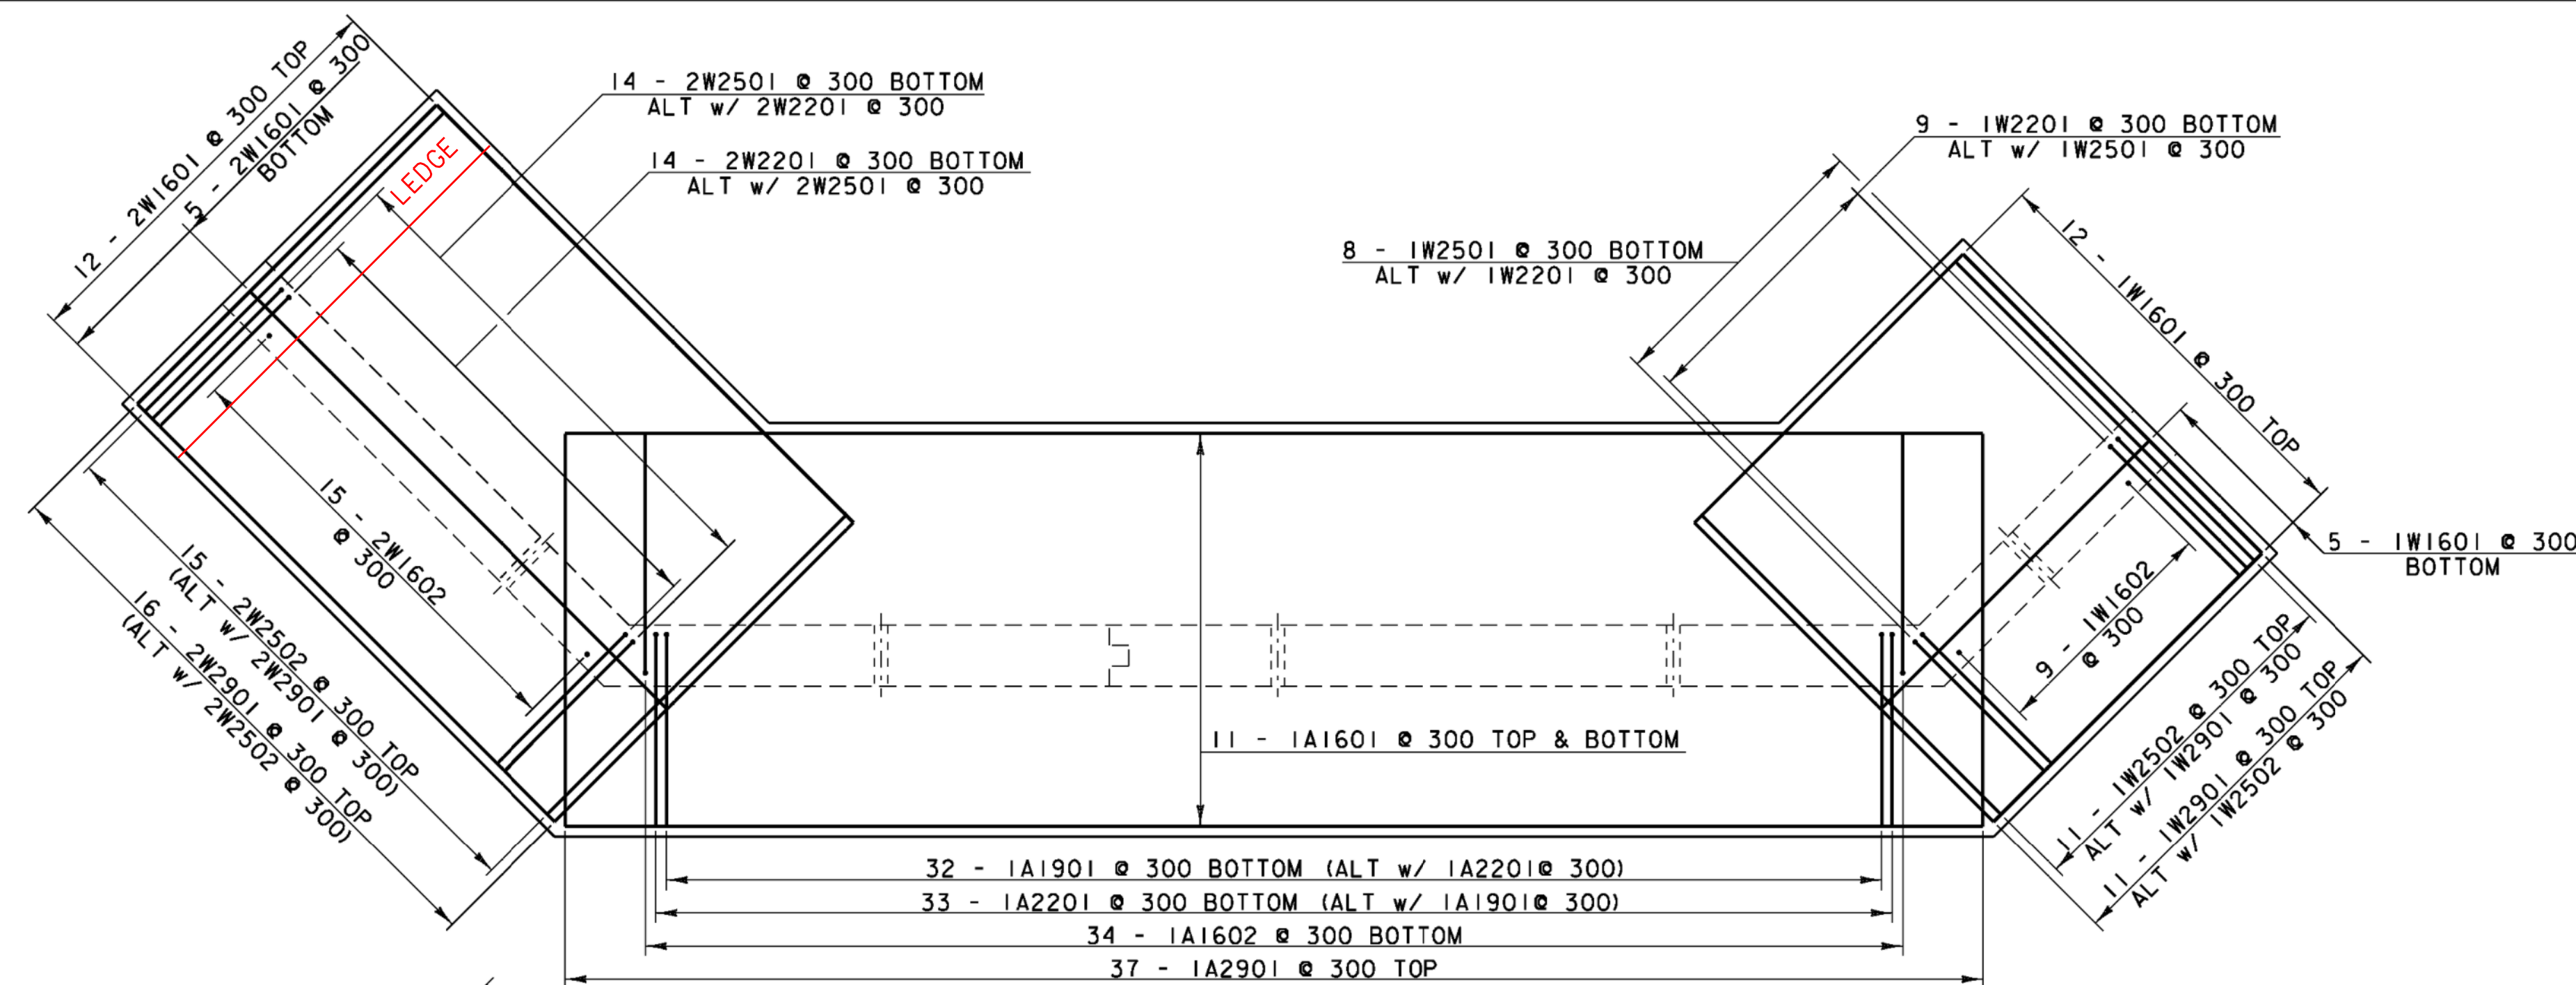


ABUTMENT #1 FOOTING REINFORCEMENT PLAN
SCALE: 1:40

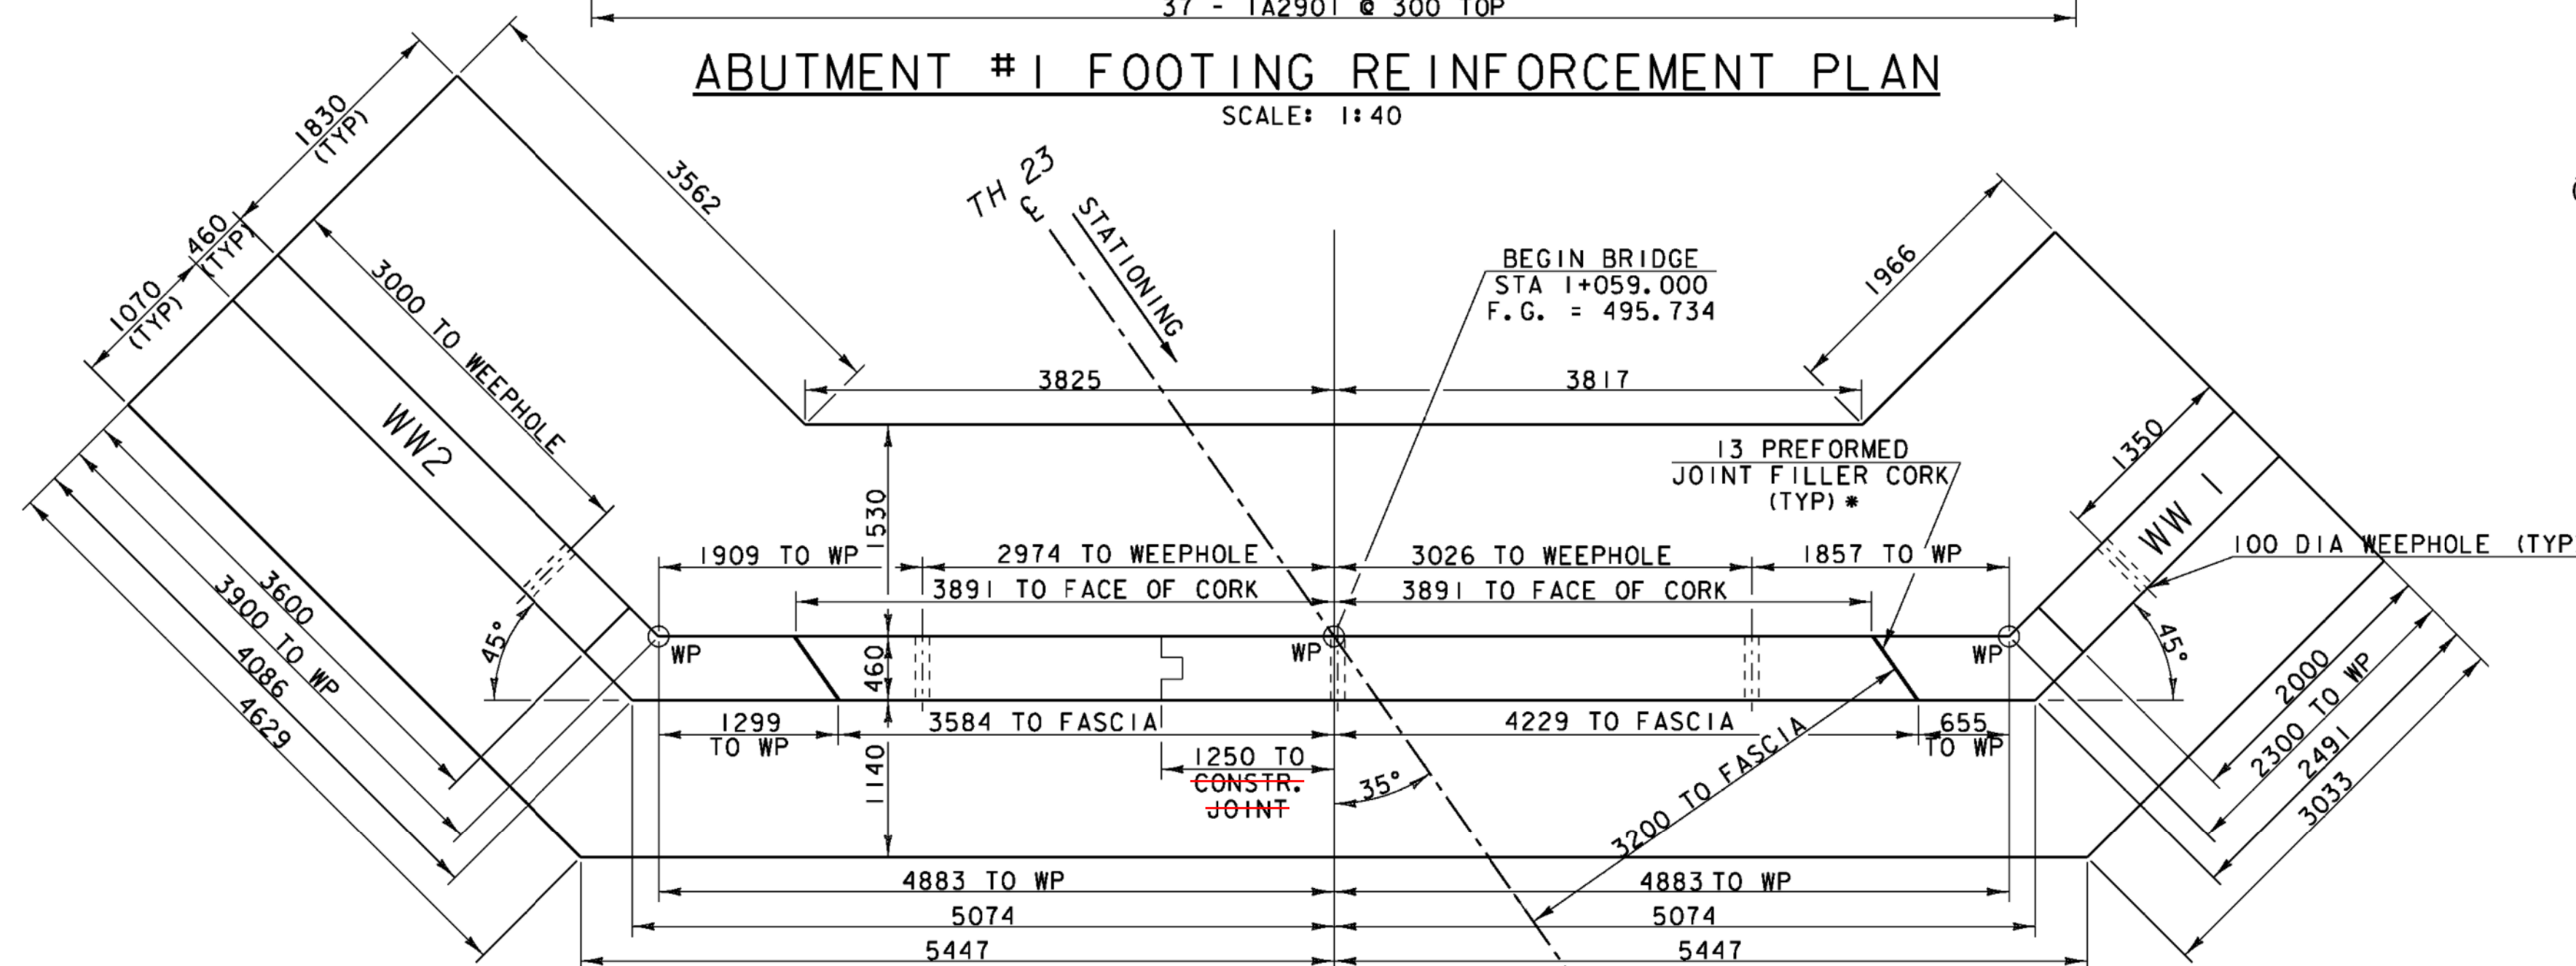


ABUTMENT #1 PLAN
SCALE: 1:40


*SEE NOTE 9

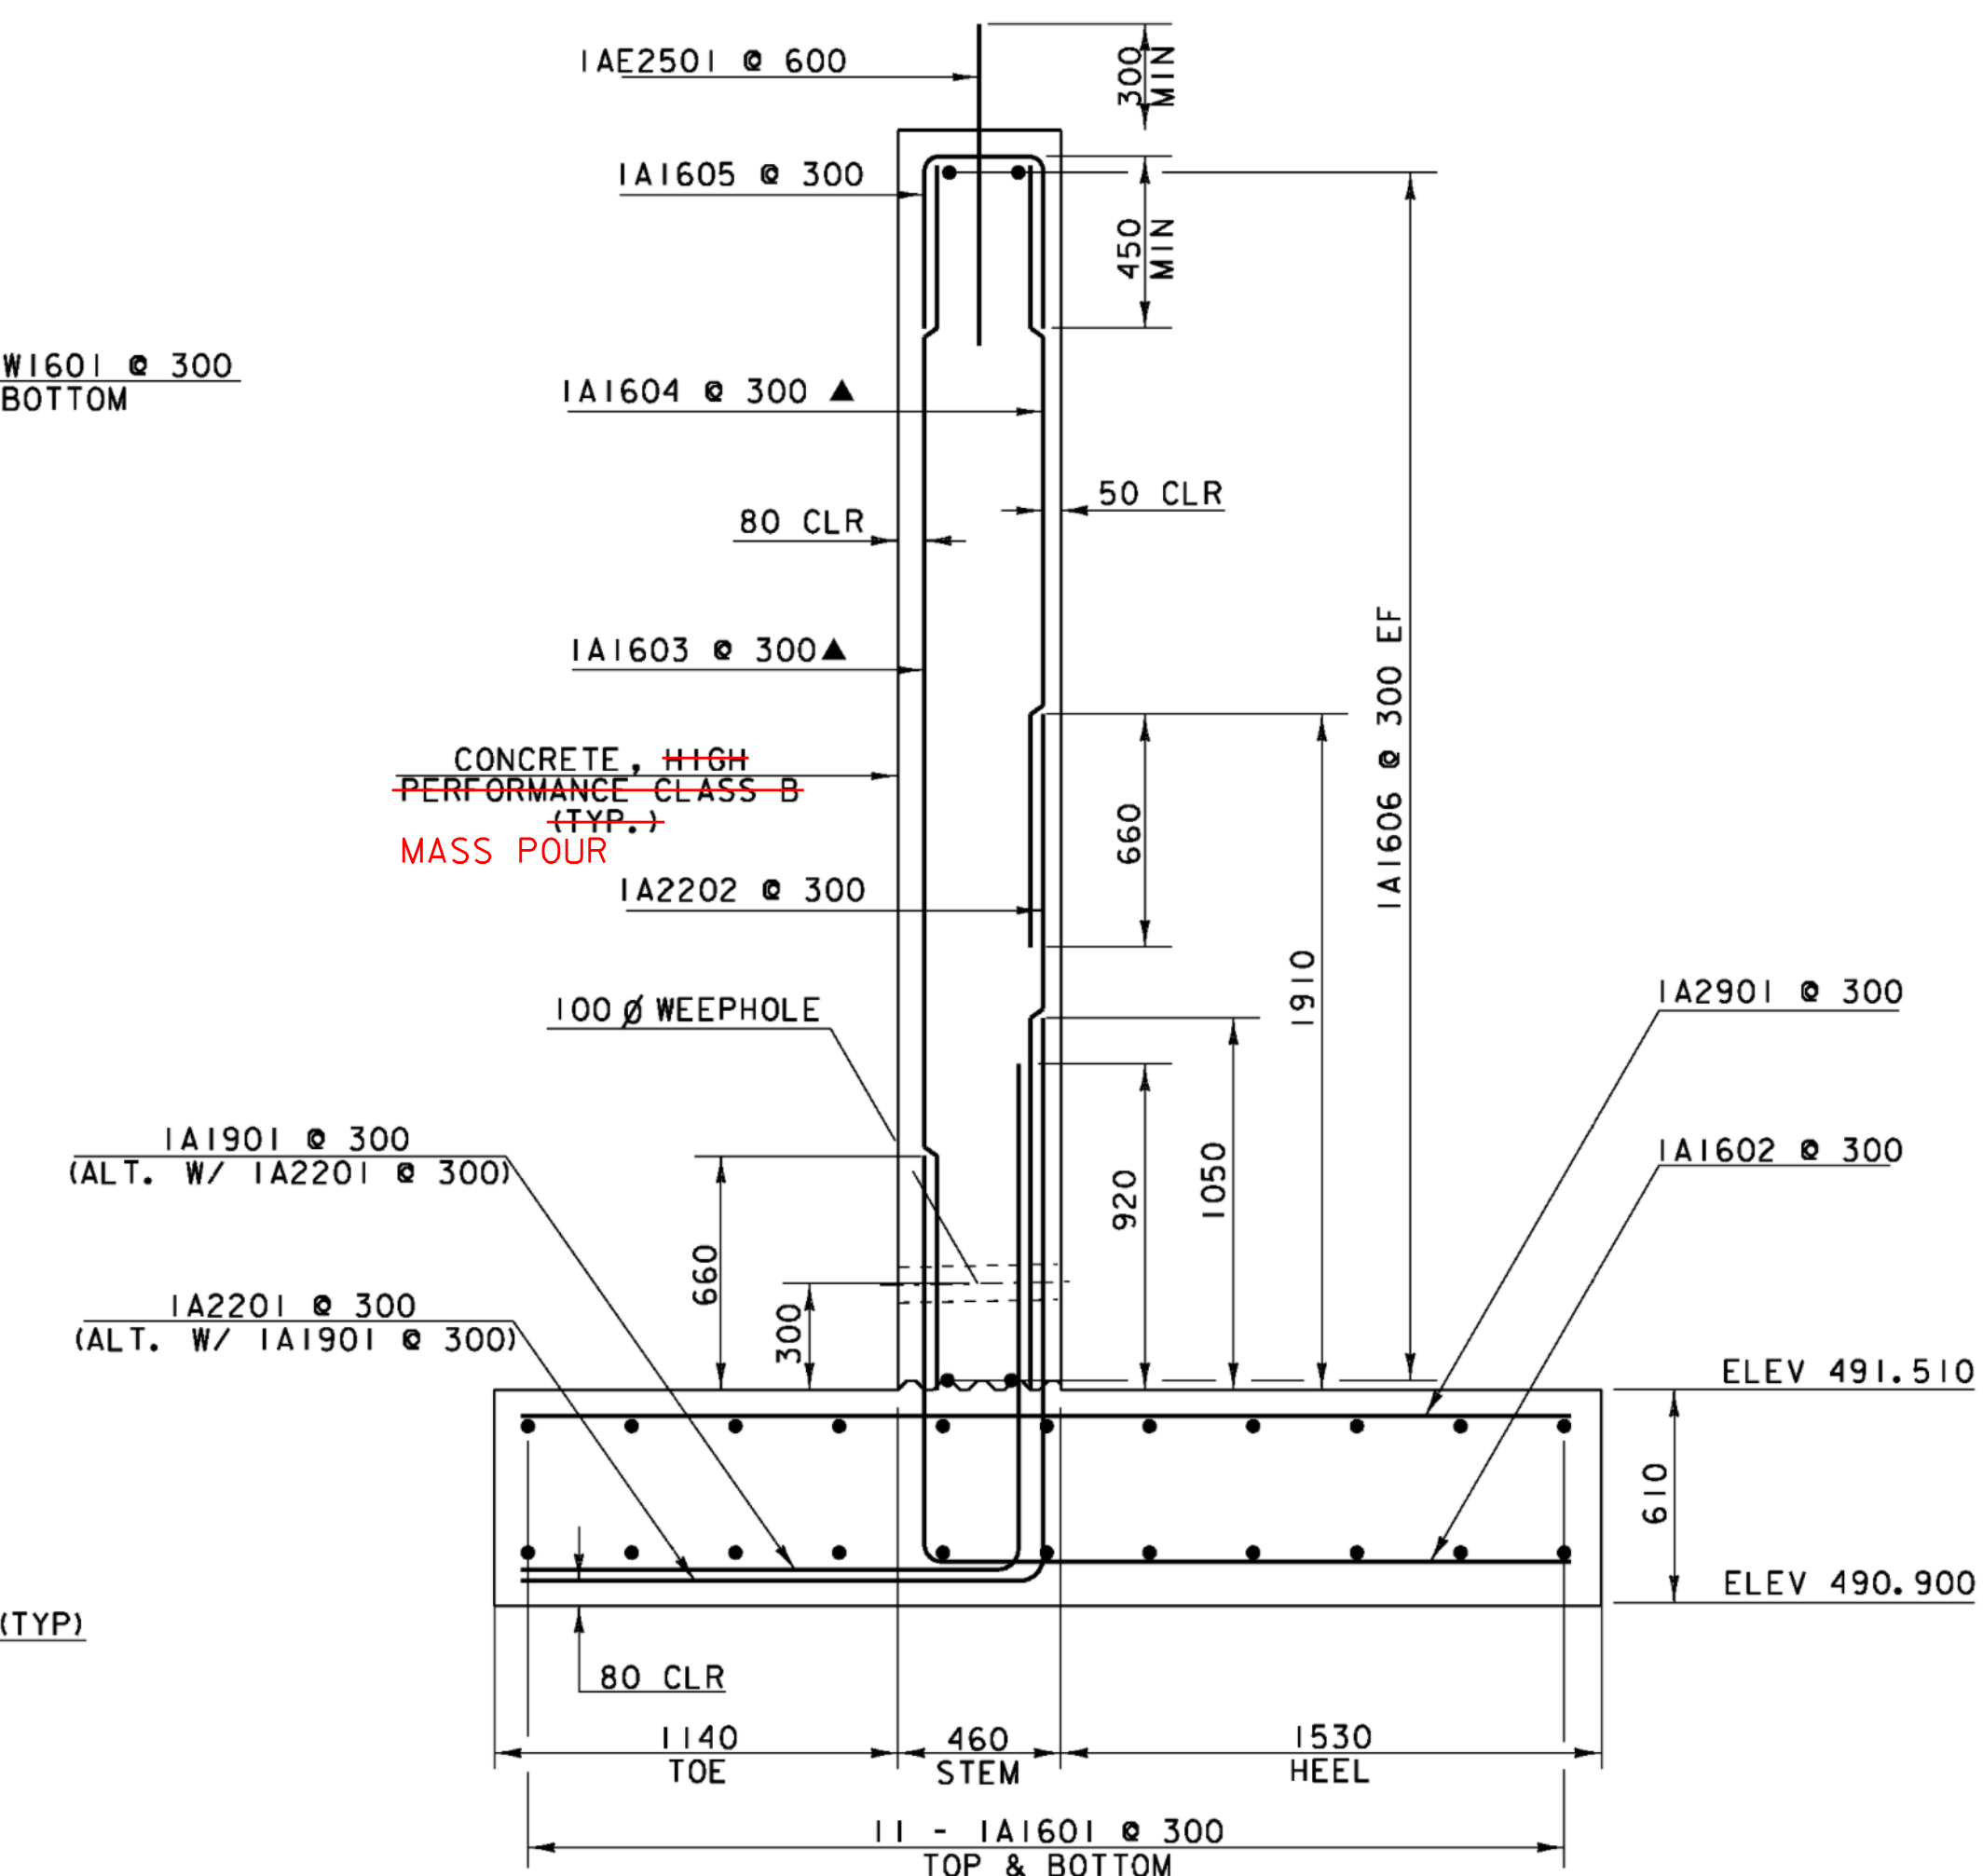

ABUTMENT NO.1 TYPICAL SECTION
SCALE: 1:20

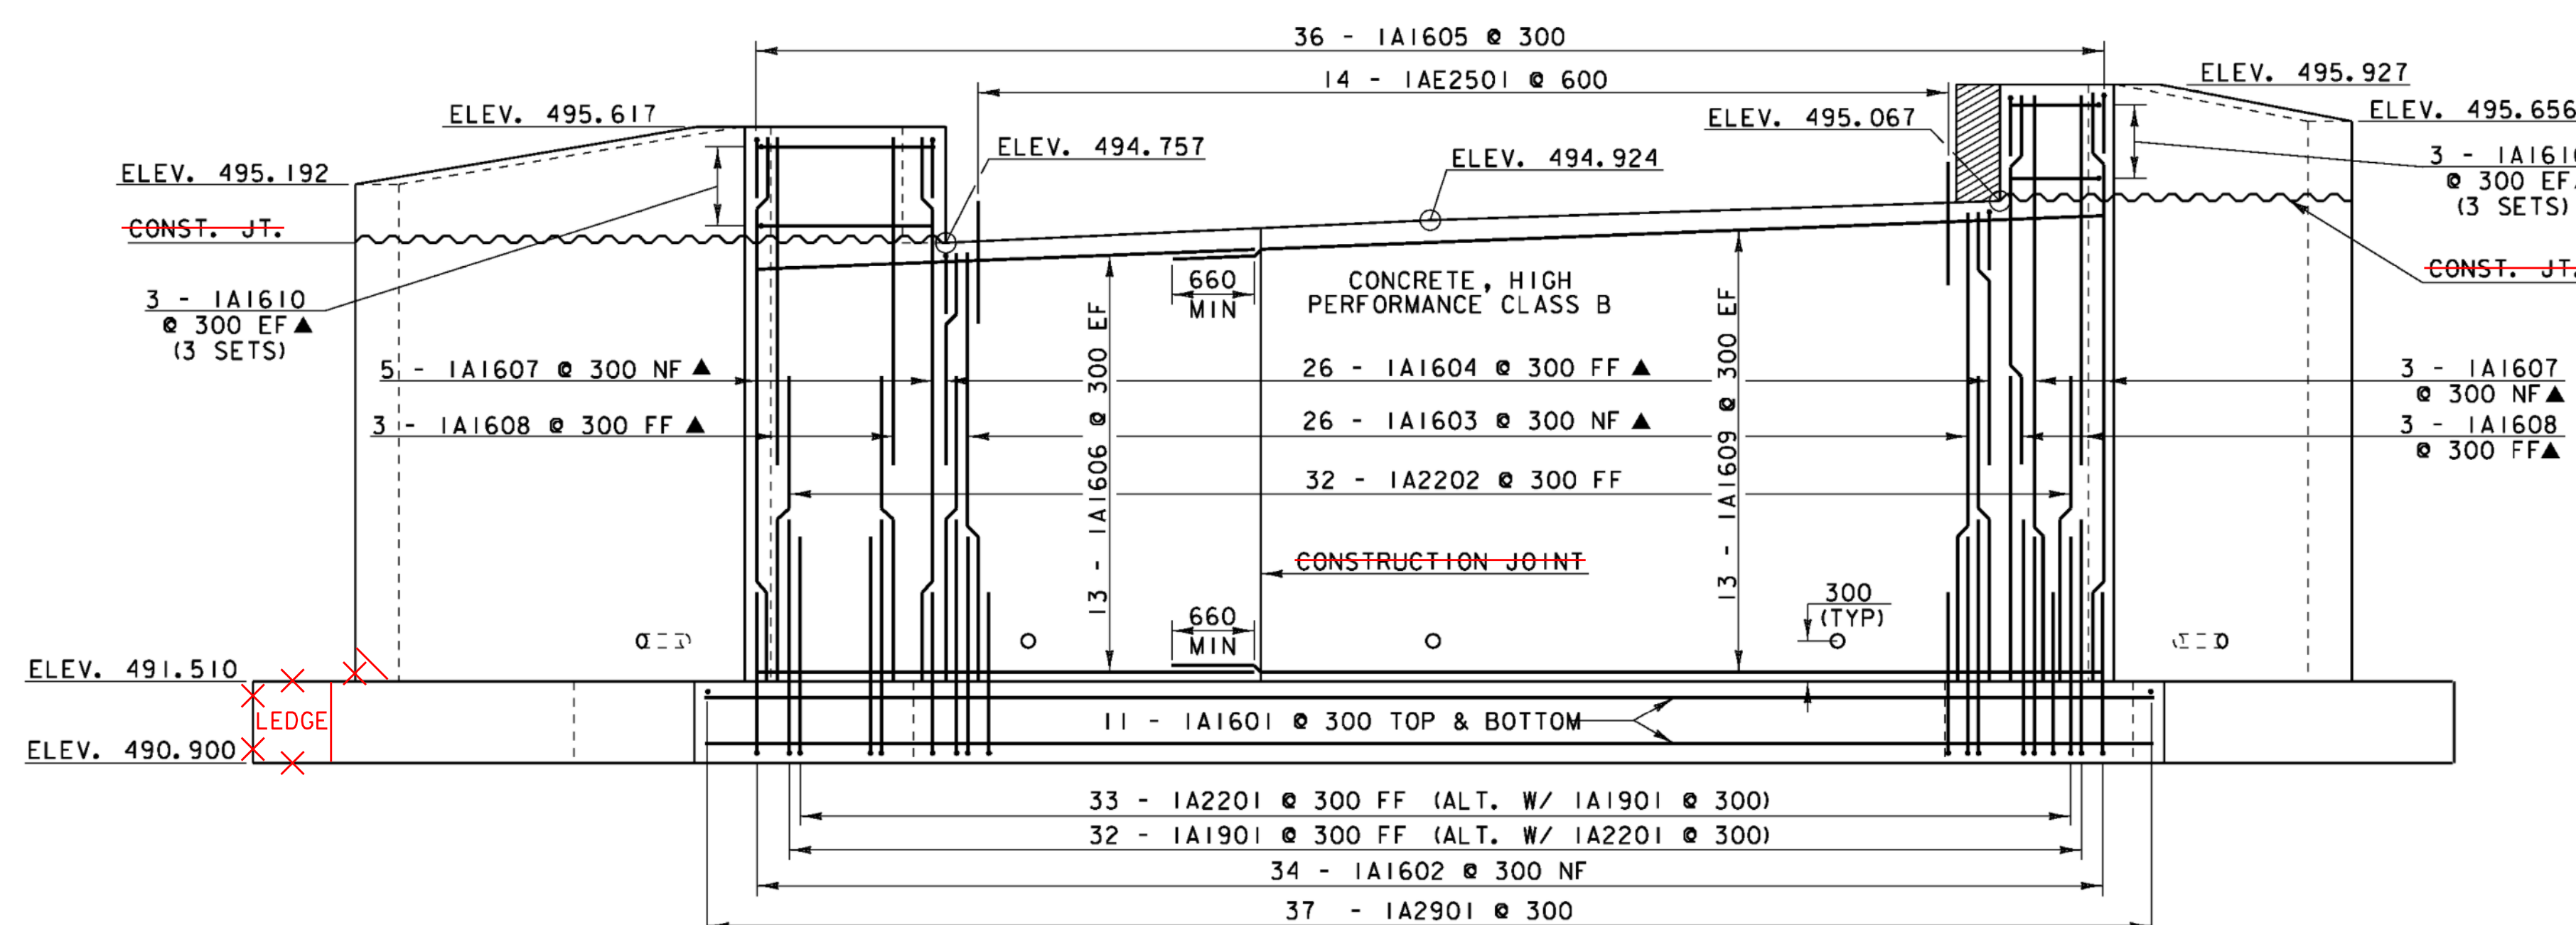

ABUTMENT #1 ELEVATION
SCALE: 1:40

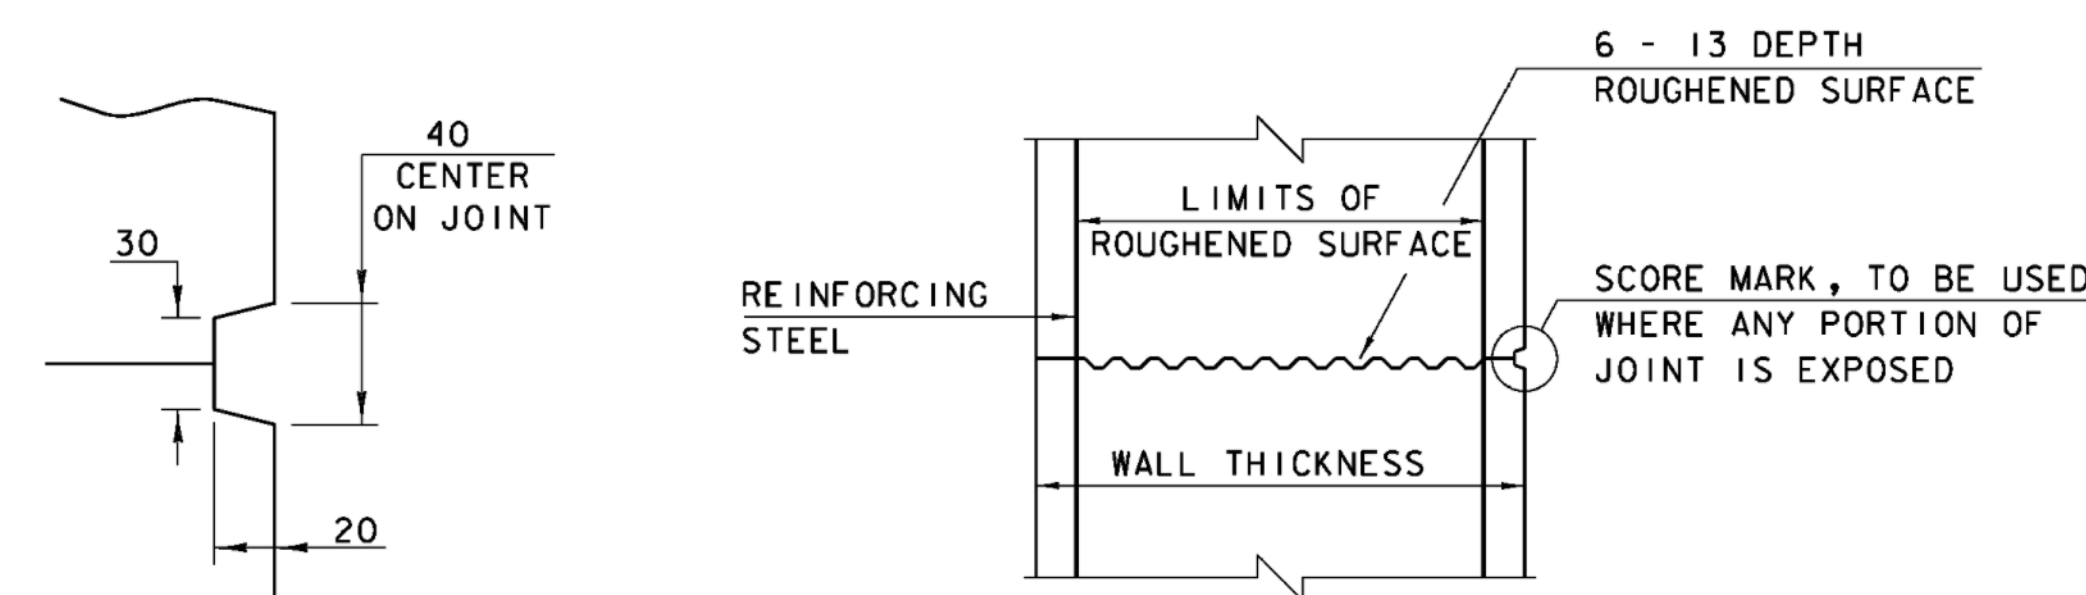

SCORE MARK DETAIL
SCALE: 1:2.5



- NOTES**
1. NF = NEAR FACE
 2. FF = FAR FACE
 3. EF = EACH FACE
 4. ▲ = CUT TO FIT IN FIELD
 5. 80 CLEAR UNLESS OTHERWISE SPECIFIED ON THE PLANS
 6. 3000 MAX. WEEPHOLE SPACING
 7. ALL LAPS NOT DETAILED SHALL BE 660 (MIN)
 8. "E" - DENOTES EPOXY COATED
 9. PAYMENT FOR PREFORMED JOINT FILLER CORK TO BE INCIDENTAL TO CONCRETE, HIGH PERFORMANCE CLASS B

BRIDGE 19 ABUTMENT 1 DETAILS

PROJECT NAME: CHITTENDEN	PLOT DATE: 14-AUG-2009
PROJECT NUMBER: STP 1443(45)	DRAWN BY: C. WEEBER
FILE NAME: 96j236/str/sj236ab.dgn	CHECKED BY: C. CARLSON
PROJECT MANAGER: C. CARLSON	SHEET 36 OF 81
DESIGNED BY: K. UPMAL	
1param: sj236br19abl.1	