
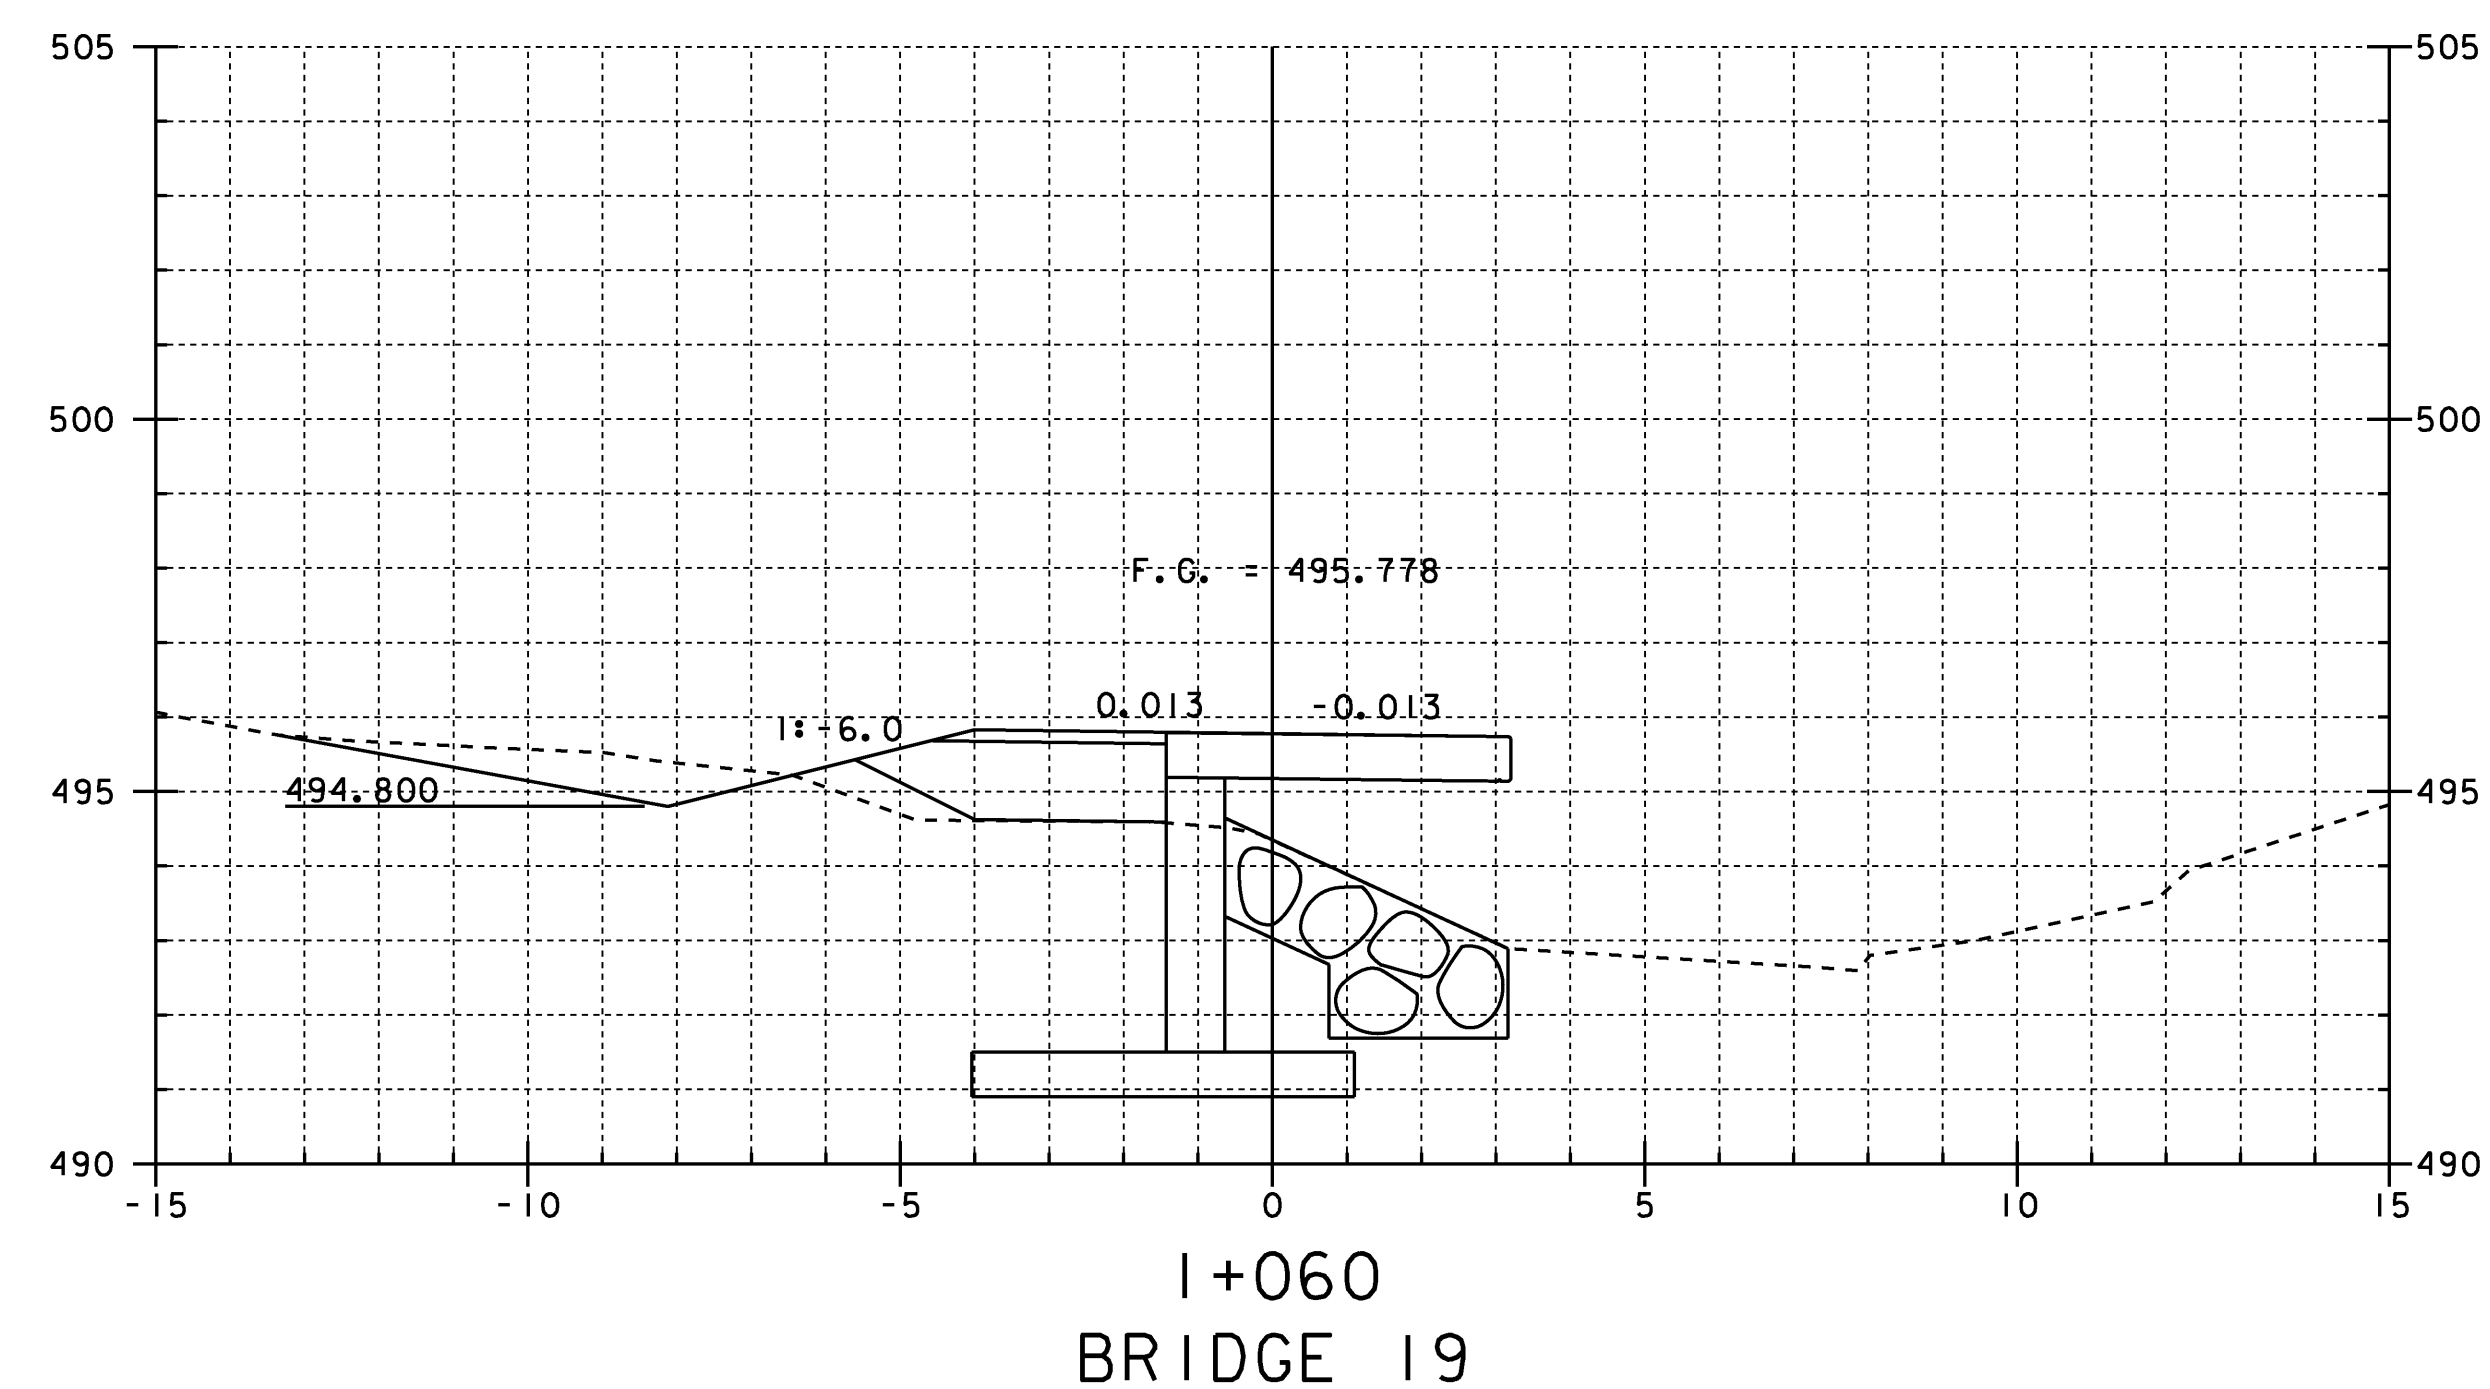
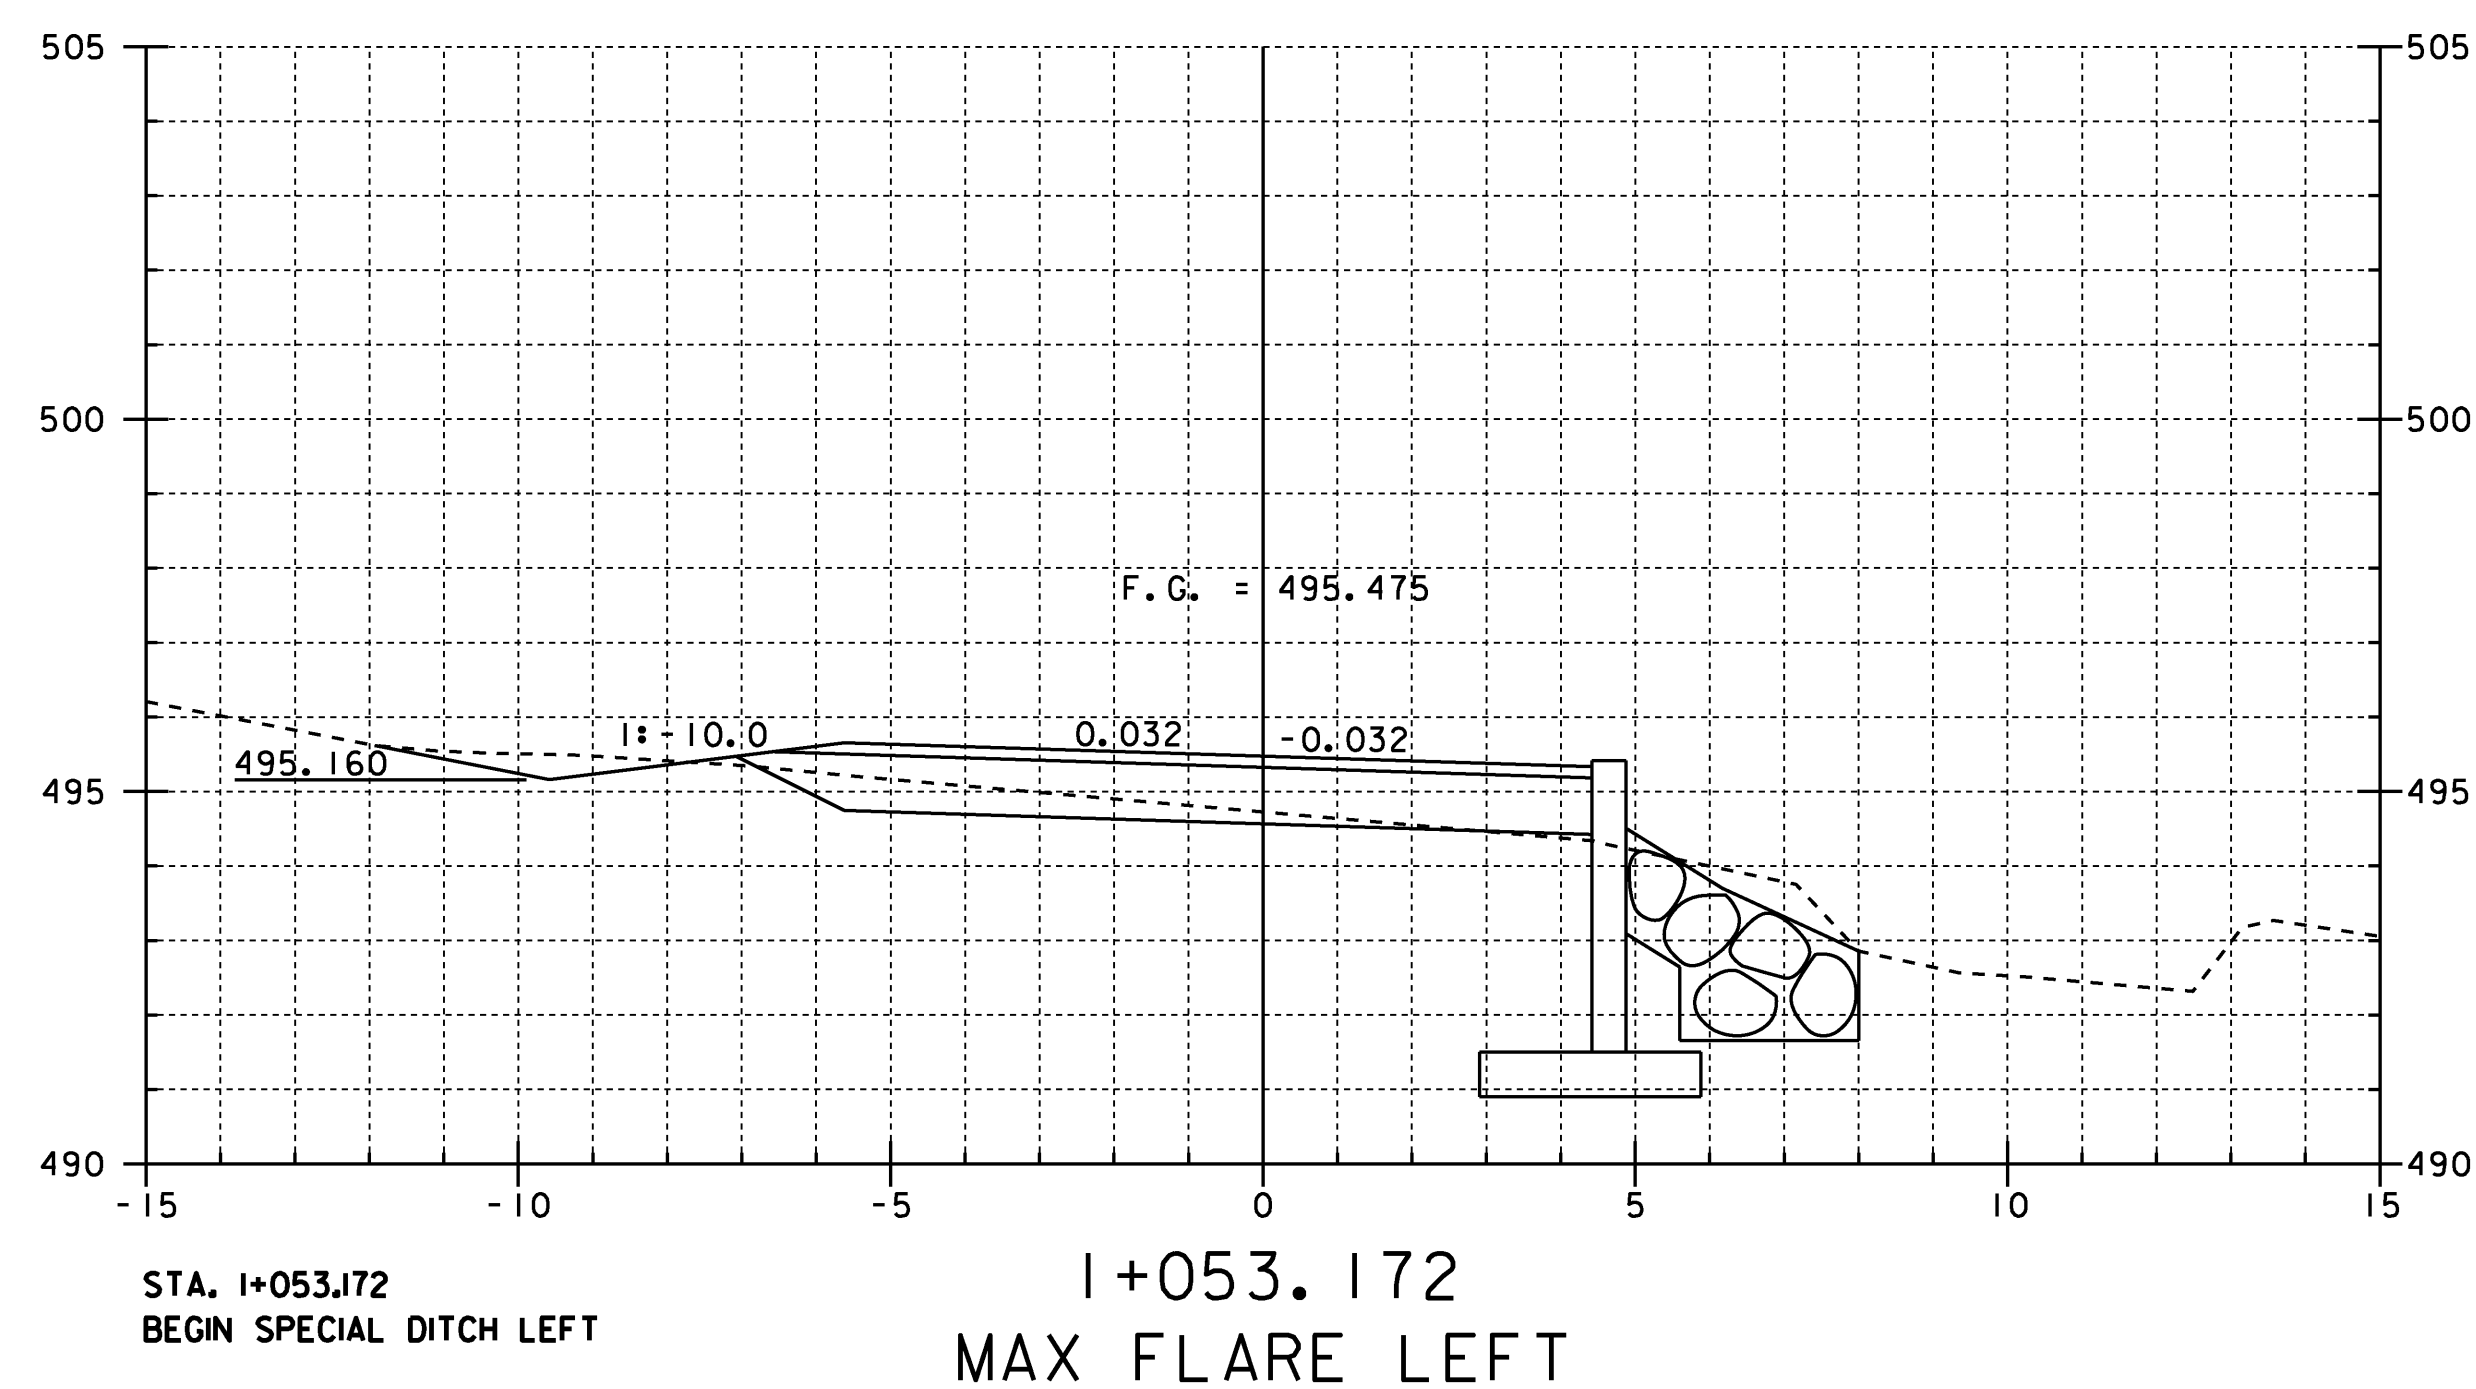
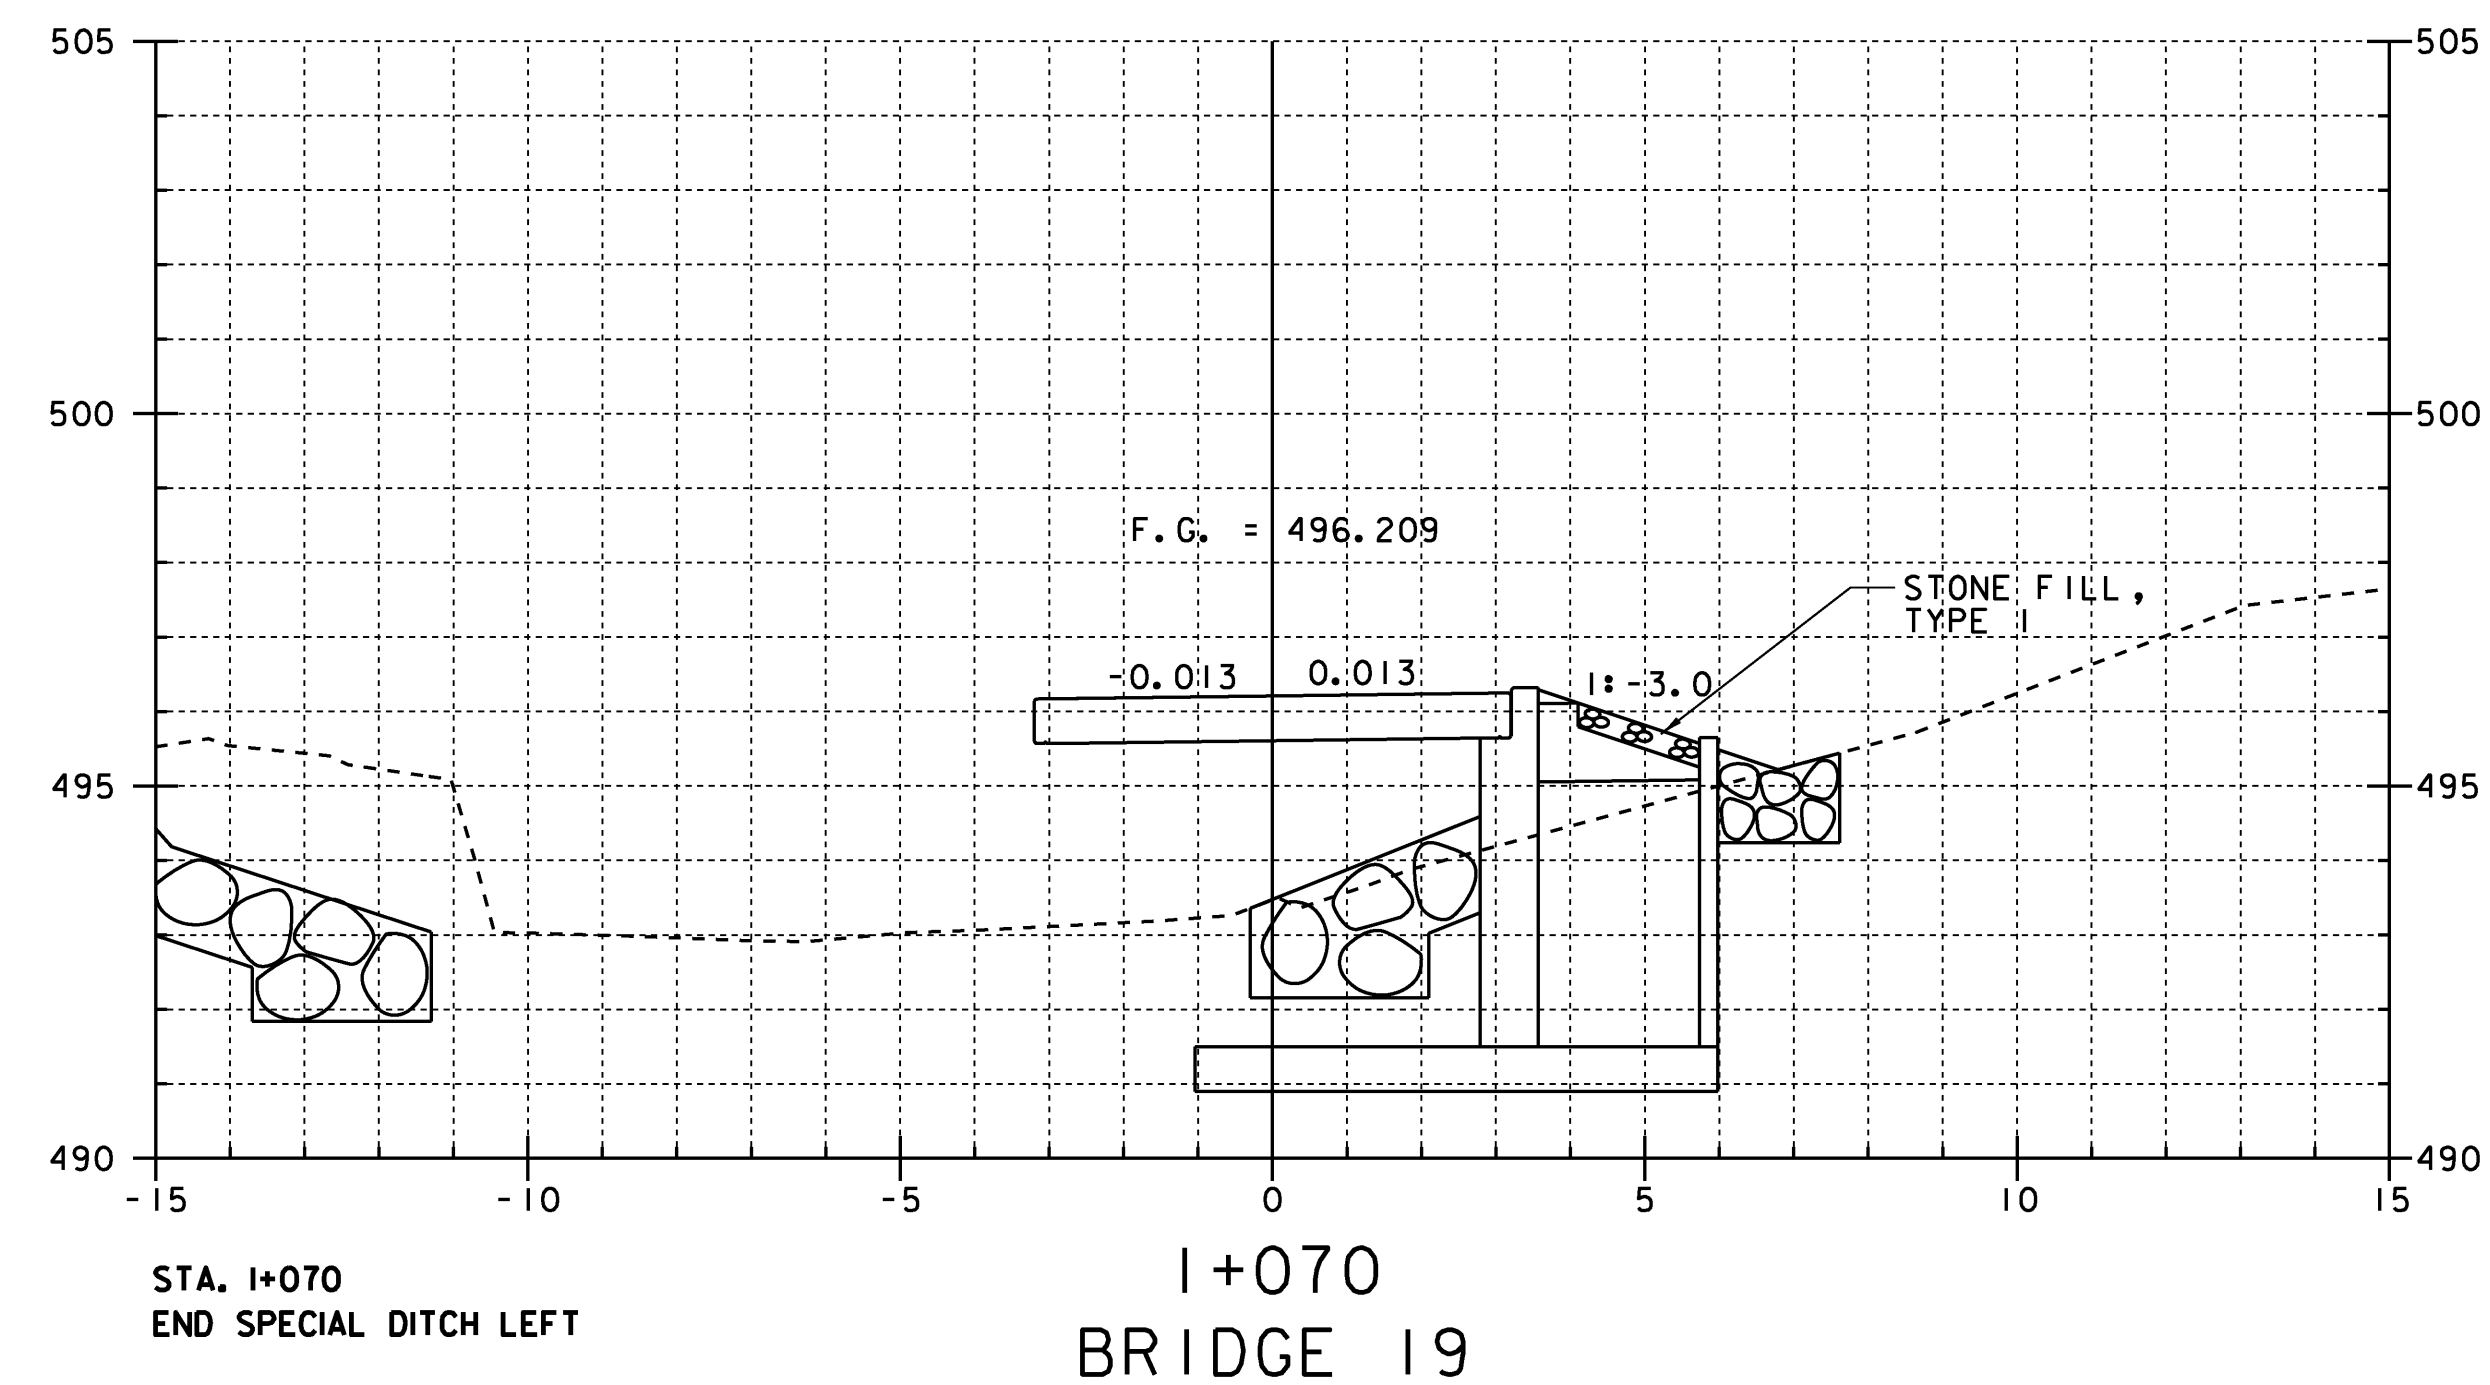


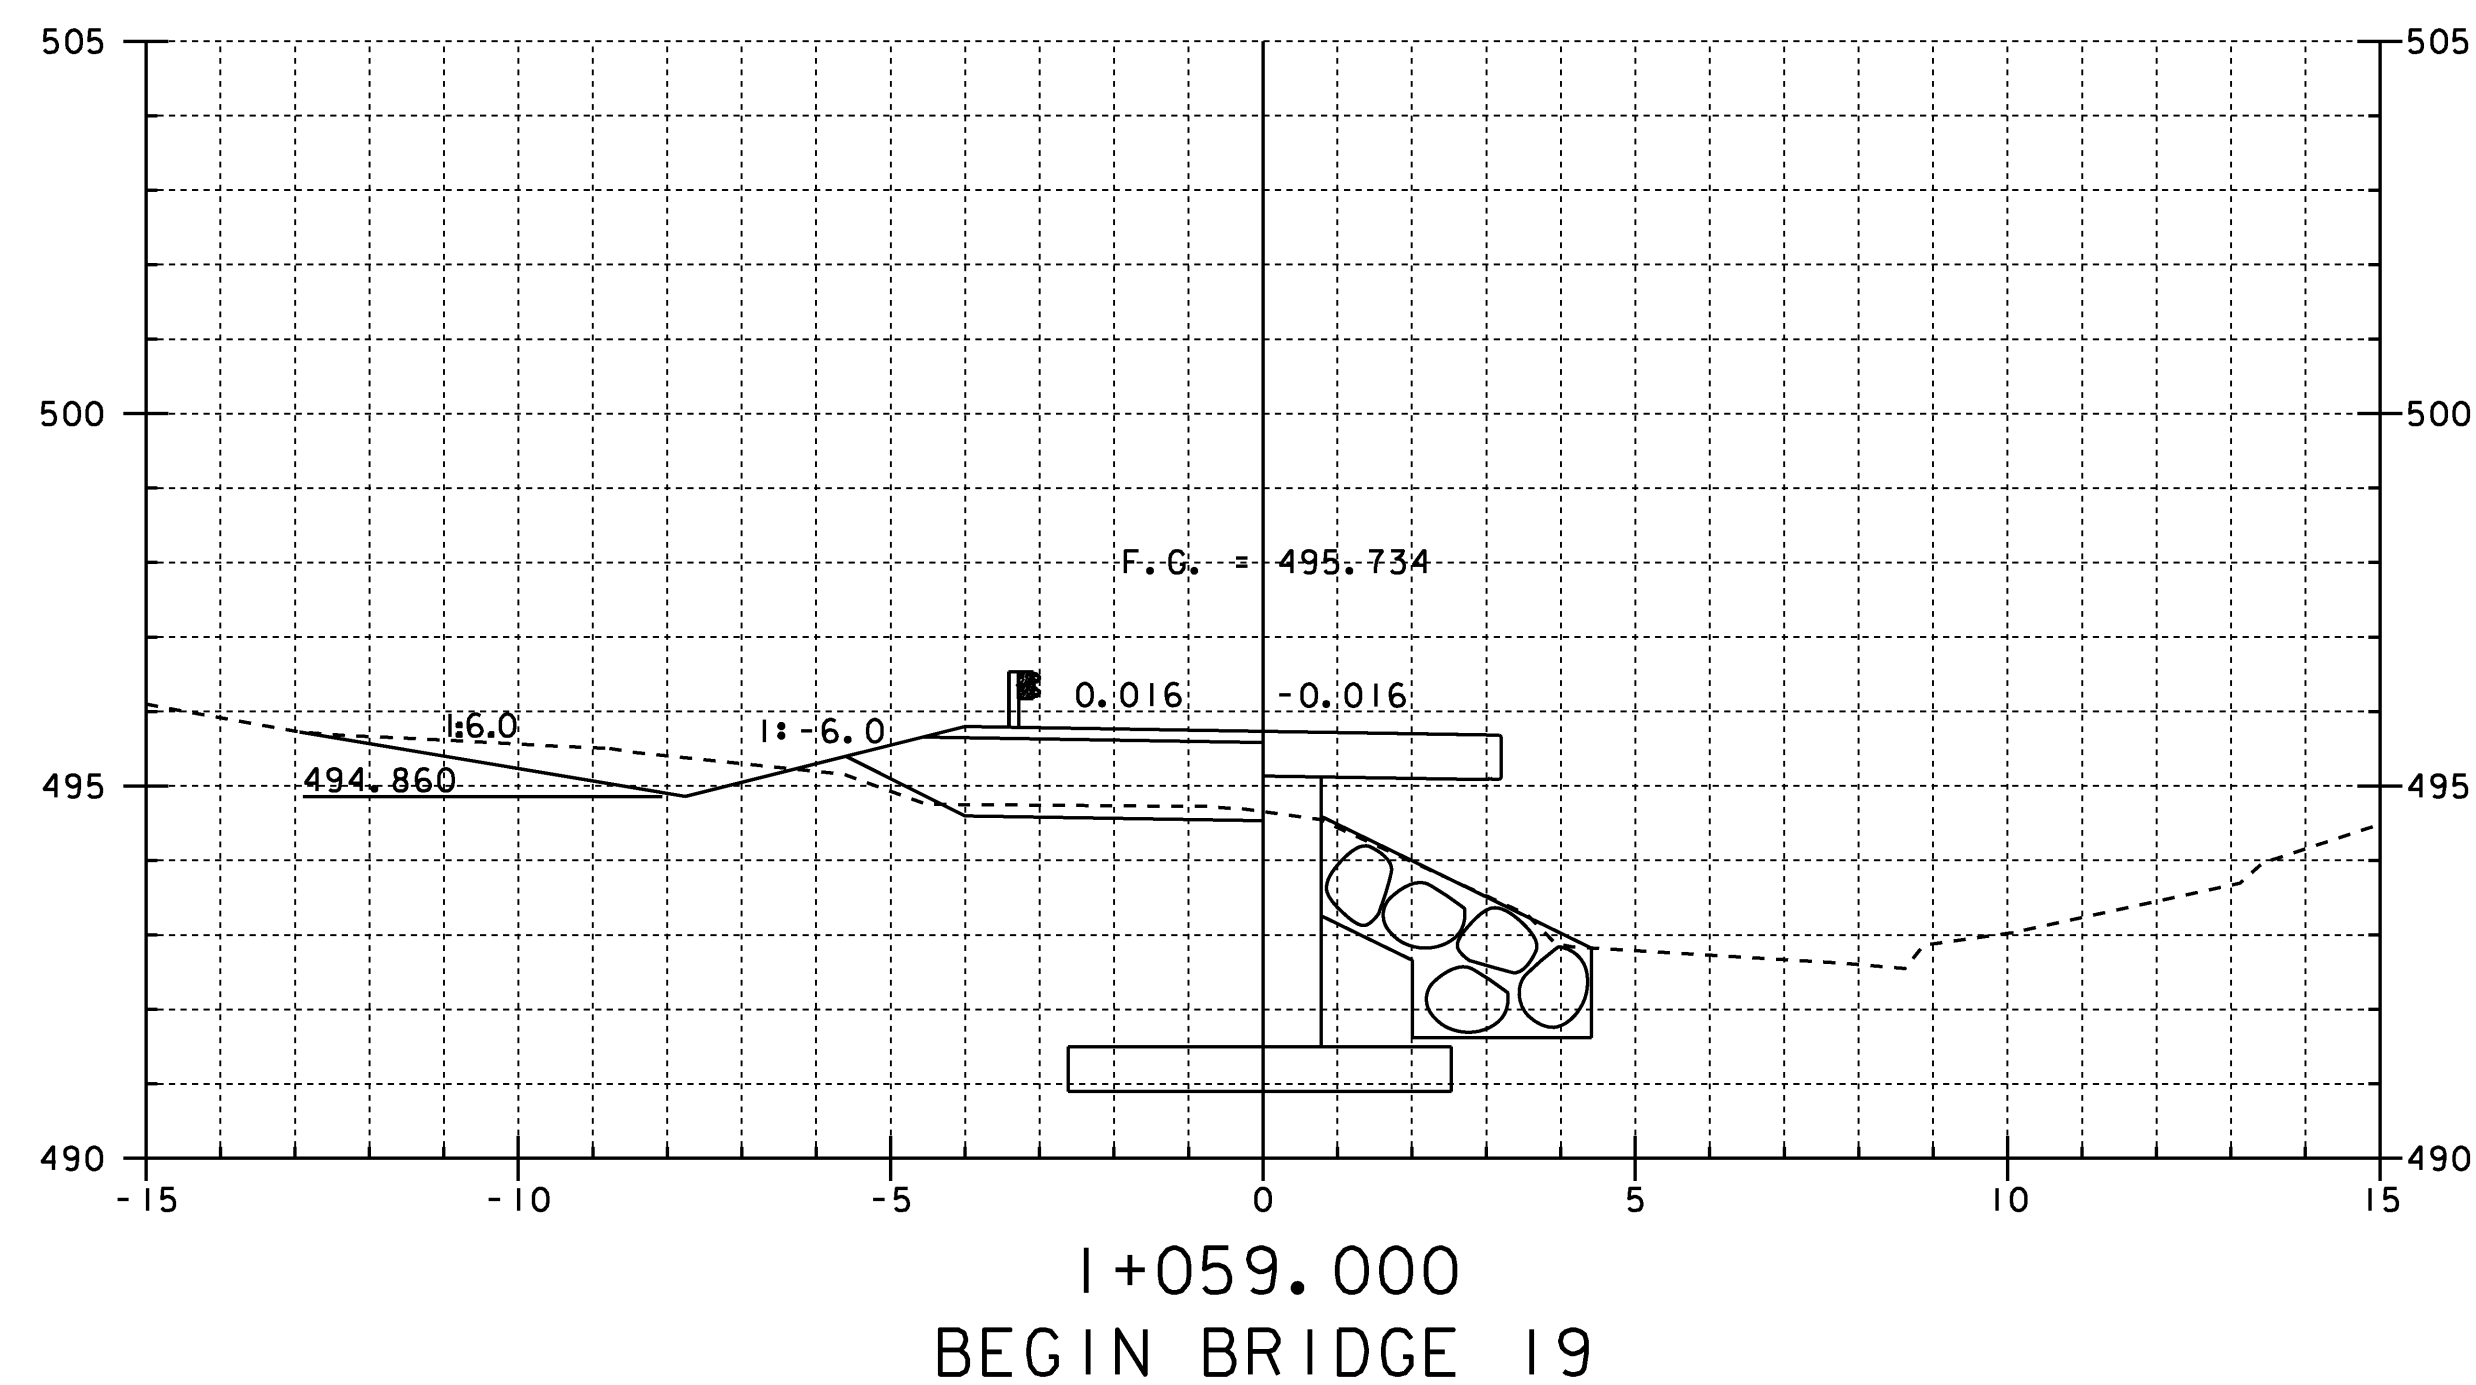

BRIDGE 19 MAINLINE CROSS SECTIONS 3

PROJECT NAME:	CHITTENDEN
PROJECT NUMBER:	STP 1443(45)
FILE NAME:	/96j236/str/sj236xs.dgn
PROJECT MANAGER:	C. CARLSON
DESIGNED BY:	K. UPMAL
PLOT DATE:	14-AUG-2009
DRAWN BY:	STR
IPARM NAME:	sj236mx3.i
SHEET	43 OF 81

STATION 1+053.172 - 1+070