


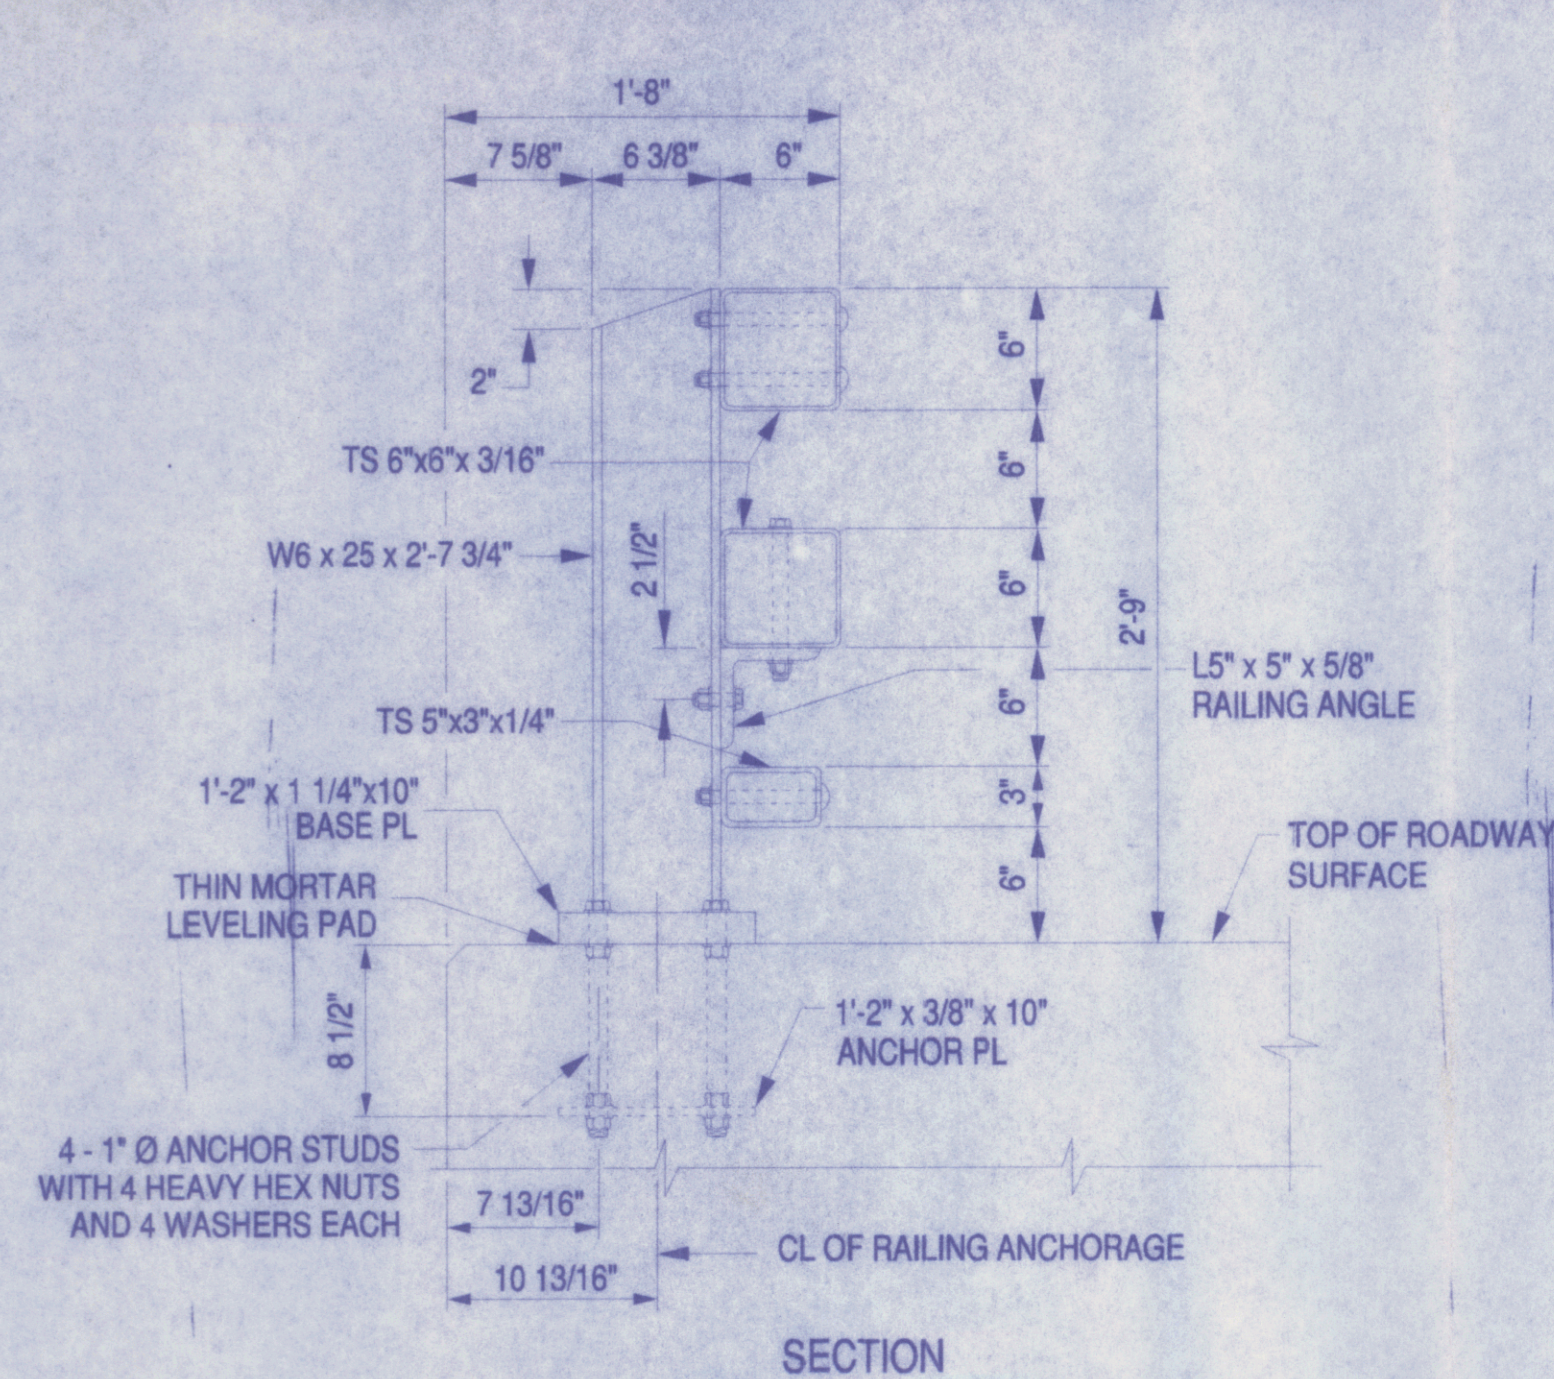


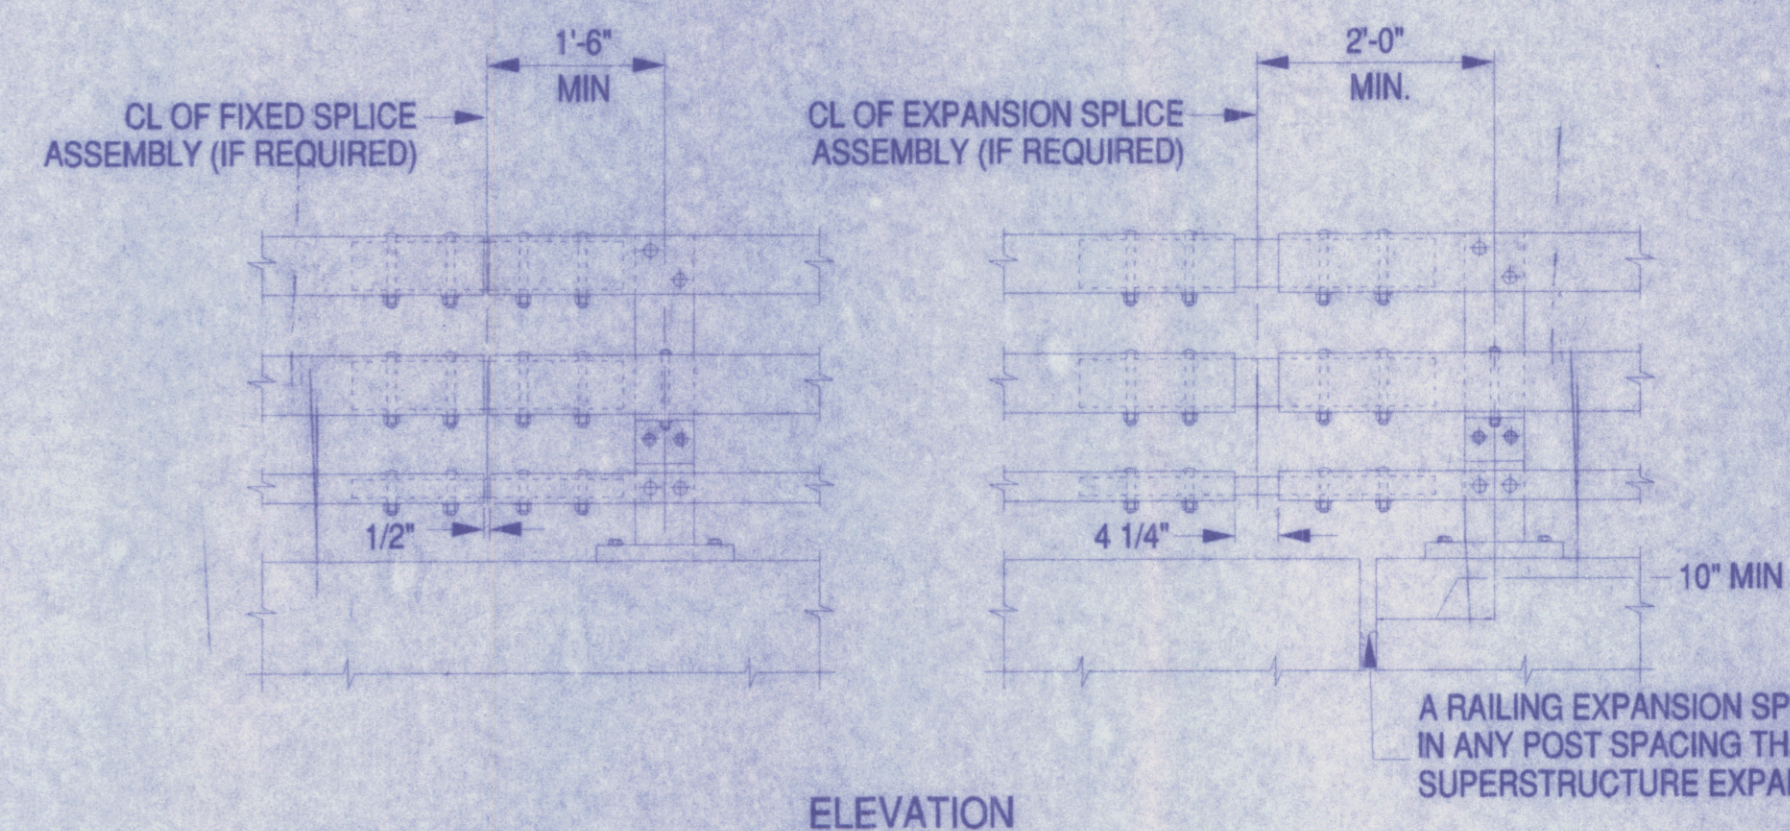


STEEL BRIDGE RAILING
(THREE-RAIL - CURBLESS)

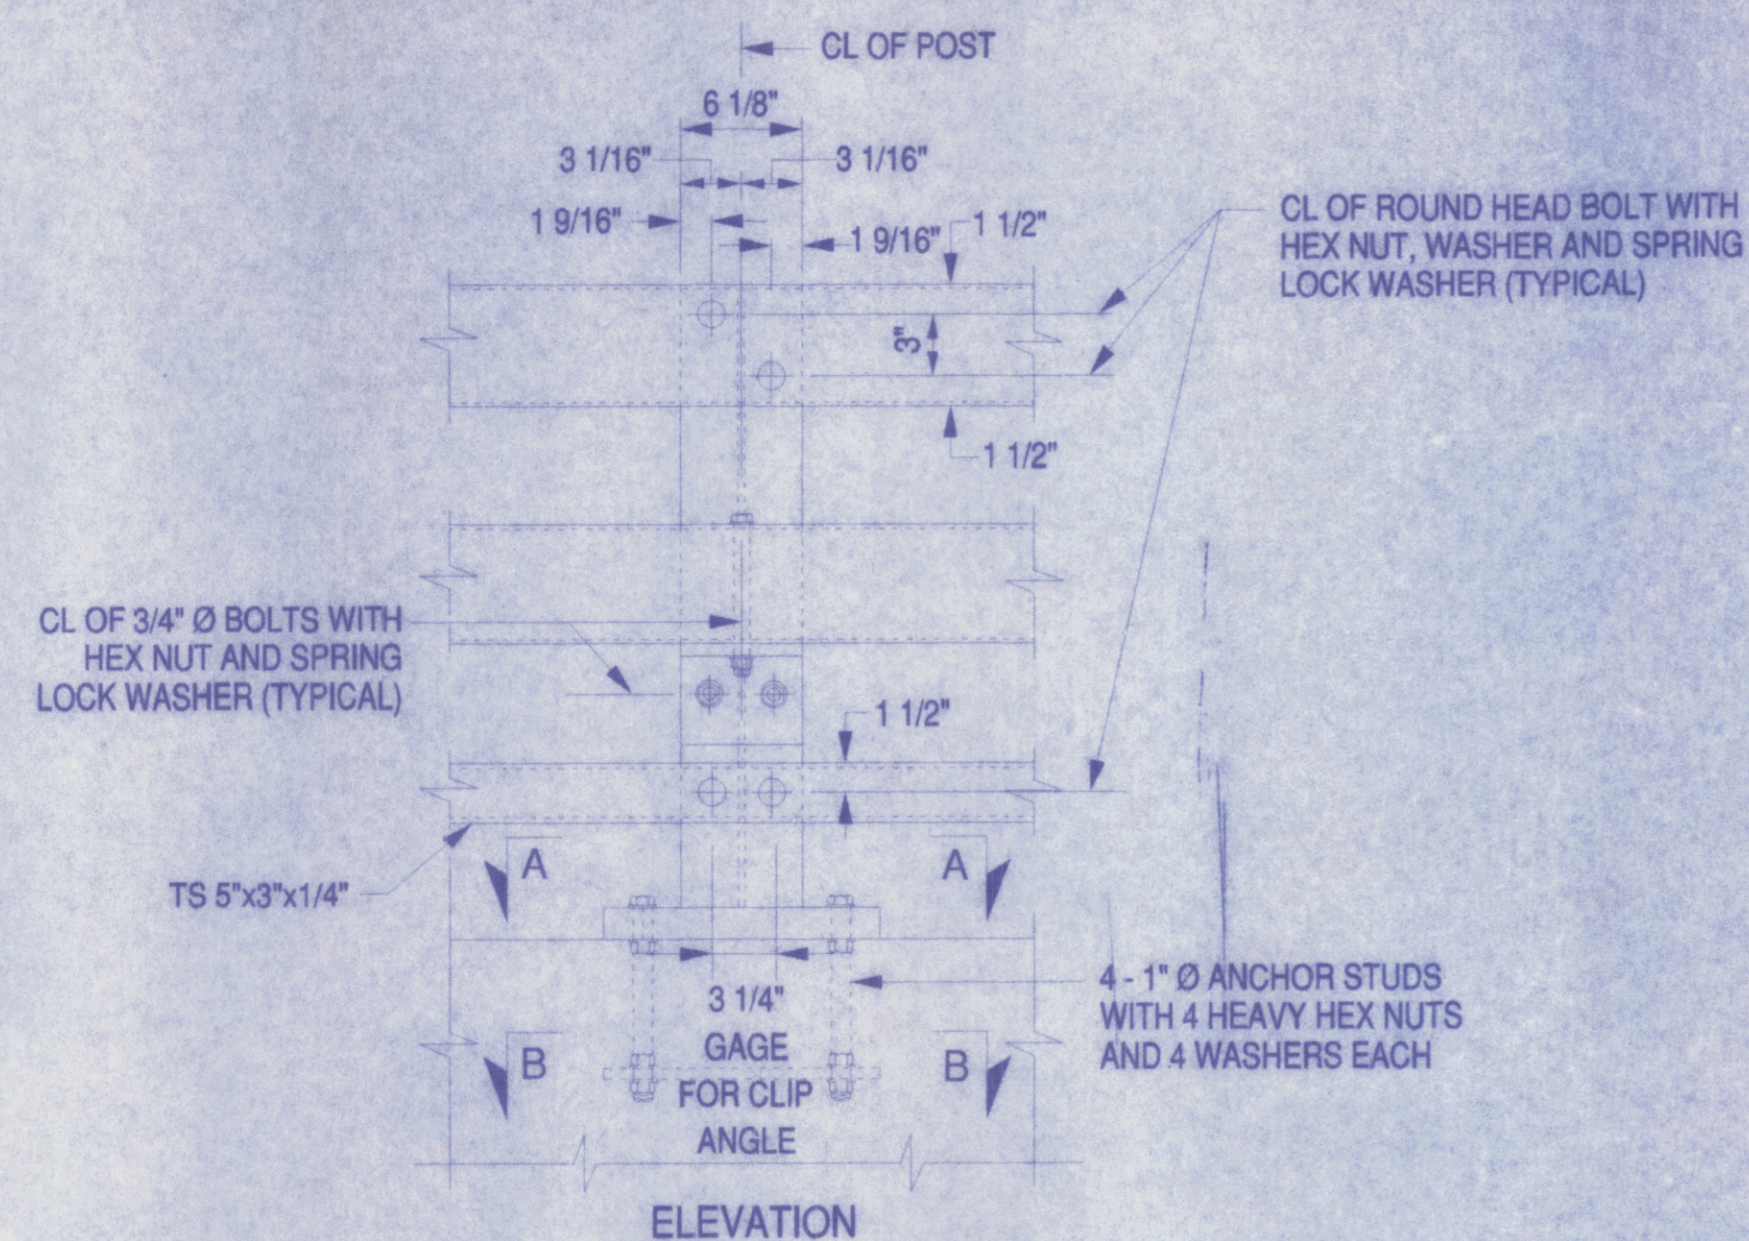


STEEL BRIDGE RAILING SPLICE DETAILS
(THREE-RAIL - CURBLESS)

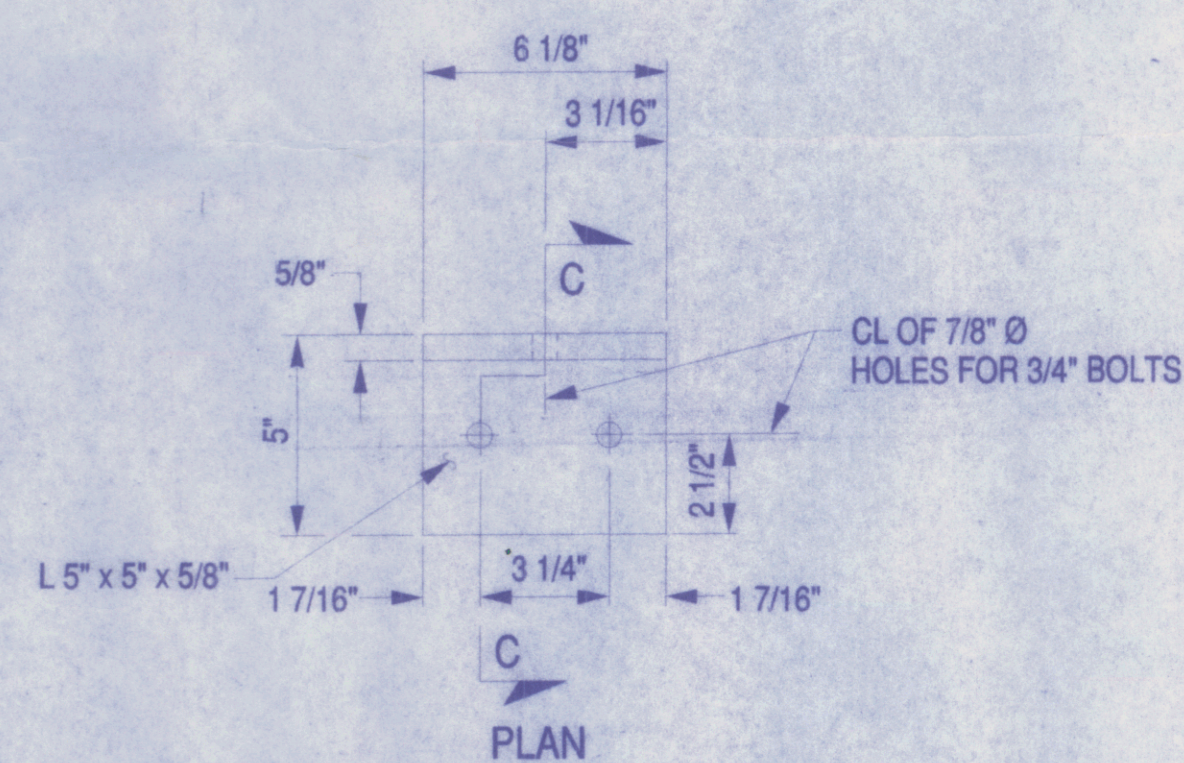



RAILING ANGLE DETAILS

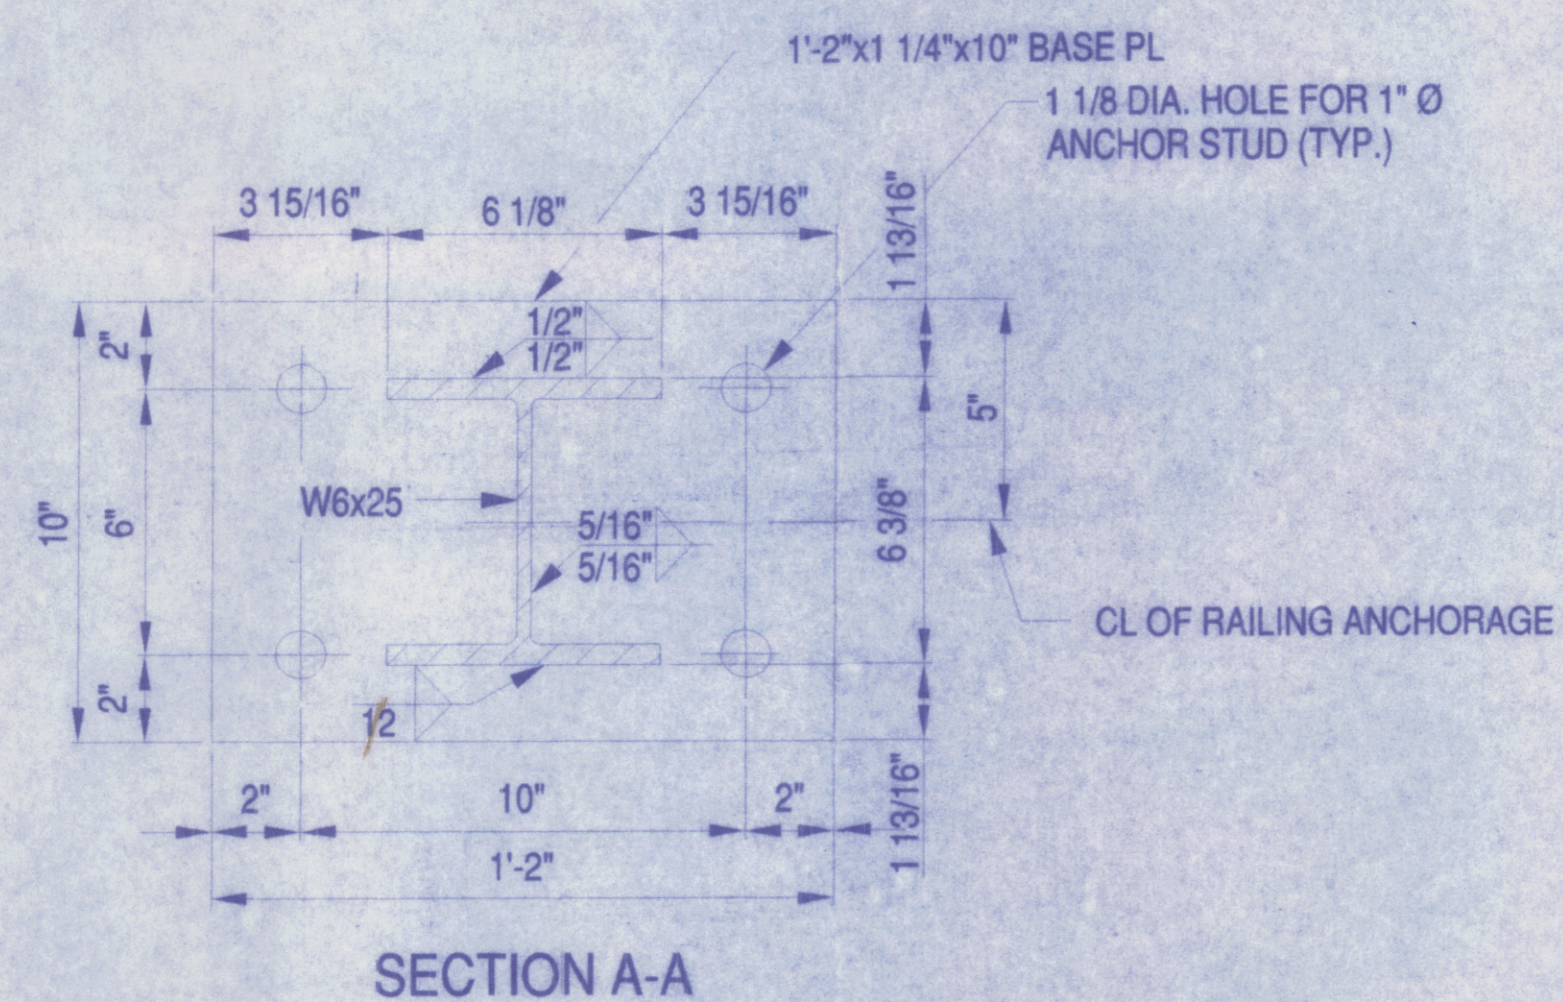

SECTION A-A

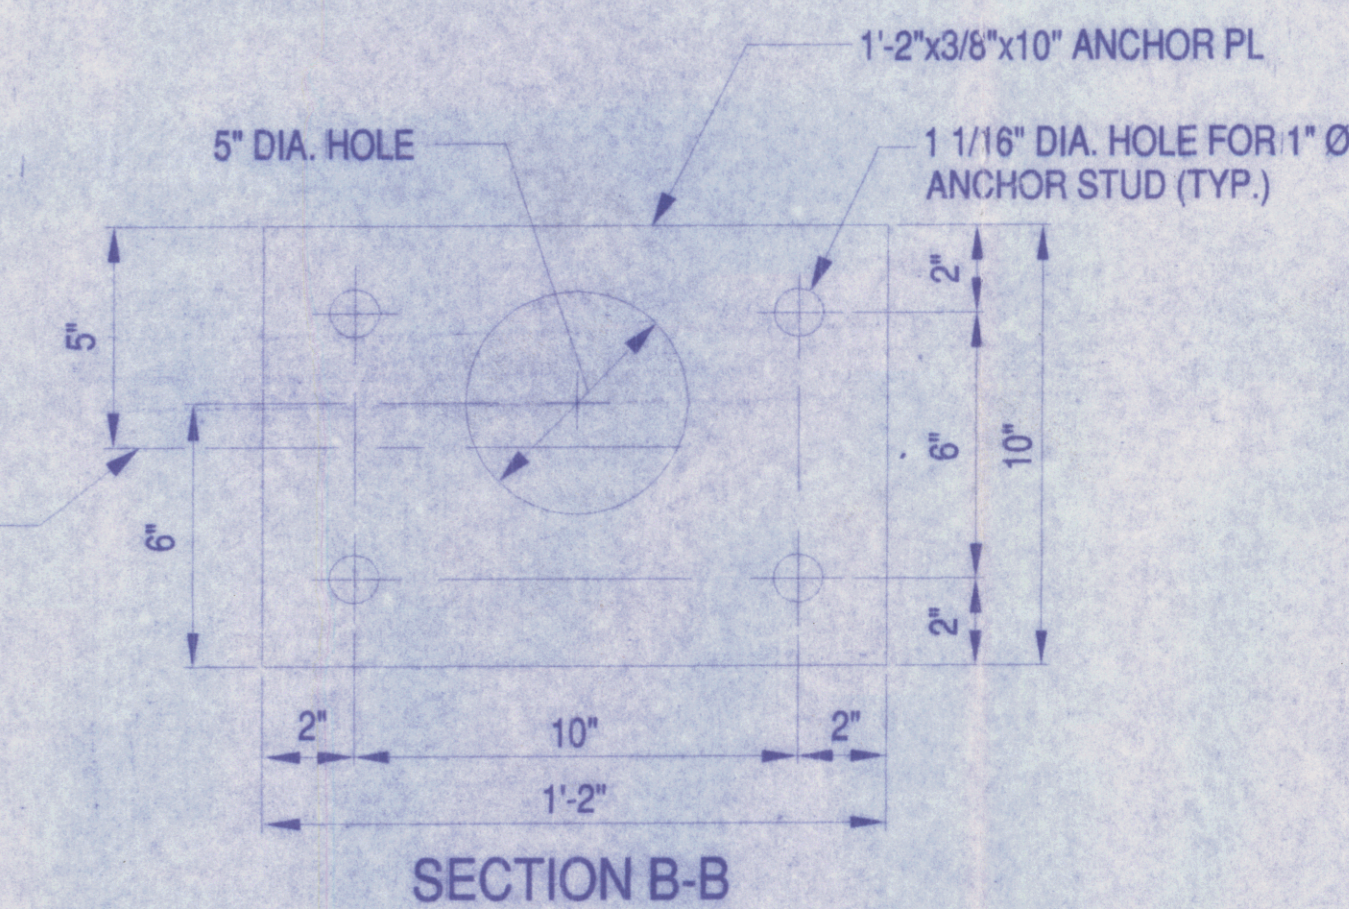

SECTION B-B

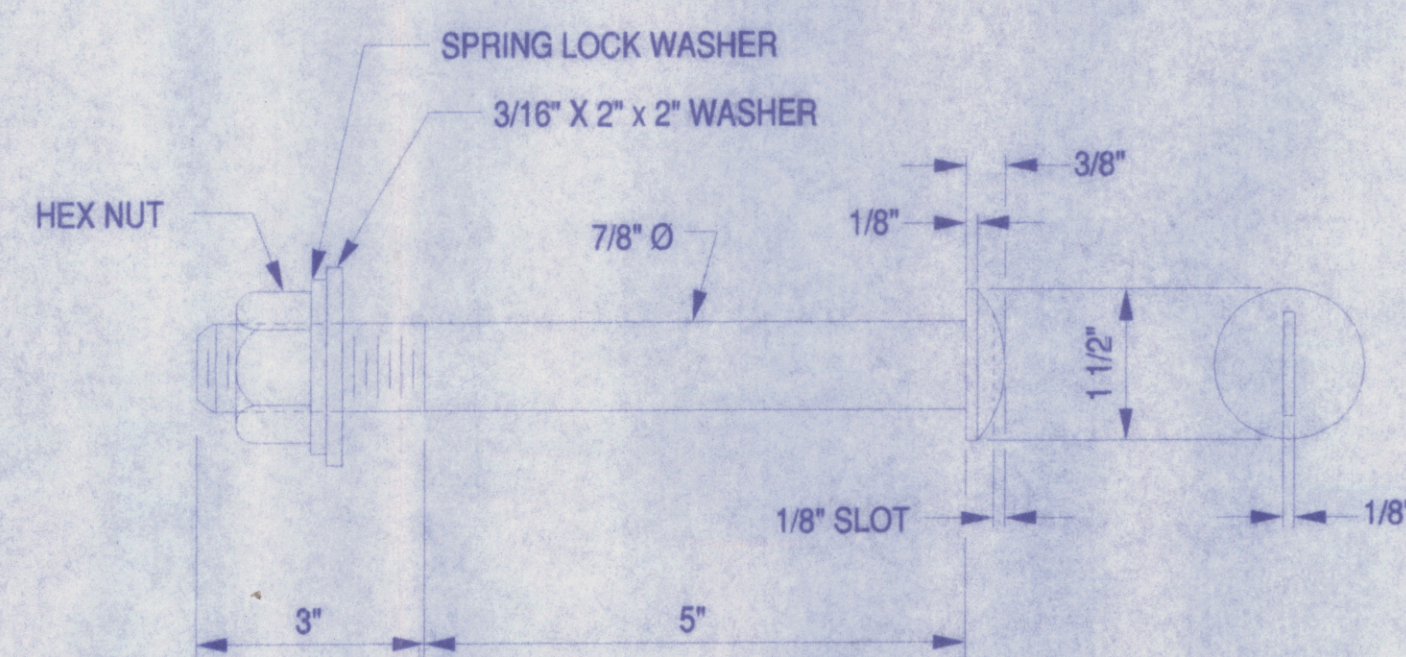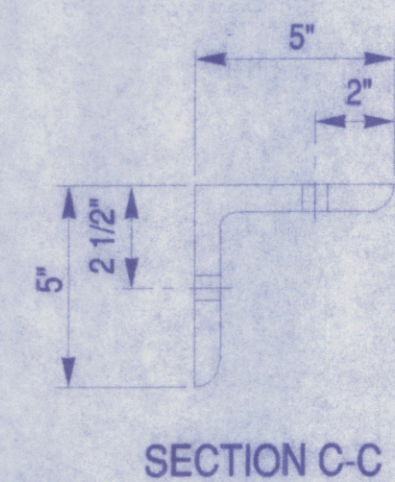

ROUND HEAD BOLT

NOTES:

PRIOR TO GALVANIZING THE ASSEMBLED POST, GRIND ALL EDGES TO A MINIMUM RADIUS OF 1/16\".

BOLTS SHALL BE TORQUED SNUG TIGHT (APPROXIMATELY 100 ft.-lb.).

RECEIVED
CHK'D BY: JEL OK'D BY: JAG
FEB JAN 23 2010
RESUBMIT APPROVED
BY KMH DATE 3/9/10

ADDED SHEET	1	2/16/10	DRAWN BY:	DATE	CHECKED BY:	SHEET NO.
			ESB	1/27/10	DKK	2 OF 3
			BRIDGE RAILING DETAILS			
			STATE OF VERMONT AGENCY OF TRANSPORTATION HIGHWAY TH 43 (BR. 33) OVER WARDBORO BROOK IN THE TOWN OF JAMAICA IN WINDHAM COUNTY			
			CONT. NO. BRO 1442 (27)			
REV.	DATE	DESCRIPTION	GEN. CONT. RENAUD BROTHERS, INC.			
			ERECTOR: RENAUD BROTHERS, INC.			
1	2/16/10	REV.	FABRICATOR: PH. (315)736-8312			JOB NO.
			DI HIGHWAY SIGN & STRUCTURE CORPORATION P.O. BOX 123(40 GREENMAN AVE.)NEW YORK MILLS, N.Y. 13417			
						R15-03