


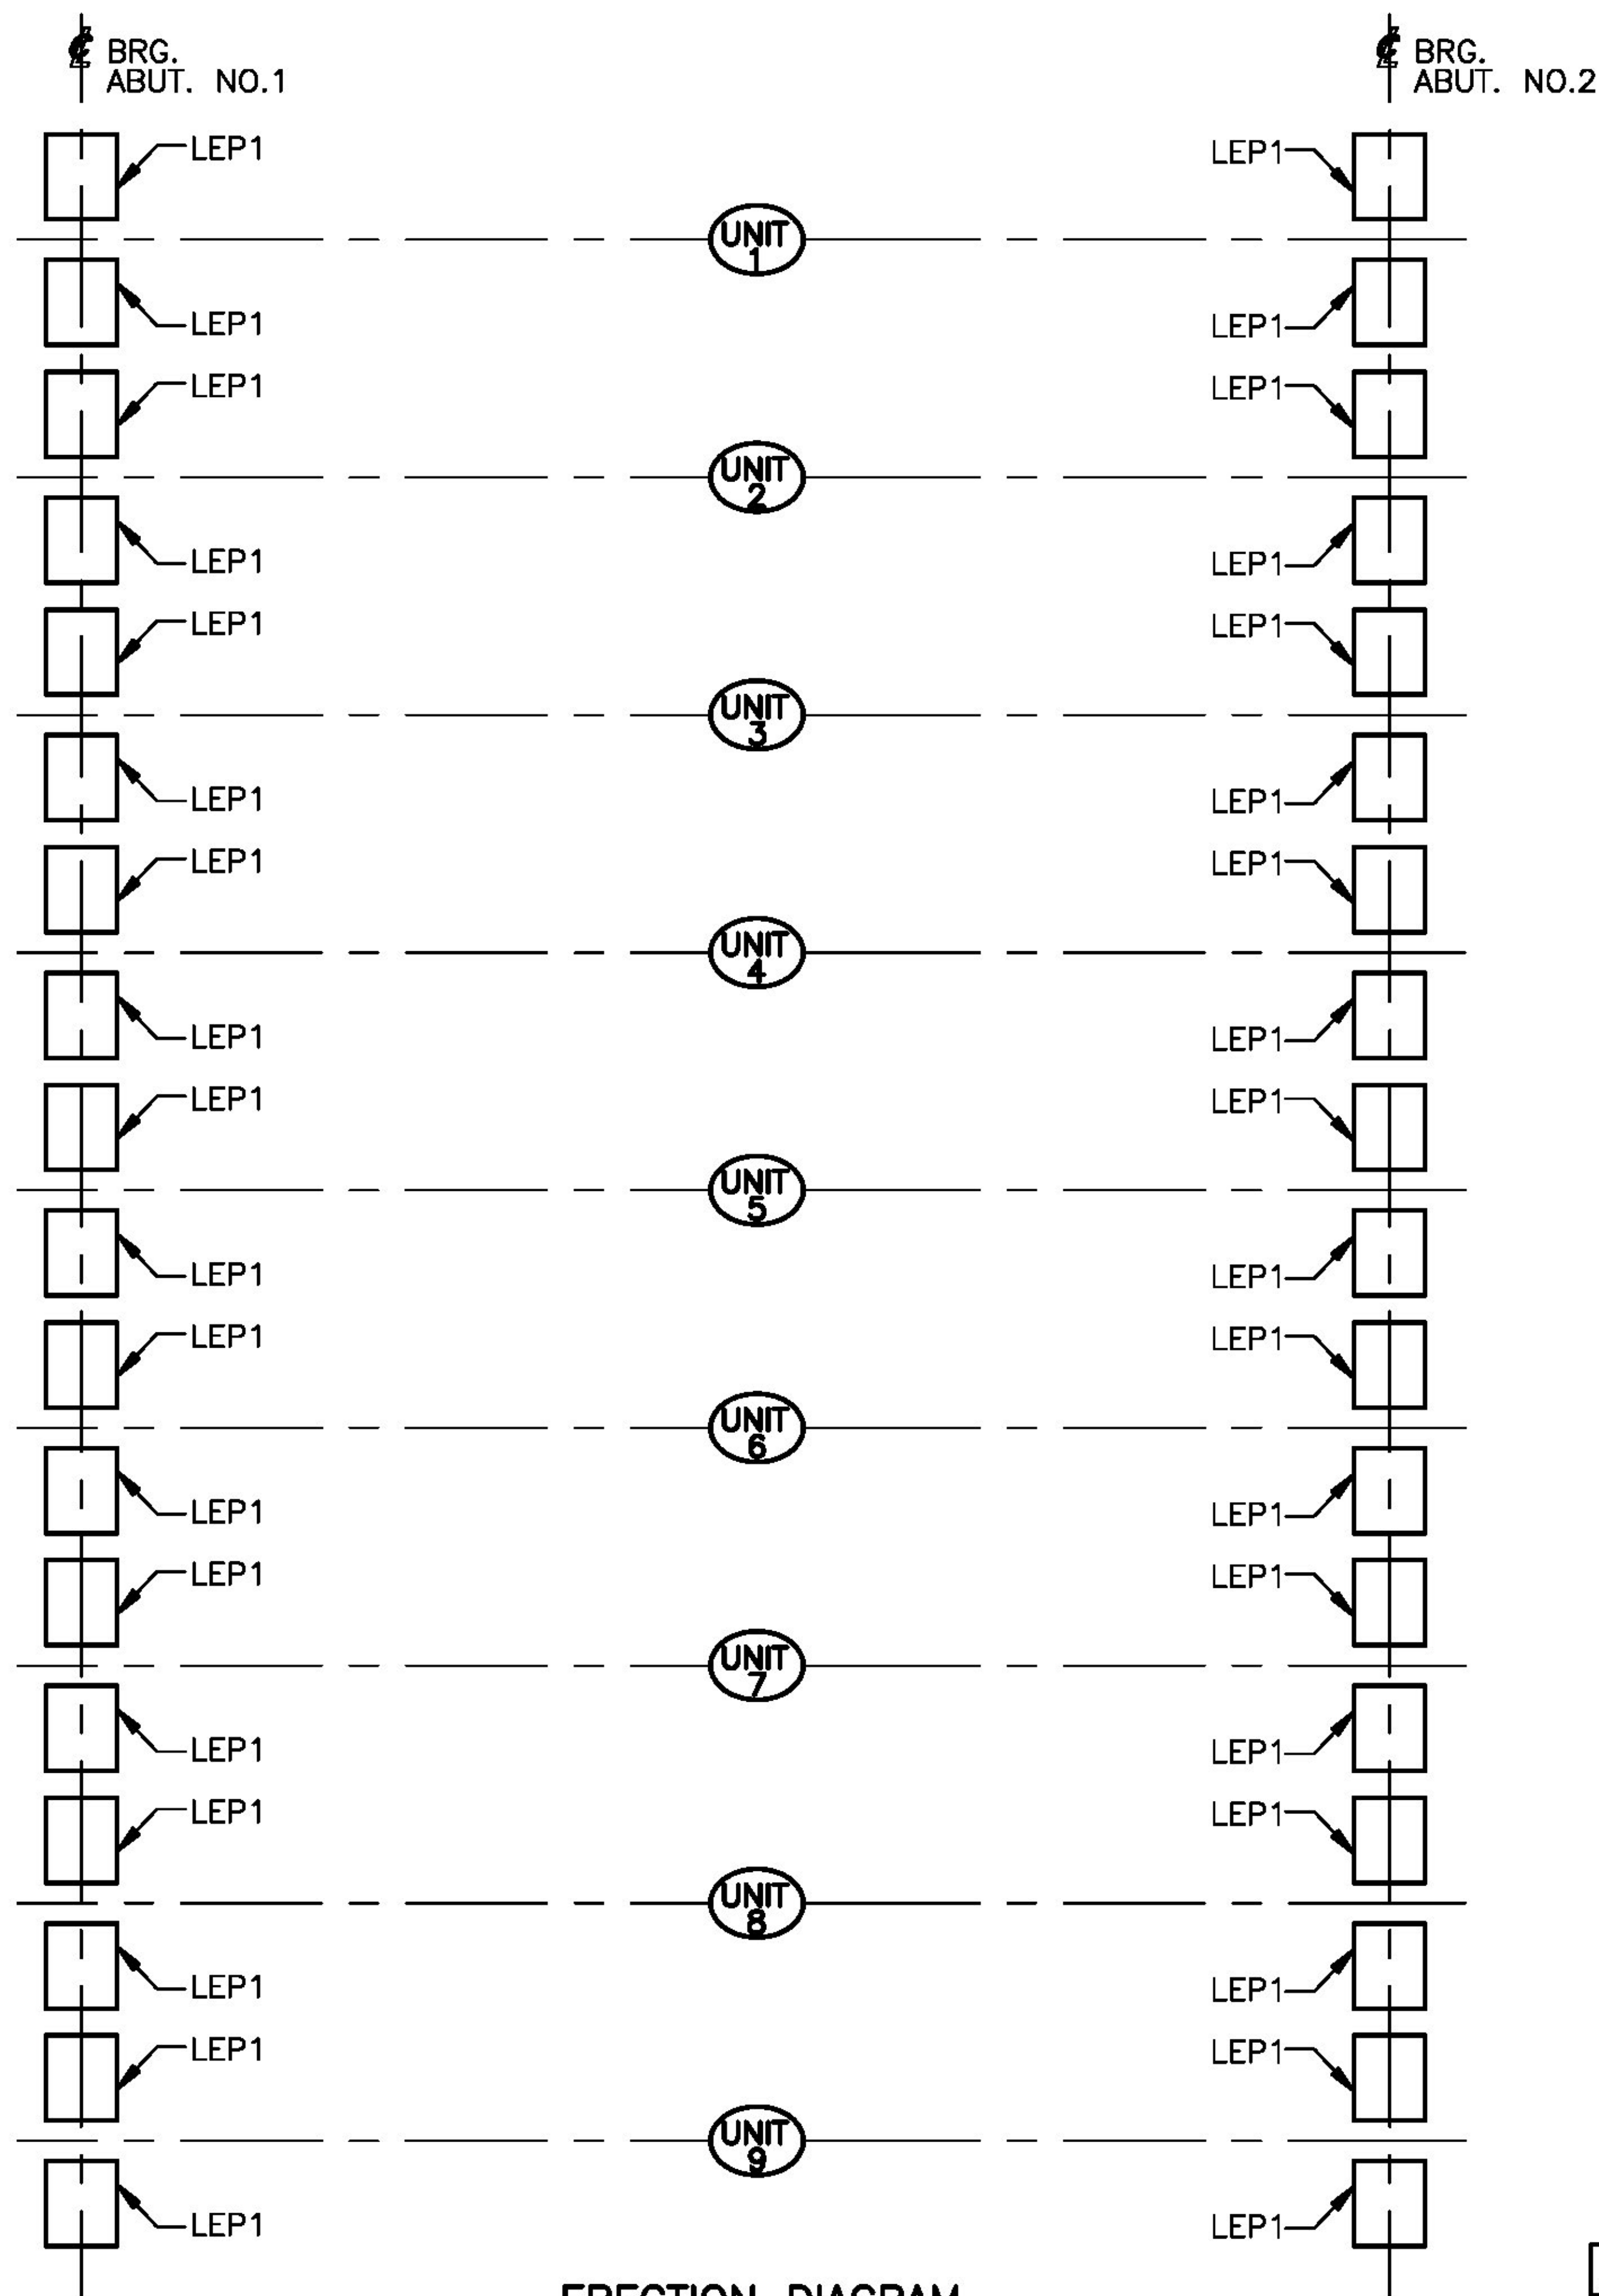

ERECTION DIAGRAM

Vermont Agency of Transportation
RECEIVED
Erection Diagram and Bearings 6-9-14.pdf
CK'D BY M. UMBERGER OK'D BY C. CARLSON
June 9, 2014
RESUBMIT NO Approved
BY C. CARLSON DATE 06/24/2014
SEE SHEET DI FOR SHOP NOTES

STATE OF VERMONT AGENCY OF TRANSPORTATION BRIDGE NO.14 ROUTE NO: TH 13 (FOREST STREET) OVER MOON BROOK ITEM NO. 513.17 CITY OF RUTLAND		
STATE	COUNTY	CONTROL NO.
VT	RUTLAND	N/A
PROJ. NO.: BRF 3000 (18)		
DYNAMIC RUBBER: LAMINATED BEARING PADS		
Cosmea 1501 ROCKY RIDGE ROAD P.O. BOX 2159 ATHENS, TEXAS 75751		
SCALE: NONE	DRAWN BY: RO DATE: 5/22/14	CHECKED BY: SL DATE: 6/5/14
SHEET E1 OF 1		JOB NO.: 12541
CUSTOMER: THE BELDEN COMPANY		DRAWING NUMBER 12541-E1
REV.		REV. 0