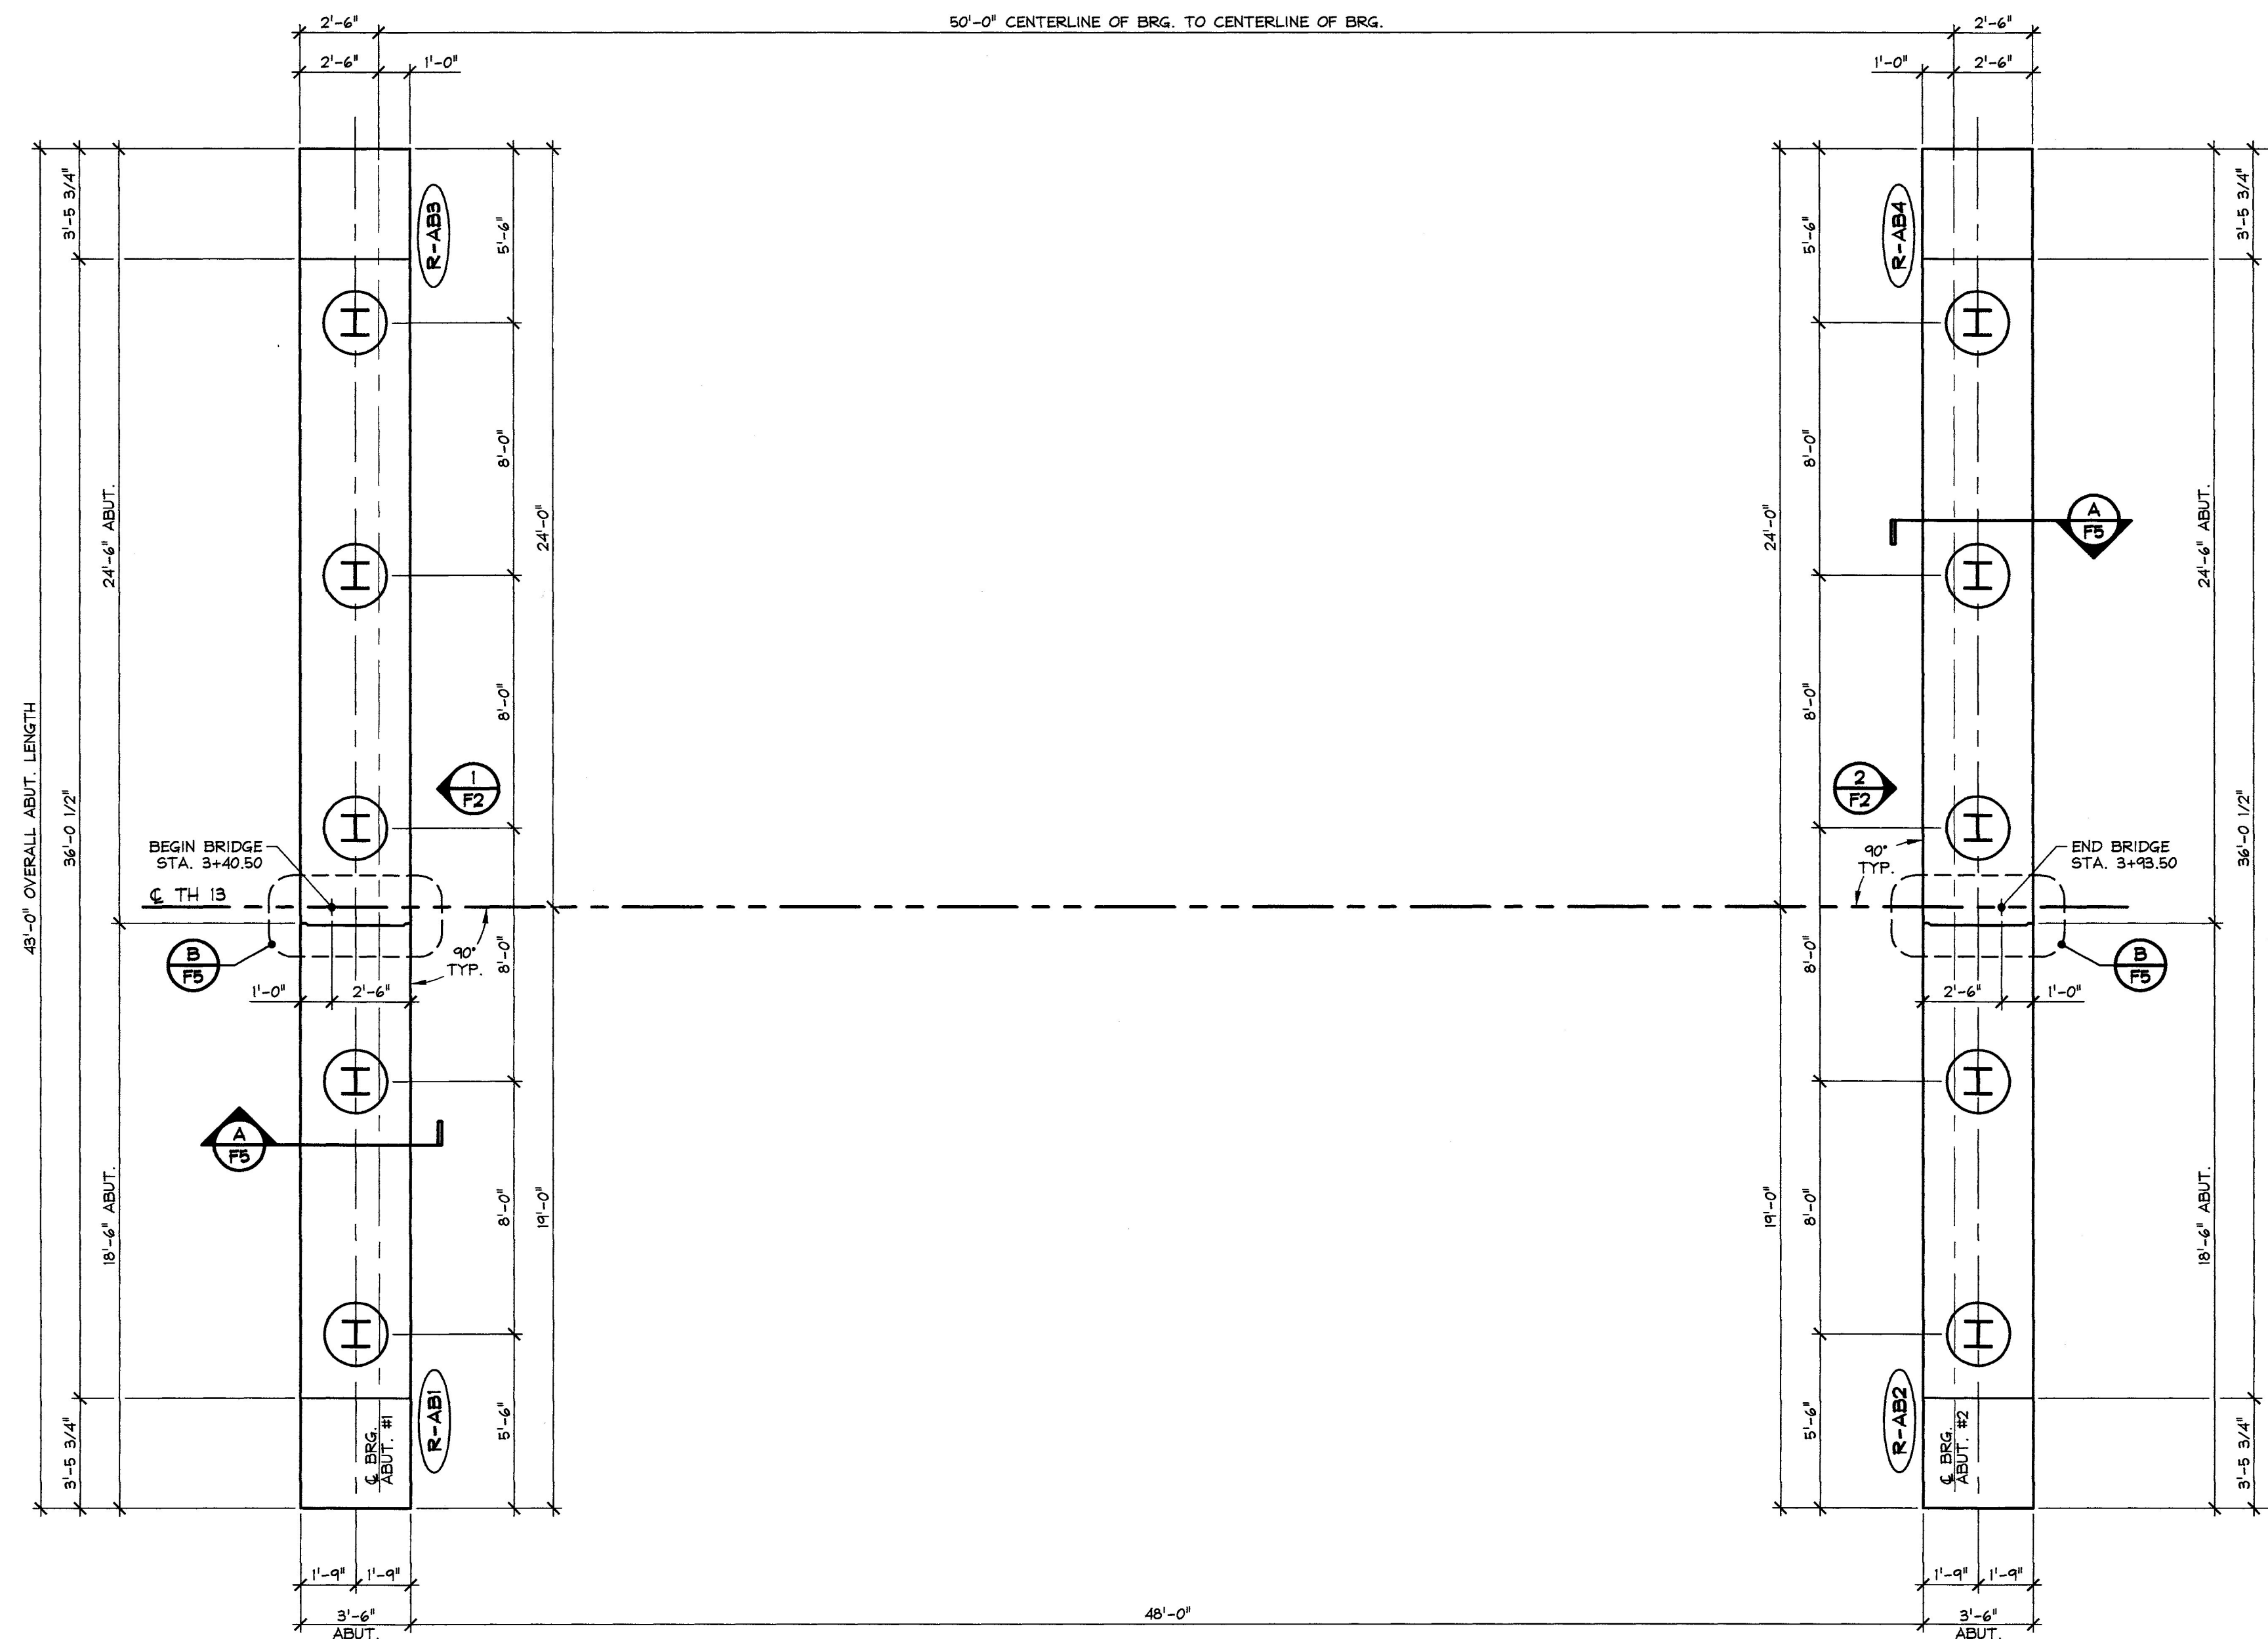


PRECAST ABUTMENT LAYOUT
1/4" = 1'-0"

Vermont Agency of Transportation
RECEIVED

CK'D BY M. Umberger OK'D BY C. Carlson

July 1, 2014

RESUBMIT No Approved
BY C. Carlson DATE 07/08/2014

APPROVAL STAMP:	J.P. CARRARA & SONS INC. THE BELDEN COMPANY, INC. Precast & Prestress Manufacturer CONTRACTOR 2404 CASE ST., MIDDLEBURY, VERMONT 05753 Phone: (802) 388-6361 Fax: (802) 388-9010 RUTLAND, VERMONT	
	STATE OF VERMONT AGENCY OF TRANSPORTATION COUNTY OF RUTLAND	DATE: APR. 25, 2014 SCALE: NOTED
	CITY OF RUTLAND ROUTE NO.: TH 13 (FOREST STREET) - URBAN COLLECTOR BRIDGE NO.: 14 PROJECT NO.: BR 3000(18)	CHKD: M.D. DFTM: B.L. JOB NO: 23430-014
	PRECAST ABUTMENT LAYOUT DWG. NO: F1	