

STATE OF VERMONT
AGENCY OF TRANSPORTATION



PROPOSED IMPROVEMENT
BRIDGE PROJECT


CITY OF RUTLAND
COUNTY OF RUTLAND

ROUTE NO : TH 13 (FOREST STREET) - URBAN COLLECTOR BRIDGE NO : 14


PROJECT LOCATION : ON FOREST STREET (TH 13), APPROXIMATELY 0.1 MILES
FROM THE INTERSECTION OF FOREST STREET (TH 13)
WITH PARK STREET (TH 12) OVER MOON BROOK

PROJECT DESCRIPTION : REPLACEMENT OF BRIDGE 14 WITH RELATED APPROACH ROADWAY AND CHANNEL WORK
NON-PARTICIPATING PAVING

LENGTH OF STRUCTURE : 53 FEET.
LENGTH OF ROADWAY : 172 FEET.
LENGTH OF PROJECT : 225 FEET.

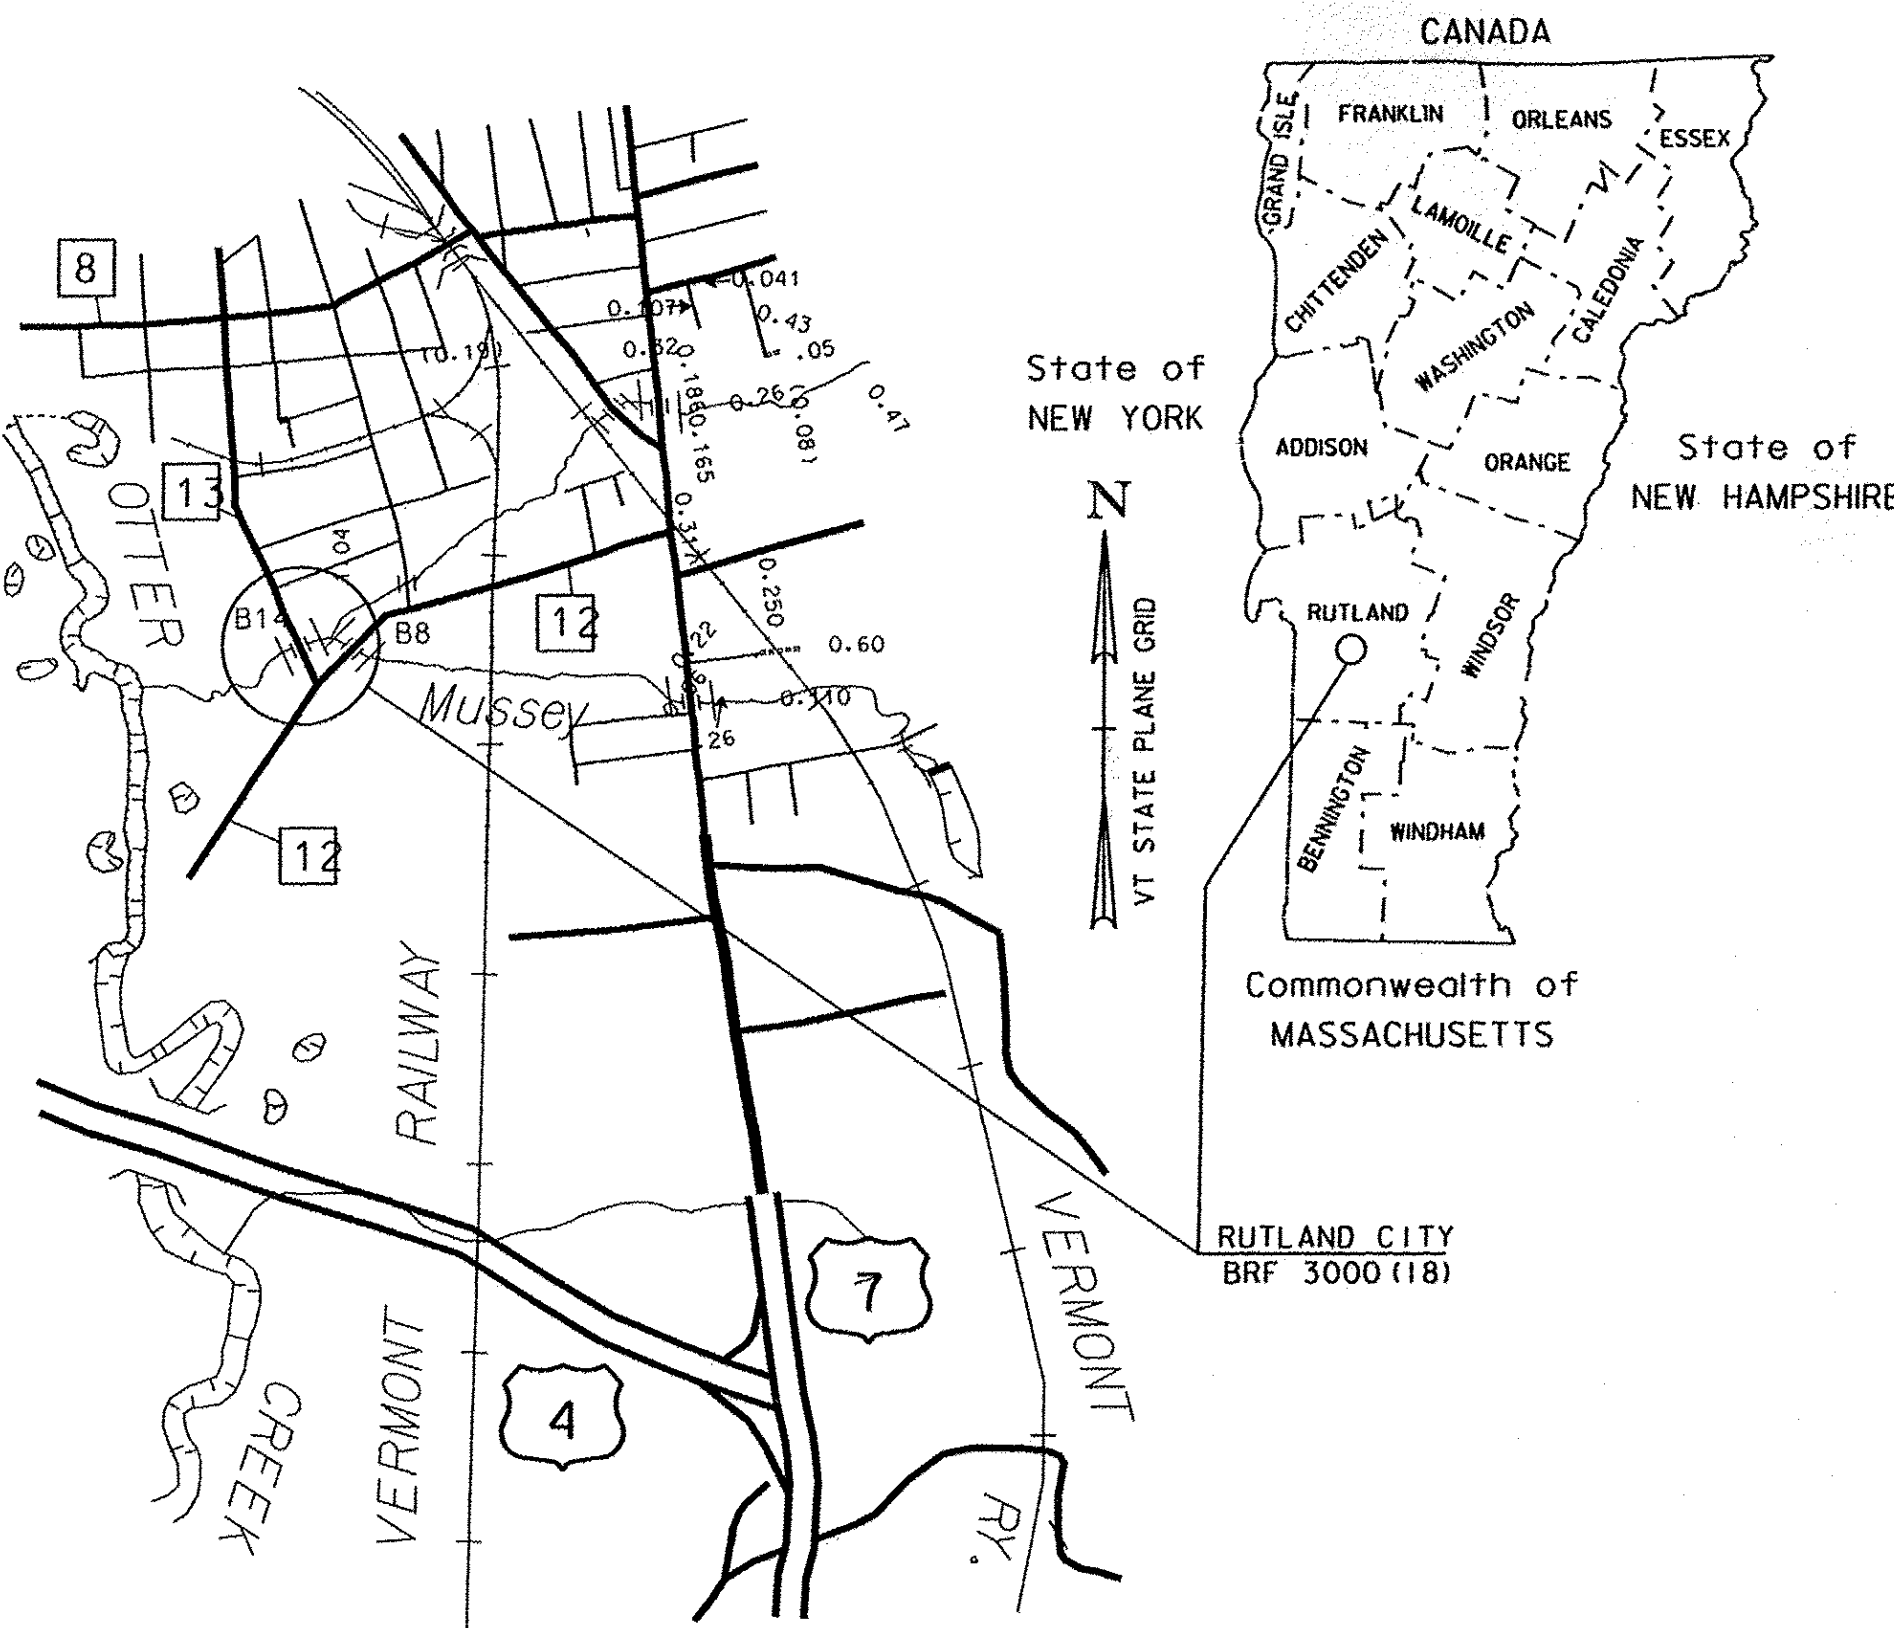

RECORD PLANS	
CONTRACTOR:	THE BELDEN CO. INC. - RUTLAND, VT
RESIDENT ENGINEER:	JUDY GILMORE
CONSTRUCTION BEGAN:	JULY 14, 2014
CONSTRUCTION COMPLETE:	OCTOBER 31, 2015
RECORD PLANS BY:	JUDY GILMORE & KEVIN KING
I HEREBY CERTIFY THAT ALL THE CONSTRUCTION REQUIRED BY THIS SET OF DRAWINGS HAS BEEN ACCOMPLISHED AS INDICATED HEREIN.	
BY <u>Judy Gilmore</u>	RESIDENT ENGINEER
DATE <u>1 June 2016</u>	
NOTE: Any further information concerning final quantities, amounts or other details relative to this project may be found at Central Files in the electronic archives.	

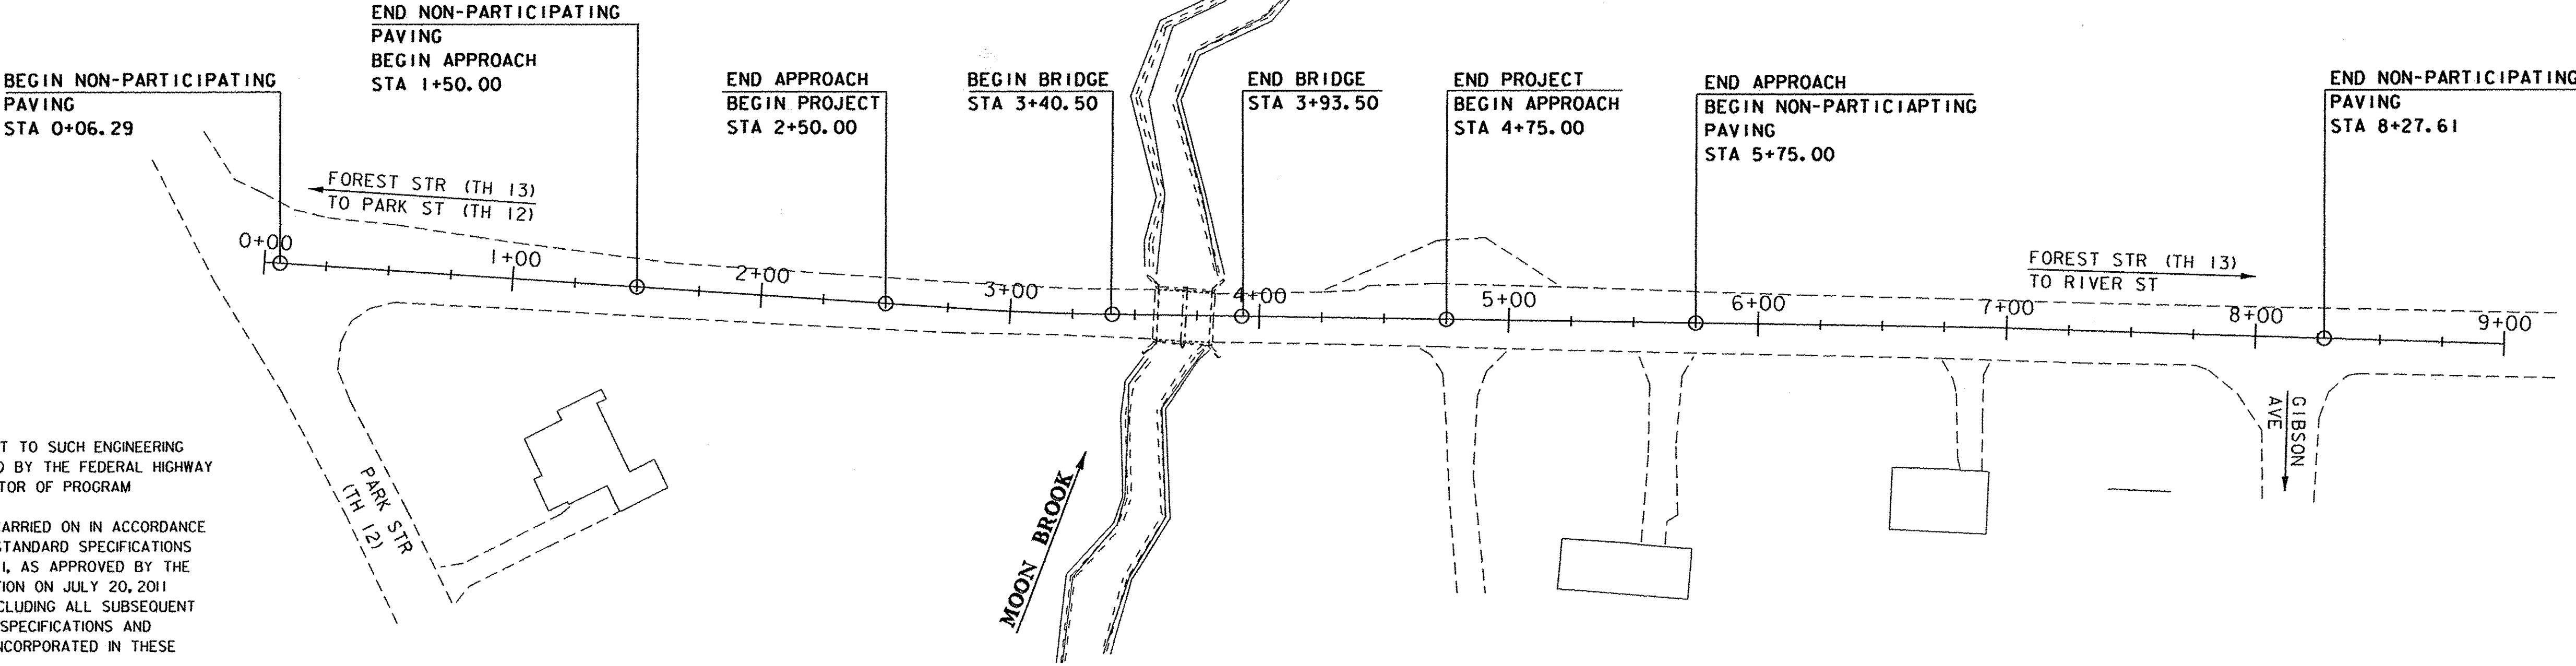

THESE PLANS ARE SUBJECT TO SUCH ENGINEERING CHANGES AS MAY BE REQUIRED BY THE FEDERAL HIGHWAY ADMINISTRATION OR THE DIRECTOR OF PROGRAM DEVELOPMENT.

CONSTRUCTION IS TO BE CARRIED ON IN ACCORDANCE WITH THESE PLANS AND THE STANDARD SPECIFICATIONS FOR CONSTRUCTION DATED 2011, AS APPROVED BY THE FEDERAL HIGHWAY ADMINISTRATION ON JULY 20, 2011 FOR USE ON THIS PROJECT, INCLUDING ALL SUBSEQUENT REVISIONS AND SUCH REVISED SPECIFICATIONS AND SPECIAL PROVISIONS AS ARE INCORPORATED IN THESE PLANS.

QUALITY ASSURANCE PROGRAM : LEVEL 2	
SURVEYED BY :	L. ORVIS
SURVEYED DATE :	4-23-1998
DATUM	
VERTICAL	NAVD 88
HORIZONTAL	NAD 83 (96)

SCALE 1" = 40' - 0"

DIRECTOR OF PROGRAM DEVELOPMENT	
APPROVED <u>Kevin J. Maslin</u>	DATE <u>3/3/14</u>
PROJECT MANAGER : CAROLYN CARLSON, P.E.	
PROJECT NAME : RUTLAND CITY	
PROJECT NUMBER : BR 3000 (18)	
SHEET 1 OF 44 SHEETS	