


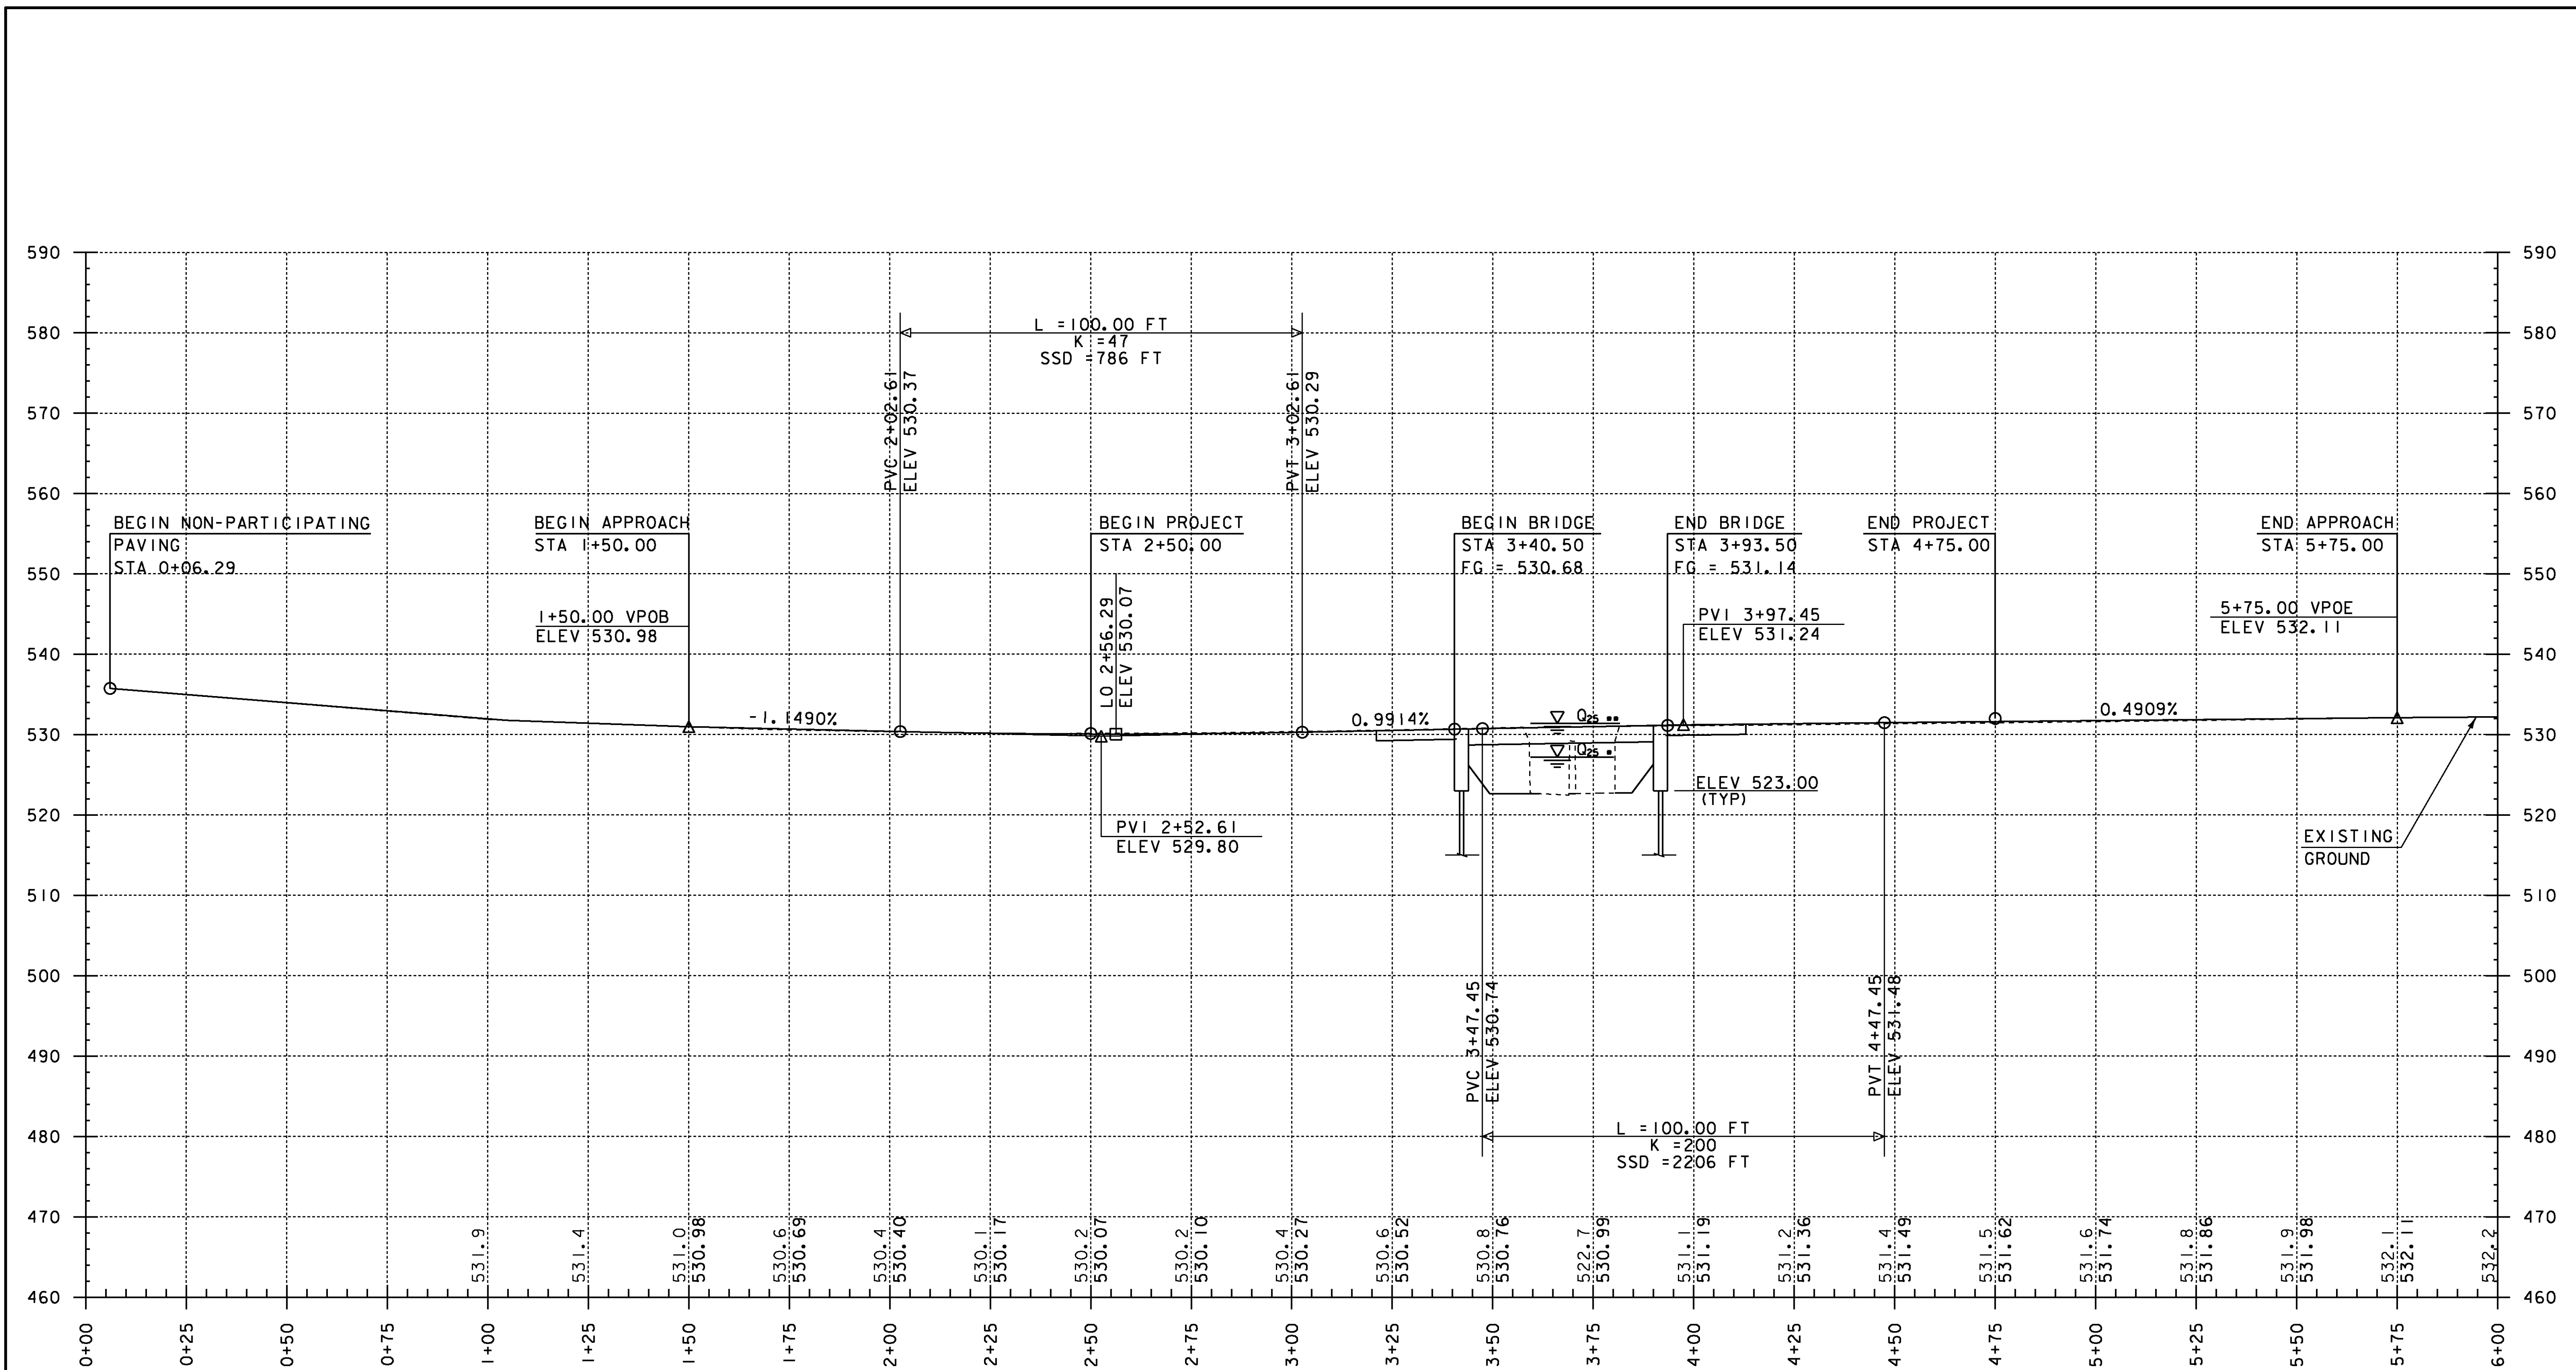

PROFILE

HORIZONTAL SCALE: 1" = 20'-0"
VERTICAL SCALE: 1" = 10'-0"

THE GRADES SHOWN TO THE NEAREST TENTH ARE THE ORIGINAL GROUND ELEVATIONS ALONG THE PROPOSED ALIGNMENT.

THE GRADES SHOWN TO THE NEAREST HUNDREDTH ARE THE FINISH GRADES ALONG THE PROPOSED ALIGNMENT.

Q₂₅ ** = 531.4' WITH OTTER CREEK TAILWATER
Q₂₅ * = 527.2' WITHOUT OTTER CREEK TAILWATER

PROJECT NAME: RUTLAND CITY	
PROJECT NUMBER: BRF 3000(18)	
FILE NAME: s96j244profile.dgn	PLOT DATE: 28-FEB-2014
PROJECT LEADER: C. CARLSON	DRAWN BY: R. PELLETT
DESIGNED BY: M. EVANS-MONGEON	CHECKED BY: M. E-M
PROFILE 1	SHEET 13 OF 44