

STATE OF VERMONT
AGENCY OF TRANSPORTATION




PROPOSED IMPROVEMENT
BRIDGE PROJECT
TOWN OF RUTLAND CITY
COUNTY OF RUTLAND

ROUTE NO : TH 13 (FOREST STREET) - URBAN COLLECTOR BRIDGE NO : 14

PROJECT LOCATION : ON FOREST STREET (TH 13), APPROXIMATELY 0.1 MILES
FROM THE INTERSECTION OF FOREST STREET (TH 13)
WITH PARK STREET (TH 12) OVER MOON BROOK

PROJECT DESCRIPTION : REPLACEMENT OF BRIDGE 14 WITH RELATED APPROACH ROADWAY AND CHANNEL WORK
NON-PARTICIPATING PAVING AND WATERLINE

LENGTH OF STRUCTURE : 52 FEET.
LENGTH OF ROADWAY : 173 FEET.
LENGTH OF PROJECT : 225 FEET.

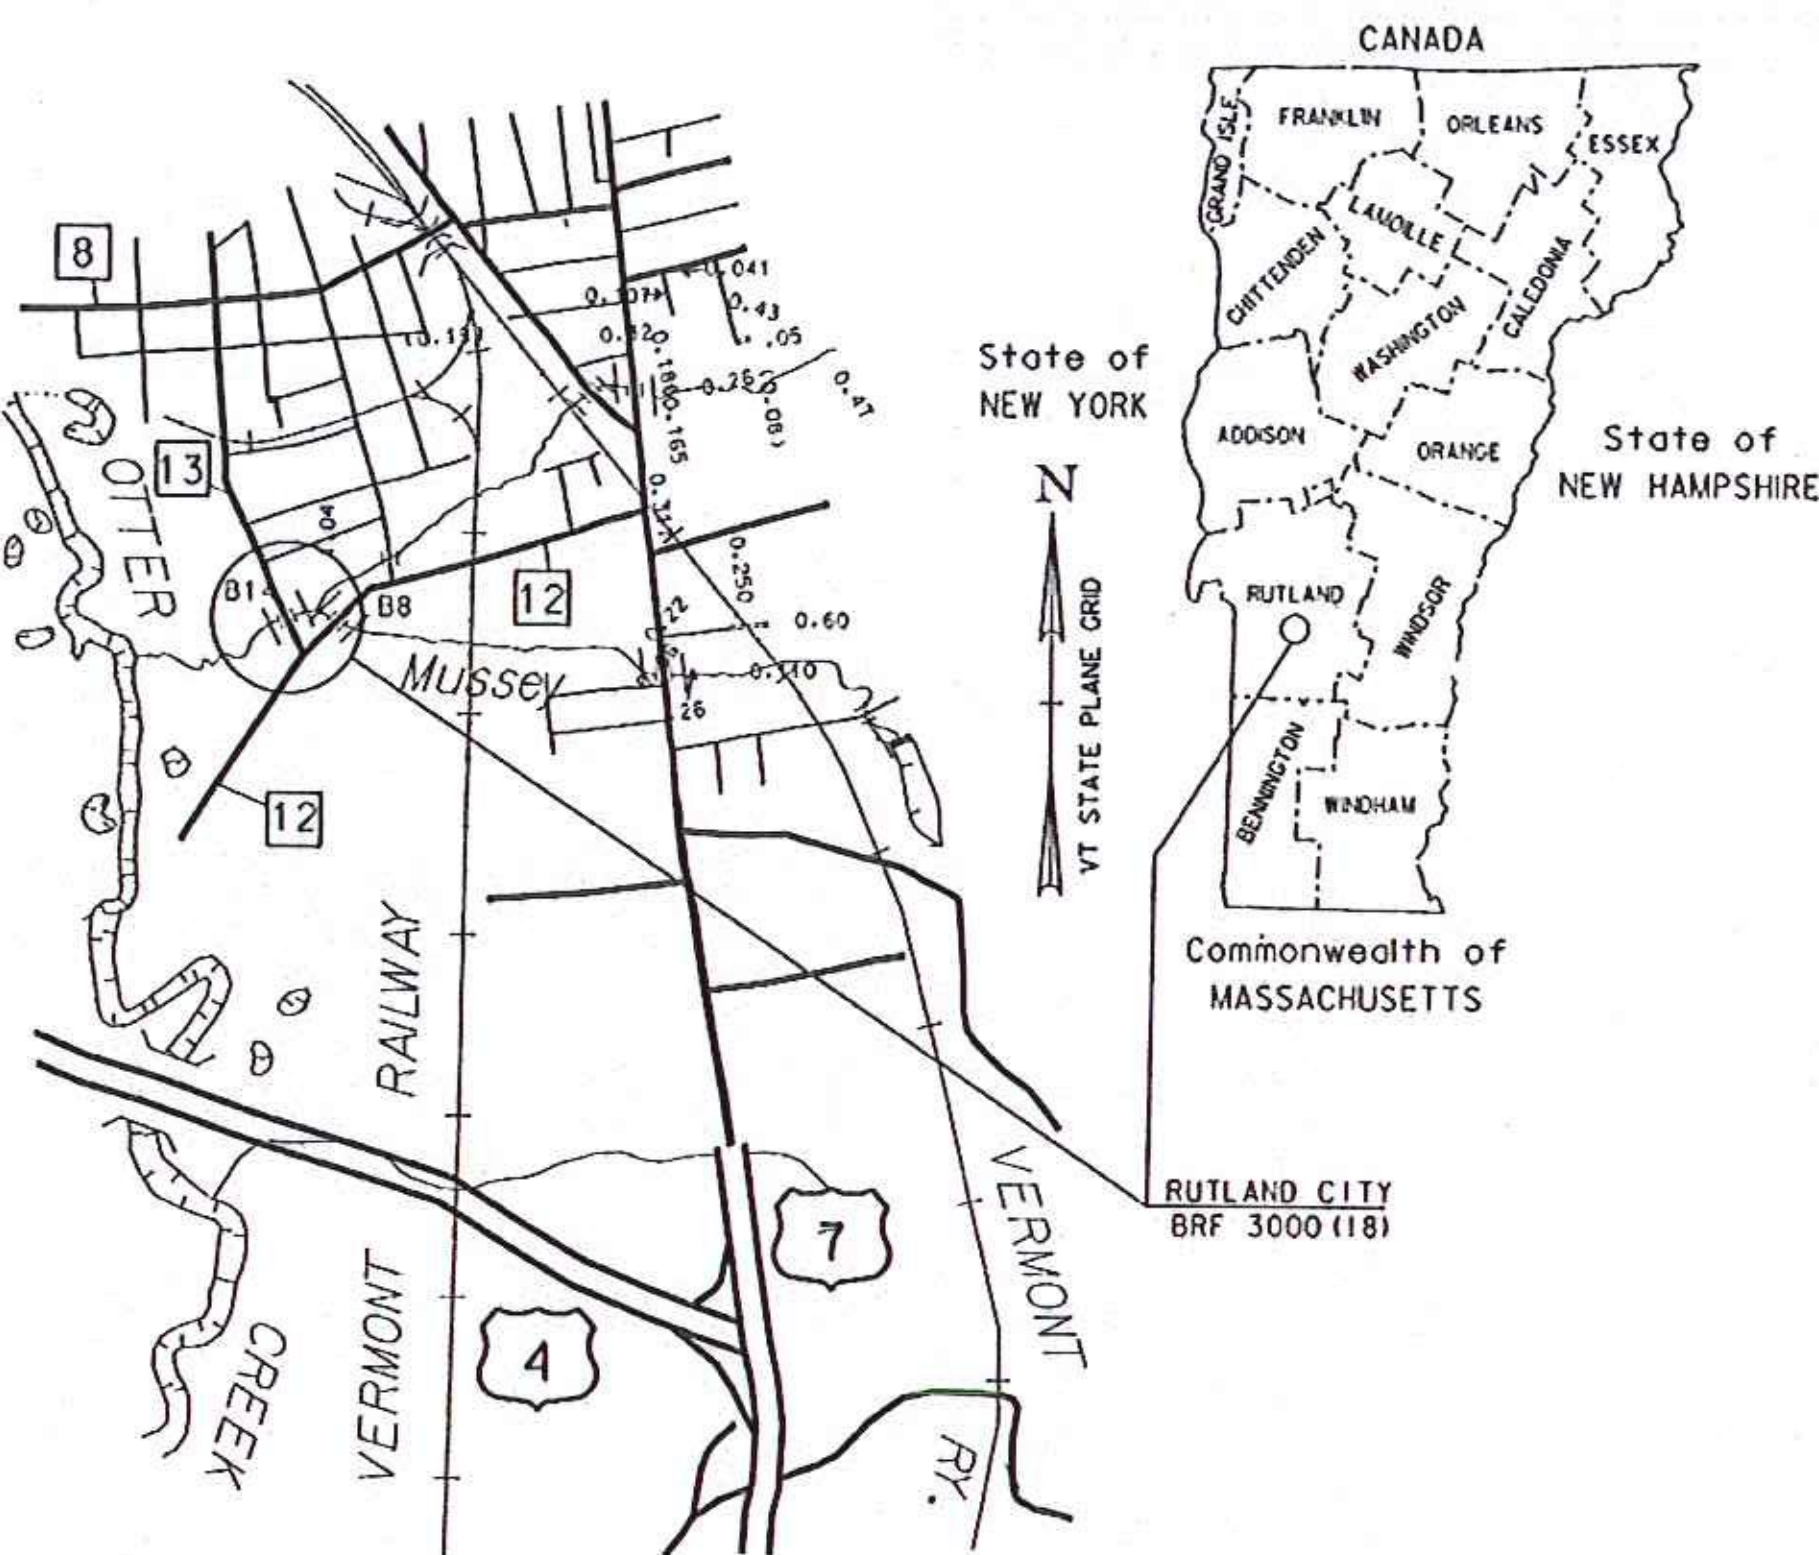

RECORD PLANS

**WATER & SEWER
REPLACEMENT
PLAN SUBSET**

DECEMBER 2014

NOTE:
THIS COVER SHEET USED TO SHOW PROJECT LOCUS.

BEGIN NON-PARTICIPATING
PAVING
STA 0+06.29

BEGIN PROJECT
STA 2+50.00
END NON-PARTICIPATING
PAVING

BEGIN BRIDGE
STA 3+41.00

END BRIDGE
STA 3+93.00

END PROJECT
STA 4+75.00
BEGIN NON-PARTICIPATING
PAVING

END NON-PARTICIPATING
PAVING
STA 8+27.61

QUALITY ASSURANCE PROGRAM: LEVEL 2

CONVENTIONAL SYMBOLS

COUNTY LINE	
TOWN LINE	
LIMITS OF ACCESS	
POINT OF ACCESS	
FENCE LINE	
STONE WALL	
TRAVELED WAY	
GUARD RAIL	
RAILROAD	
SURVEY LINE	
CULVERT	
POWER POLE	
TELEPHONE POLE	
TREES	
CONTROL OF ACCESS	
PROPERTY LINE	
R.O.W. TAKING LINE	
SLOPE RIGHTS	
TOP OF CUT	
TOE OF SLOPE	

SURVEYED BY : L. ORVIS
SURVEYED DATE : 4-23-1998

DATUM
VERTICAL NAVD 88
HORIZONTAL NAD 88 (96)

SCALE 1" = 40'-0"
40 0 40

RECORD DRAWING WATER AND SEWER ELEMENTS
SOME OF THE CONTENT SHOWN ON THESE RECORD DRAWINGS HAS BEEN PREPARED BASED
ON INFORMATION FURNISHED BY OTHERS. THE LOCATION OF ITEMS SHOWN WITHOUT
LABELED DIMENSIONS SHALL BE CONSIDERED AS APPROXIMATE. MODIFICATIONS TO
BRIDGE ELEMENTS ARE NOT ADDRESSED ON THESE RECORD PLANS. THE SITE WAS NOT
RE-SURVEYED AFTER CONSTRUCTION, SO RECORD LOCATIONS, ELEVATIONS AND FINISH
GRADES ARE APPROXIMATE AND SHALL BE CONSIDERED "SCHEMATIC." DETAILS AND CROSS
SECTIONS MAY NOT REFLECT "AS-BUILT" CONDITIONS.
CONTRACTOR: THE BELDEN COMPANY, INC.
UTILITY ENGINEER: CLD CONSULTING ENGINEERS, INC.



THESE PLANS ARE SUBJECT TO SUCH ENGINEERING
CHANGES AS MAY BE REQUIRED BY THE FEDERAL HIGHWAY
ADMINISTRATION OR THE DIRECTOR OF PROGRAM
DEVELOPMENT.
CONSTRUCTION IS TO BE CARRIED ON IN ACCORDANCE
WITH THESE PLANS AND THE STANDARD SPECIFICATIONS
FOR CONSTRUCTION DATED 2011, AS APPROVED BY THE
FEDERAL HIGHWAY ADMINISTRATION ON JULY 20, 2011
FOR USE ON THIS PROJECT, INCLUDING ALL SUBSEQUENT
REVISIONS AND SUCH REVISED SPECIFICATIONS AND
SPECIAL PROVISIONS AS ARE INCORPORATED IN THESE
PLANS.

PROJECT MANAGER : CAROLYN CARLSON

PROJECT NAME : RUTLAND CITY
PROJECT NUMBER : BRF 3000 (18)

SHEET 0 OF 7 SHEETS

CLD 13-0126 MODEL: TITLE