

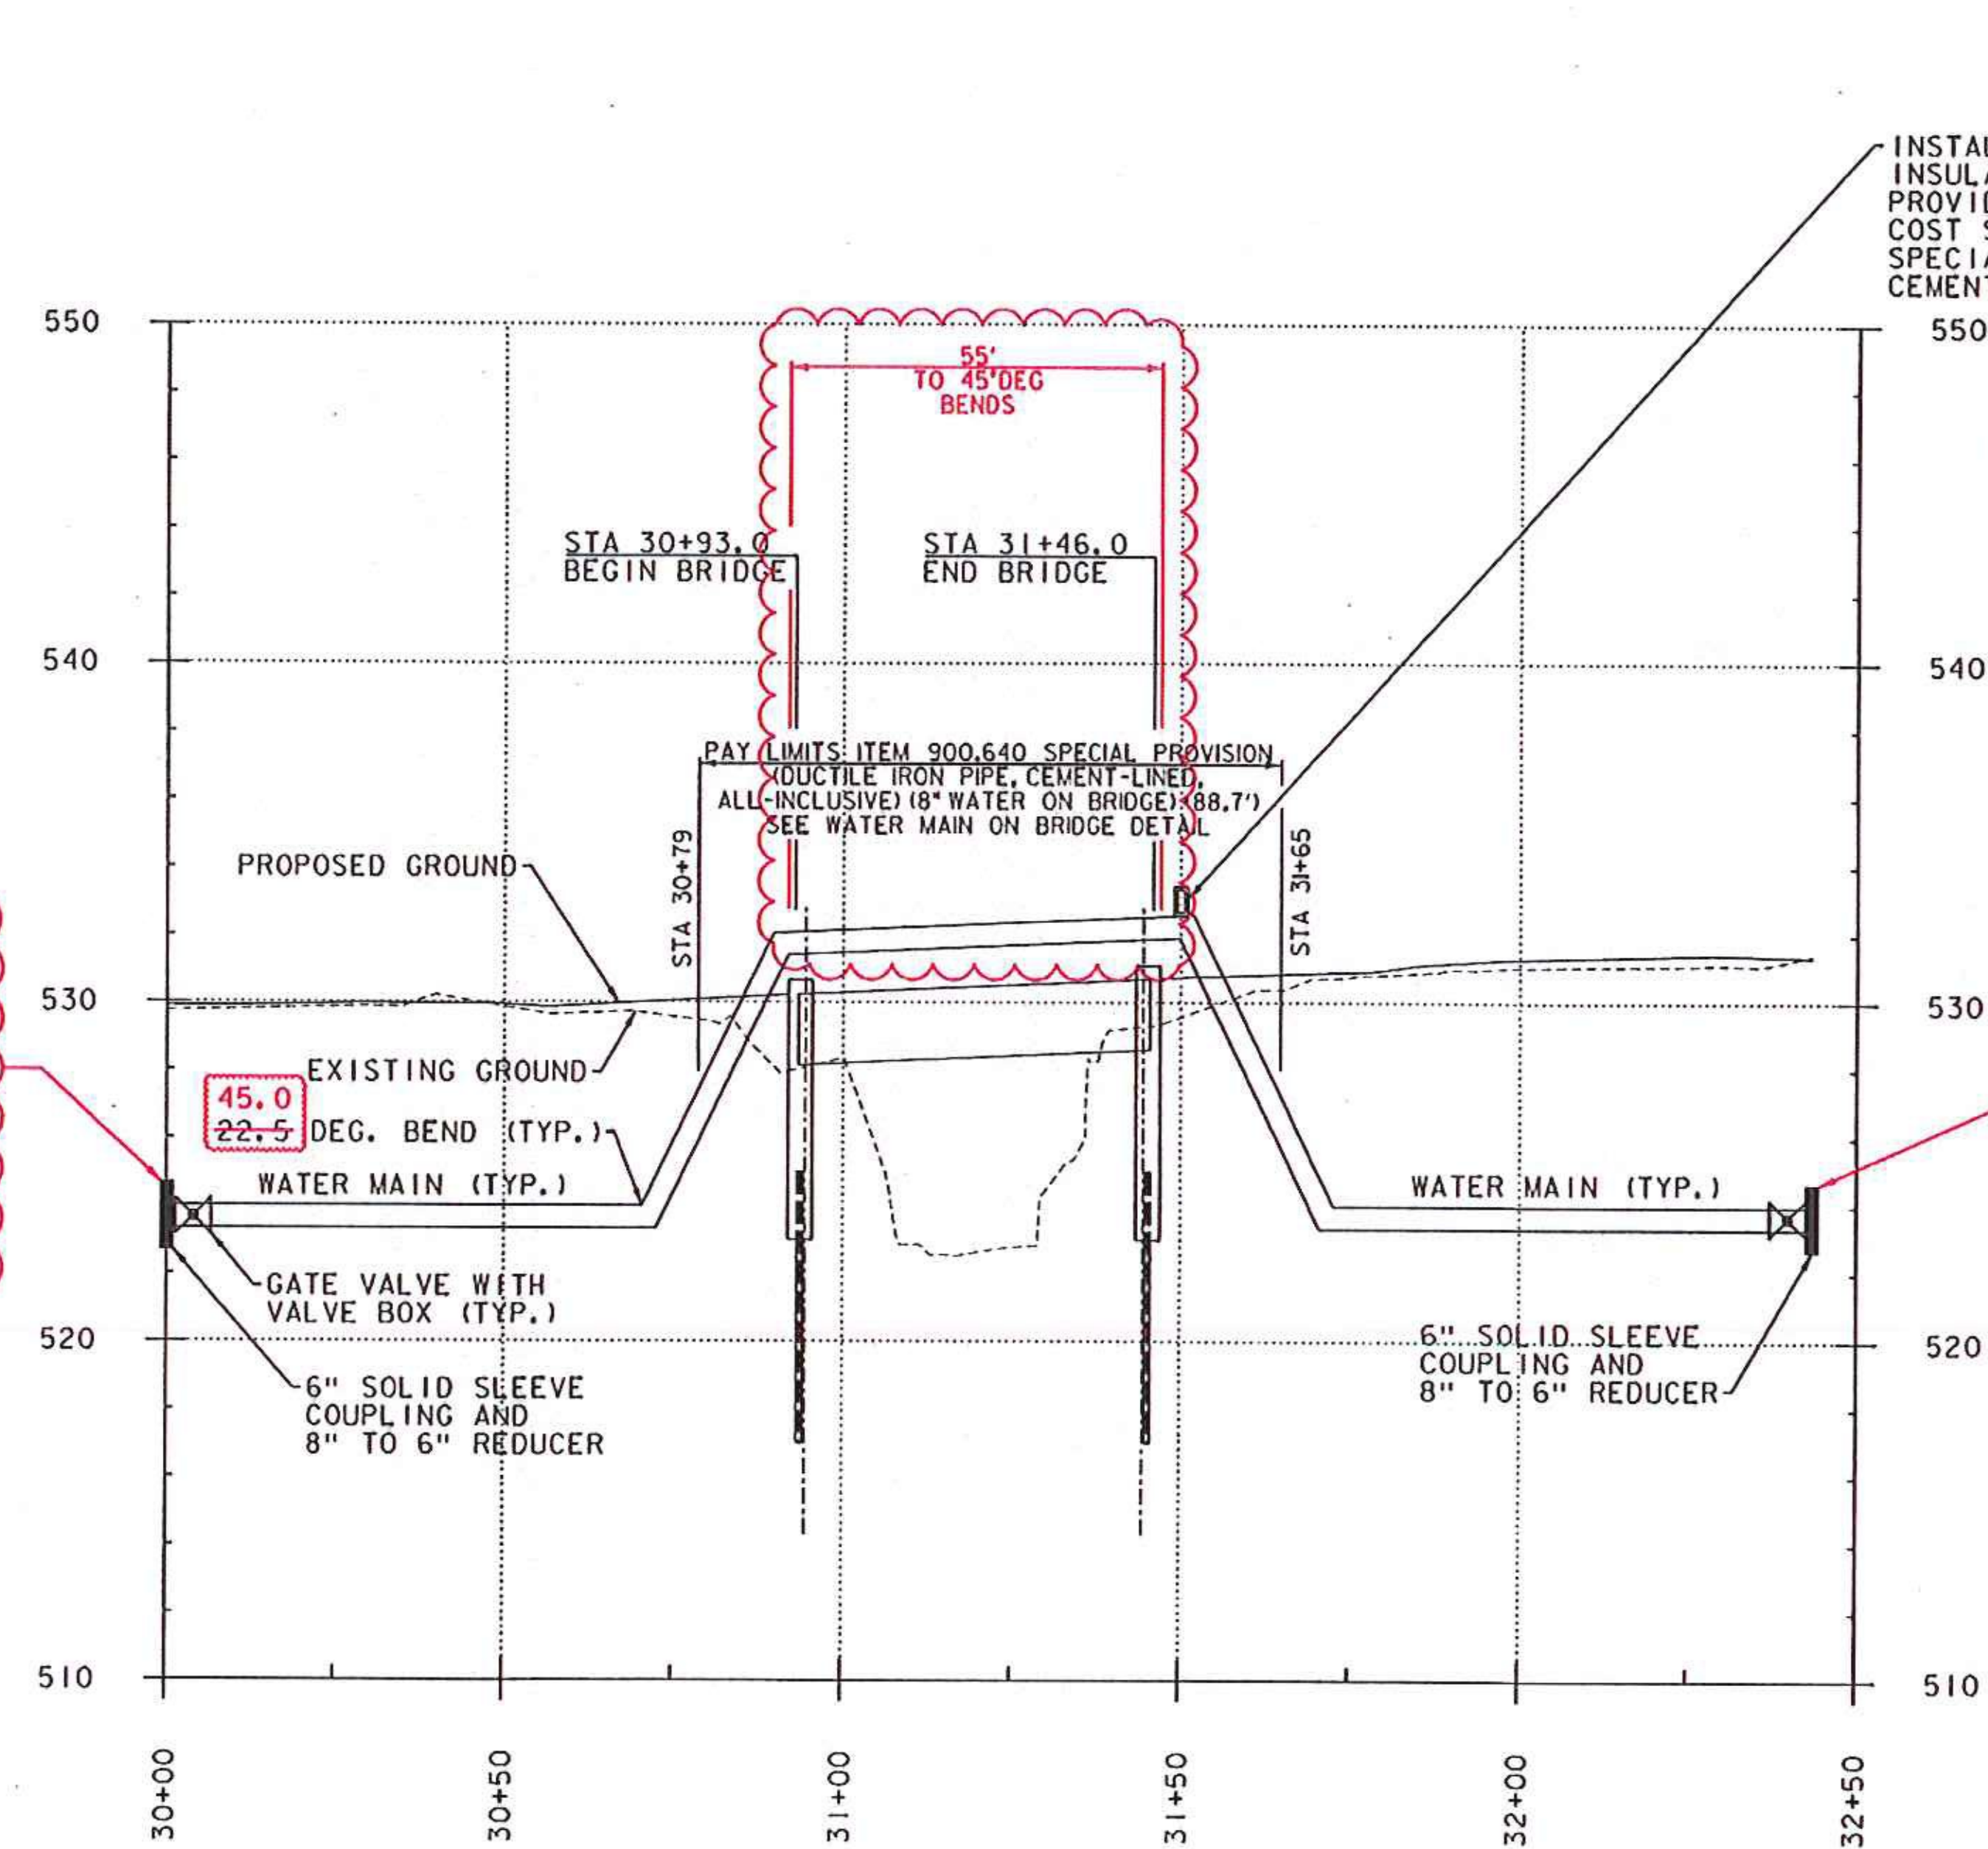


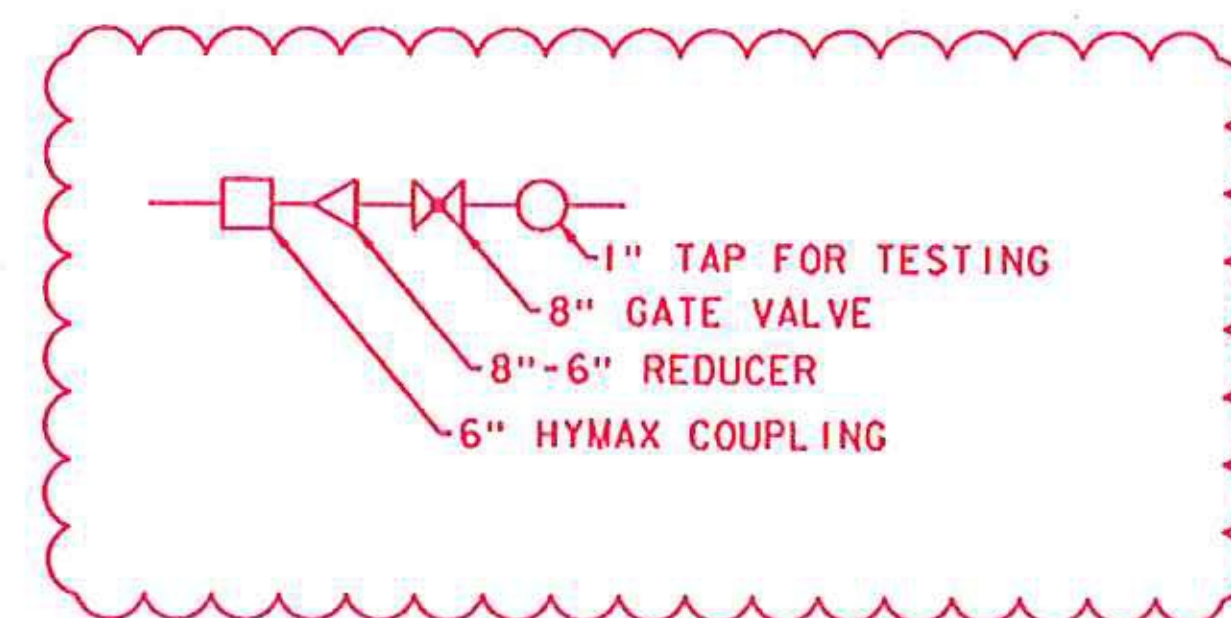

INSTALL AIR RELIEF VALVE WITH WEATHERPROOF, INSULATED AND LOCKABLE ENCLOSURE. PROVIDE FABRICATION DRAWING FOR REVIEW. COST SHALL BE INCIDENTAL TO ITEM 900.640 SPECIAL PROVISION (DUCTILE IRON PIPE, CEMENT-LINED, ALL-INCLUSIVE) (8" WATER ON BRIDGE)

NOT REQUIRED BY CITY

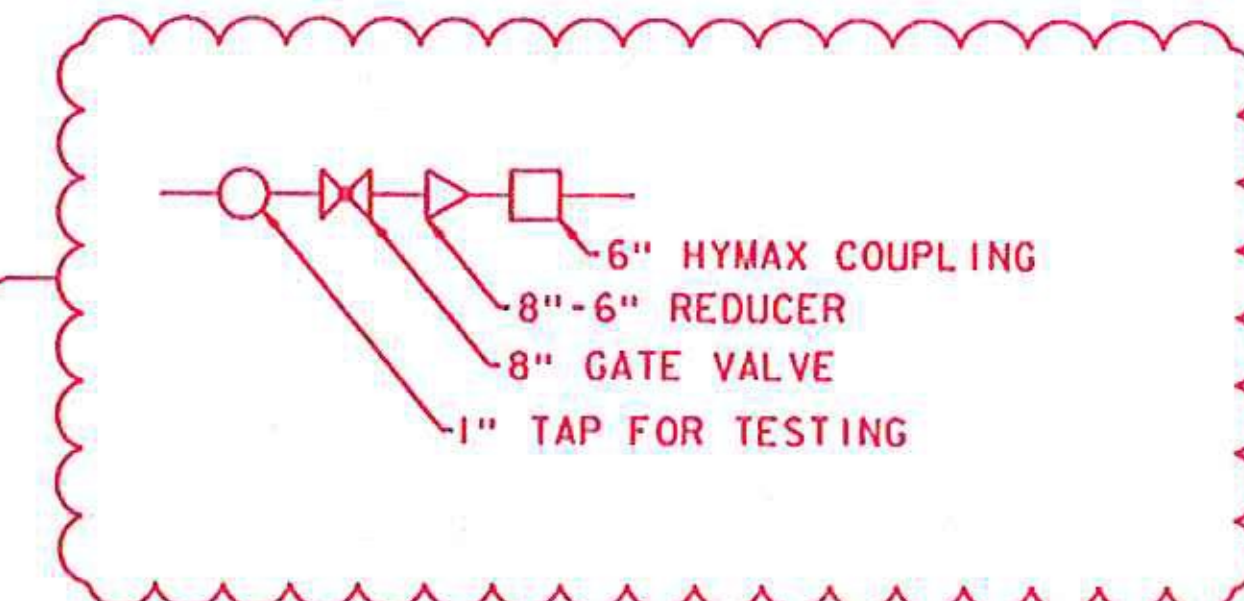

WATER MAIN STATION
 HOR. SCALE 1" = 20'-0"
 VER. SCALE 1" = 4'-0"

- 3 RECORD CHANGES CLOUD
- PLAN REVISIONS
- 2 3/5/14: REVISED WATER MAIN PROFILE ON BRIDGE TO ACCOMMODATE HANGER INSTALLATION REQUIREMENTS. REVISED AIR RELIEF VALVE AND GATE VALVE LOCATIONS.
- 1 1/16/14: ADDED NOTE TO DEFINE INSULATION EXTENT AND CORRECTED SCALE (PER DEC).

WATER AND SEWER PLANS		PROJECT NAME: RUTLAND CITY
		PROJECT NUMBER: BRF 3000(18)
	FILE NAME: \$FILEABBREV\$	PLOT DATE: 3/5/2014
	PROJECT LEADER: C. BEAN	DRAWN BY: W. GORDON
	DESIGNED BY: D. LEWIS	CHECKED BY: S. REICHERT
	WATER PROFILE	SHEET 7 OF 7

540 Commercial Street, Manchester, NH 03101
 (603) 888-8223 • Fax (603) 888-8802
 clde@cldeengineers.com • www.cldeengineers.com
 Maine • New Hampshire • Vermont