
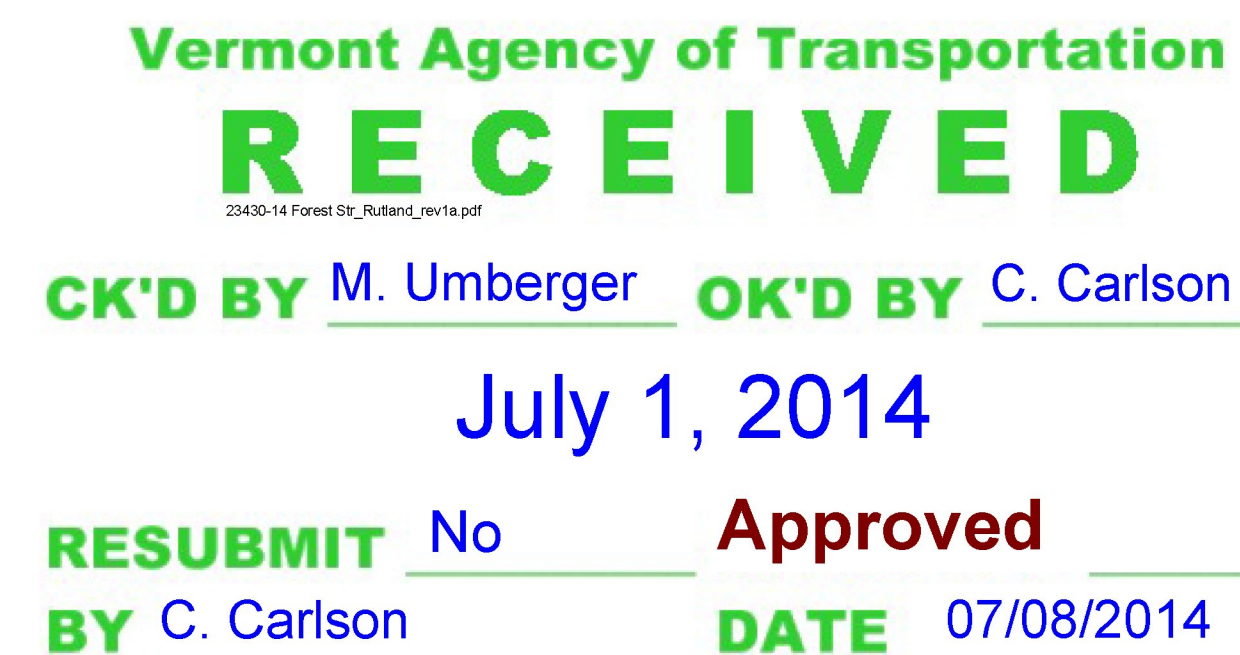
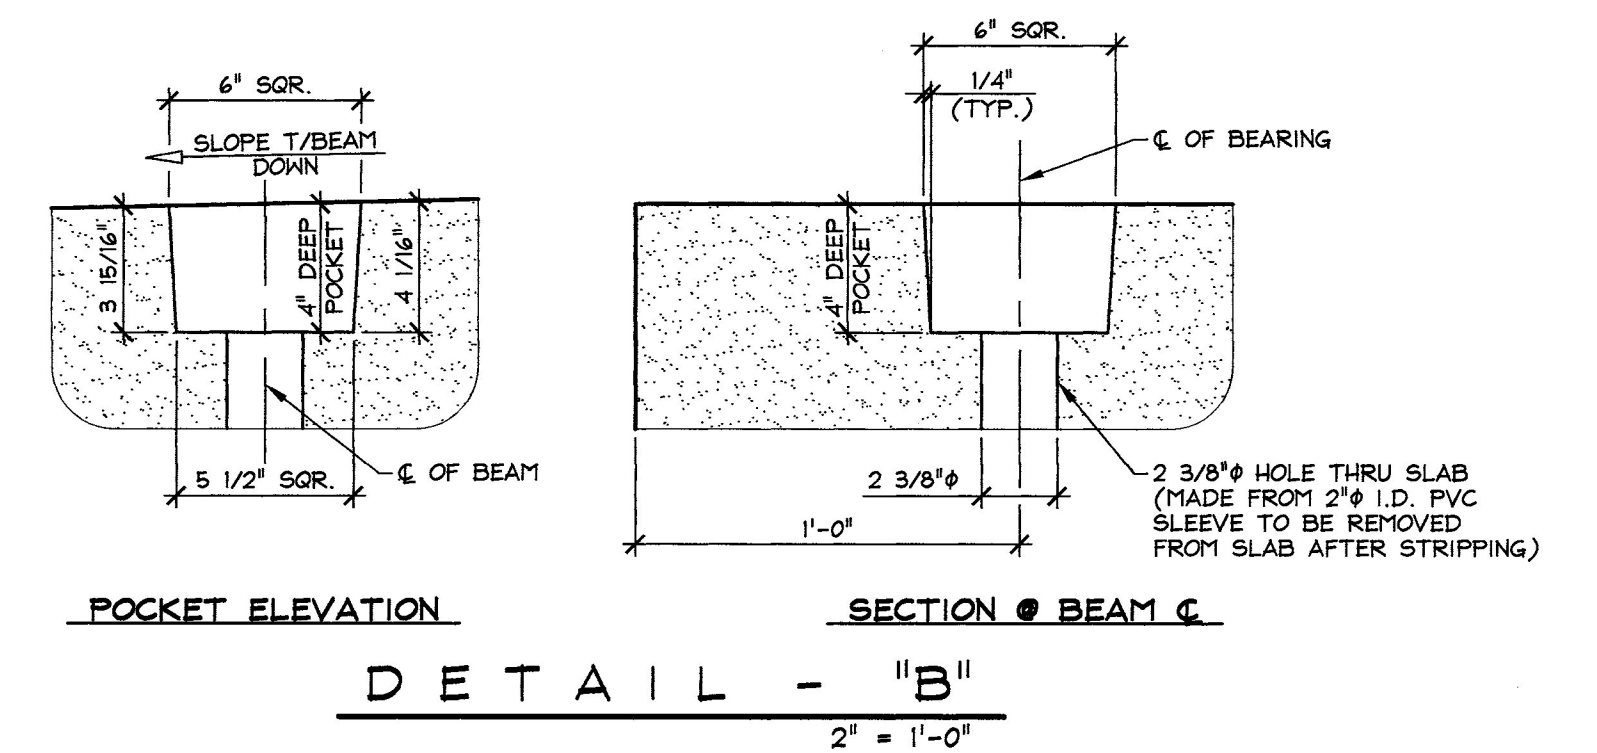


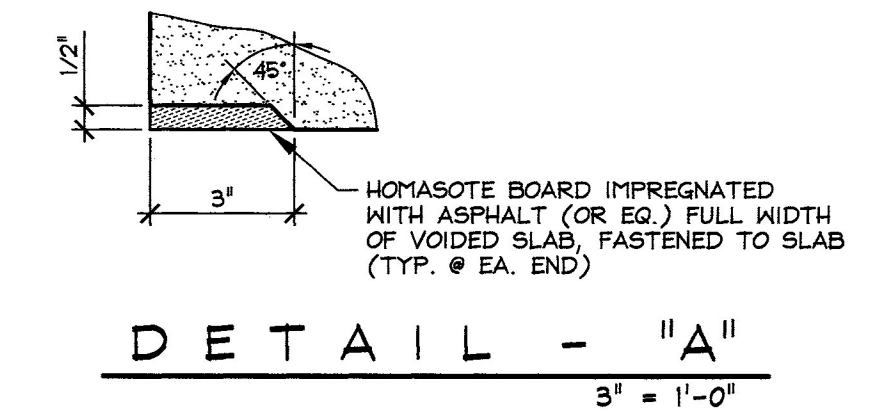

MARK:	R-SSA	QTY.: 2	WT.: 24.48 T	VOL.: 12.09 cy
MATERIAL LIST / VOIDED SLAB				
ITEM	MARK	DESCRIPTION		QTY.
1	R-401D	#4 BENT BAR (LEVEL II, DUAL COATED)		120
2	R-402D	#4 BENT BAR (LEVEL II, DUAL COATED)		64
3	R-403D	#4 x 3'-7 1/2" (LEVEL II, DUAL COATED)		24
4				
5				
6				
7				
8				
9				
10				
11		3/4"φ x 6" NON-FERROUS VOID DRAIN		24
12		10"φ x 9'-10" VOID		6
13		10"φ x 10'-10" VOID		6
14		SET OF TRIPLE 0.60"φ STRAND LIFTING LOOPS		4
15				

APPROVAL STAMP:	J.P. CARRARA & SONS INC. Precast & Prestress Manufacturer 2464 OASE STR., MIDDLEBURY, VERMONT 05753 Phone:(802)388-6361 Fax:(802)388-9010		THE BELDEN COMPANY, INC. CONTRACTOR RUTLAND, VERMONT	
	STATE OF VERMONT AGENCY OF TRANSPORTATION COUNTY OF RUTLAND		DATE: APR. 25, 2014	
			SCALE: NOTED	
	CITY OF RUTLAND ROUTE NO.: TH 13 (FOREST STREET) - URBAN COLLECTOR BRIDGE NO.: 14 PROJECT NO.: BRP 3000(18)		CHKD: M.D.	DFTM: B.L.
			JOB NO: 23430-014	
PRESTRESSED VOIDED SLAB DETAILS		DWG. NO: SS2		