



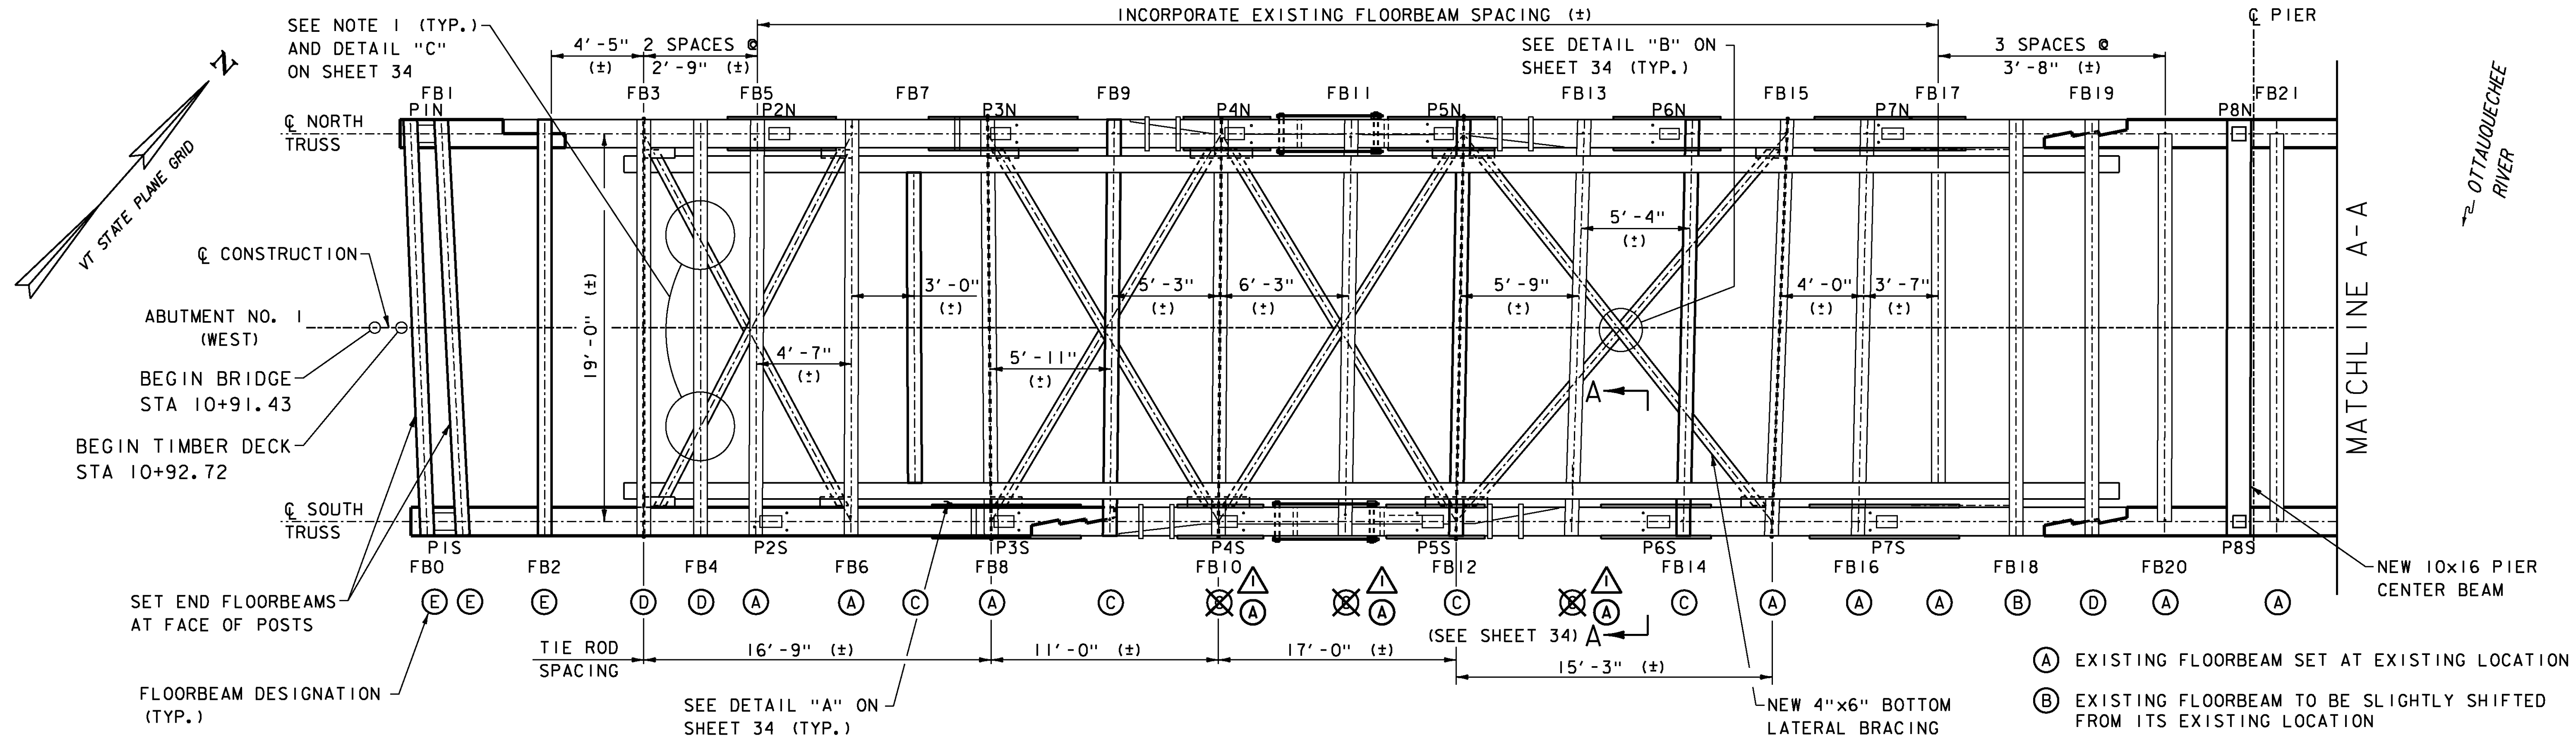

FLOOR FRAMING PLAN - SPAN 1

SCALE: 1/4" = 1'-0"

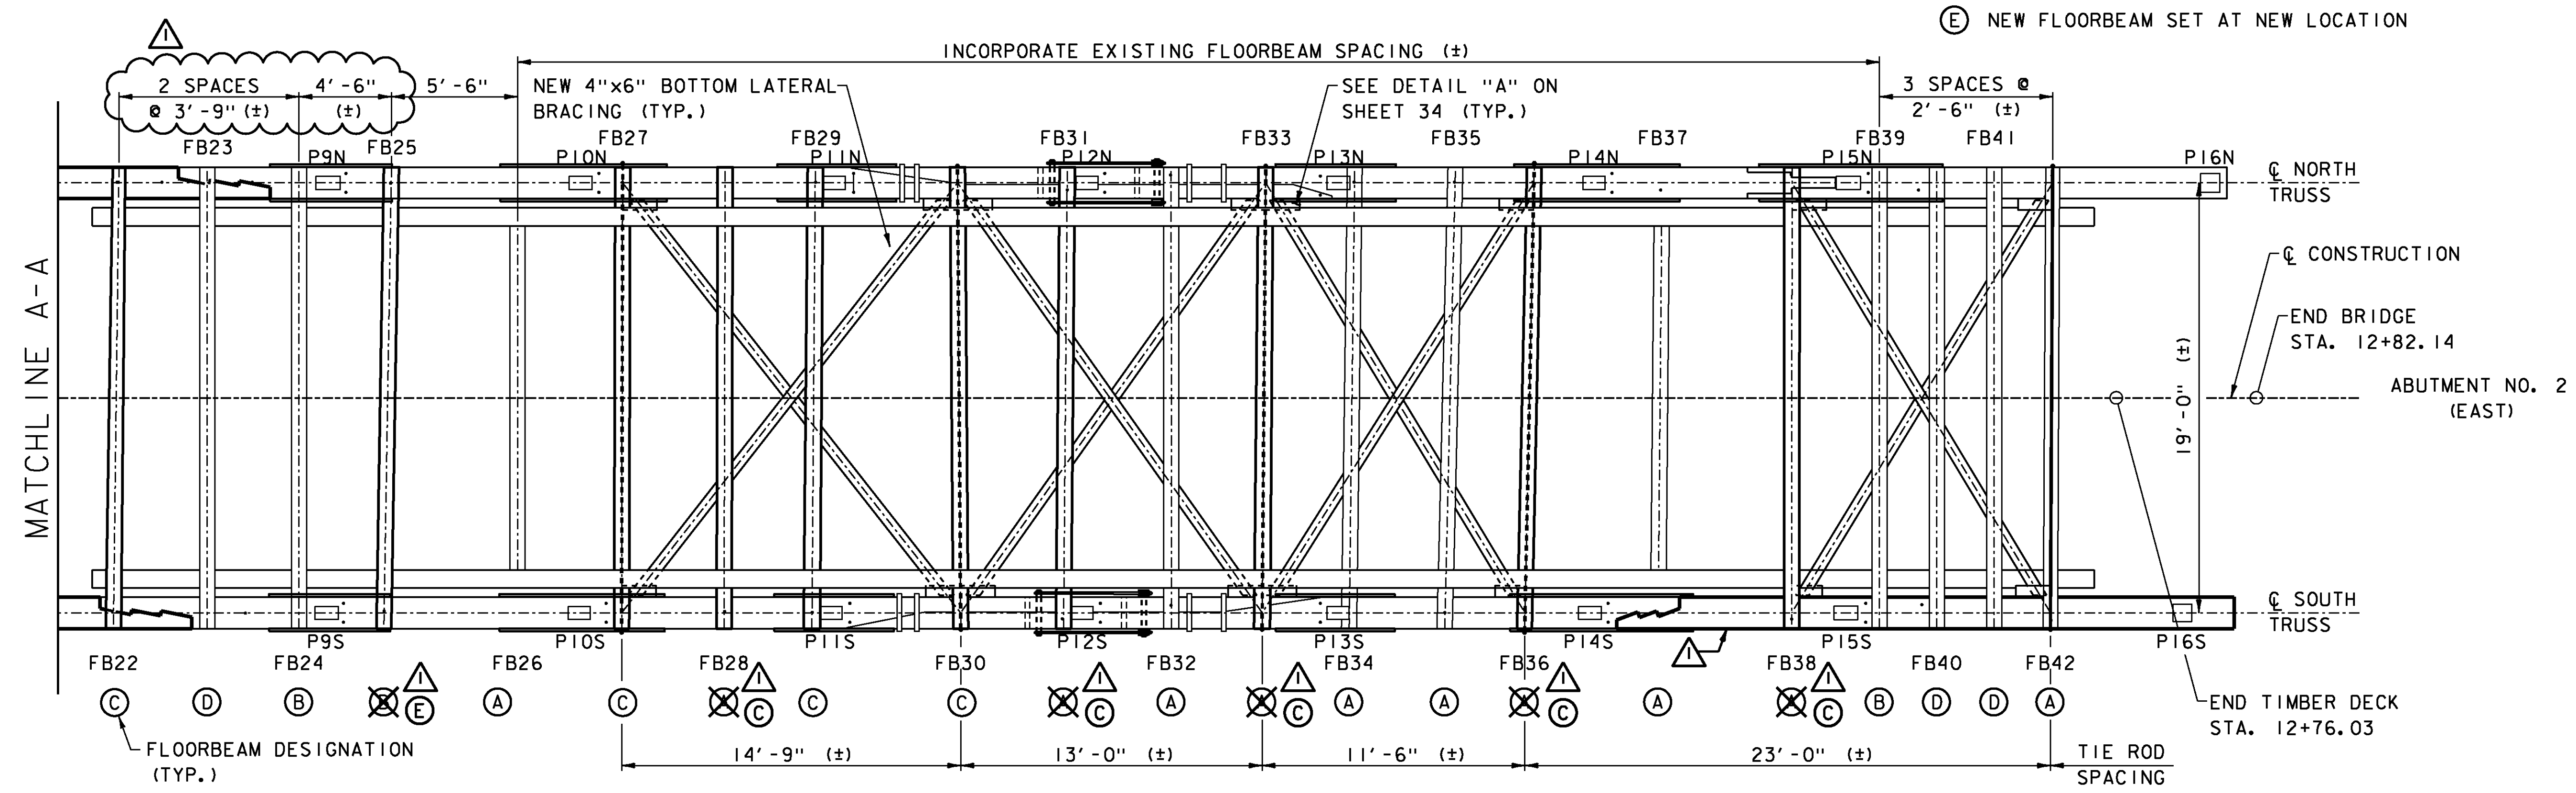

FLOOR FRAMING PLAN - SPAN 2

SCALE: 1/4" = 1'-0"

LEGEND

FB FLOORBEAM
P POST

NOTES

1. LAG LATERAL BRACING FROM UNDERNEATH TO FLOORBEAMS AT FB4, FB5, FB9, FB11, FB13, FB14, FB28, FB29, FB31, FB32, FB34, FB36, FB39 AND FB41 AT BRACING/FLOORBEAM CROSSINGS (2 PER FLOORBEAM) WITH 3/4" DIA. HEX HEADED LAG SCREWS. SEE DETAIL "C" ON SHEET 34.
2. FOR FLOORBEAM REFERENCE TABLE, SEE SHEET 56.

- A UPDATE FB DESIGNATION AND LOWER CHORD WORK LIMITS (PER FIELD INSPECTION)
- B REVISE LOCATIONS OF BOTTOM LATERAL BRACING

SCALE 1/4" = 1'-0"
1 0 2 4 6



PROJECT NAME:	WOODSTOCK	WOODSTOCK
PROJECT NUMBER:	BHO 1442(52)	ST 1444(58)
FILE NAME:	z96j262ffp.dgn	PLOT DATE: \$\$\$DATE\$\$\$
PROJECT LEADER:	M. Sargent	DRAWN BY: P. Dustin
DESIGNED BY:	P. Dustin	CHECKED BY: R. Joy
FLOOR FRAMING PLAN		SHEET 29A OF 68