




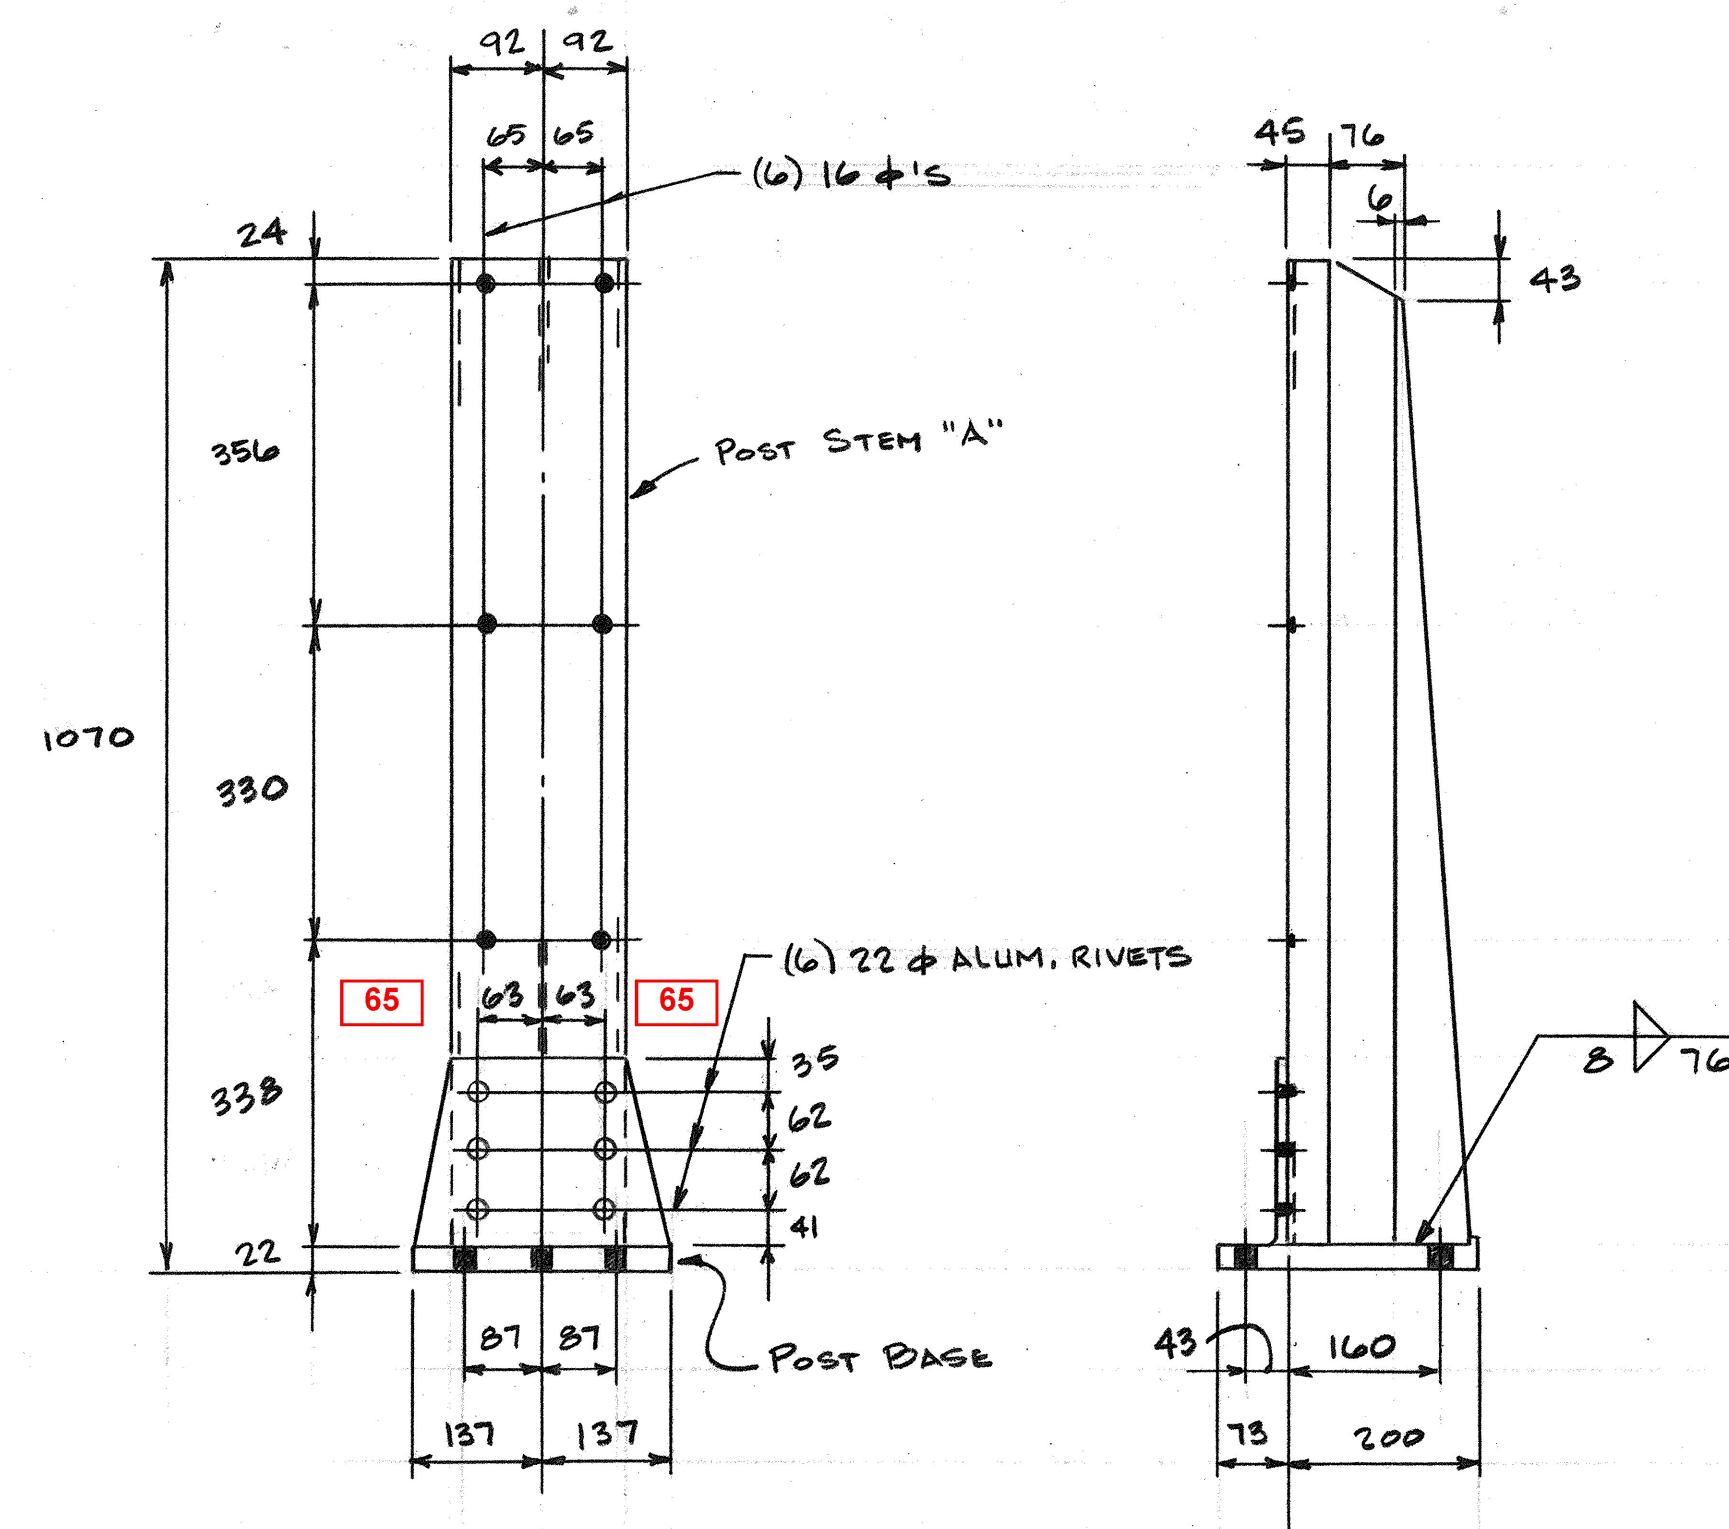


BRIDGE RAIL POST ~ "P1" (12 REQ'D.)

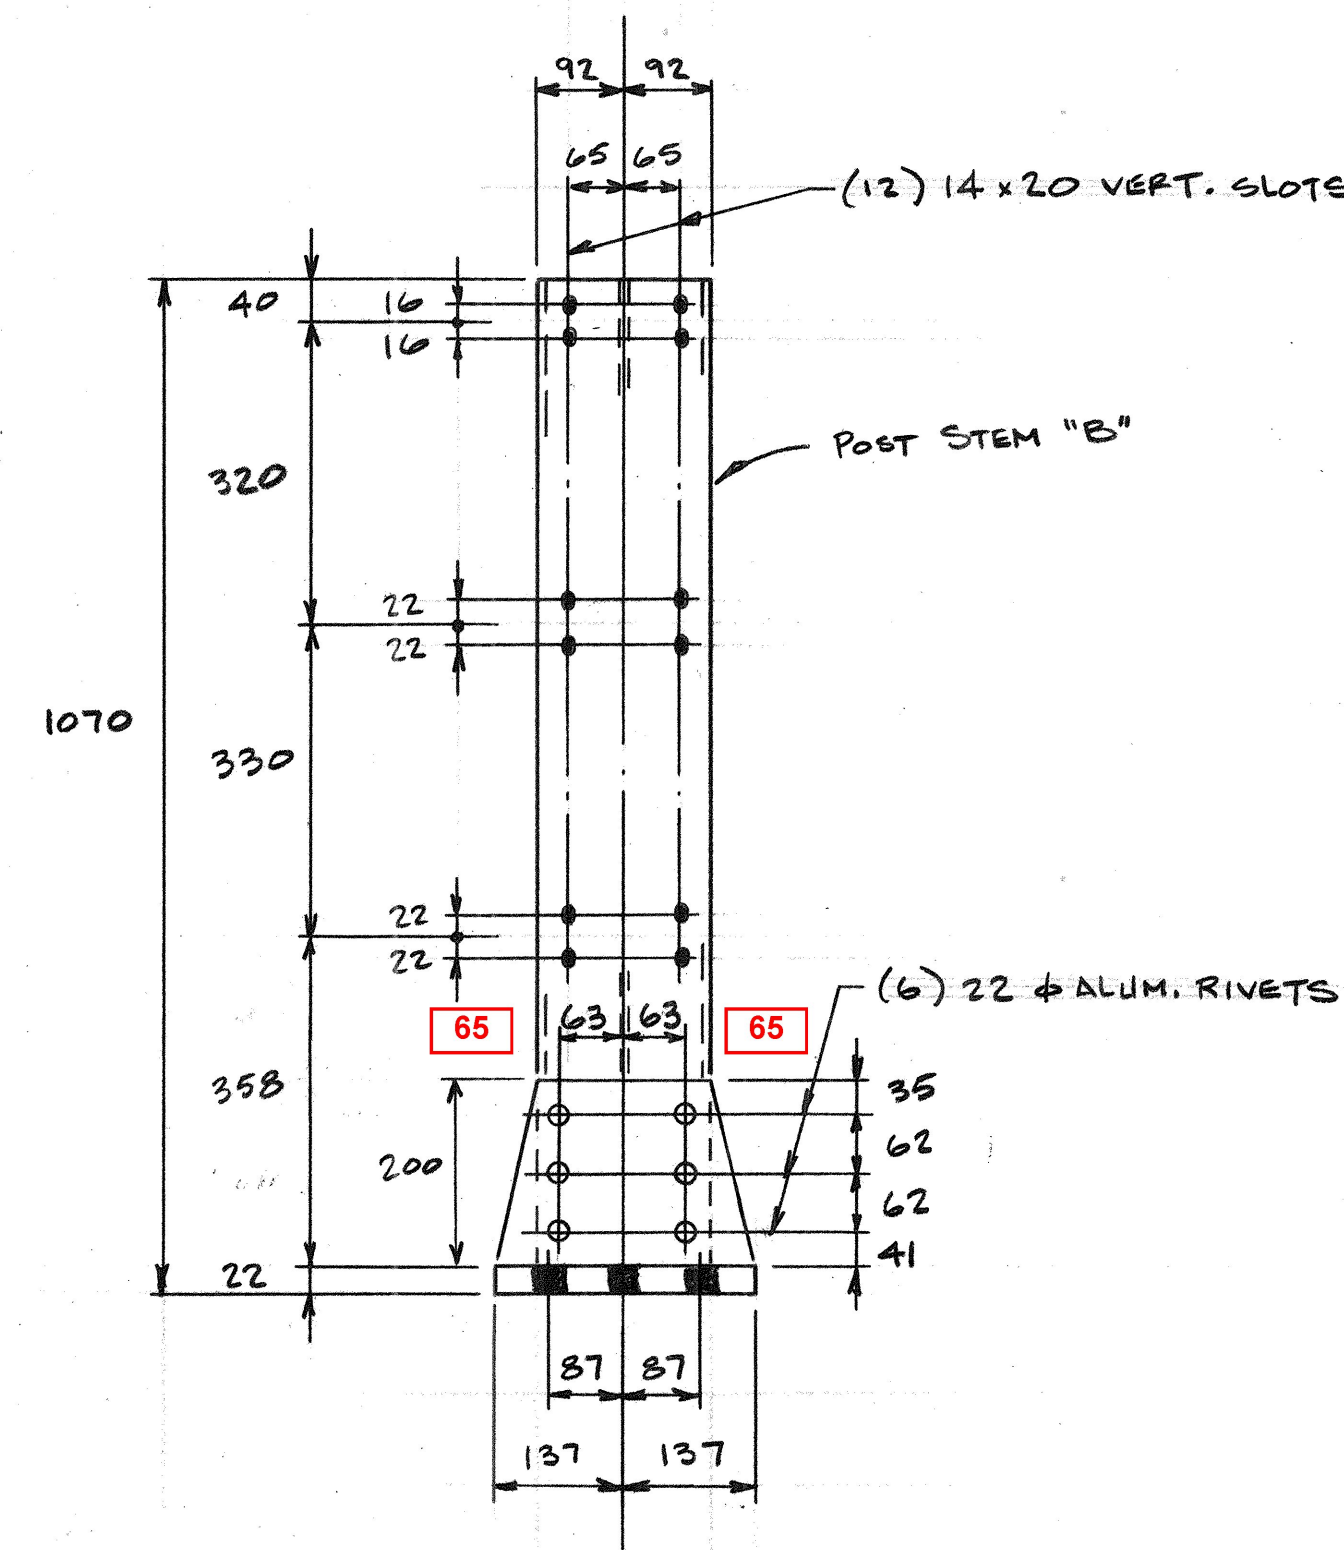


BRIDGE RAIL POST ~ "P2" (12 REQ'D.)

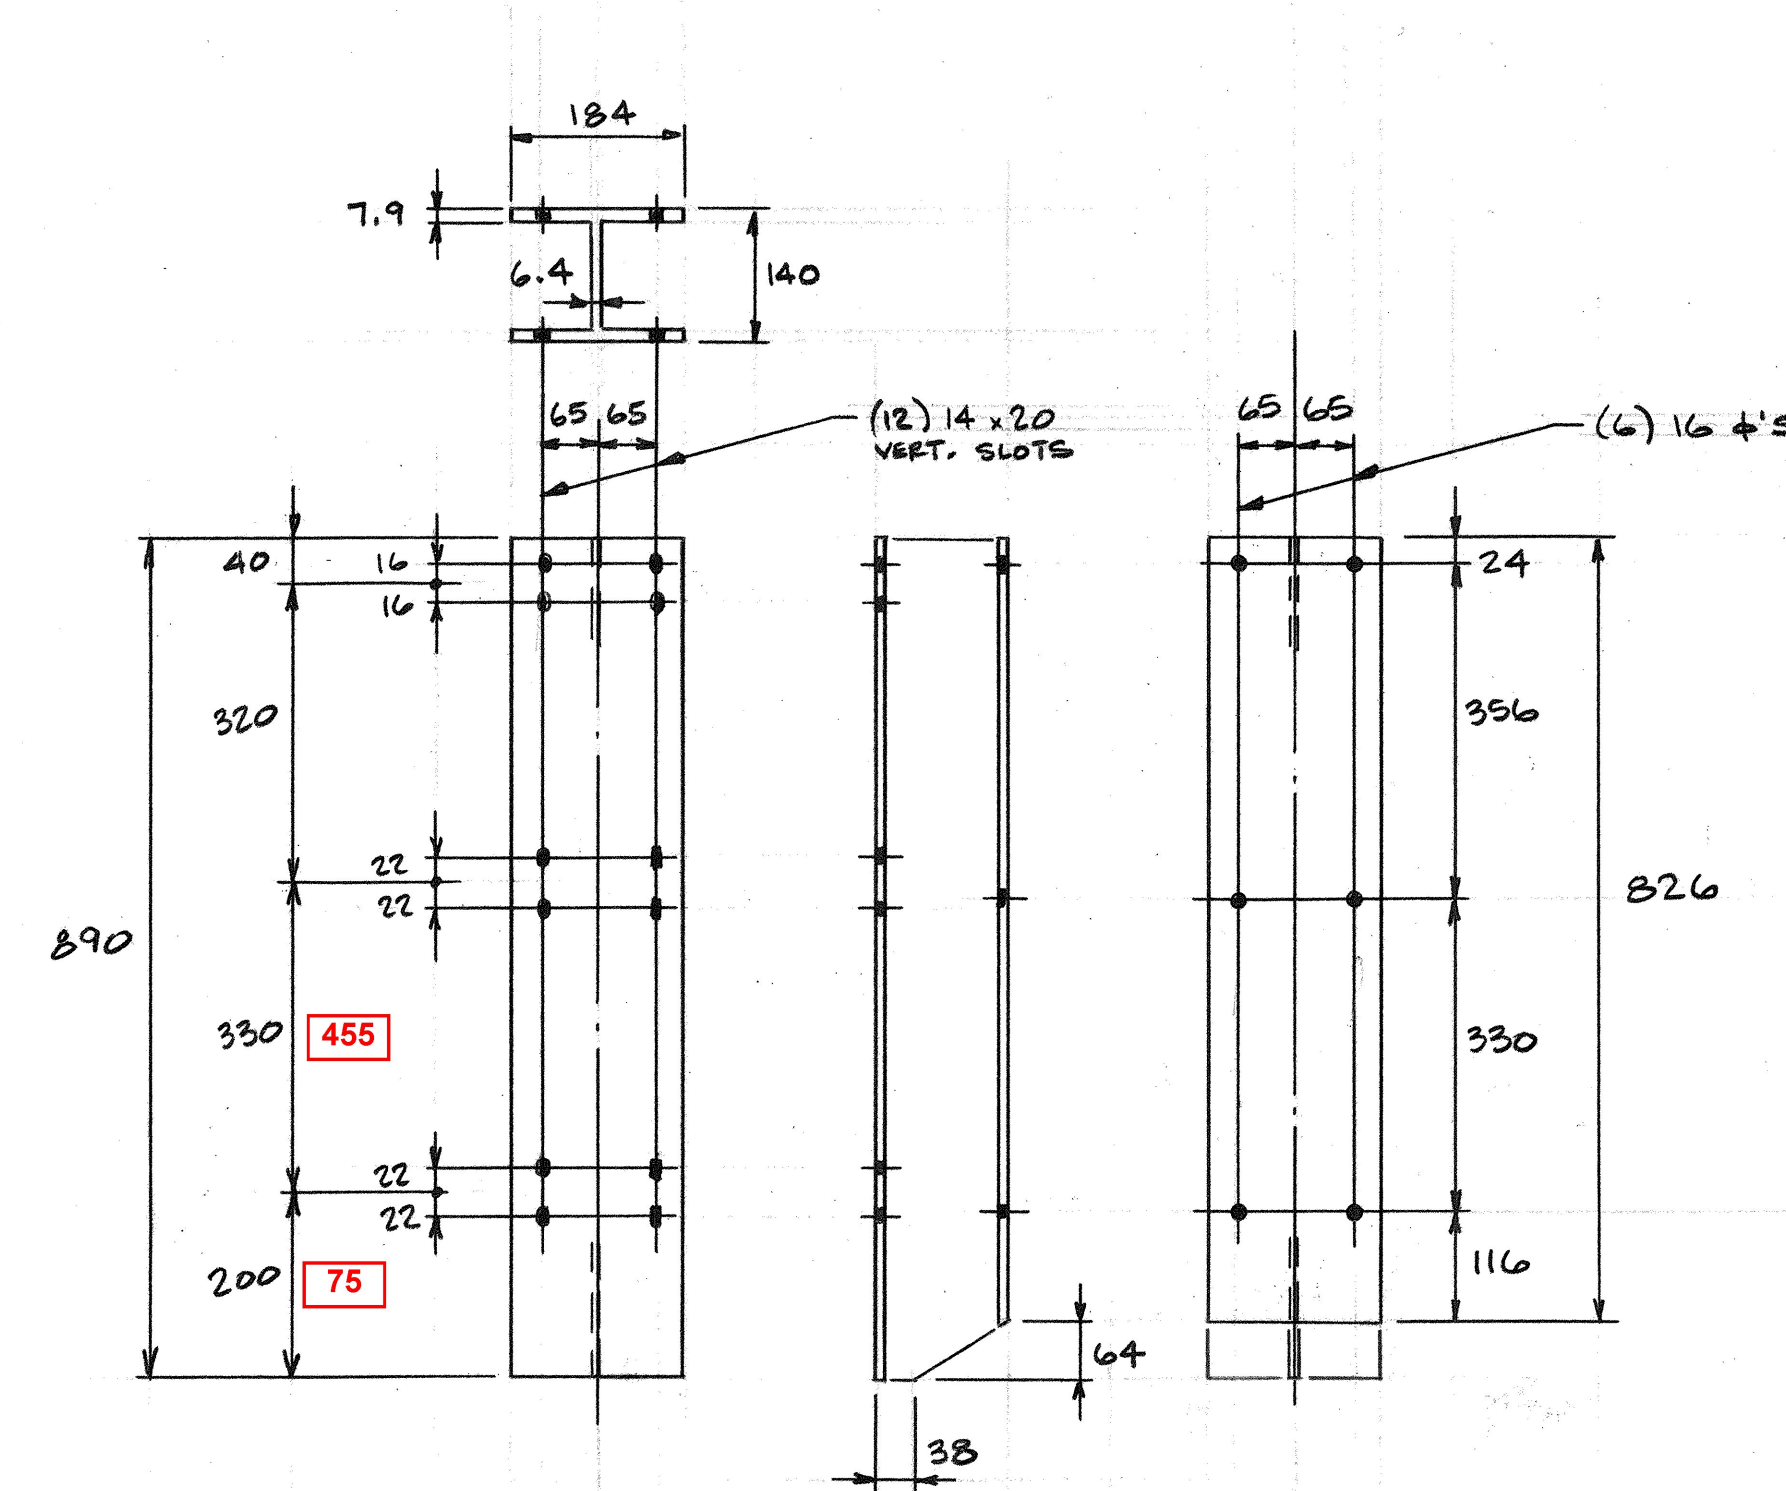



OFFSET BLOCKS ~ "P103" (12 REQ'D.)
"H" SECTION 140x184 ALLOY 6061-T6

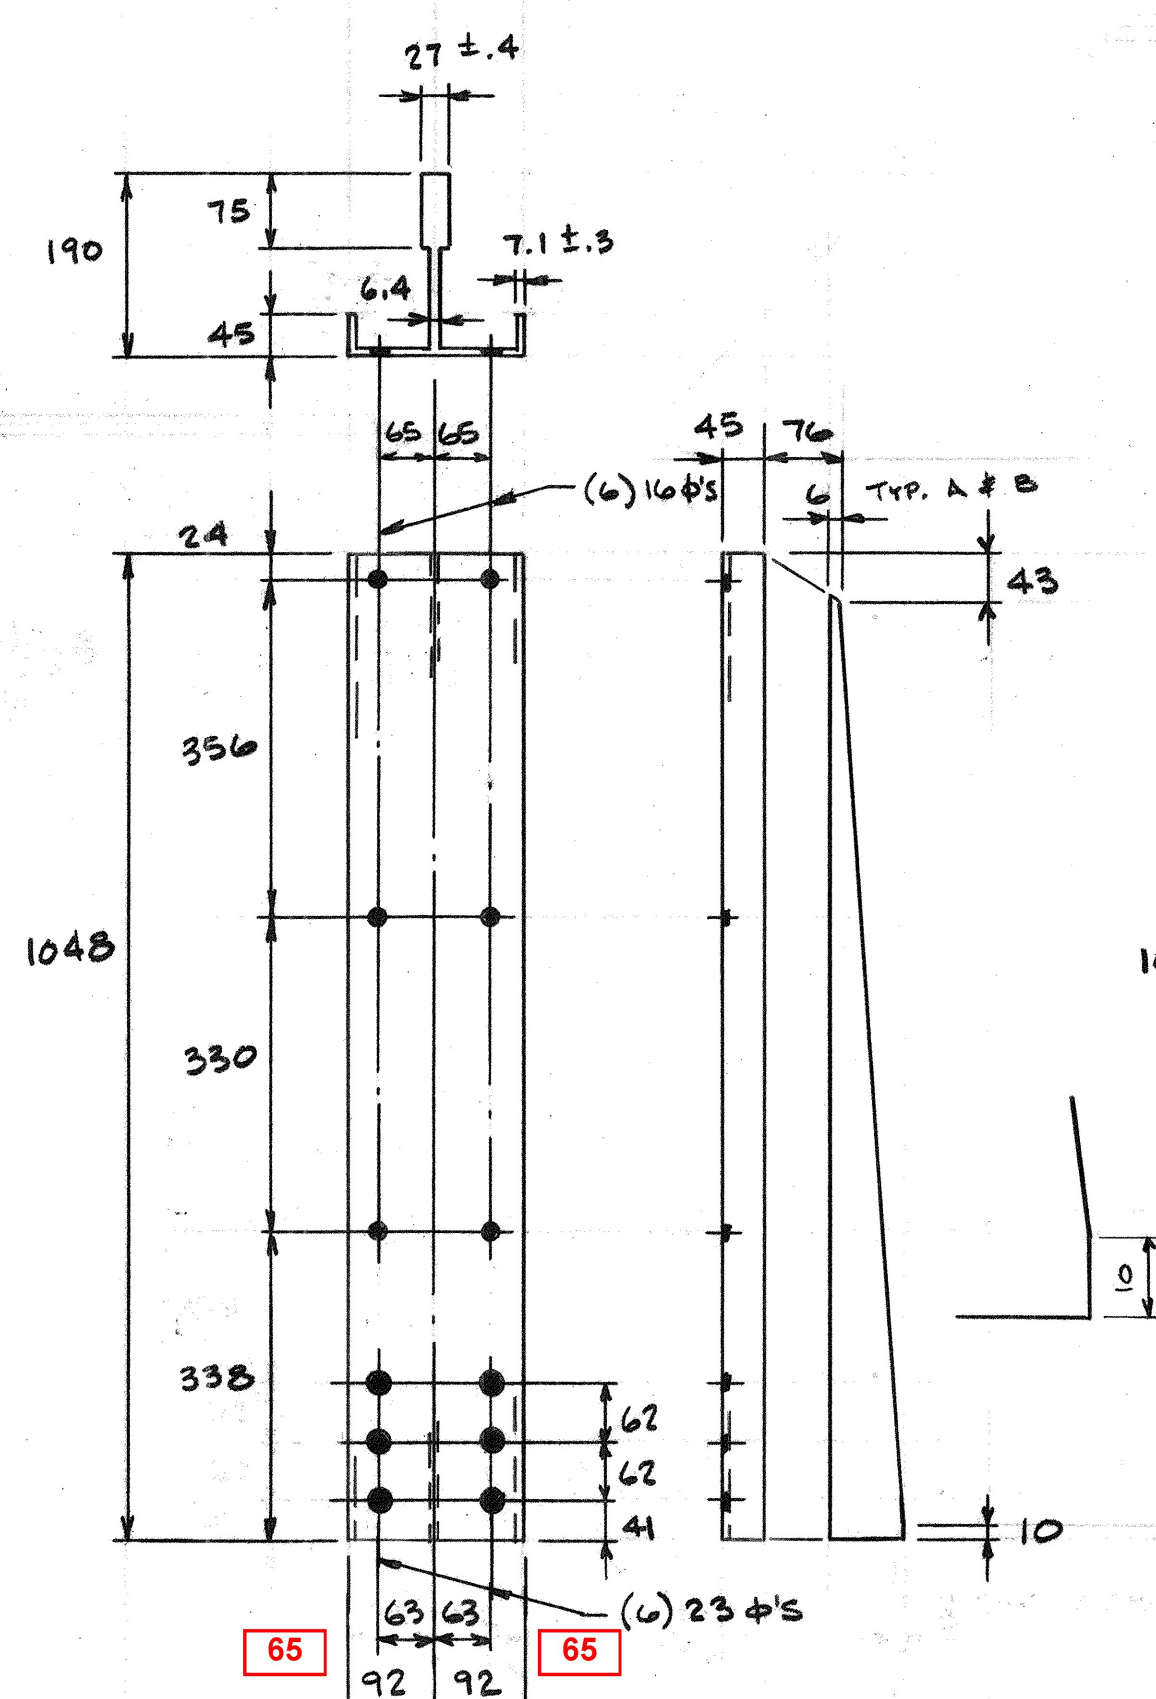

POST STEM ~ "A" (12 REQ'D.)
ALLOY 6061-T6

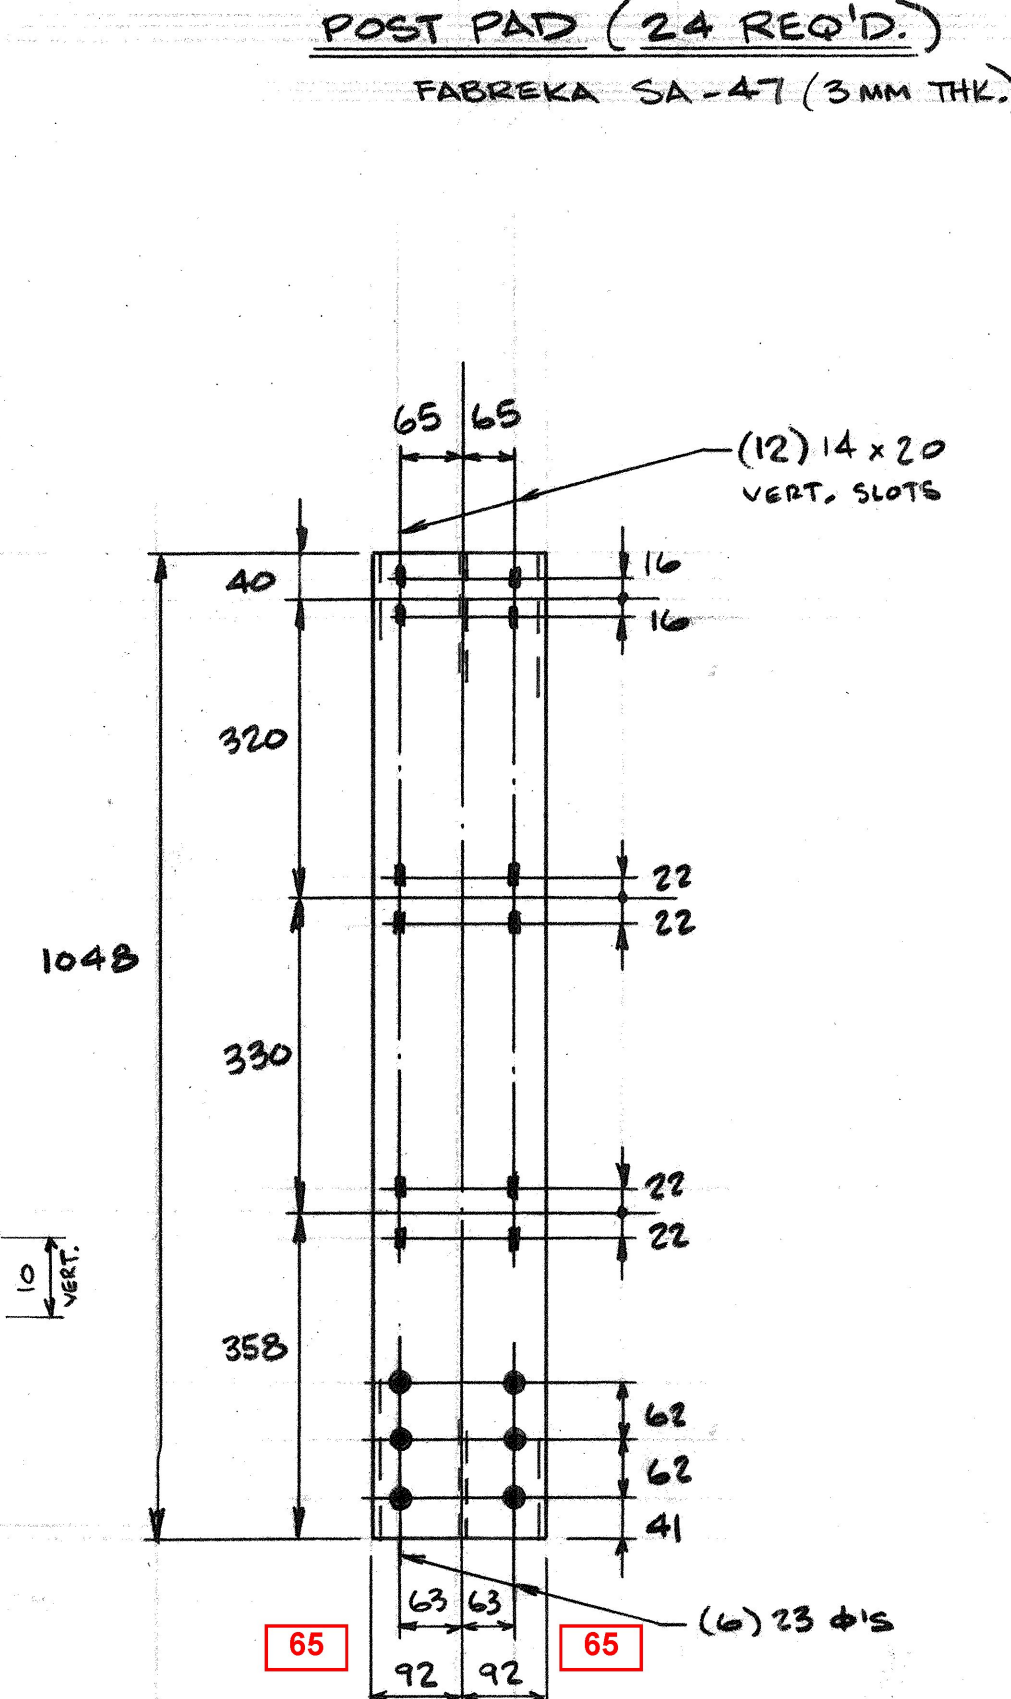

POST STEM ~ "B" (12 REQ'D.)
ALLOY 6061-T6

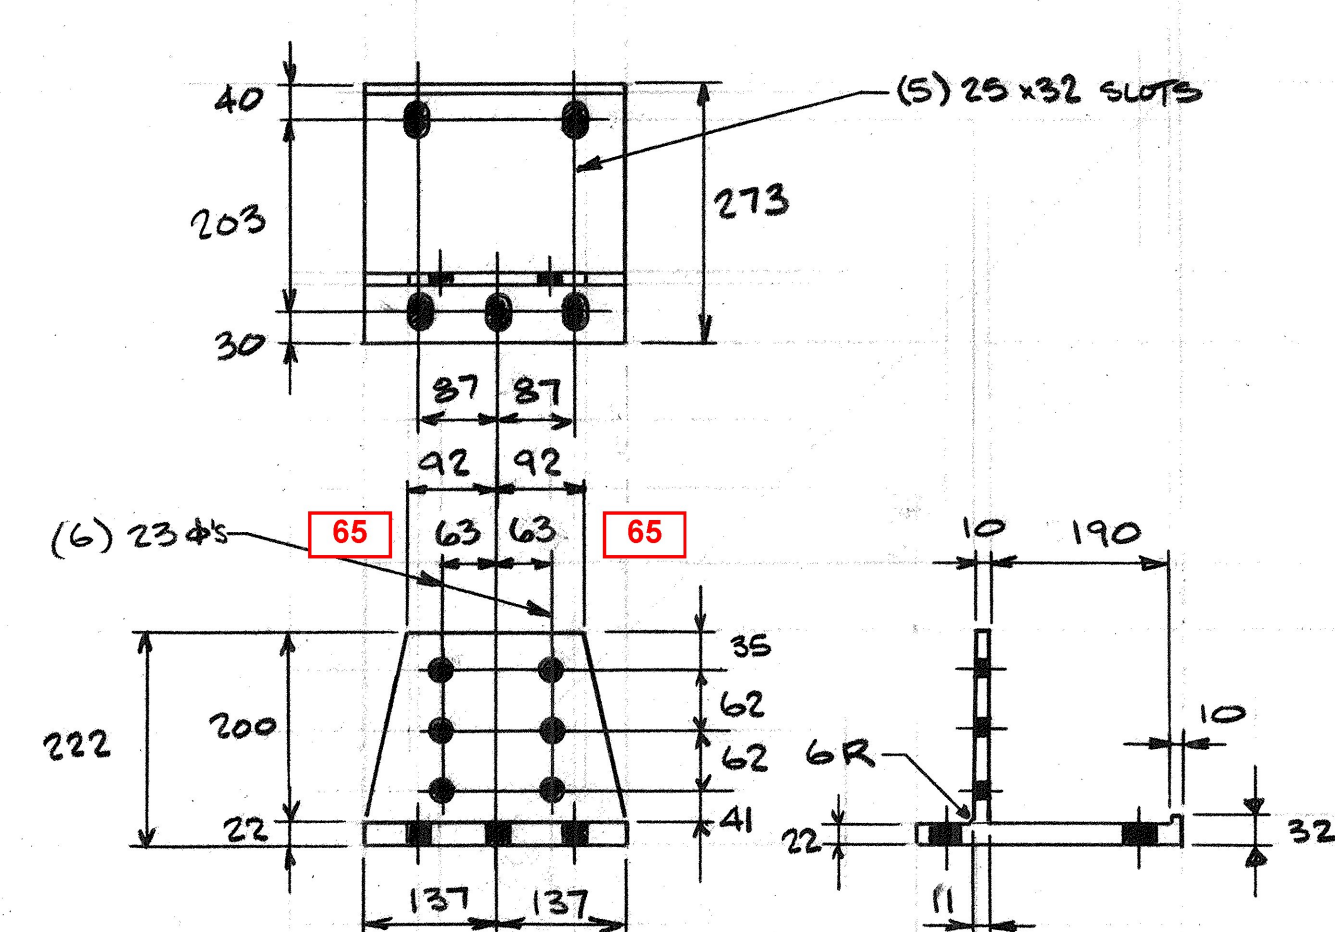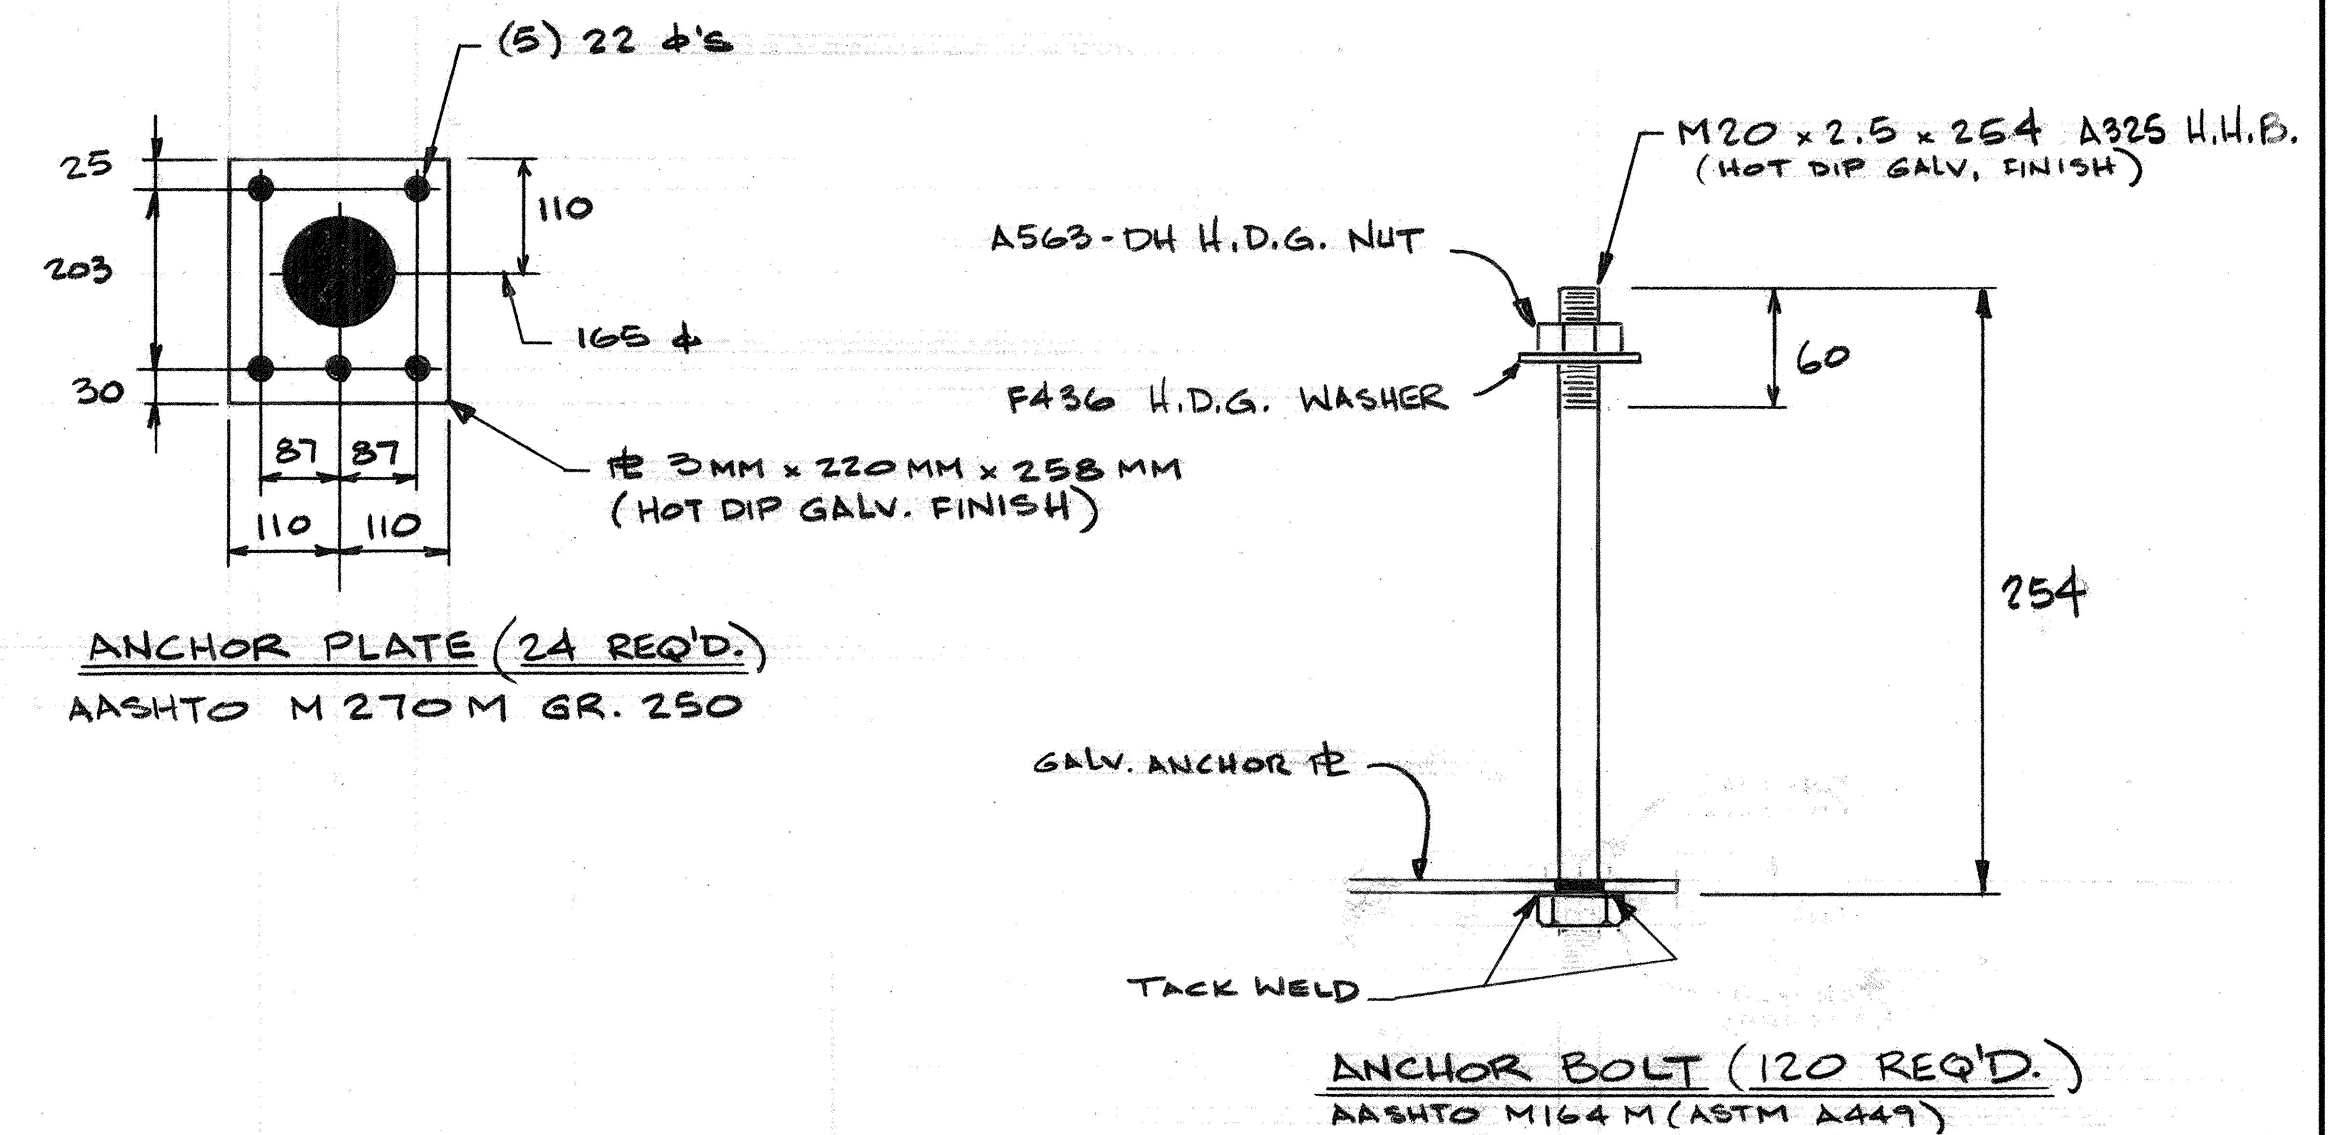

POST PAD (24 REQ'D.)
FABRIKA SA-47 (3MM THK.)

POST BASE (24 REQ'D.)
ALLOY 6061-T6

STATE OF VERMONT
AGENCY OF TRANSPORTATION
RECIEVED 08/20/2009
CK BY THL OK BY WDL
ACTION APPROVED AS NOTED
BY CWC DATE 08/26/2009

AUCIELLO IRON WORKS INC 560 MAIN ST. HUDSON, MA (978) 568-8382	
VERMONT AGENCY OF TRANSPORTATION TOWN OF LINCOLN COUNTY OF ADDISON ROUTE No. T.H.9 CL 3 BRIDGE No. 18 PROJECT No. BRO 1445 (25)	
ALUM. BRIDGE RAILING POSTS	
SURFACE PREP: NONE	FINISH: ANODIZED ~ BLACK, SATIN FINISH
FOR: F.R. LAFAYETTE, INC.	
DR: F.R. LAFAYETTE, INC.	DWG. NO. BR-2959
CHK: 5/19/09	JOB NO. AB97048-1001
ISSUE DATE	FOR APPROVAL
DESCRIPTION	BY
SHEET 1-FI OF 4	

ALL DIMENSIONS ARE IN MILLIMETRES