

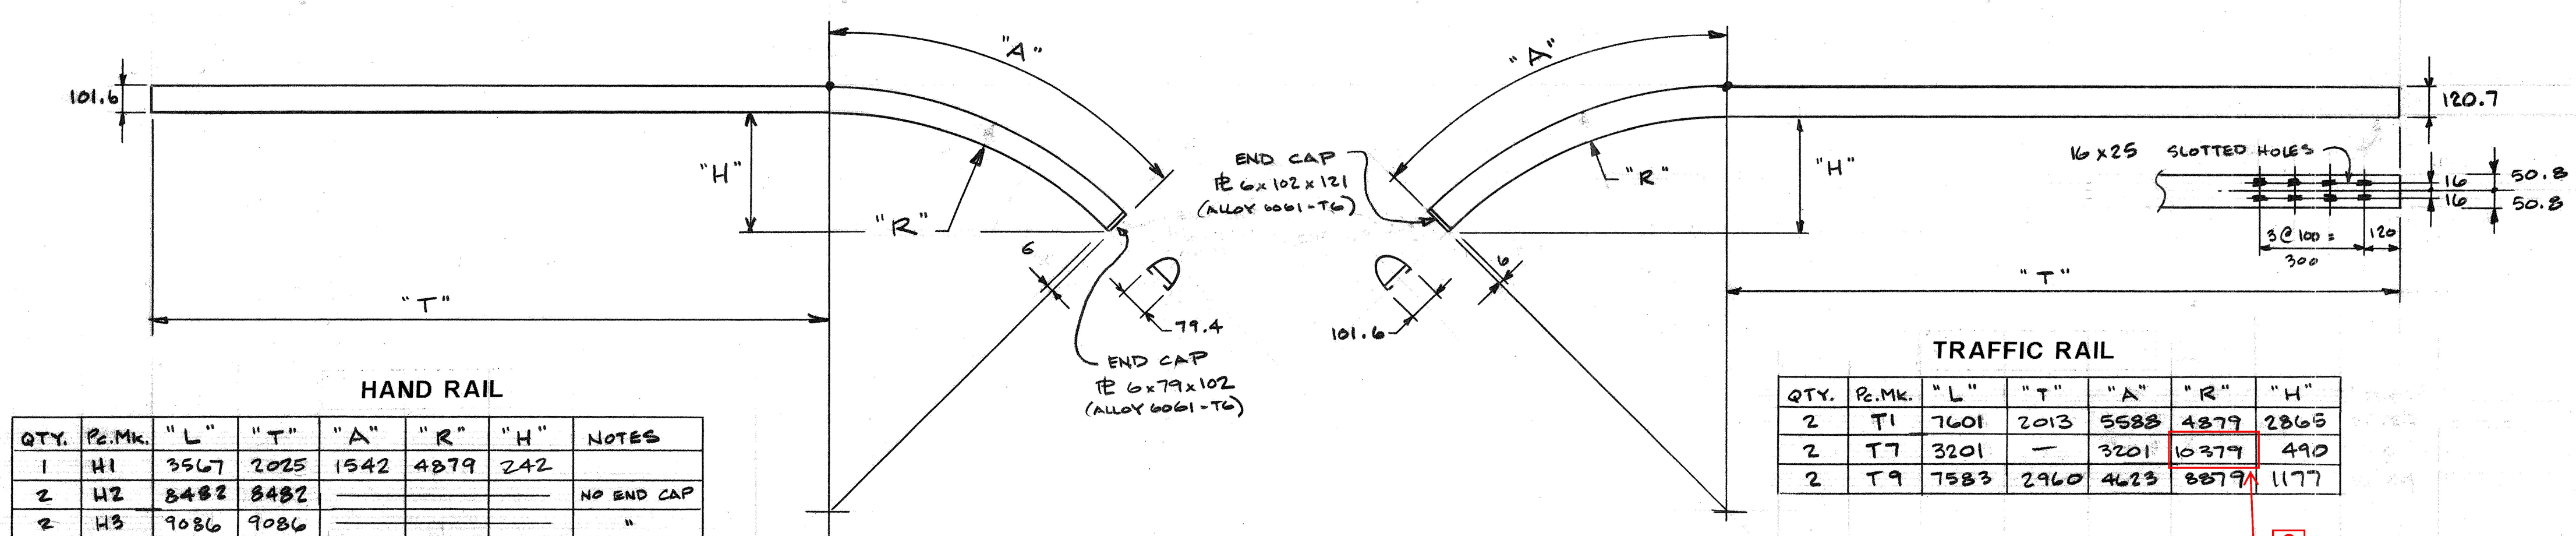



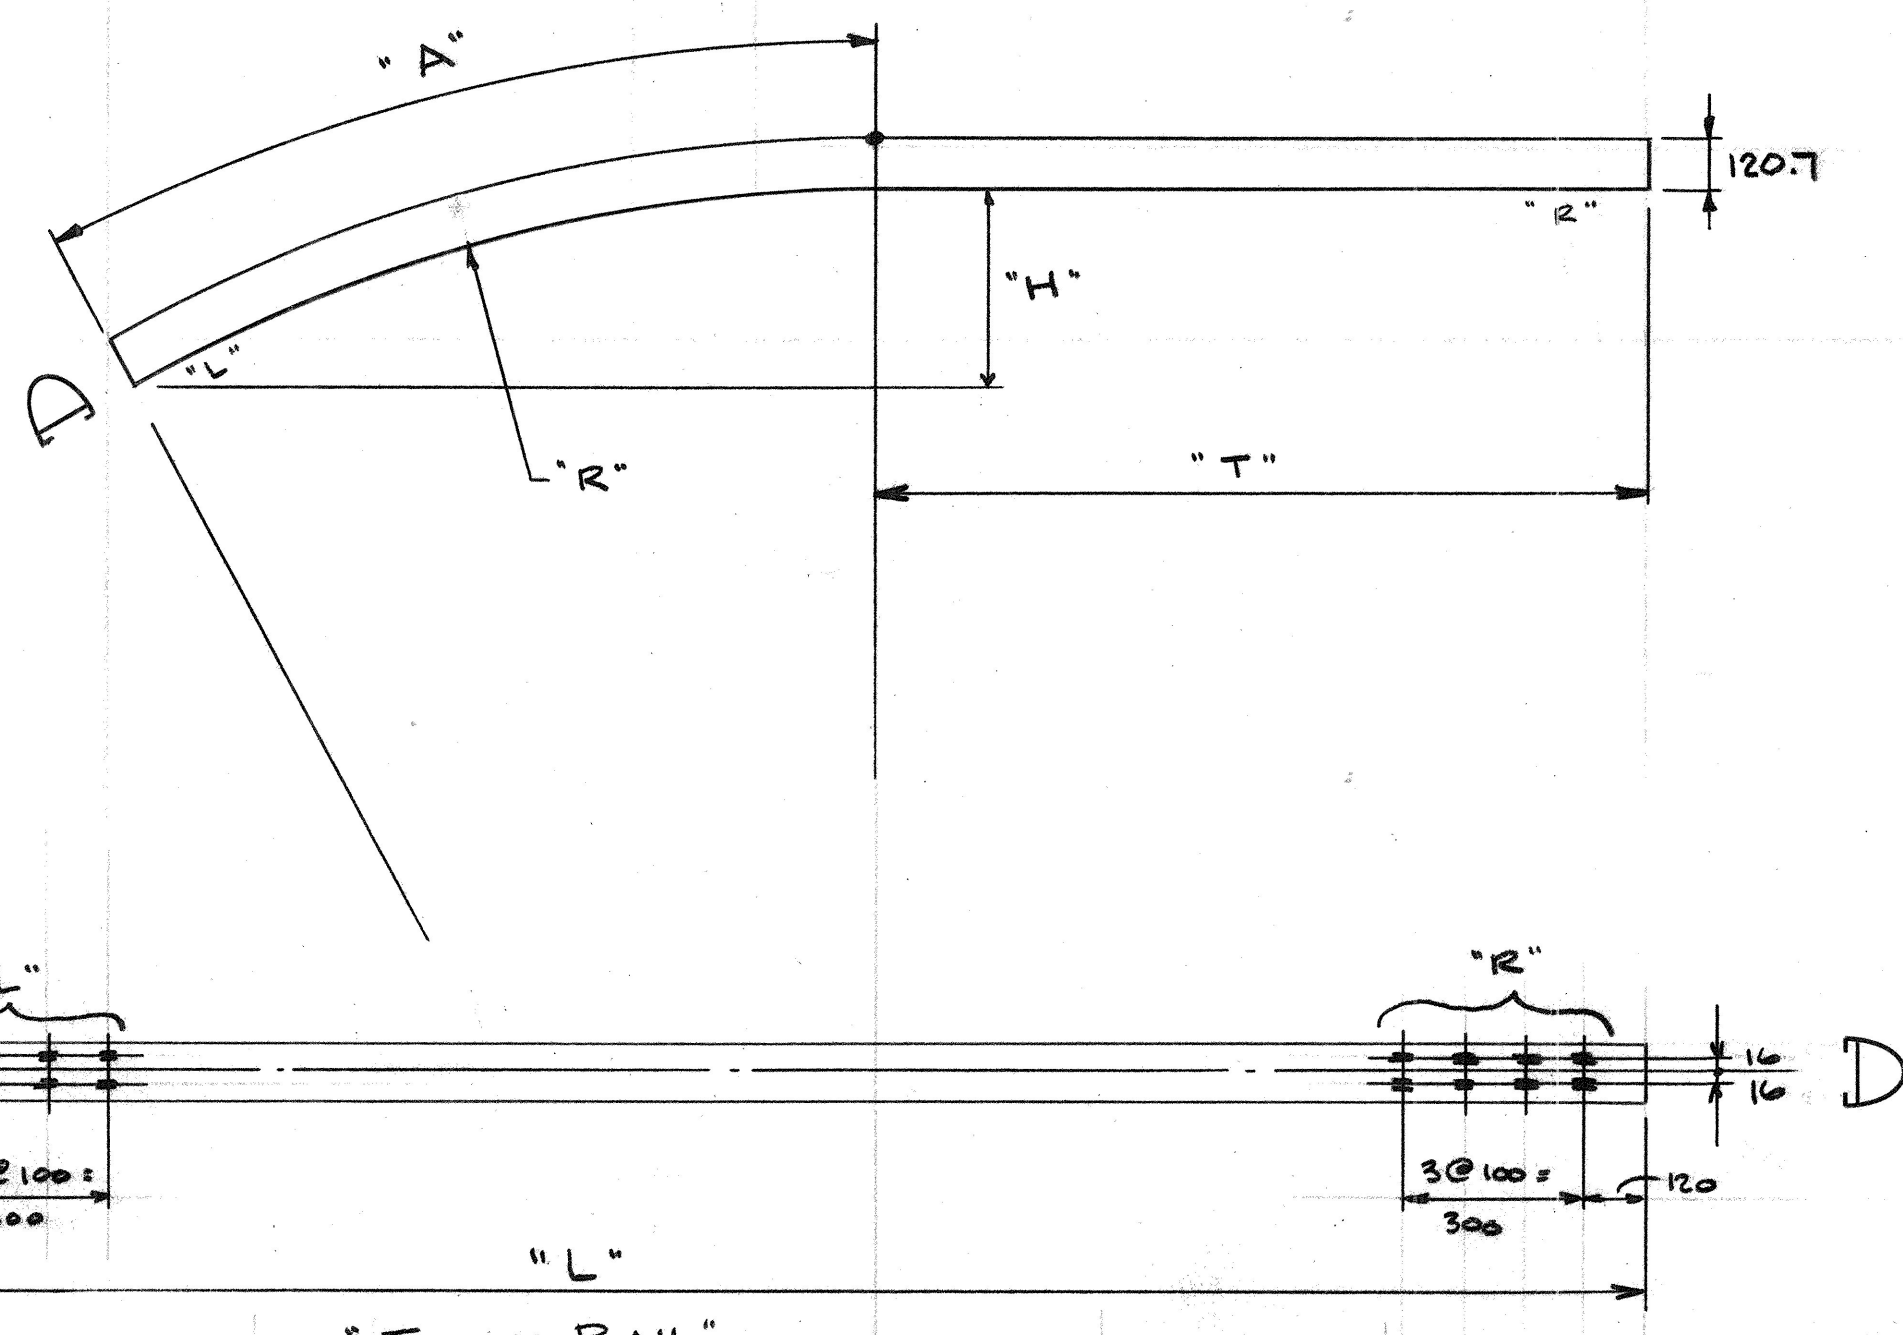


HAND RAIL						
QTY.	P.C.MK.	"L"	"T"	"A"	"R"	"H"
1	H1	3567	2025	1542	4879	242
2	H2	8482	8482			
2	H3	9086	9086			
2	H4	9097	9097			
1	H5	3583	2034	1549	10379	115
1	H6	3557	—	3557	9729	643
1	H7	3555	2974	521	8879	19
NOTES						
NO END CAP						

TRAFFIC RAIL						
QTY.	P.C.MK.	"L"	"T"	"A"	"R"	"H"
2	T1	7601	2013	5583	4879	2863
2	T7	3201	—	3201	10379	490
2	T9	7583	2960	4623	8879	1177

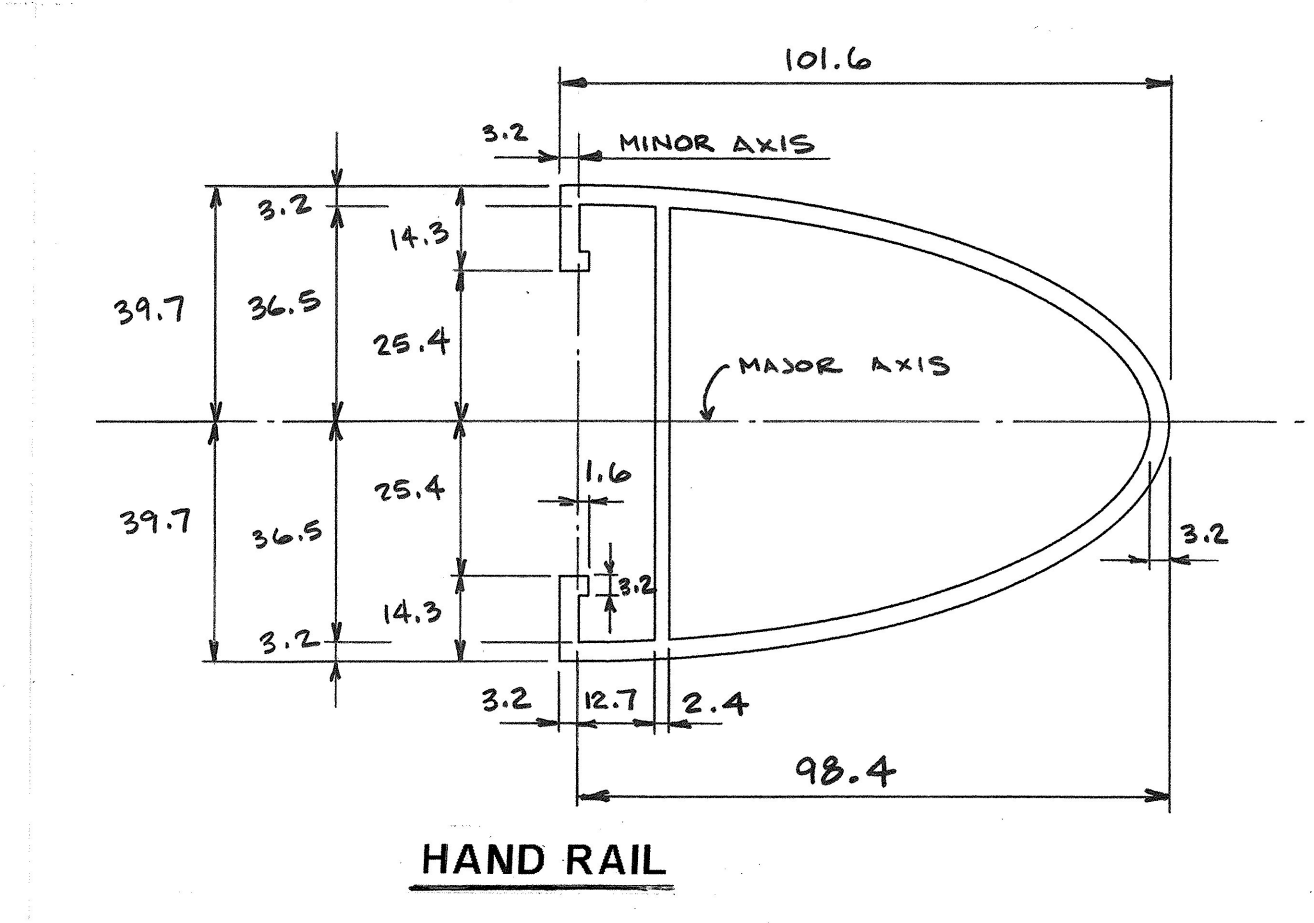

TRAFFIC RAIL						
QTY.	P.C.MK.	"L"	"T"	"A"	"R"	"H"
4	T3	9086	—	—	—	—
2	T5	7624	2019	5603	10379	1477
2	T6	8272	—	8272	10379	3126
4	T2	8482	—	—	—	—
4	T4	9097	—	—	—	—
HOLES						
		"L"	"T"	"A"	"R"	"H"
		16x25	16	16x25	16	16x25
		16x25	16	16x25	16	16x25
		16x25	16	16x25	16	16x25
		16x25	16	16x25	16	16x25

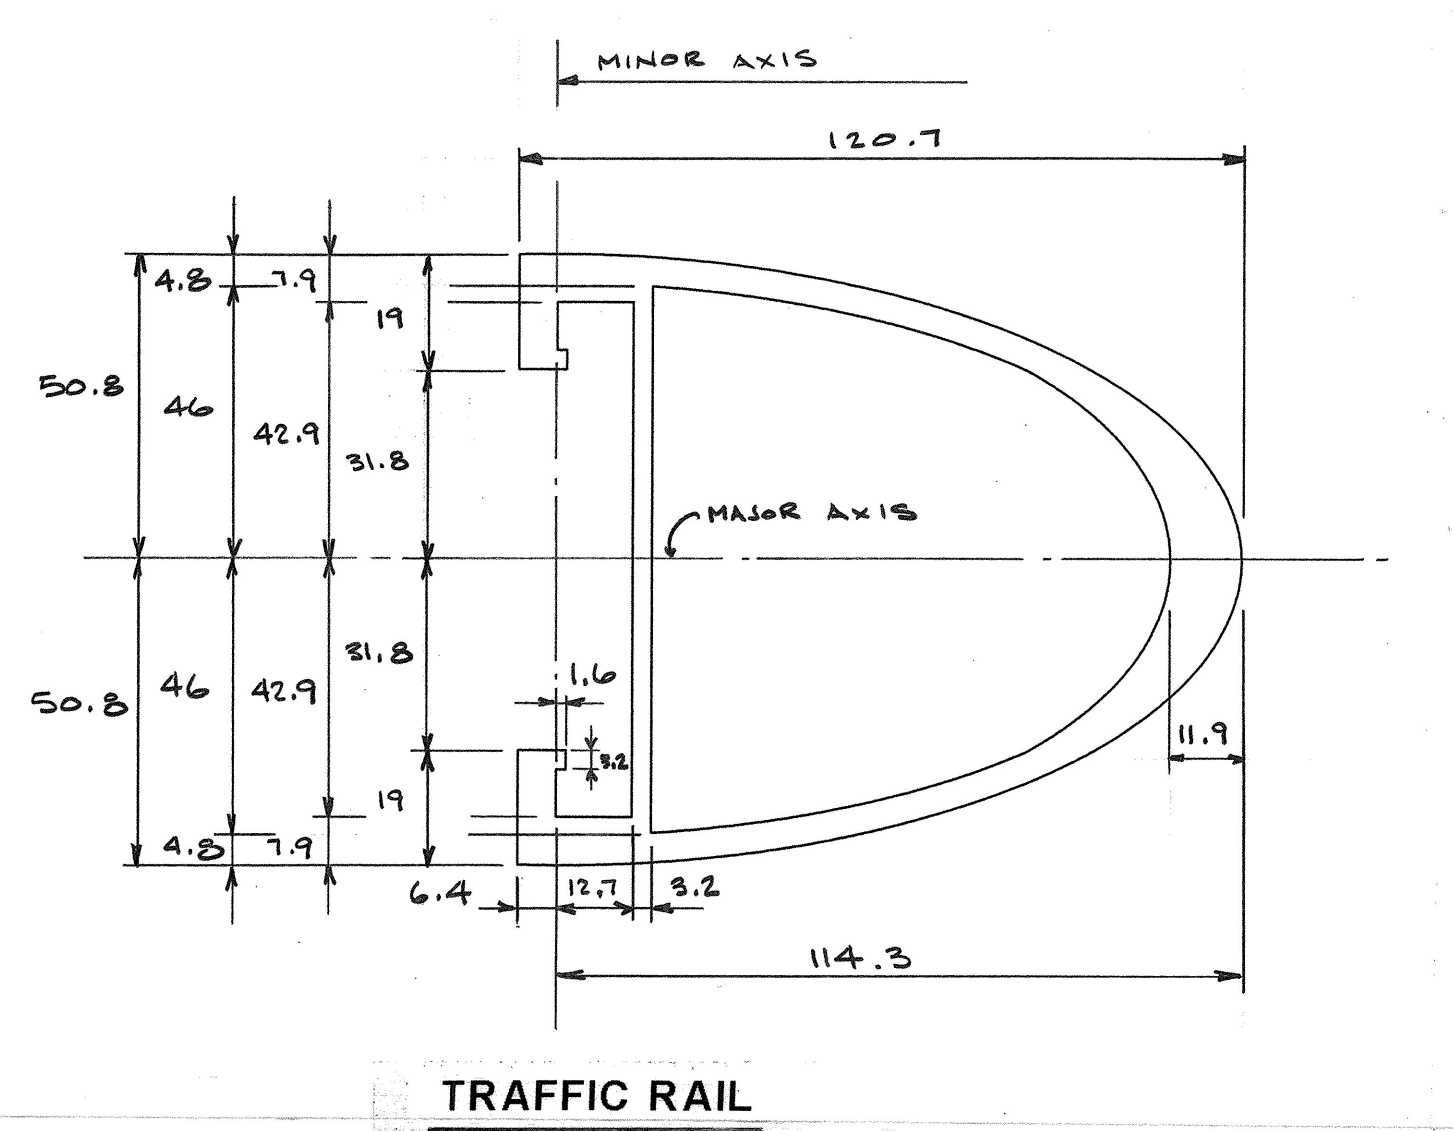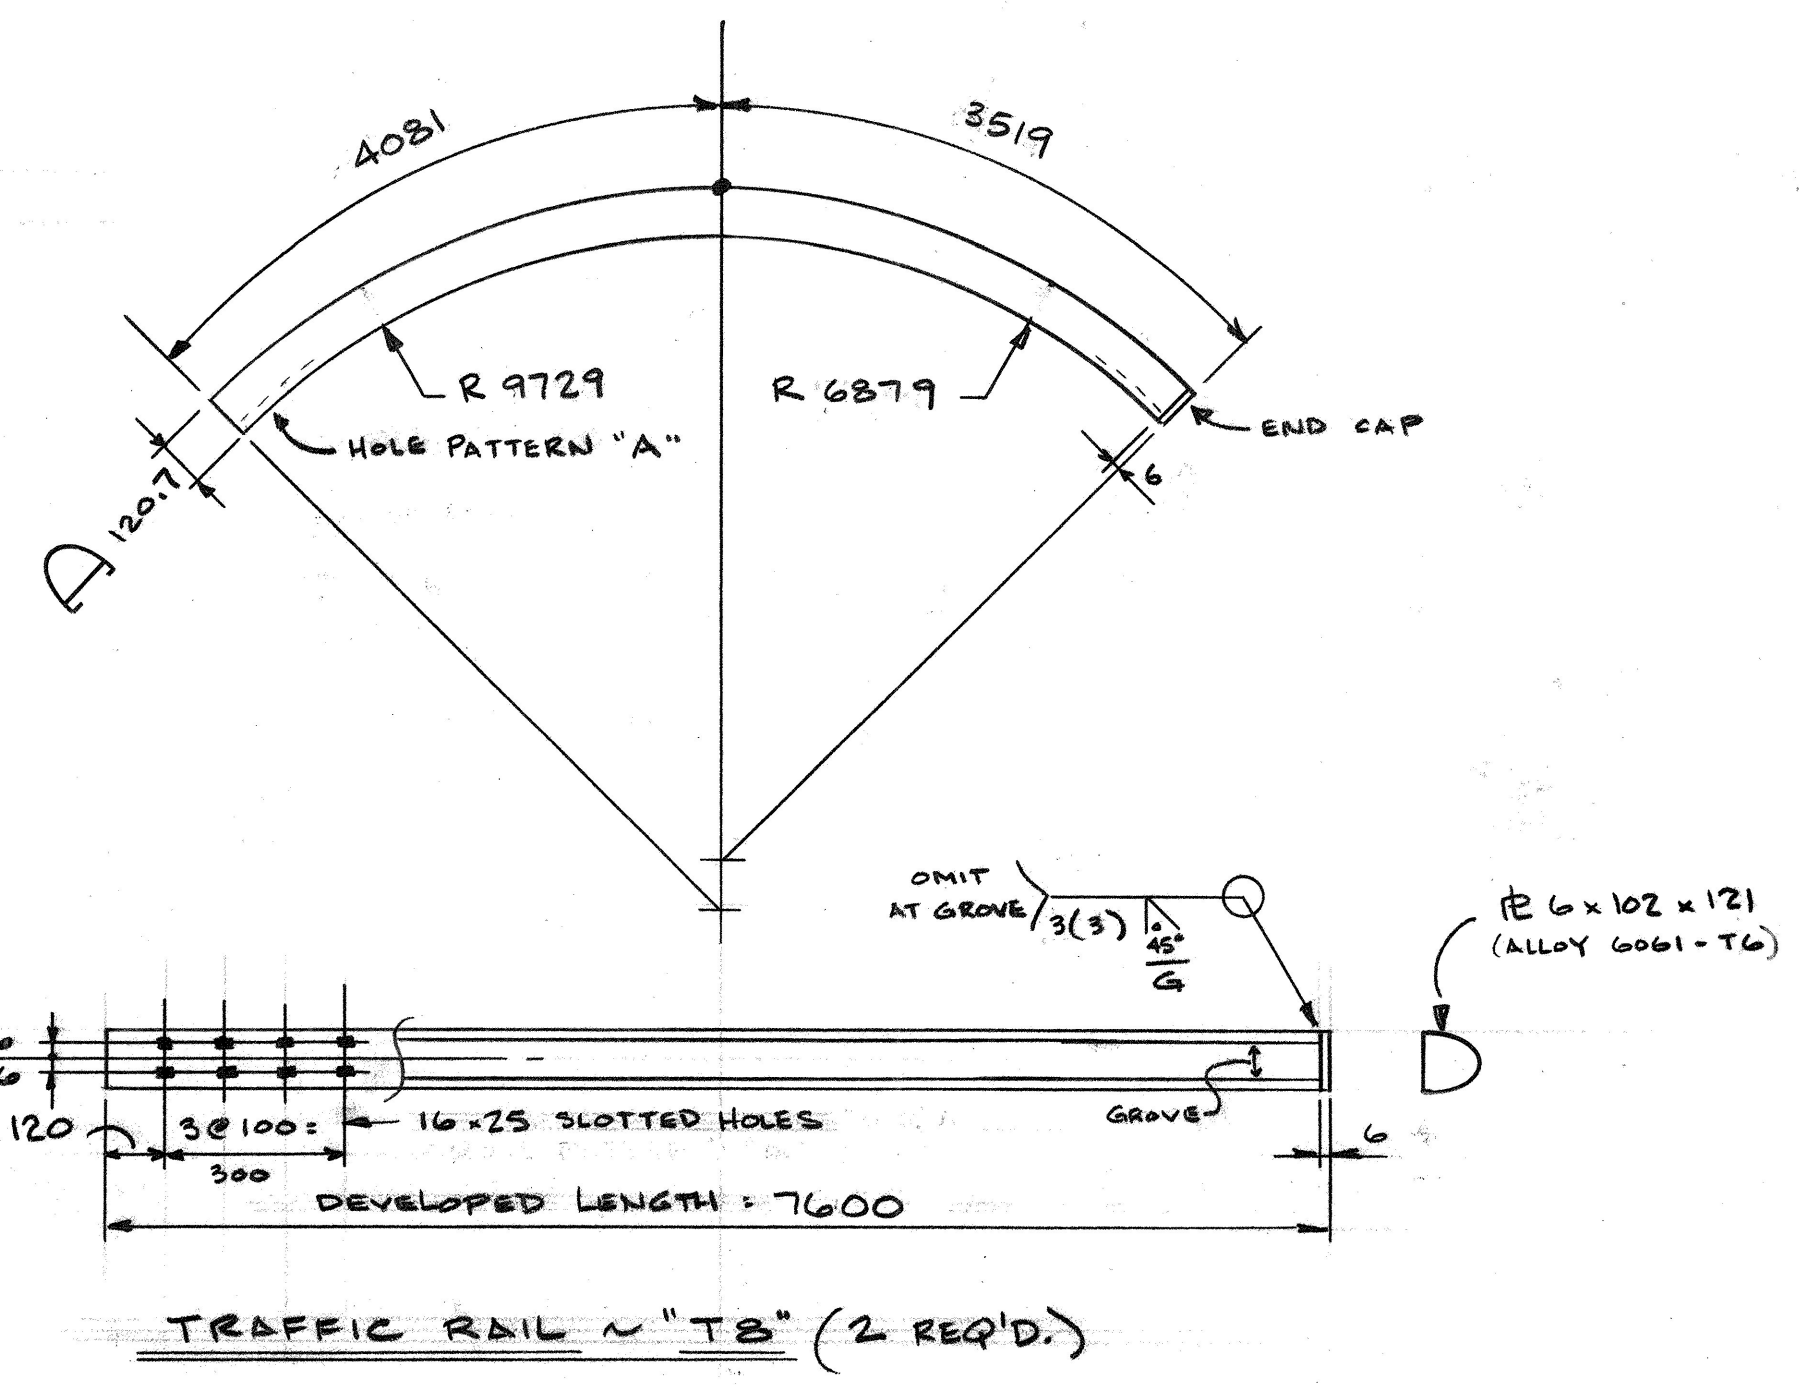

MATERIAL:
HAND RAIL & TRAFFIC RAIL EXTRUSIONS SHALL BE ALUMINUM ALLOY 6061-T6 (ASTM B221)

STATE OF VERMONT
AGENCY OF TRANSPORTATION
RECIEVED 08/20/2009
CK BY THL OK BY WDL
ACTION APPROVED AS NOTED
BY CWC DATE 08/26/2009

ALL DIMENSIONS ARE IN MILLIMETRES

AUCIELLO IRON WORKS INC 560 MAIN ST. HUDSON, MA (978) 568-8382	
VERMONT AGENCY OF TRANSPORTATION TOWN OF LINCOLN COUNTY OF ADDISON ROUTE No. T.H. 9 CL3 BRIDGE No. 42 PROJECT No. BRD 1445 (25)	
ALUMINUM BRIDGE RAILING	
SURFACE PREP: NONE	FINISH: ANODIZED BLACK SATIN FINISH
FOR: F.R. LAFAYETTE, INC.	
DR: <i>[Signature]</i> CHK: 5/29/09	DWG. NO. BR-2959
ISSUE 1 8-13-09	DATE FOR APPROVAL
DESCRIPTION	BY
AB97048-1001	SHEET 1-F4 OF 4