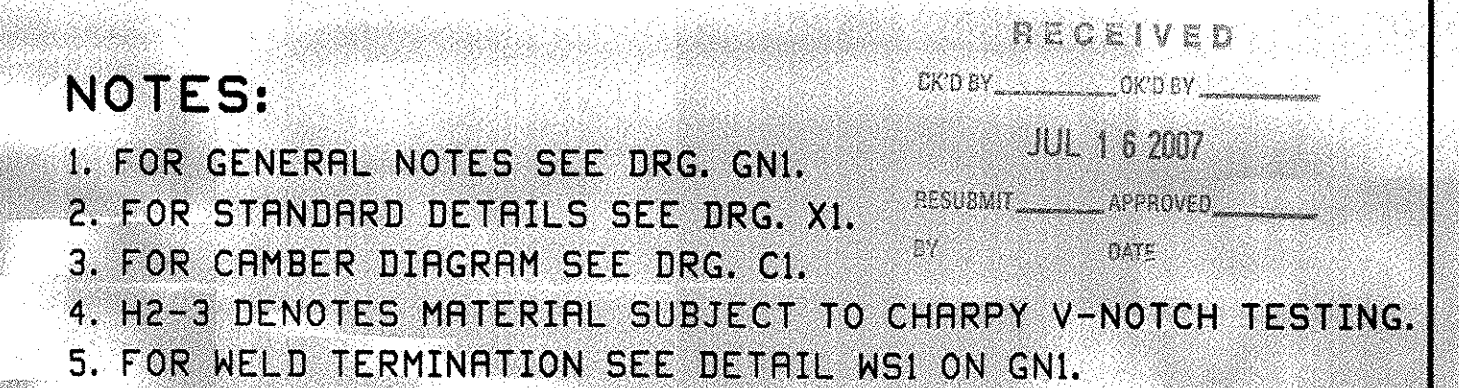
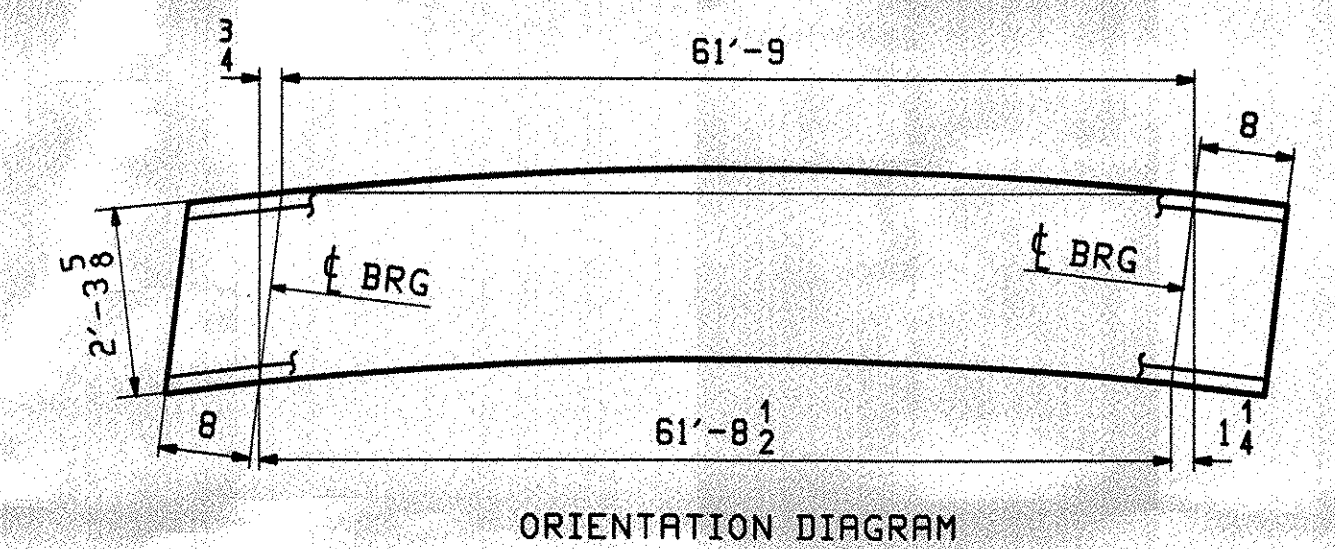
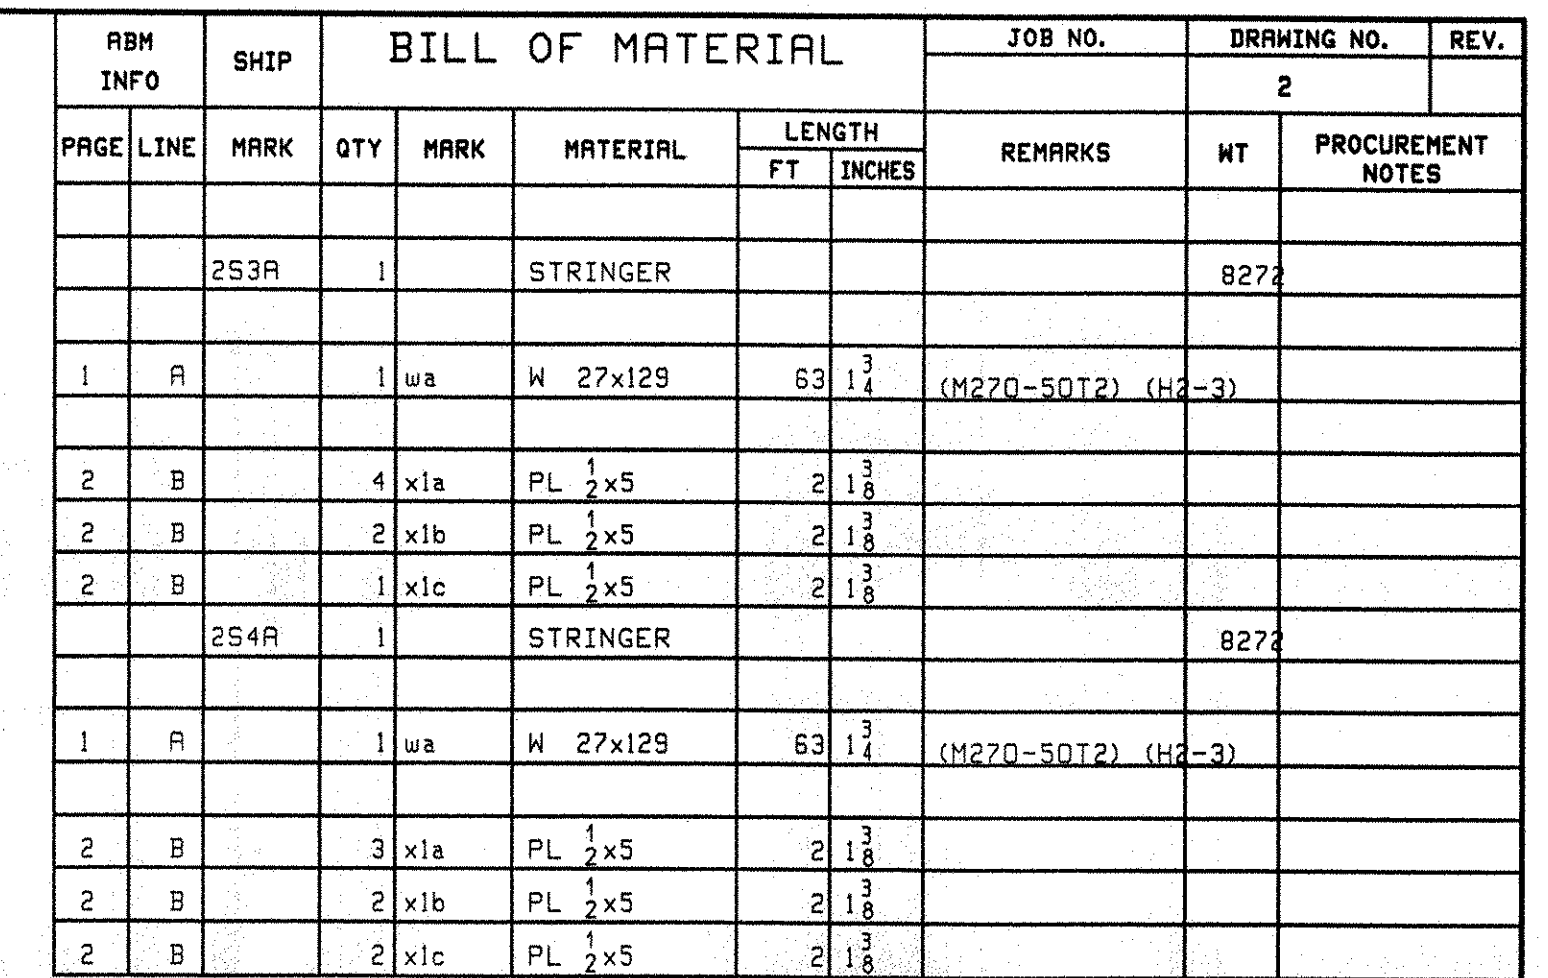



[illegible]

REV.	REMARKS	DATE	DWN	CHK	APP	Q.A.	NO.	DIA.	LGT	TYPE	WASHER
MATERIAL:		ELECTRODES:			HOLES:			SHOP BOLTS:			
M270 50 U.N.					15 16 Ø U.N.			NONE			

SURFACE PREP. & PAINT:
SEE GN1

DESCRIPTION:	STRINGERS - 2S3A & 2S4A	DRAWN BY	DATE
JOB:		EEO	06/11/07
	BROOK ROAD OVER FREEMAN BROOK	CHKD BY	
	BIRDGE NO. 7	ELC	06/12/07
	WARREN, VT. (COUNTY OF WASHINGTON)	APPROV BY	
		SUPERVISOR	W. J. GATTI
	PROJ NO. BHF 0188(7)	Q.A.	
	CUSTOMER: BLOW & COTE		

CASCO BAY STEEL STRUCTURES, INC.		JOB NO.	DRG. NO.
75 SPRING HILL ROAD	SACO, MAINE 04072	324	2
PHONE (207) 282-7360	FAX. (207) 282-1179	DES SS	REV. Δ

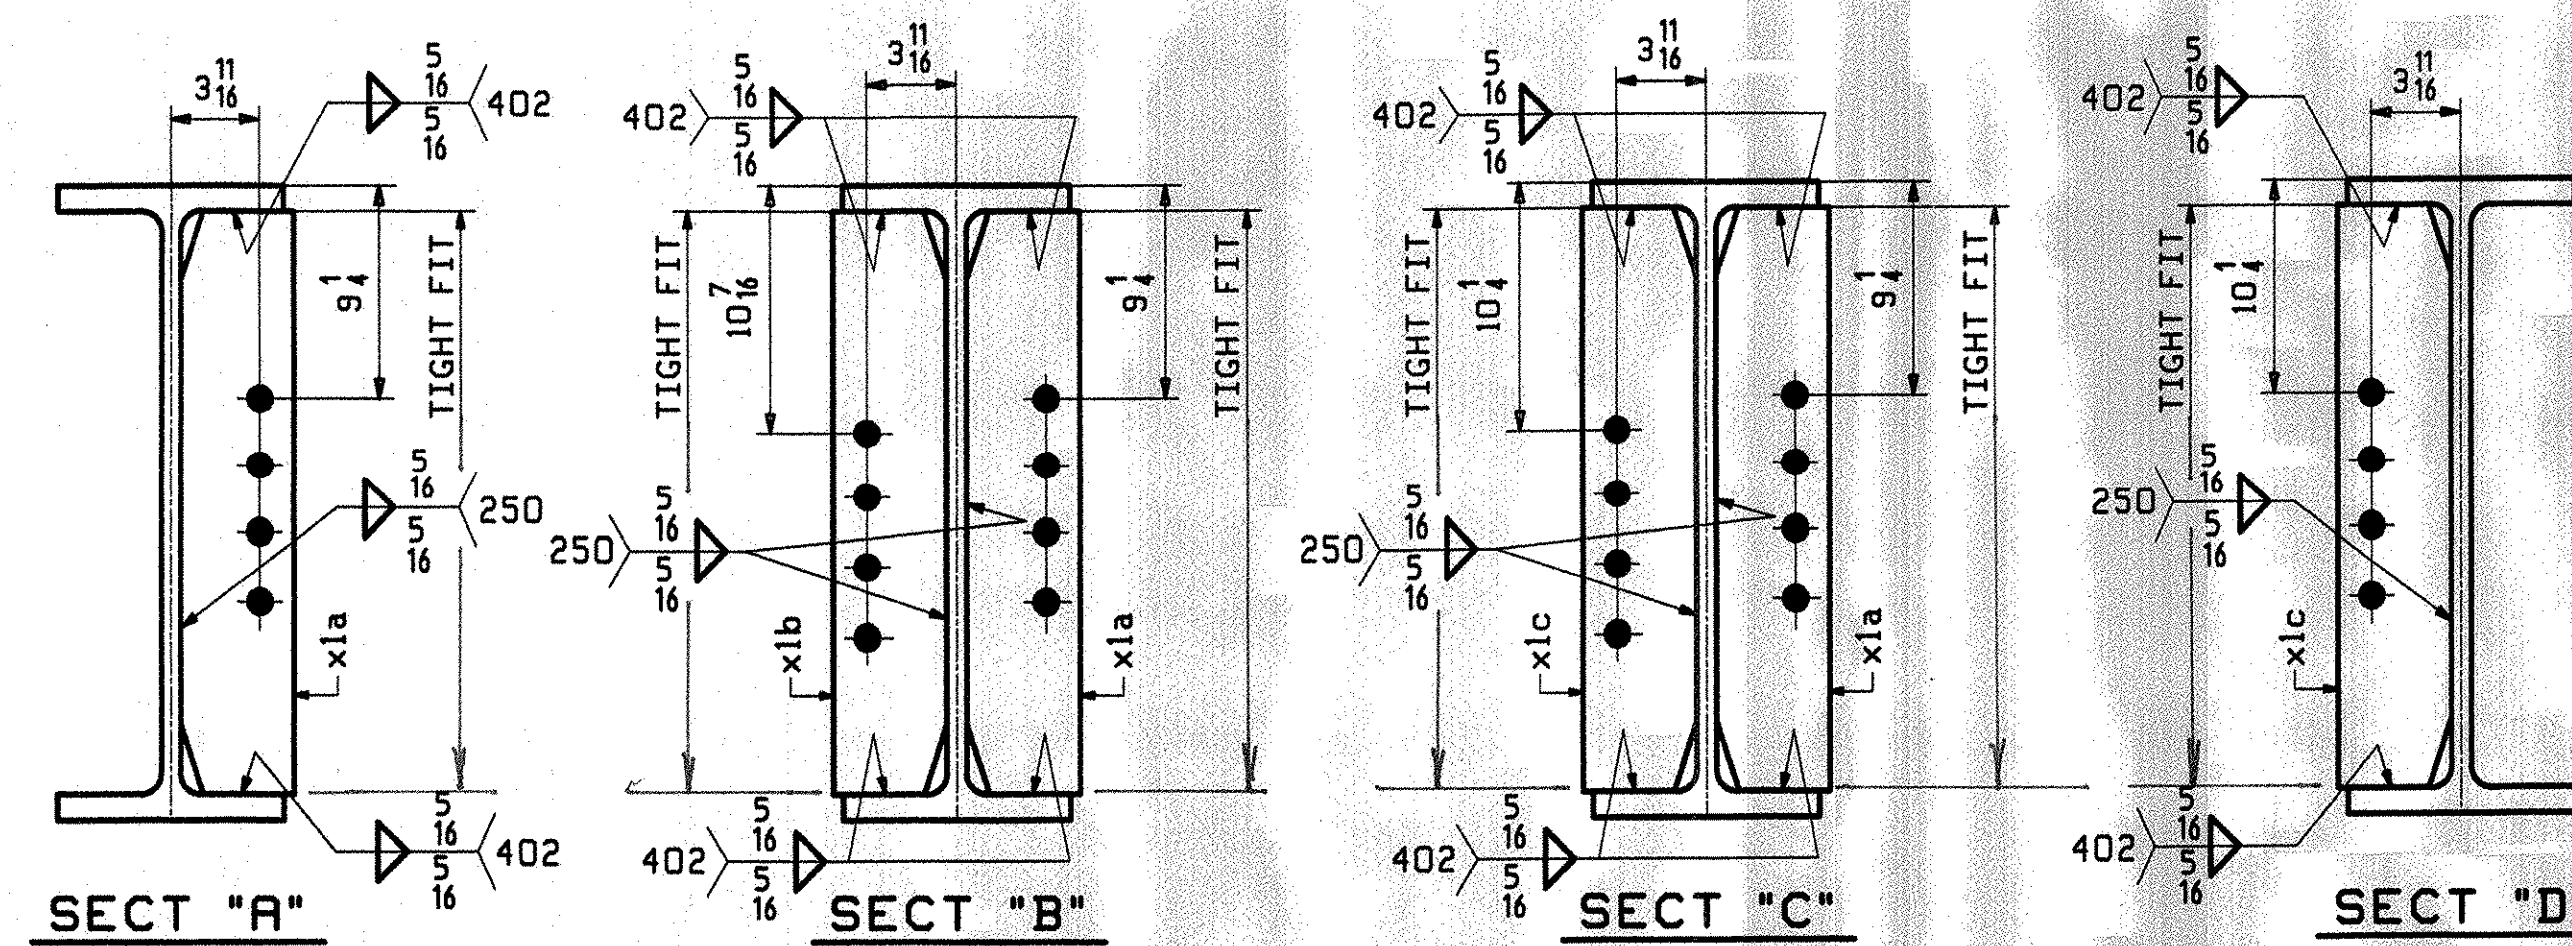

☒ Reviewed
☐ Rejected

☐ Furnish as Corrected
☐ Revise and Resubmit
☐ Submit Specified Item

This review is only for general conformance with the design concept and the information given in the Construction Documents. Corrections or comments made on shop drawings during this review do not relieve the contractor from compliance with the requirements of the plans and specifications. Review of a specific item shall include review of an assembly of which the item is a component. The Contractor is responsible for: dimensions to be confirmed and consistent at the job site; material that pertains solely to the fabrication process or to the means, methods, techniques, sequences and procedures of construction; coordination of the Work with that of other trades and performing all Work in a safe and satisfactory manner.

McFarland-Johnson, Inc. _____
Date 7-11-07
By Steven J. Delia