

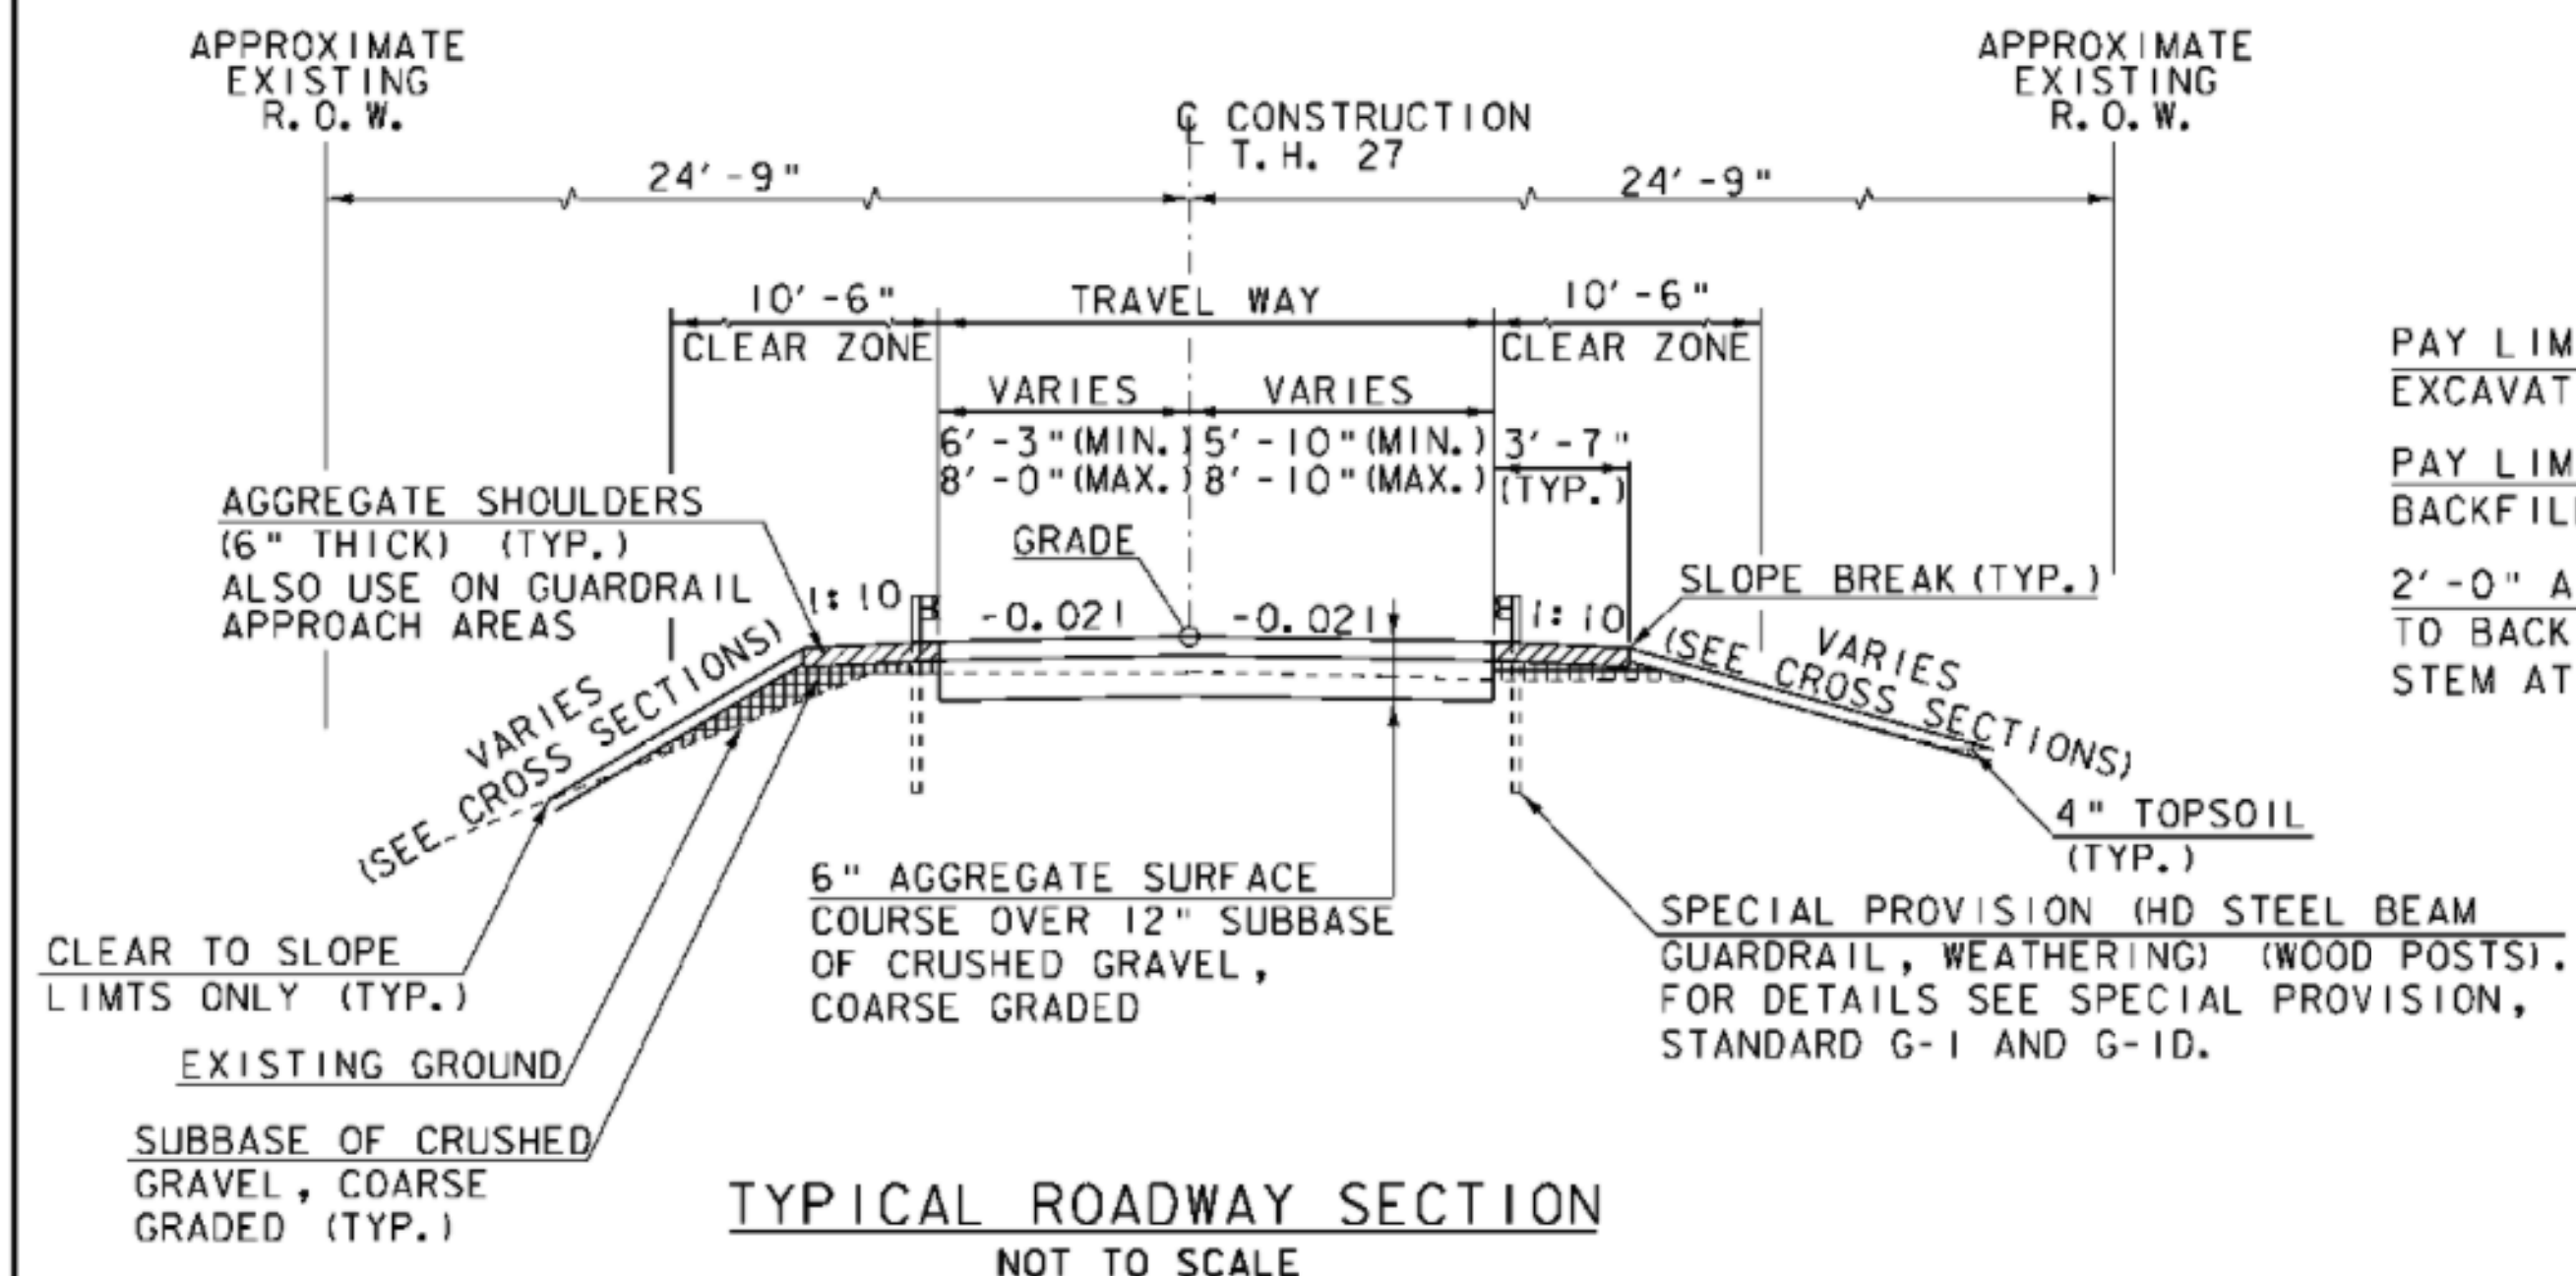
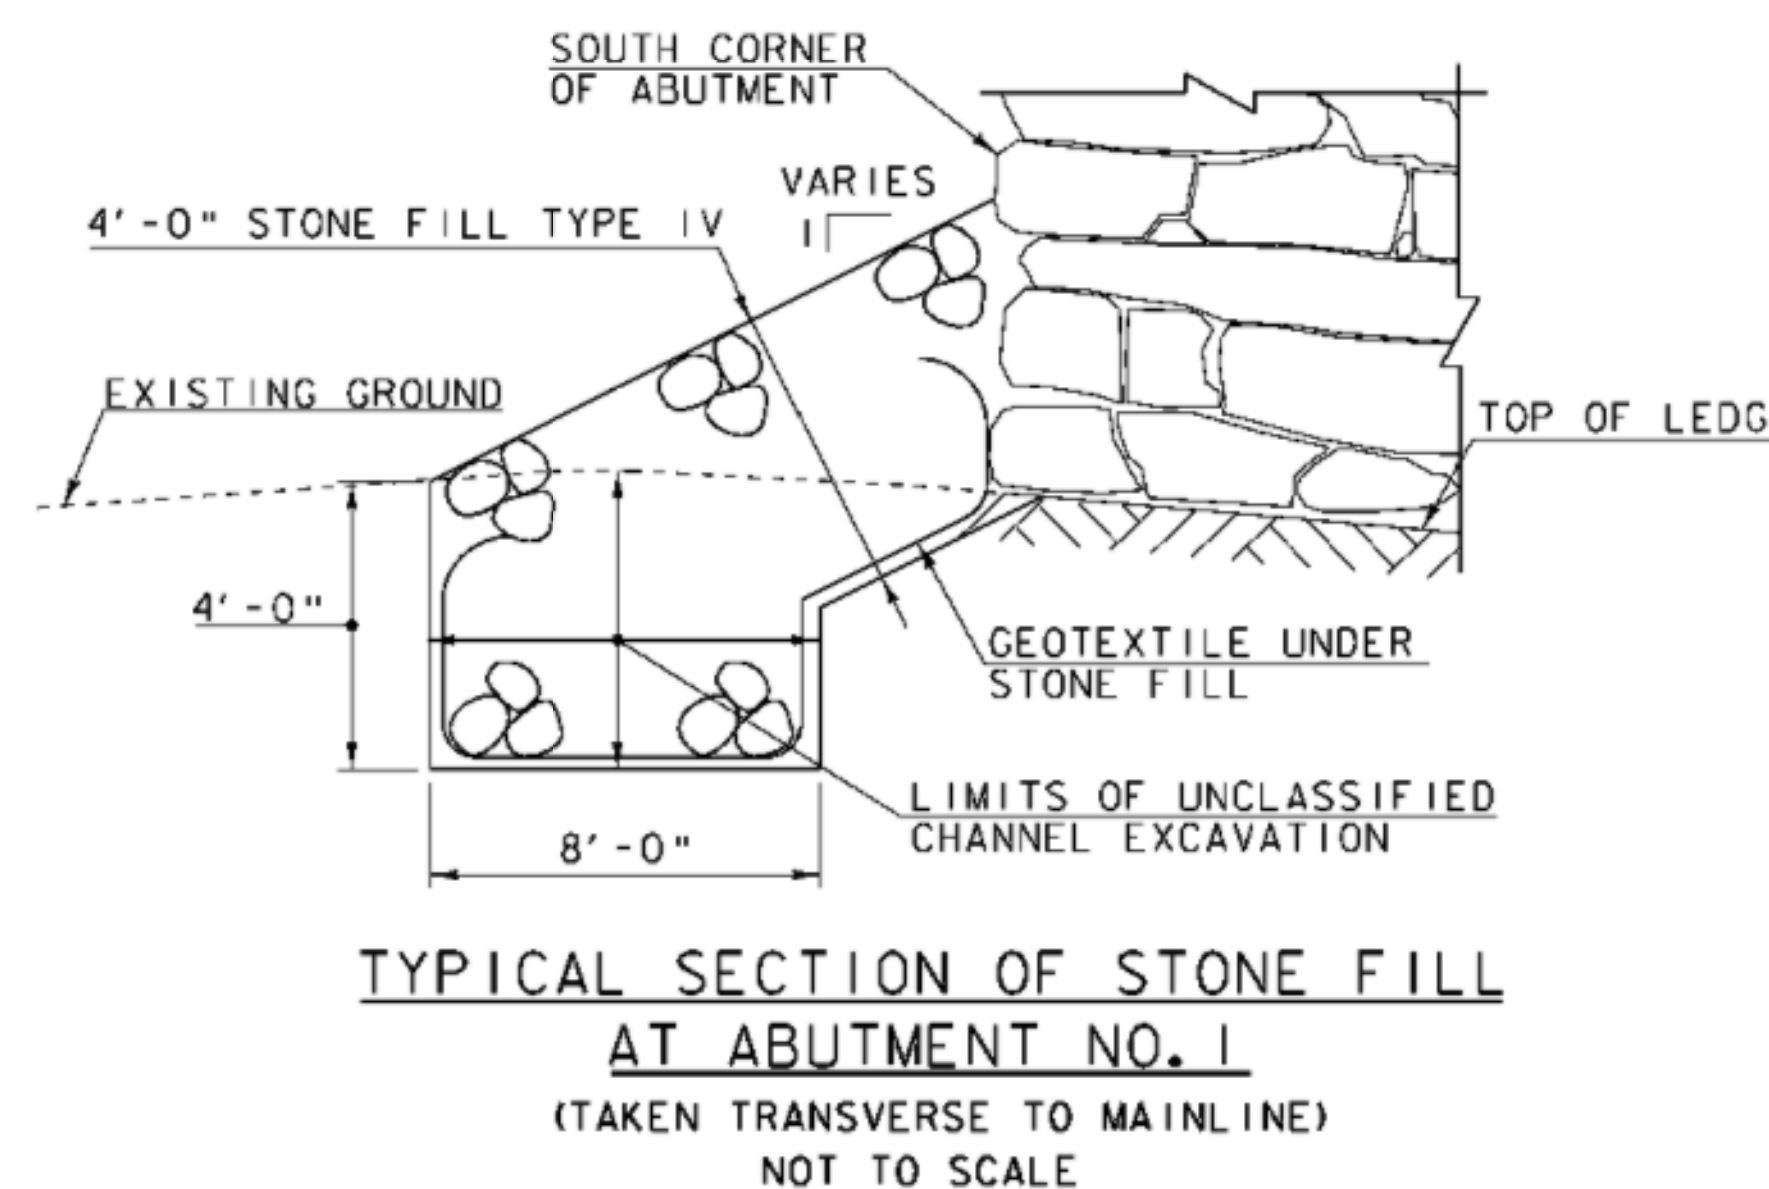
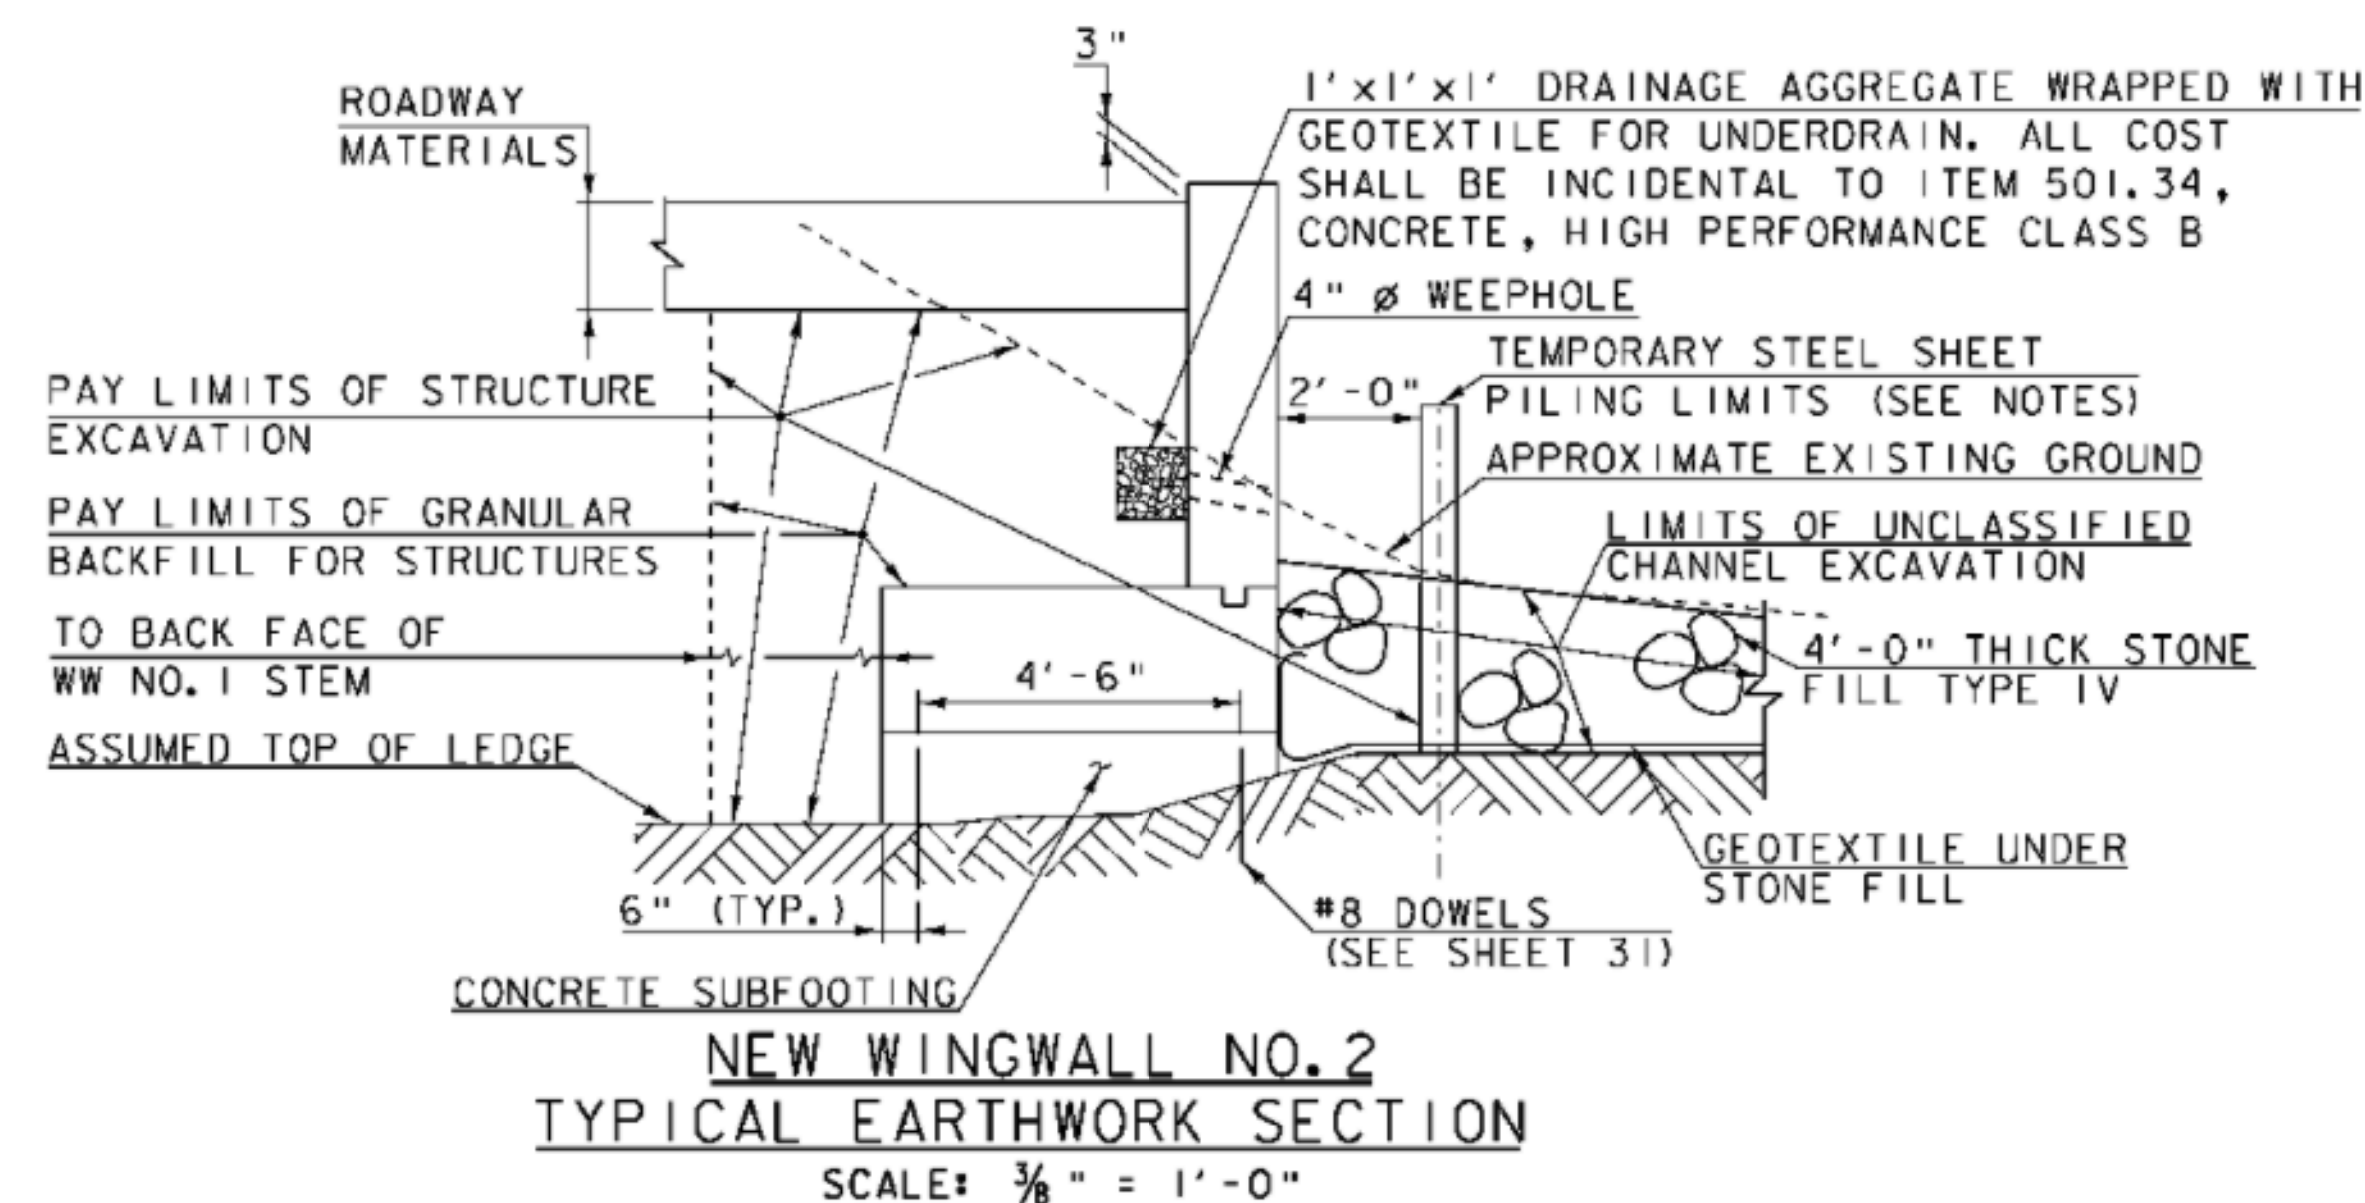
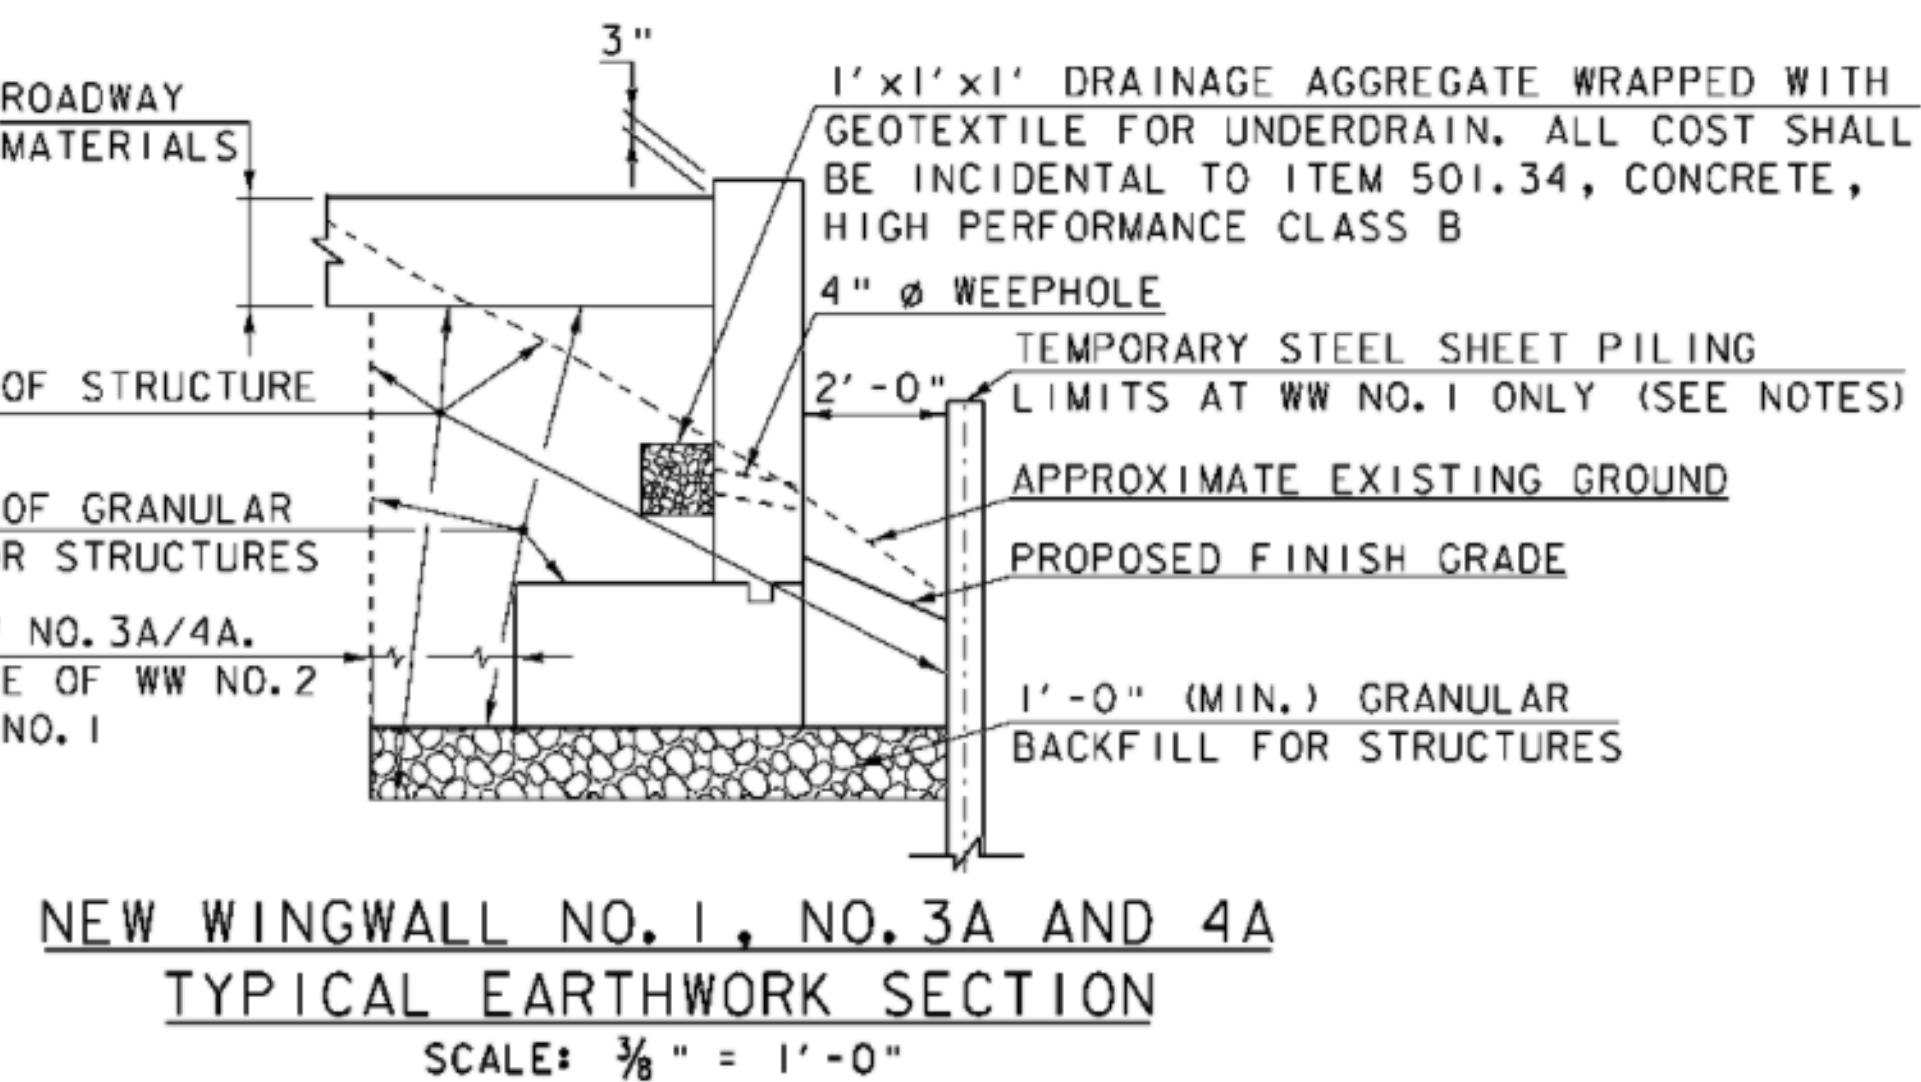
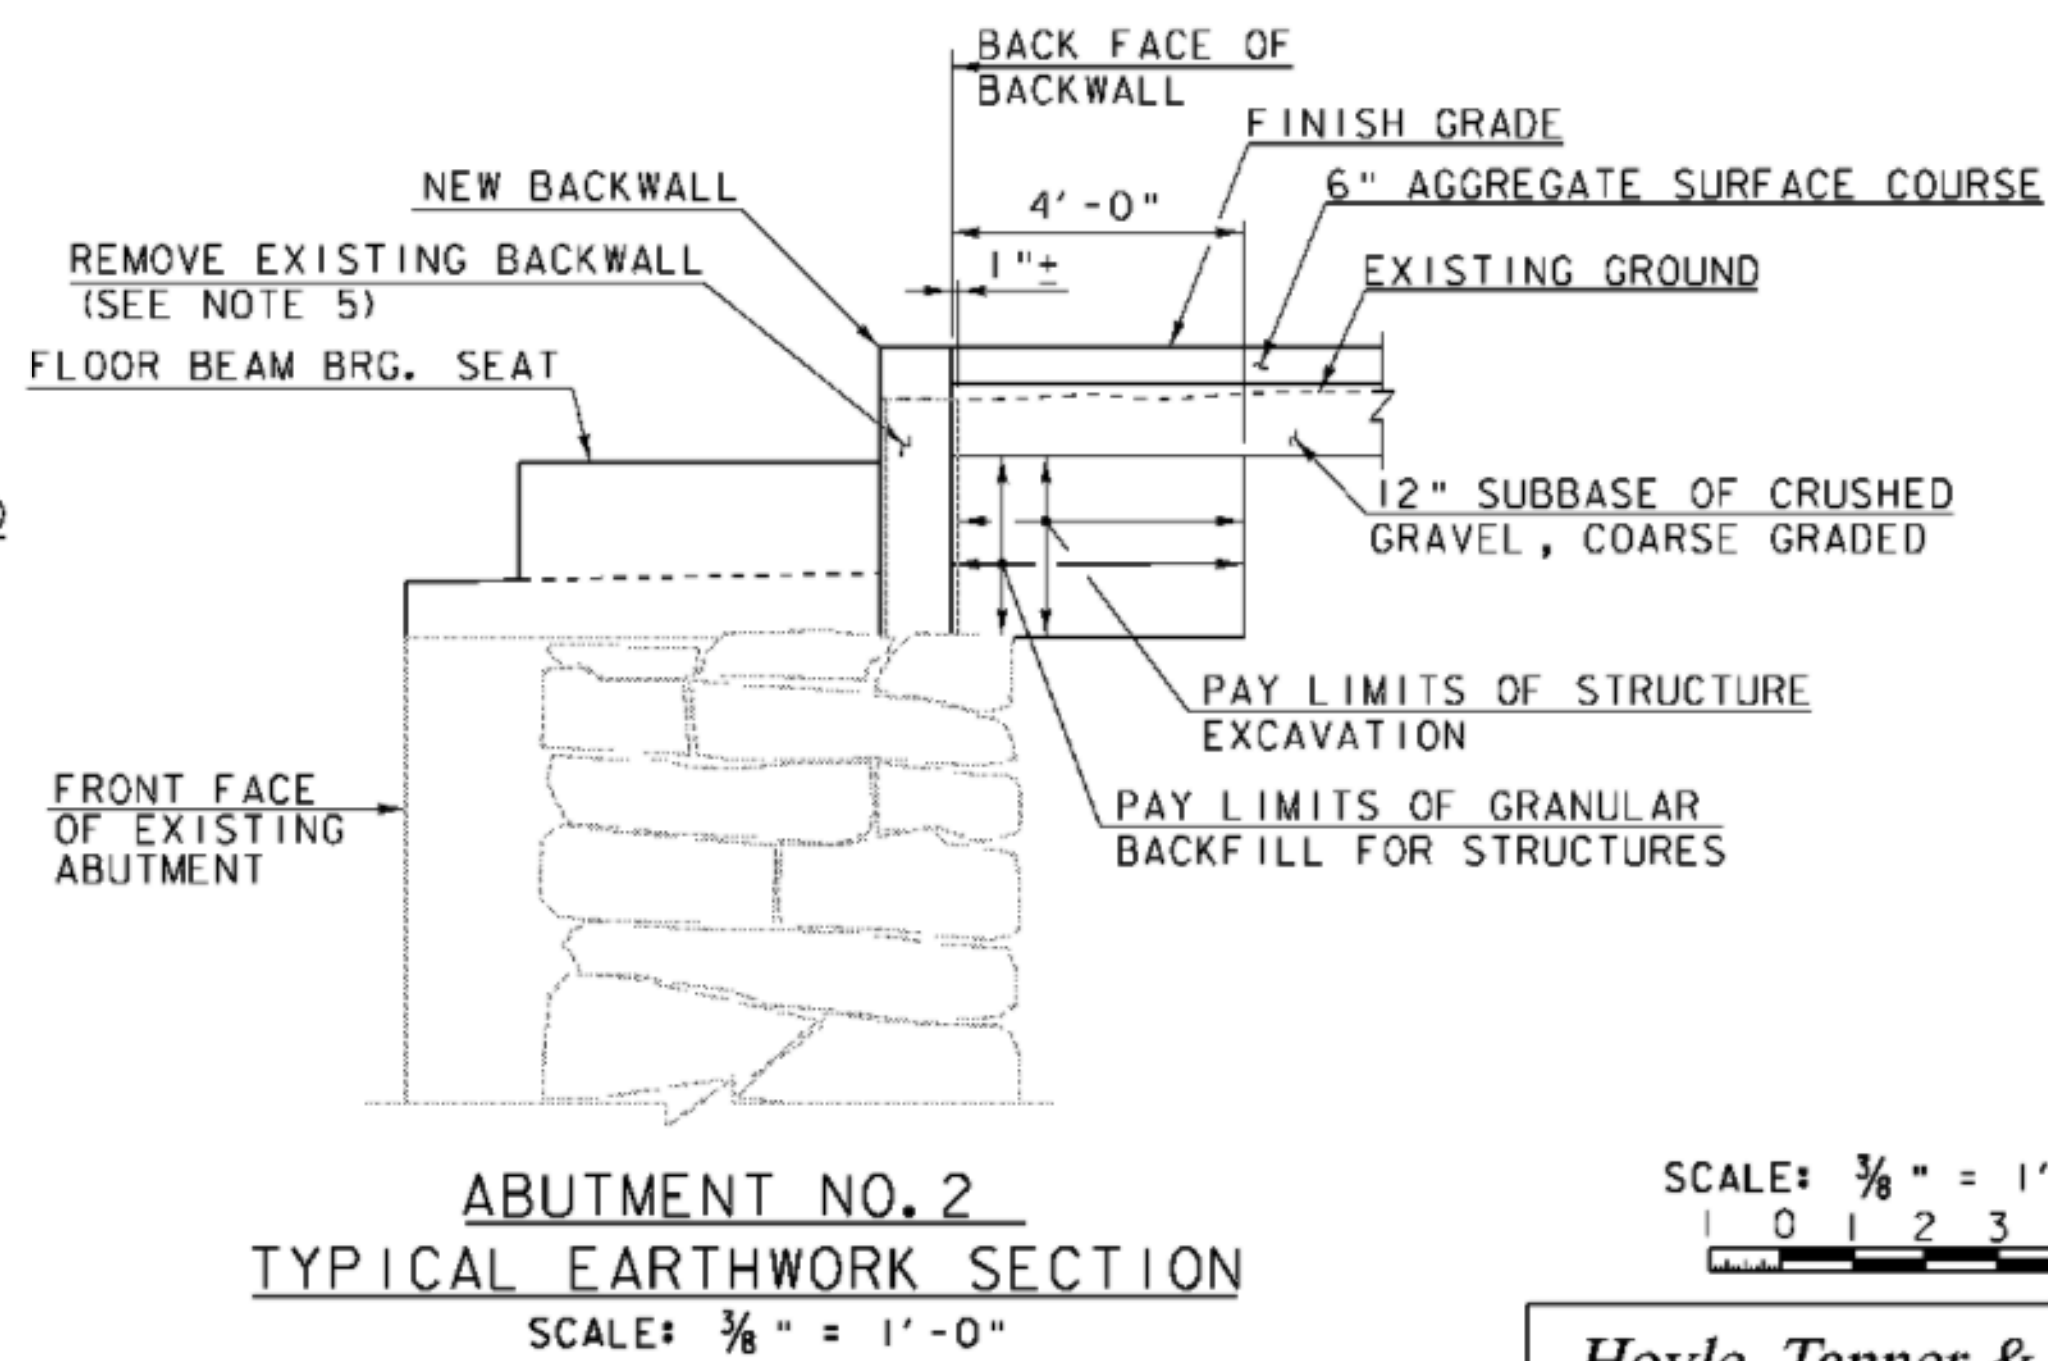


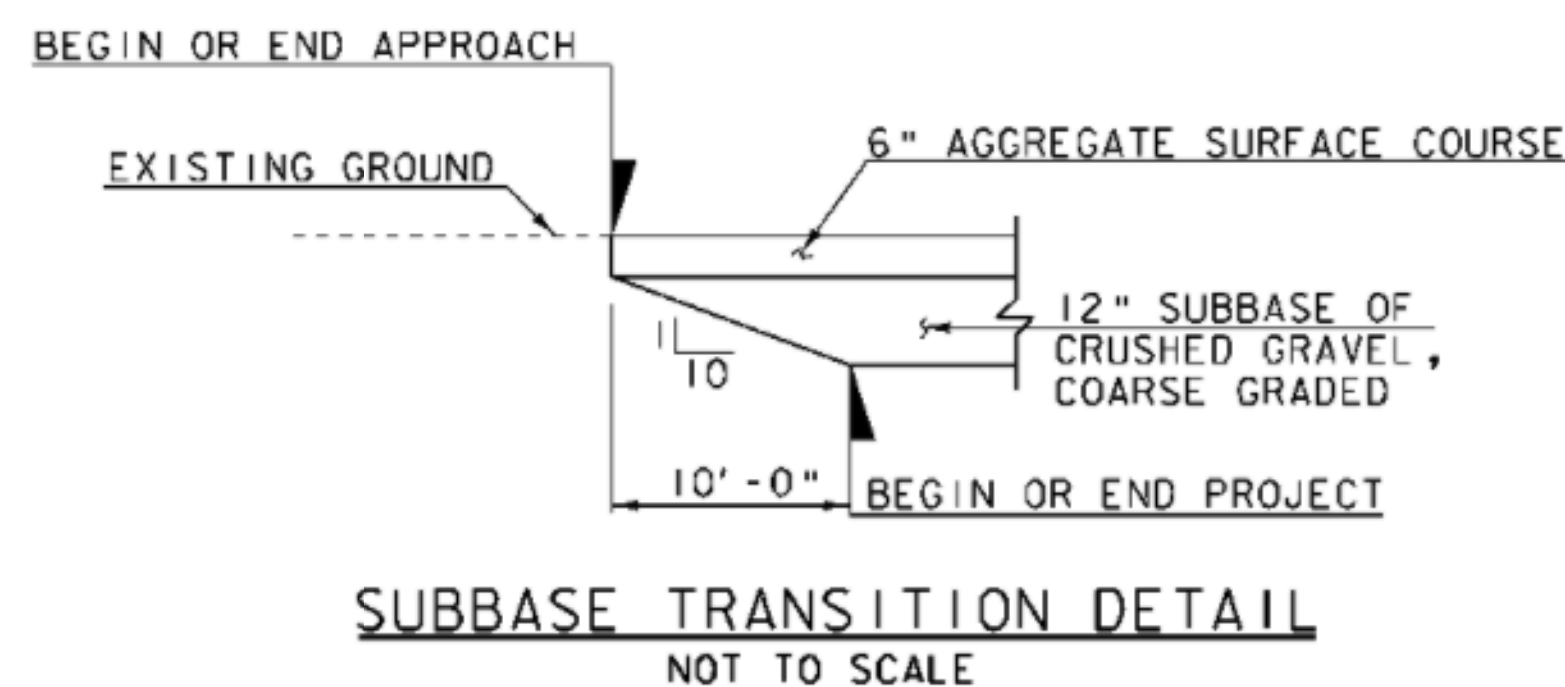

MATERIAL ITEM	TOLERANCE
SURFACE:	
- AGGREGATE SURFACE COURSE	$\pm \frac{1}{2}"$
CRUSHED GRAVEL COURSE	$\pm \frac{1}{2}"$
SUBBASE	$\pm 1"$

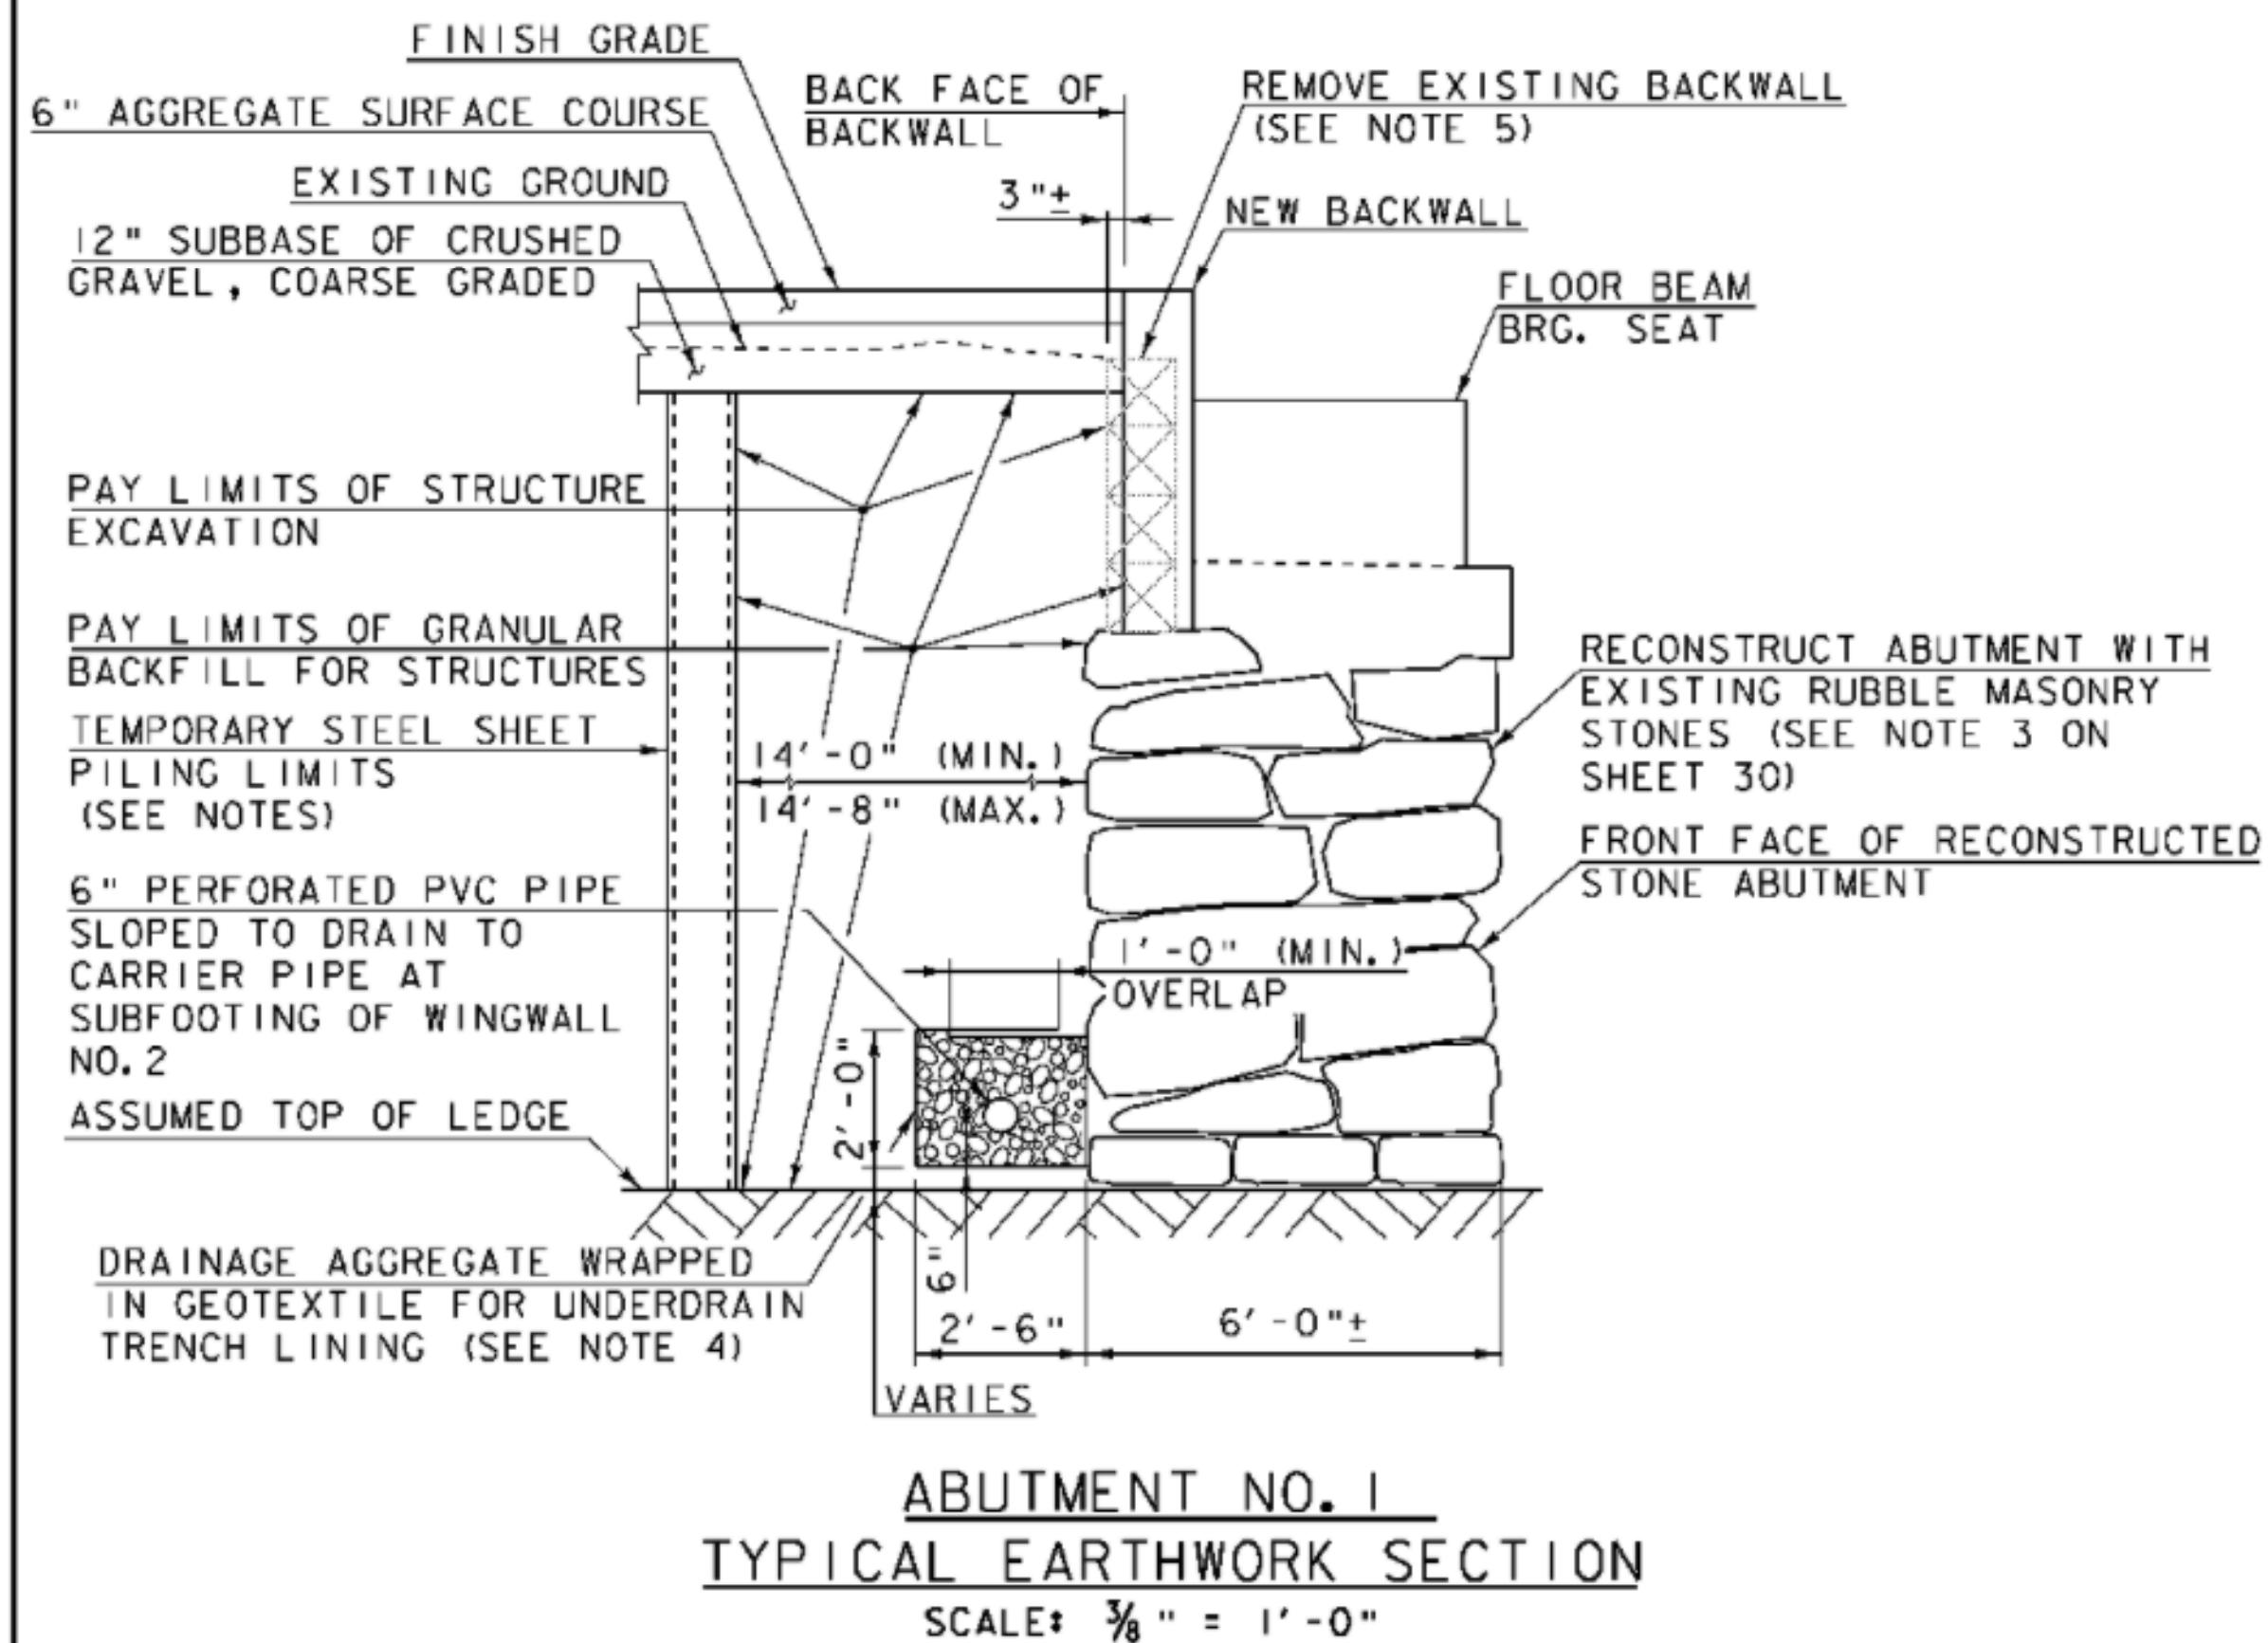

SHEET NOTES:

1. ACTUAL TEMPORARY STEEL SHEET PILING LIMITS TO BE DETERMINED BY THE CONTRACTOR.
2. THE PAY LIMITS OF TEMPORARY STEEL SHEET PILING SHALL BE 2'-0" OUTSIDE THE WESTERN ENDS OF WINGWALLS NO. 1 AND NO. 2 AND AS SHOWN ON SHEET 18, UP TO EXISTING GROUND OR BOTTOM OF SUBBASE, WHICHEVER IS LOWER.
3. IF THE TEMPORARY STEEL SHEET PILING IS CONSTRUCTED LARGER THAN INDICATED IN THESE PLANS, THE ADDITIONAL EXCAVATION AND GRANULAR BACKFILL WILL NOT BE MEASURED FOR PAYMENT.
4. ITEM 605.10, 6 INCH UNDERDRAIN PIPE INCLUDES THE GEOTEXTILE FOR UNDERDRAIN, DRAINAGE AGGREGATE AND 6" PERFORATED PVC PIPE COMPLETE IN PLACE.
5. ALL COSTS FOR REMOVAL OF EXISTING CONCRETE AND MASONRY BACKWALL AT ABUTMENT NO. 2 TO THE LIMITS SHOWN, IS PAID FOR UNDER ITEM 529.25, REMOVAL OF CONCRETE OR MASONRY. REMOVAL OF EXISTING TIMBER BACKWALL AT ABUTMENT NO. 1 IS PAID FOR UNDER ITEM 529.20, PARTIAL REMOVAL OF STRUCTURE.

SCALE: 3/8" = 1'-0"

MODEL
Default
HTA PROJECT NO.
904214

PROJECT NAME: MONTGOMERY
PROJECT NUMBER: BHO 1448(23)

FILE NAME: Z96J302detail.dgn
PROJECT LEADER: J.H. WEAVER
DESIGNED BY: J.BICJA
EARTHWORK TYPICALS

PLOT DATE: 8/1/2008
DRAWN BY: J.B. McQUAID
CHECKED BY: S.T. JAMES
SHEET 4 OF 54

Hoyle, Tanner & Associates, Inc.