



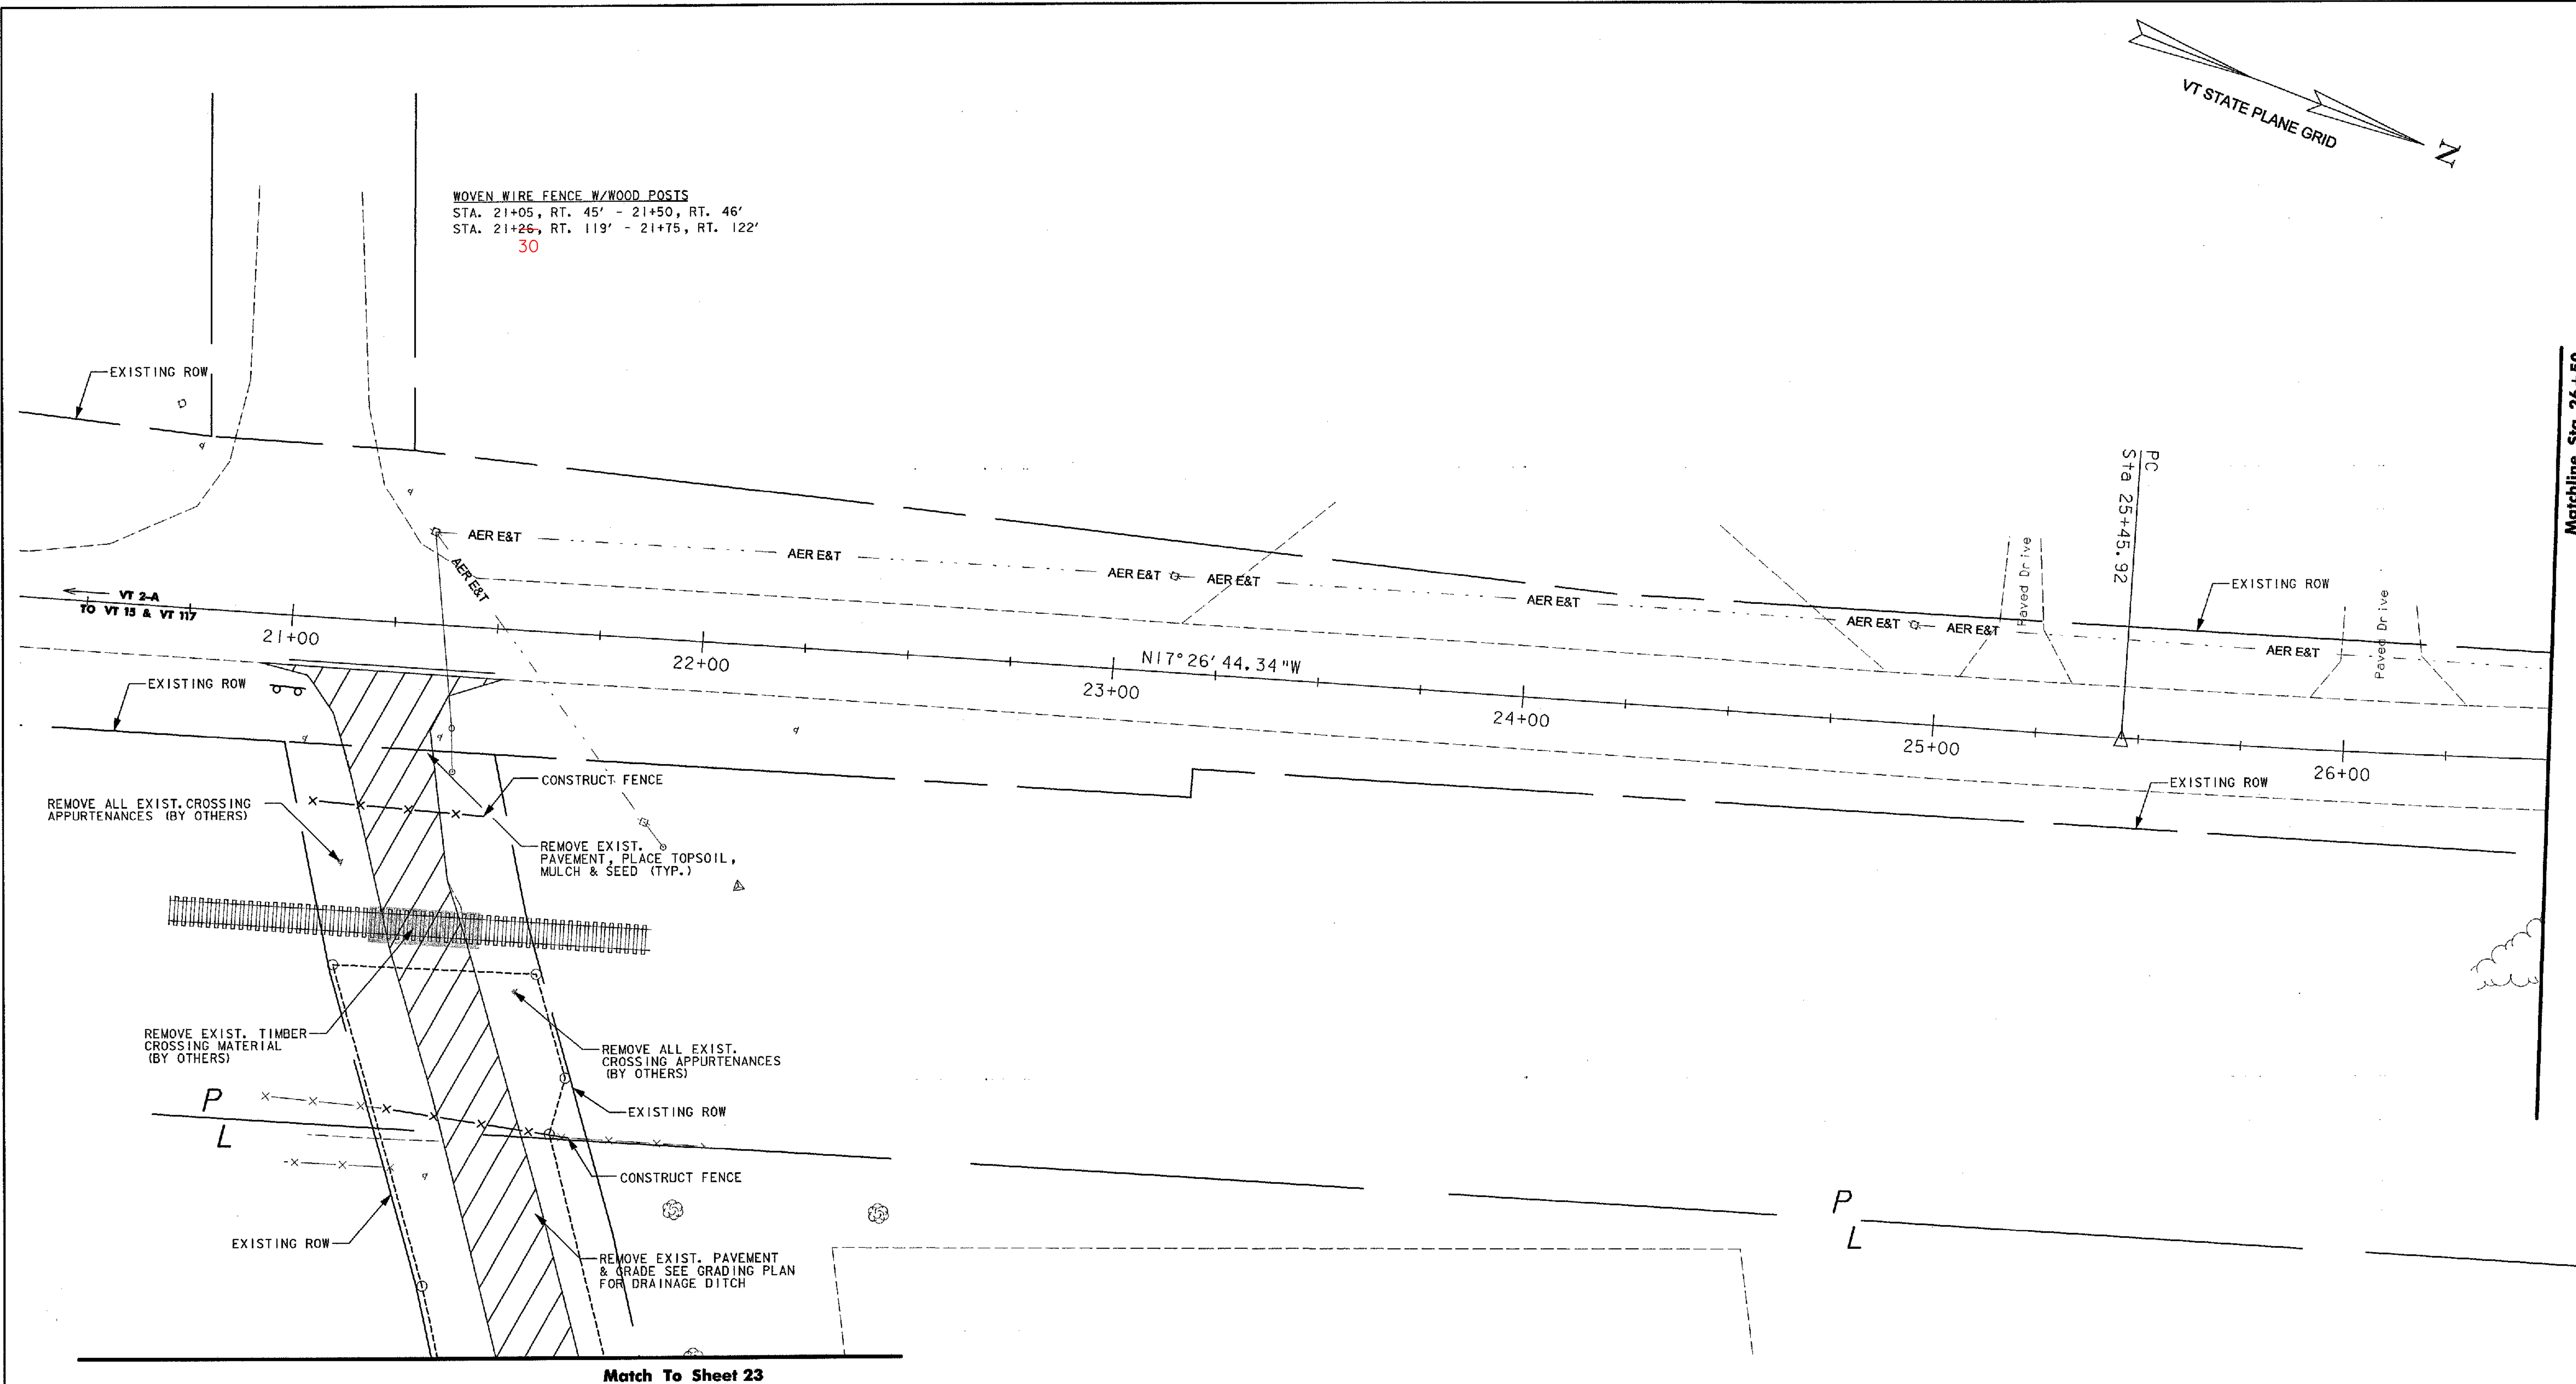

**GENERAL NOTES:**

- 1) RAIL CROSSING WORK TO BE COMPLETED BY OTHERS. SEE RAIL CROSSING PLANS, PROFILE, & TYPICAL FOR DETAILS.

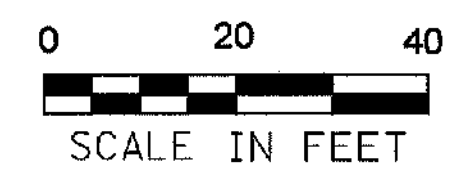

**VT. 2A**

**VHB Vanasse Hangen Brustlin, Inc.**

**GENERAL PLANS**

|                                                           |                              |
|-----------------------------------------------------------|------------------------------|
| PROJECT:<br>ESSEX                                         | PROJECT NO.:<br>STP2035(14)S |
| DESIGN FILE NAME: NH-BED\PROJECTS\CAD\TEXT\51070BDR-1.DGN | PLOT DATE: 06/14/2002        |
| IPARM FILE NAME:                                          | SURVEY DATE: 18Sept99        |
| SURVEYED BY:                                              | DRAWN BY: RBN                |
| SQUAD LEADER: GLB                                         | SHEET: 20 OF 50              |

DATUM  
 VERTICAL NAVD 88  
 HORIZONTAL NAD 83 (96)