

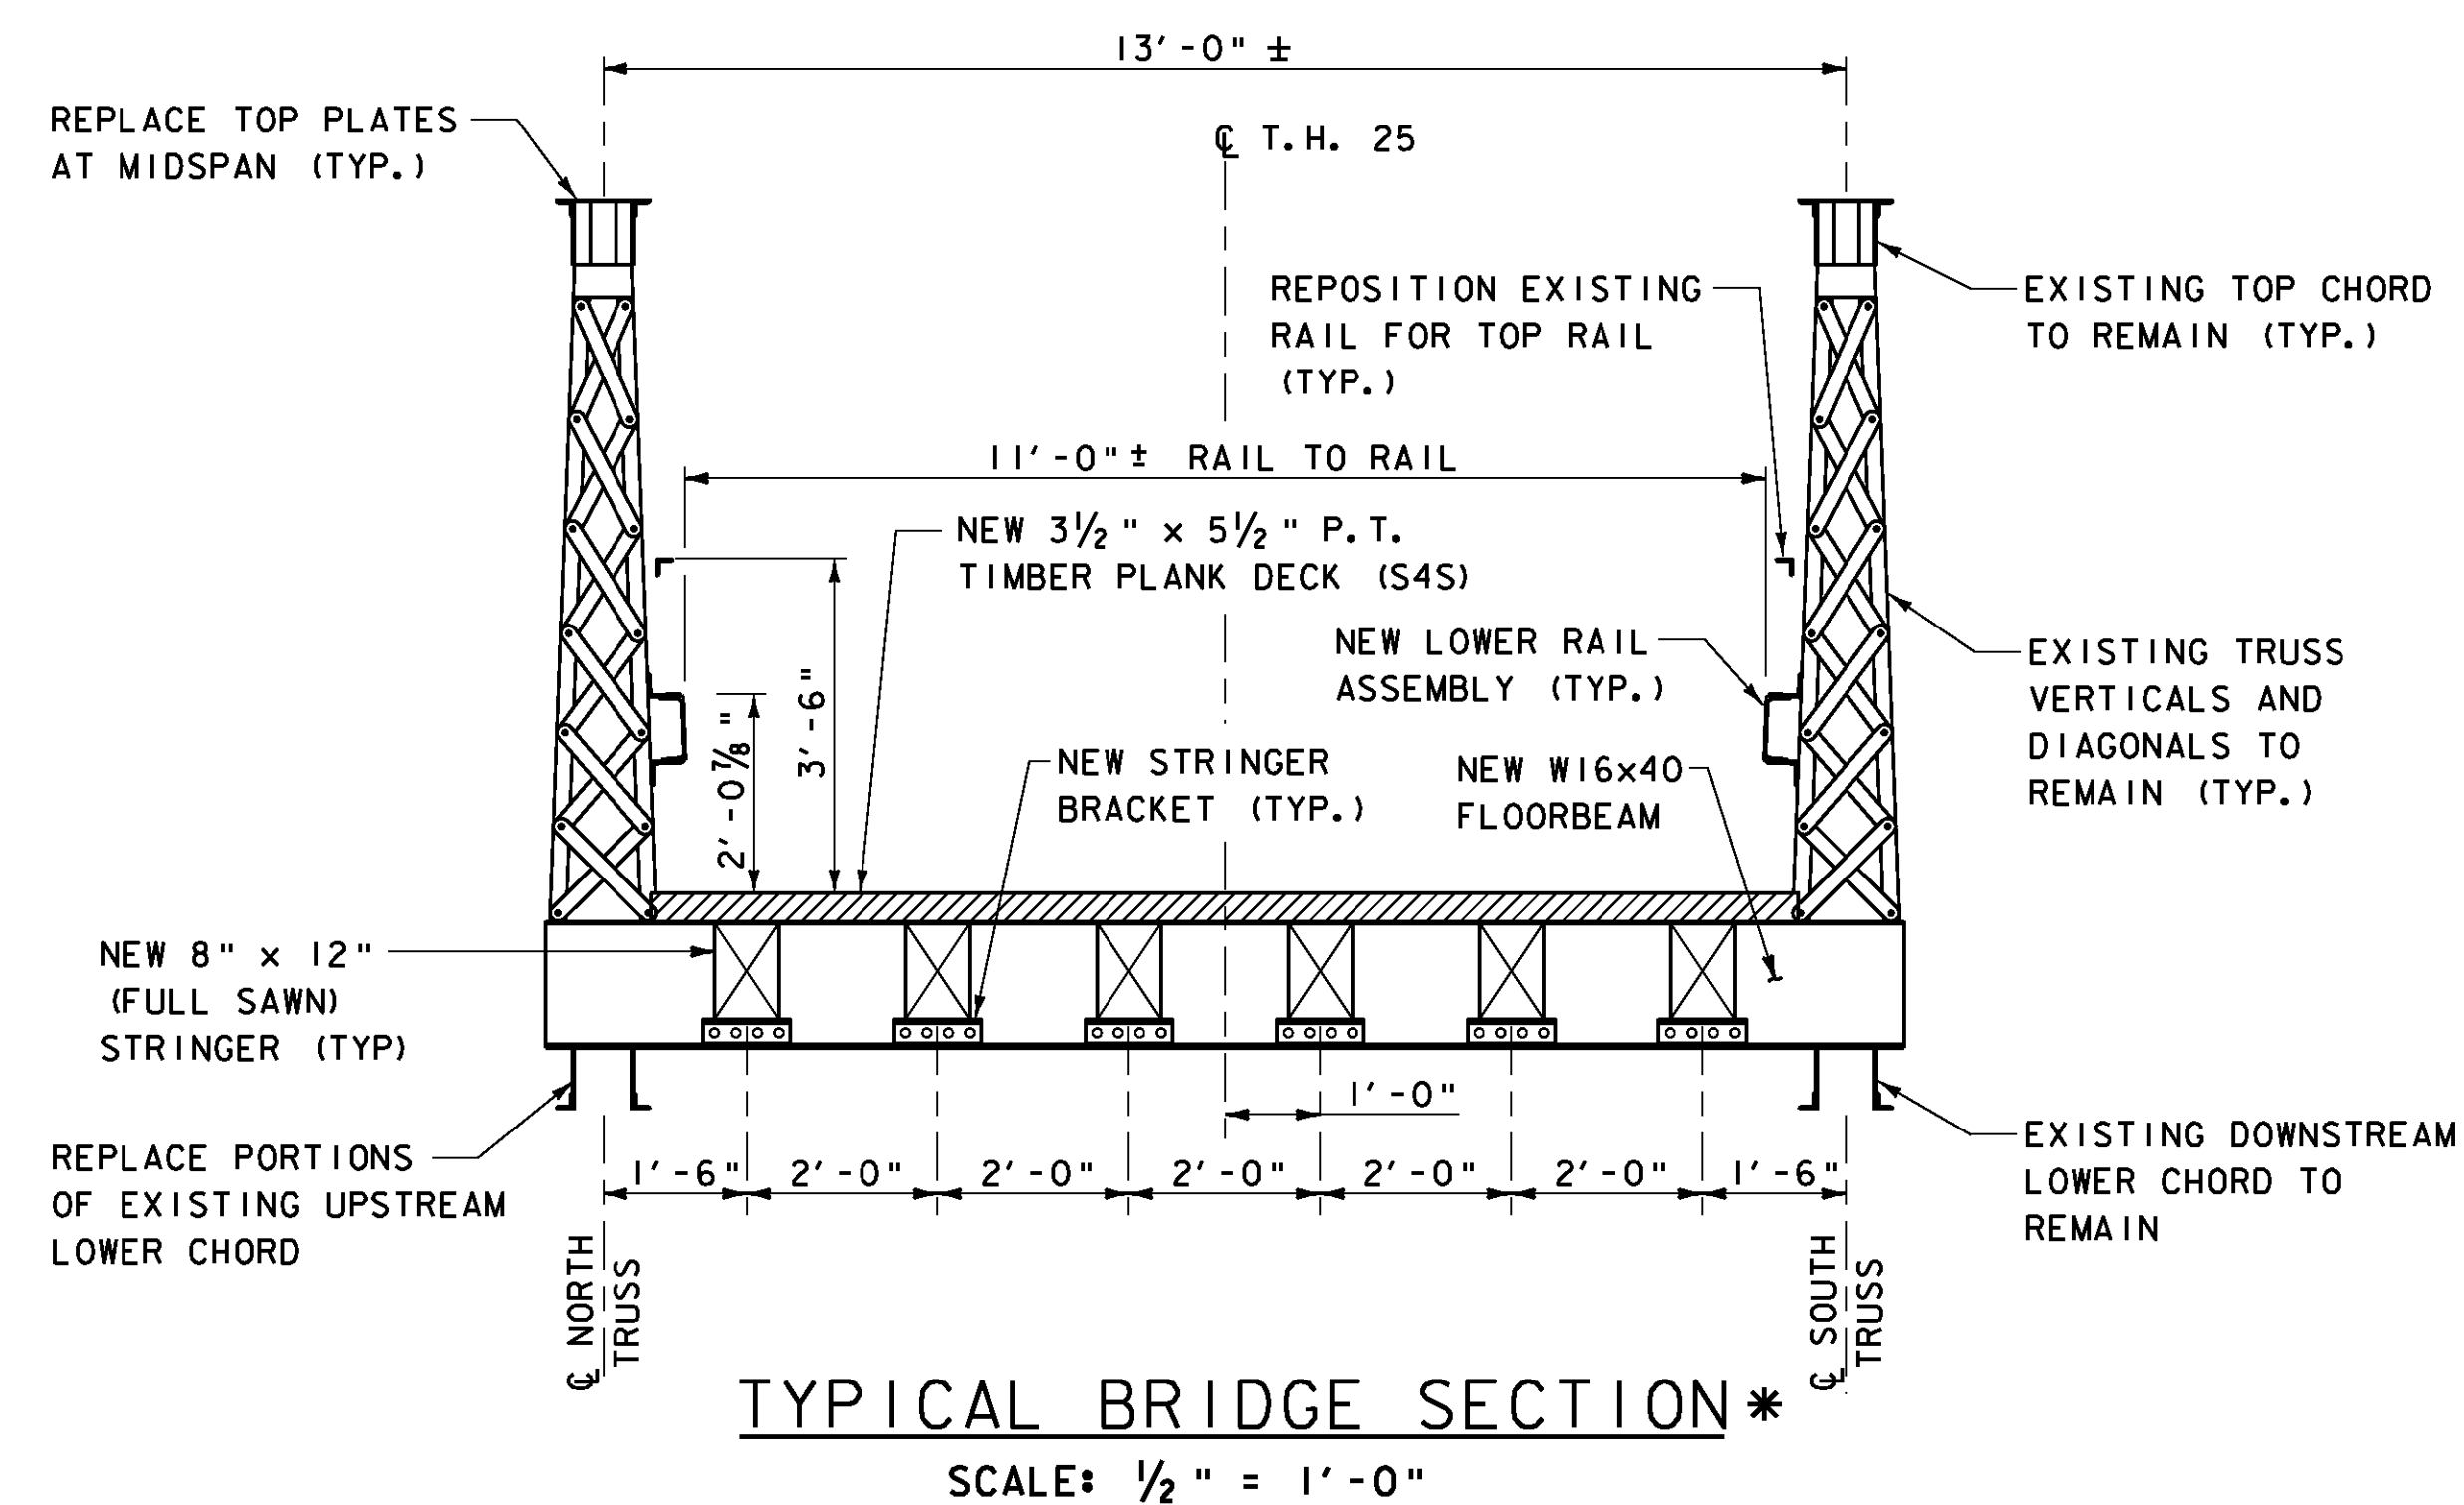


(IF USED ON PROJECT)

SURFACE	
- PAVEMENT (TOTAL THICKNESS)	+/- 1/4"
- AGGREGATE SURFACE COURSE	+/- 1/2"
SUBBASE	+/- 1"
SAND BORROW	+/- 1"

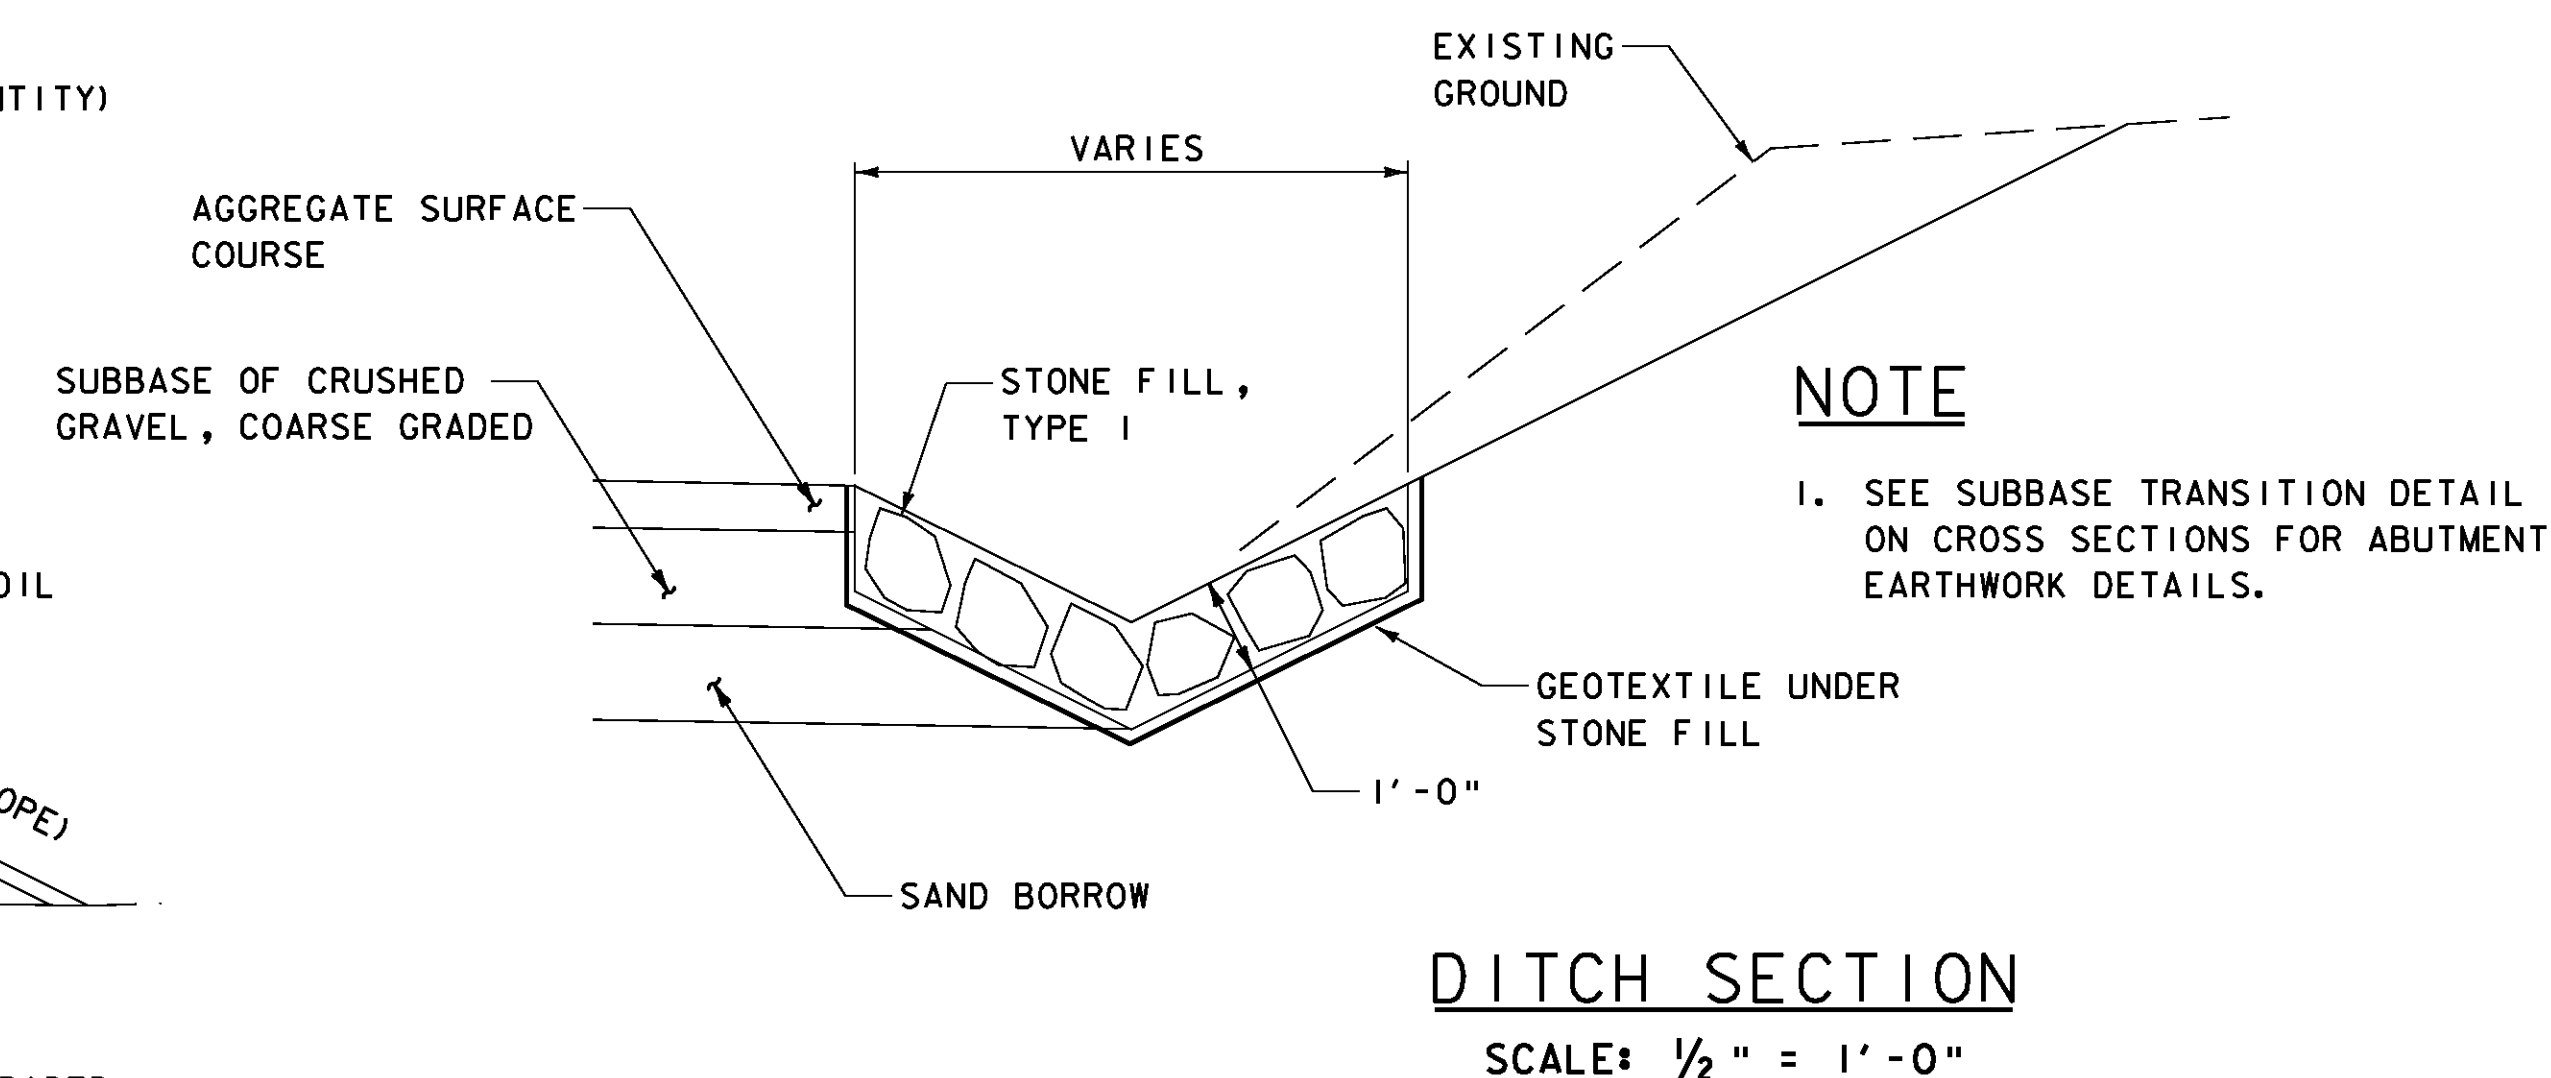

* SEE GENERAL NOTE 2 ON SHEET 17

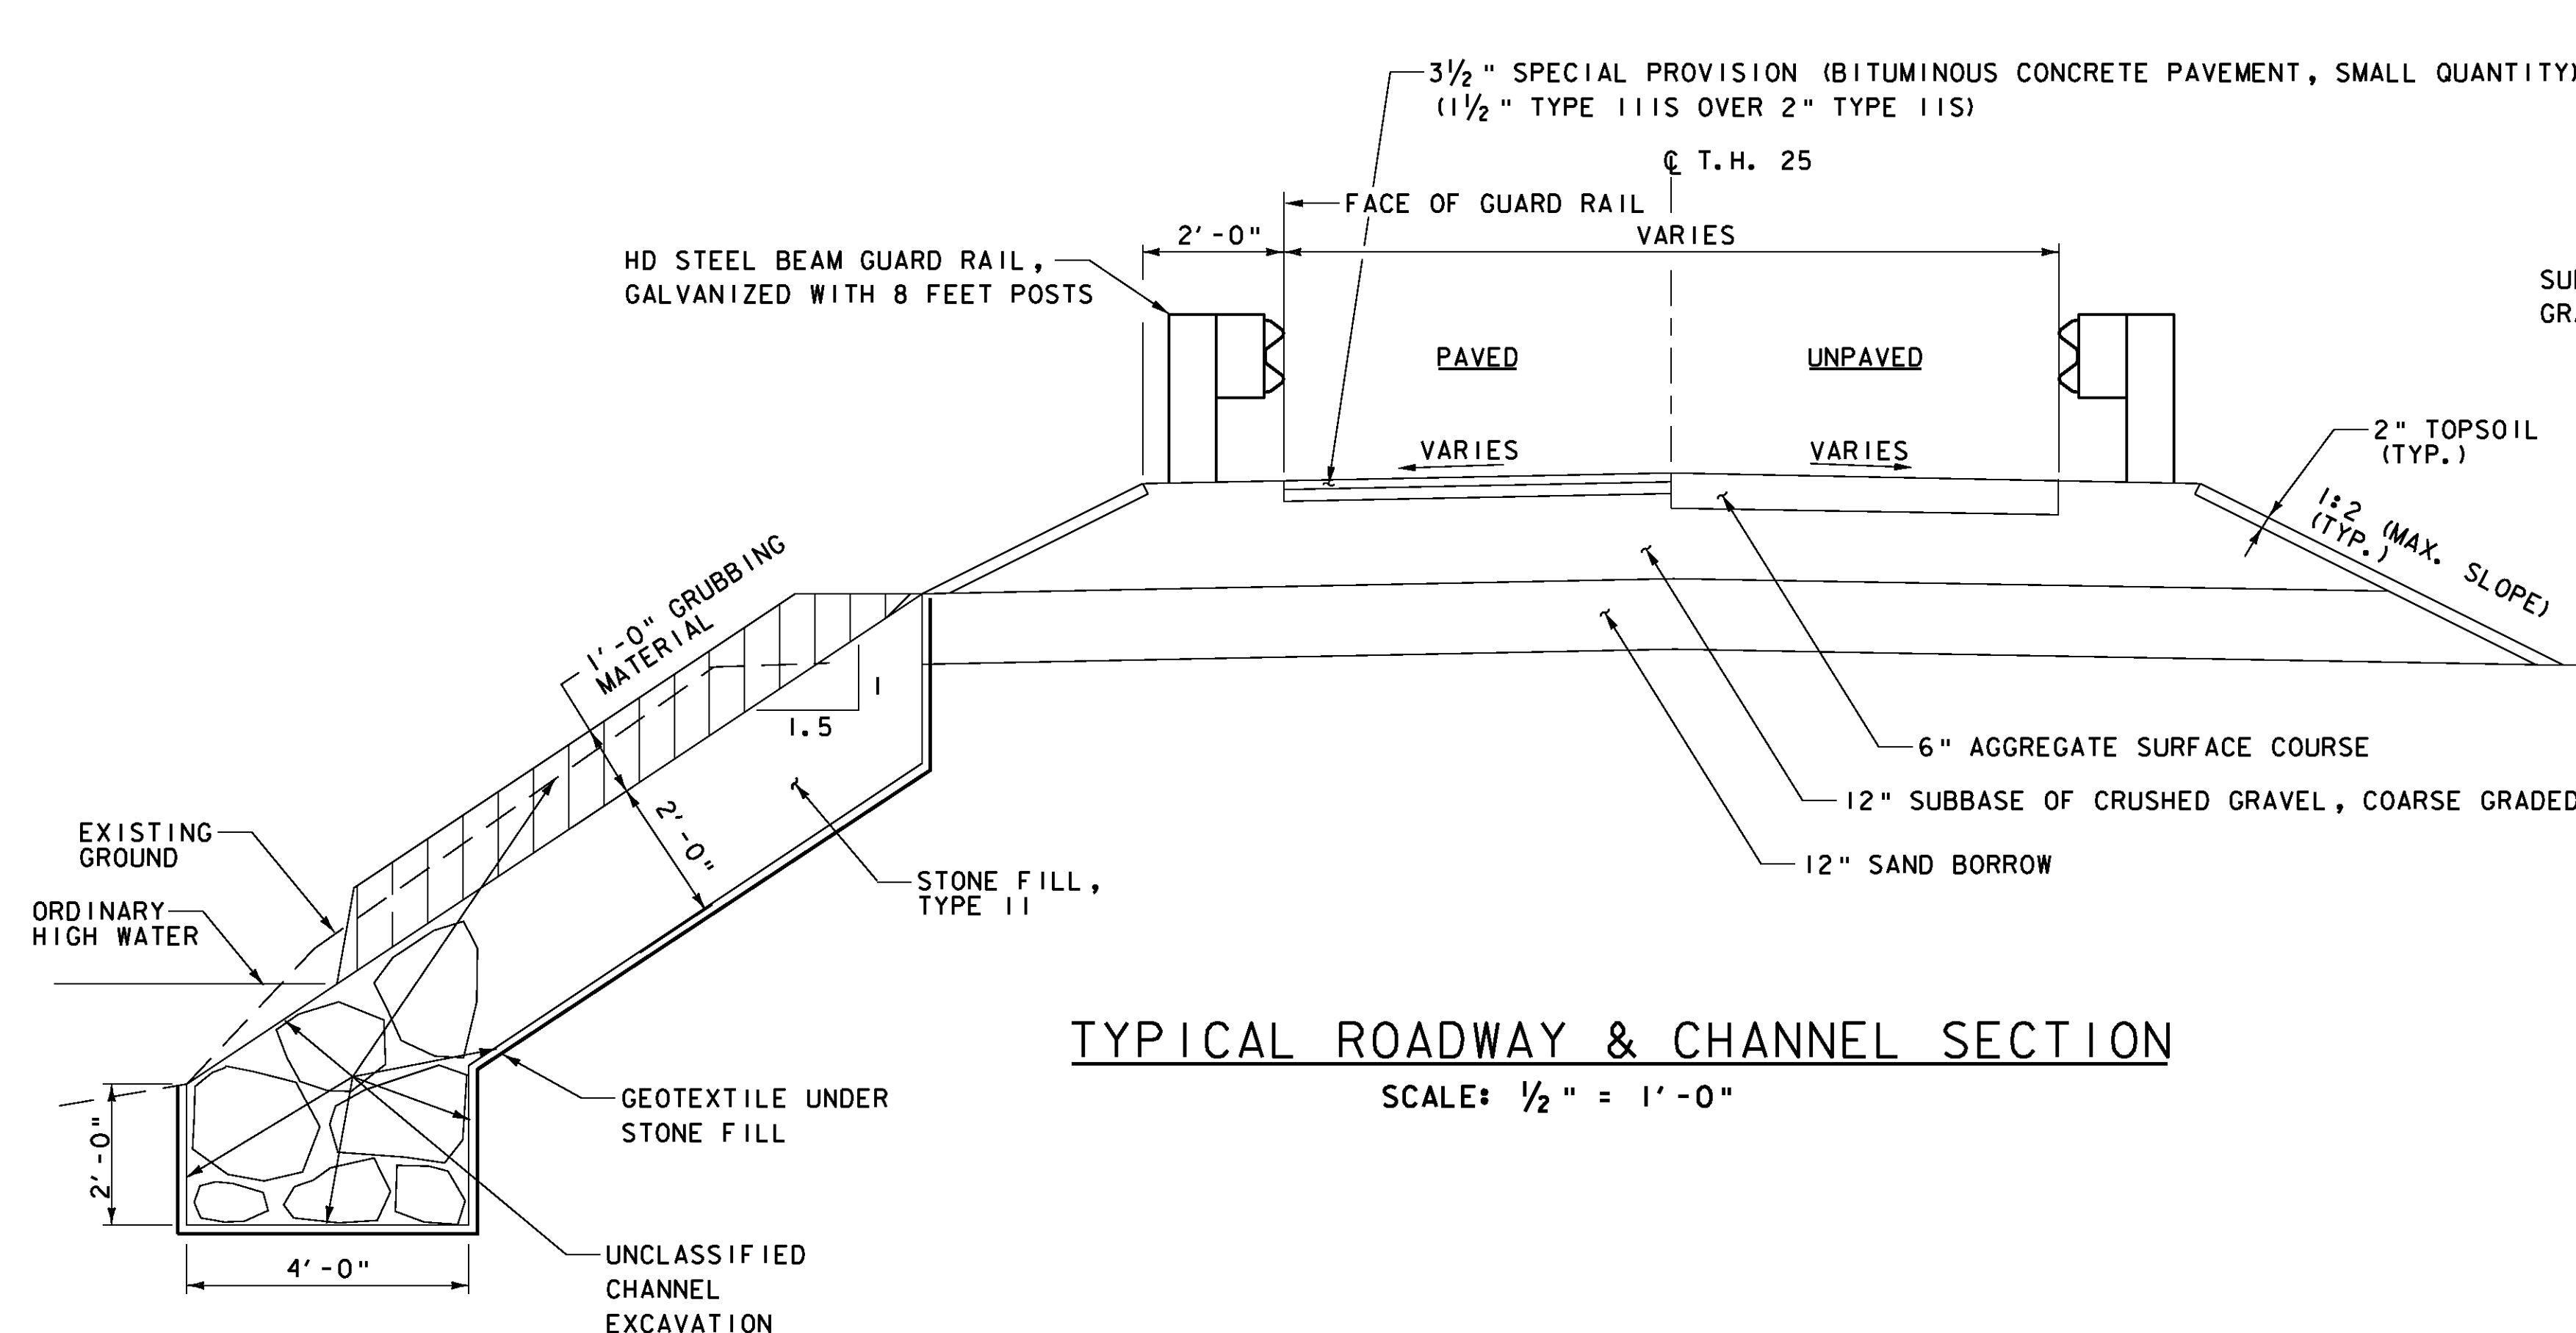

NOTE

I. SEE SUBBASE TRANSITION DETAIL
ON CROSS SECTIONS FOR ABUTMENT
EARTHWORK DETAILS.

DITCH SECTION

SCALE: $\frac{1}{2}'' = 1' - 0''$

SCALE $\frac{1}{2}" = 1'-0"$



SHEET NAME: PROJECT TYPICAL SECTIONS	
PROJECT NAME: TUNBRIDGE	
PROJECT NUMBER: BRO 1444 (39)	
FILE NAME: z99JI0+yp.dgn	PLOT DATE: 26-MAY-2009
PROJECT LEADER: K.M. Higgins	DRAWN BY: P. Dustin
DESIGNED BY: S. Della/P. Dustin	CHECKED BY: R. Joy
	SHEET 3 OF 32