






2728

- C

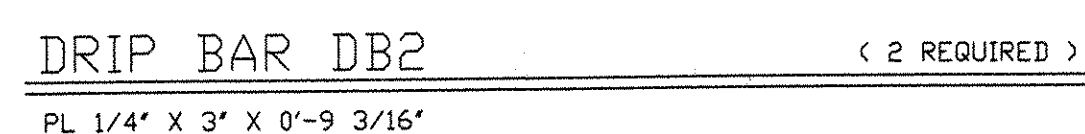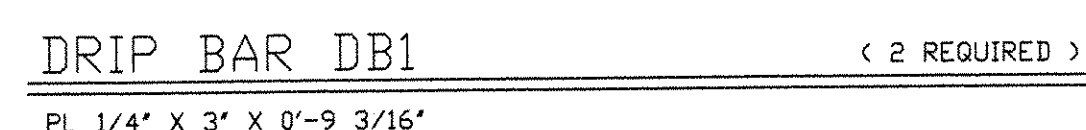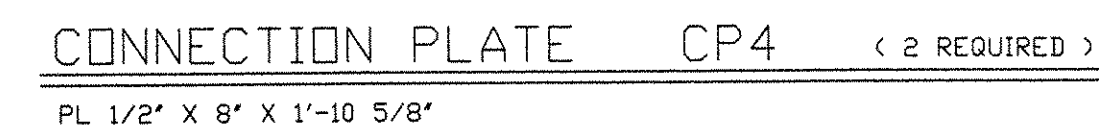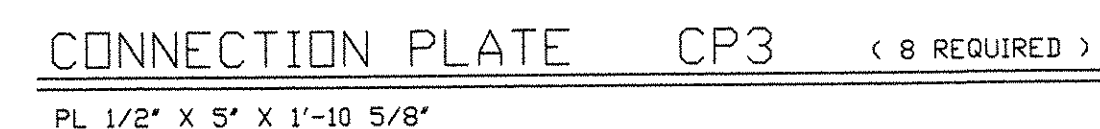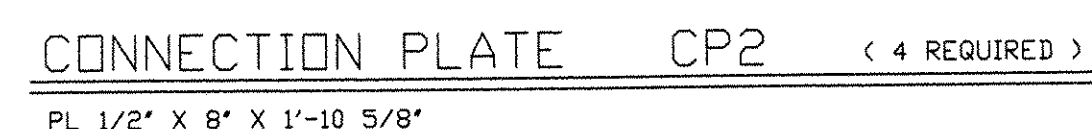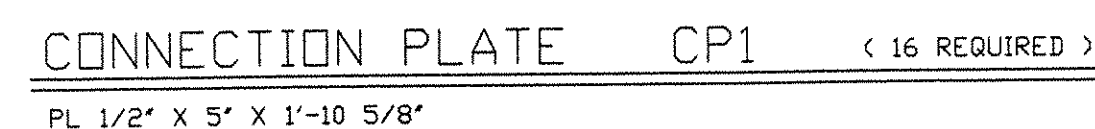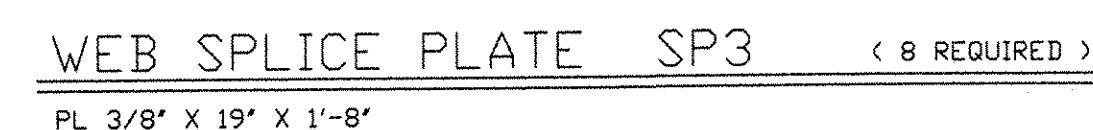

EBL

A