
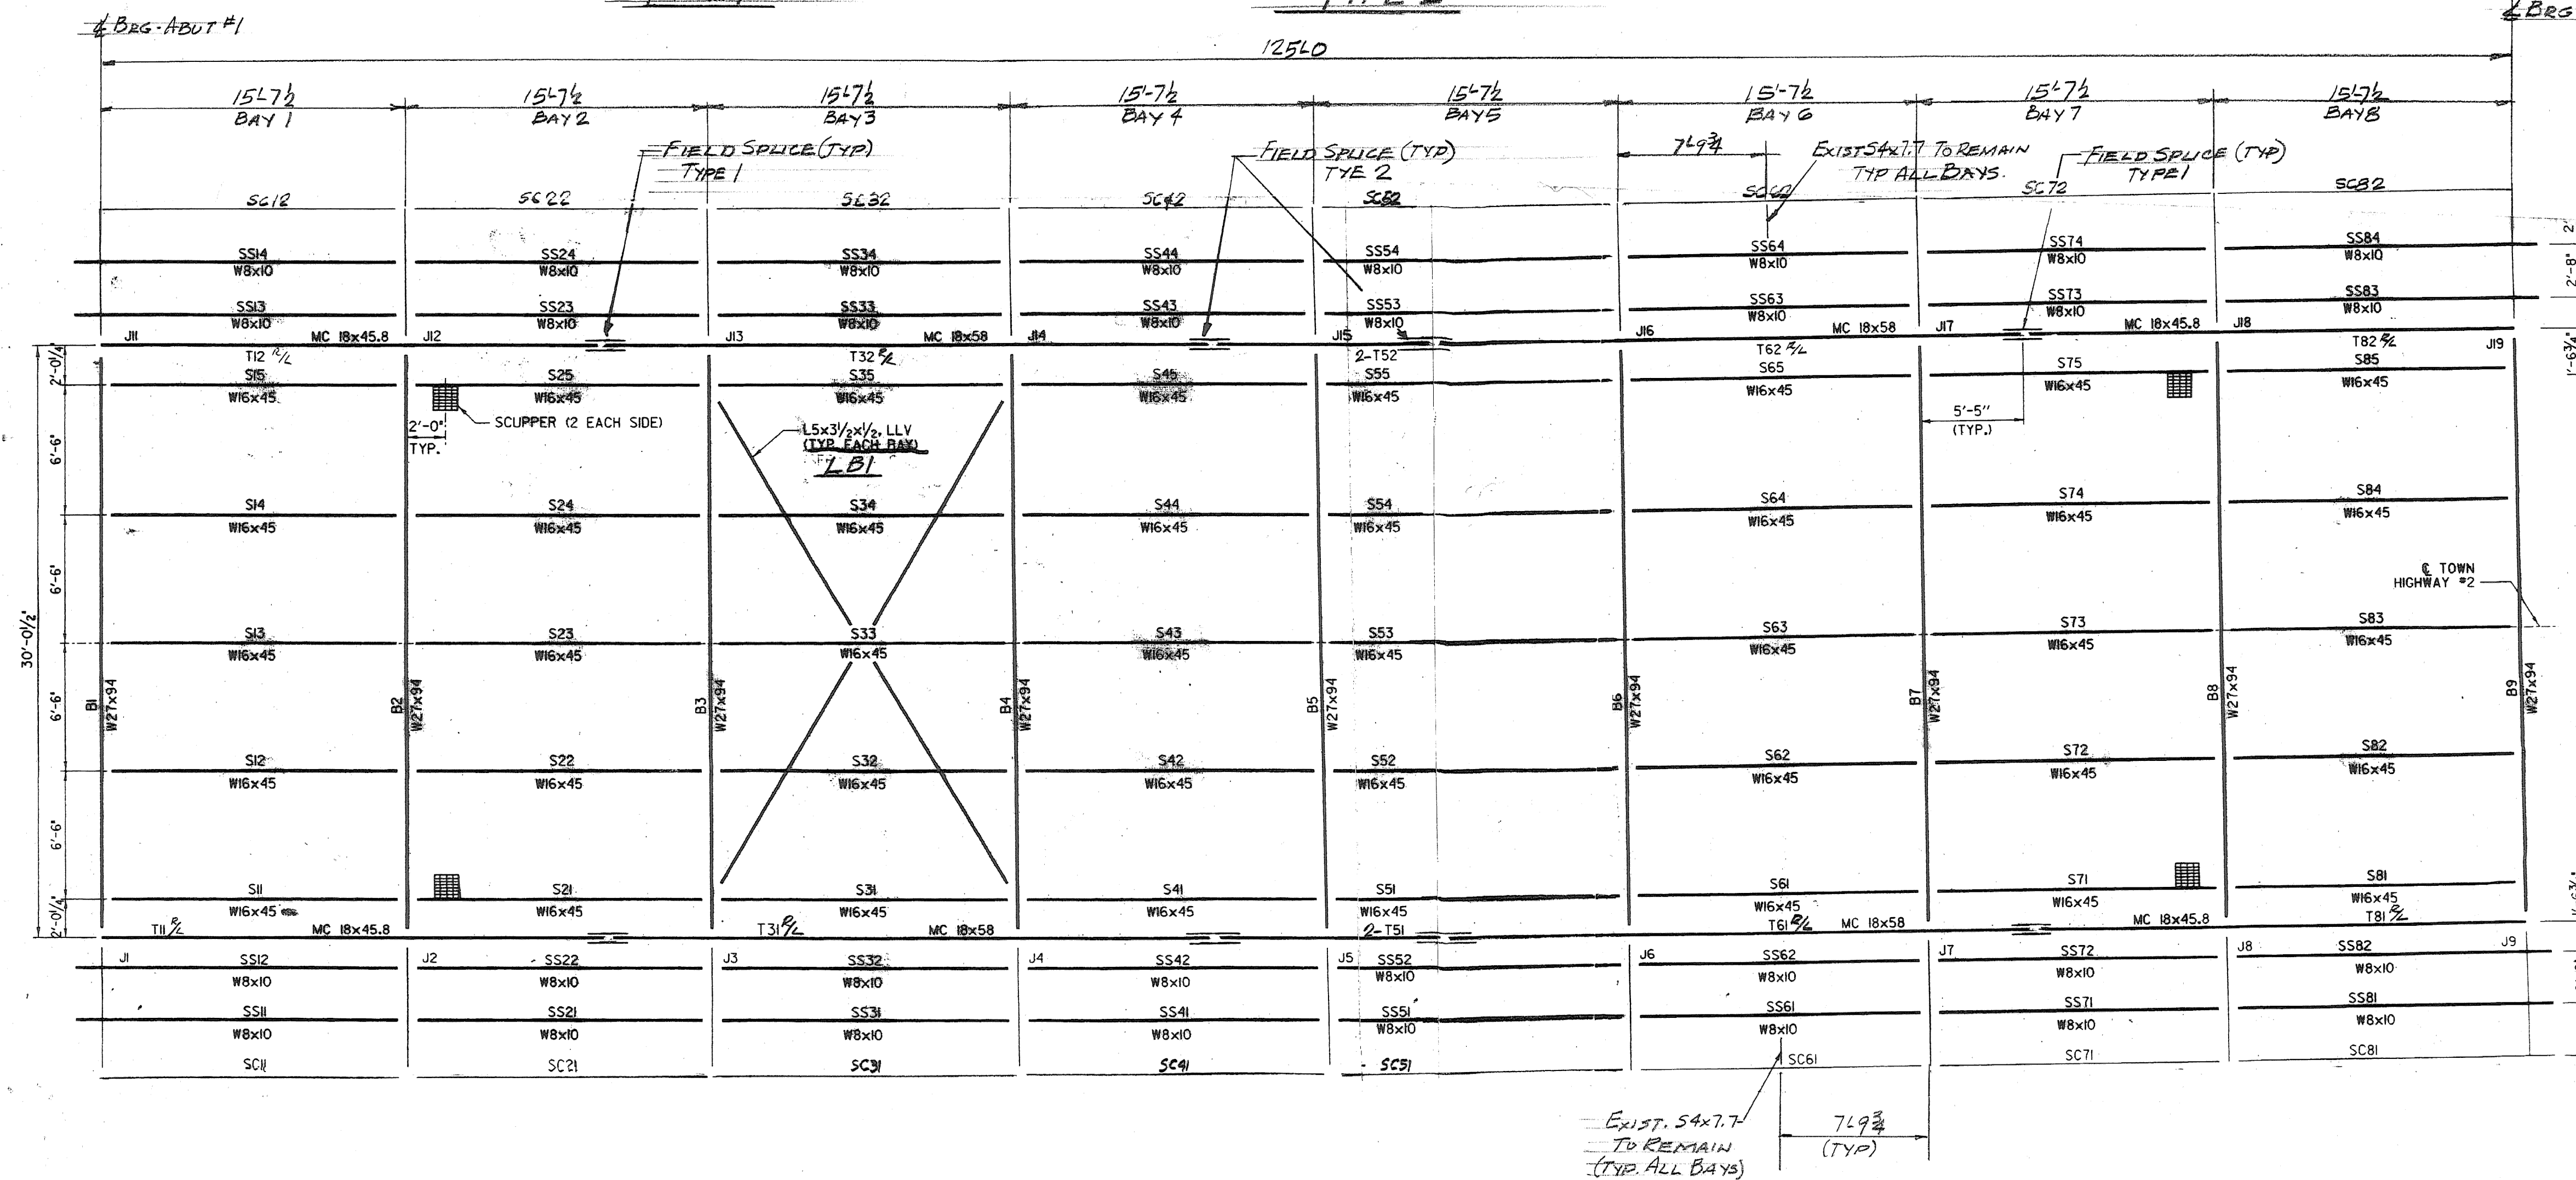
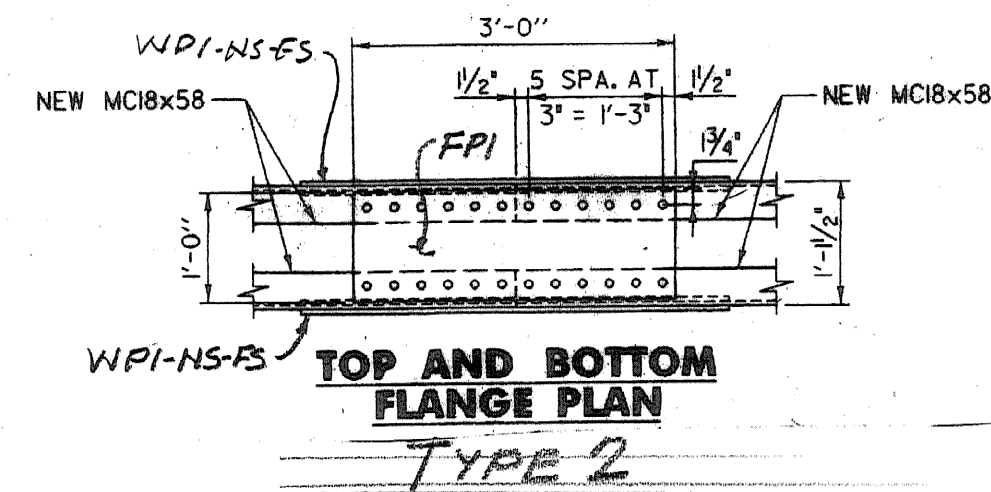


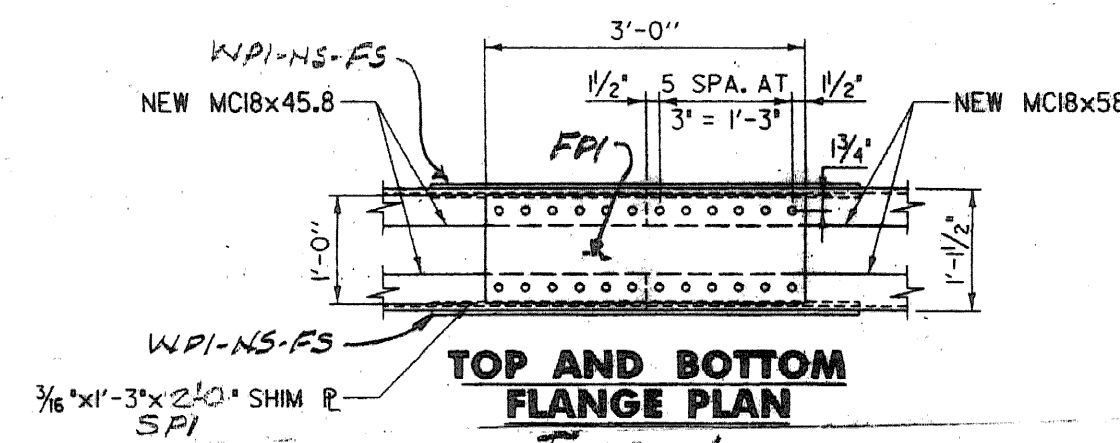

FRAMING PLAN

- LEGEND
- J = JOINT
 - S = FLOOR STRINGER (NEW W16x45)
 - B = BEAM (NEW W27x94)
 - T = TRUSS BOTTOM CHORD (SEE PLAN)
 - SS = SIDEWALK STRINGER (NEW W8x10)
 - SC = EXISTING SIDEWALK CHANNEL (C7)
 - = NEW FRAMING MEMBER
 - = EXISTING FRAMING MEMBER TO BE RETAINED

SHOP DRAWINGS ARE REVIEWED UNLESS NOTED OTHERWISE

NO EXCEPTION TAKEN

REVISE AS NOTED (RESUBMISSION NOT REQUIRED)

REVISE AS NOTED (RESUBMISSION REQUIRED)

REJECTED

DATE 4/23/08

SIGNATURE Michael Christ

REVIEW BY: OF ASPECTS: CONFORMANCE WITH DESIGN, CONTROL DIMENSIONS, FABRICATION, AND CONSTRUCTION METHODS, COORDINATION OF SUB-TASKS, DETAIL DESIGN OF COMPONENTS AND DETAILS, OR OMISSIONS ON SHOP DRAWINGS.

OUT FOR APPROVAL	3/19/08																		
OUT FOR APPROVAL	4/17/08																		
ISSUED TO SHOP																			
FIELD & OFFICE																			
App'l Comments	4/17/08																		
REV. REMARKS	DATE	DWN	CHK	APP	Q.A.	NO.	DIA.	LGT	TYPE	WASHER									
PROJECT NO. BHF-0302(3) S STATE PROJECT NO.																			
MATERIAL:					ELECTRODES:					HOLES:					SHOP BOLTS:				
SURFACE PREP. & PAINT:																			
DESCRIPTION: FRAMING PLAN										DRAWN BY		DATE							
JOB: IMPROVEMENTS										UPF		3-08							
BRIDGE No. 41 ON T.H. No. 2										CHKD BY		CR							
RICHFORD, VT.										APPROV BY		Q.A.							
CUSTOMER: BLOW & COTE INC.																			
CASCO BAY STEEL STRUCTURES, INC.										JOB NO.		DRG. NO.							
75 SPRING HILL ROAD SACO, MAINE 04072										361		E1							
PHONE (207) 282-7360 FAX. (207) 282-1179										REV.		△							